


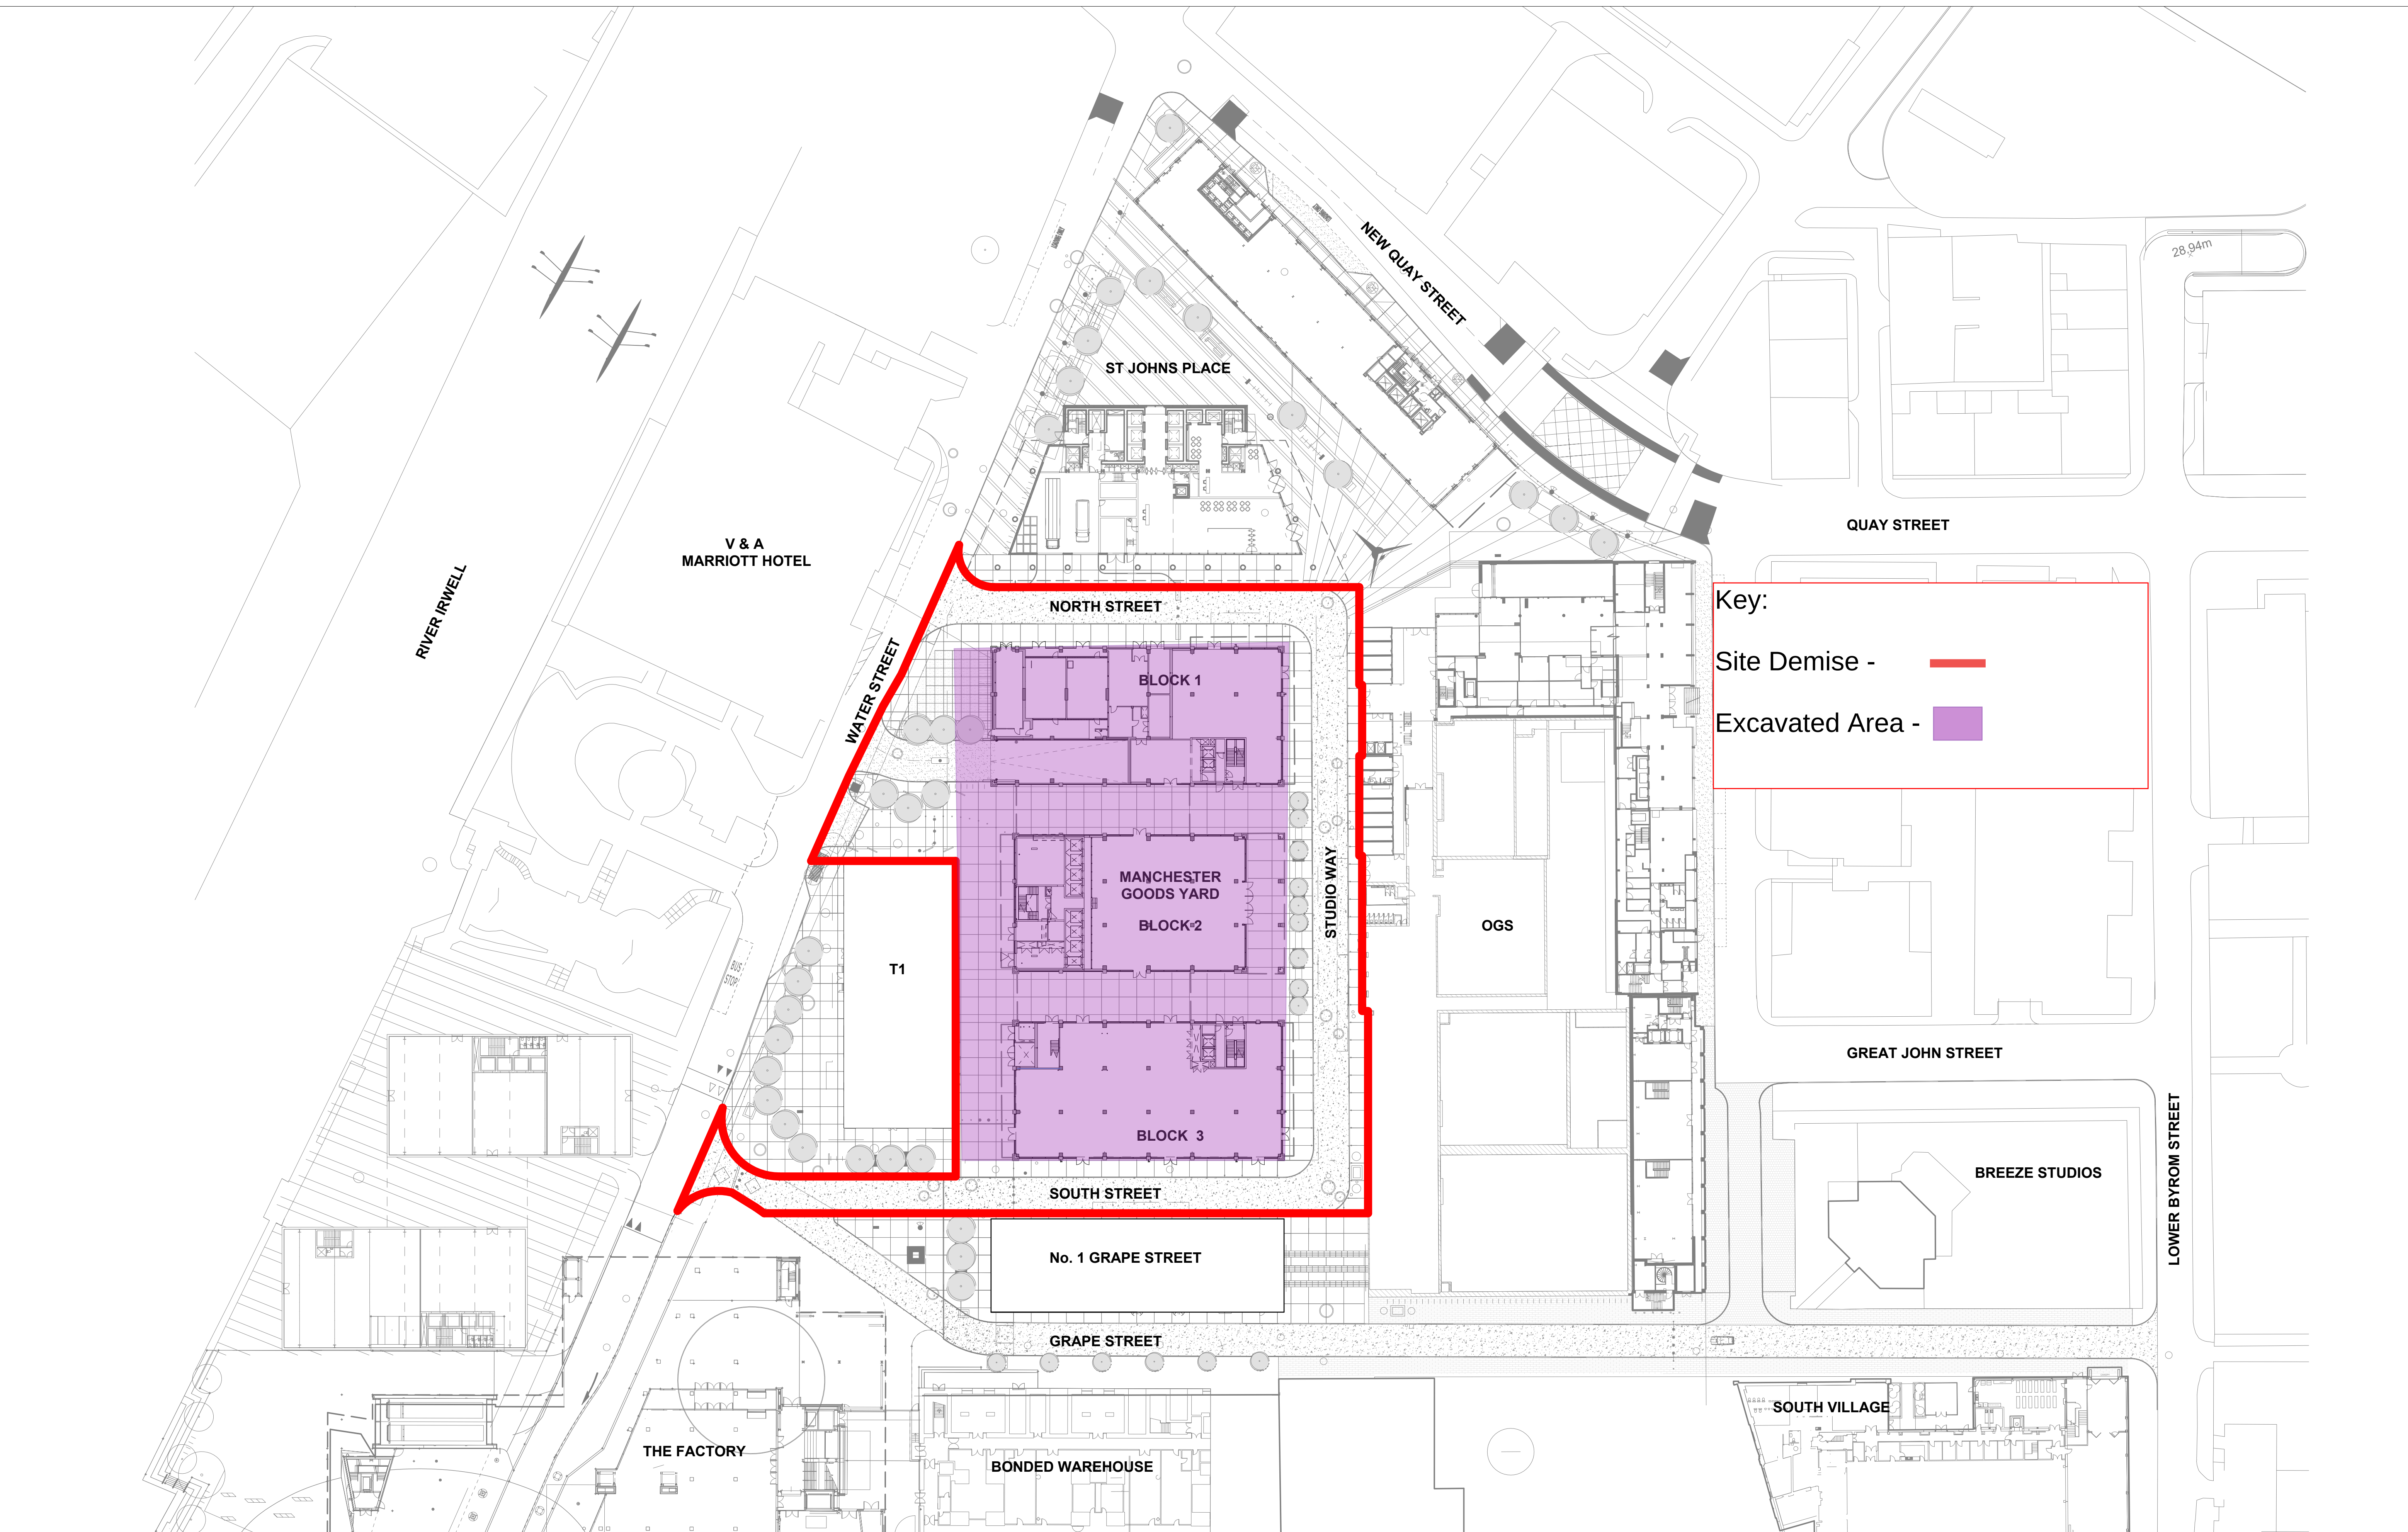

Key:

Site Demise -

Excavated Area -

KEY PLAN

STUDIO WAY

NOTES

THIS DRAWING MUST NOT BE SCALED.

ALL DIMENSIONS ARE TO BE VERIFIED AND CHECKED ON SITE. ANY DISCREPANCIES THAT ARE, OR BECOME APPARENT SHOULD BE REPORTED TO CHAPMAN TAYLOR.

AREAS INDICATED ARE APPROXIMATE GROSS INTERNAL AND NET INTERNAL AREAS. THEY RELATE TO THE LIKELY AREAS OF THE BUILDING AT THE CURRENT STAGE OF DESIGN. ANY DECISIONS TO BE MADE ON THE BASIS OF THESE PREDICTIONS, WHETHER AS TO PROJECT VIABILITY, PRELIMINARY LOSE AGREEMENTS, OR THE LIKE, SHOULD INCLUDE DUE ALLOWANCE FOR THE INCOMPLETES AND DEFEASURES INHERENT IN THE DESIGN DEVELOPMENT AND BUILDING PROCESS.

© COPYRIGHT CHAPMAN TAYLOR 2021

THIS DRAWING IS A FINAL RECORD ISSUE HOWEVER THIS MAY NOT NECESSARILY REFLECT THE FINAL AS BUILT CONDITION ON SITE. THIS DRAWING HAS NOT BEEN SUBJECT TO ANY FINAL SITE SURVEY AND ANY DIMENSIONAL CHECKS TO VERIFY ITS ACCURACY SHOULD BE UNDERTAKEN ON SITE. THE DESIGN OF THE DESCRIPTIVE ELEMENTS/PACKAGES AS NOTED BY OTHERS ON THIS DRAWING ARE INCOMPLETE FOR USE IN MANUFACTURE OR CONSTRUCTION OF THE WORKS, SINCE DETAILED DESIGN IS STILL REQUIRED BY THE RELEVANT SPECIALIST SUB-CONTRACTORS. REFERENCE SHOULD BE MADE TO THE SUB-CONTRACTOR DRAWINGS FOR 'CONSTRUCTION ISSUE' STATUS DRAWINGS AND WORKING DRAWINGS FOR MANUFACTURE AND / OR CONSTRUCTION OF THESE ELEMENTS

REV	DATE	BY	DESCRIPTION	CHK'D

REV	DATE	BY	DESCRIPTION	CHK'D
R01	07.05.21	AE	FINAL CONSTRUCTION ISSUE	SCM/MD

PROJECT STATUS

FINAL CONSTRUCTION ISSUE

CLIENT

 ALLIED LONDON

ALLIED LONDON
DEVELOPMENT MANAGEMENT
33 Cork Street,
London
W1S 3NQ

PROJECT

MANCHESTER GOODS YARD

ARCHITECT

 CHAPMAN TAYLOR

GLOBAL ARCHITECTS & MASTERPLANNERS

MANCHESTER STUDIO
Basil Virentzen
4 Castle Street, Castelfield
Manchester M14 4LZ
United Kingdom
T +44 (0)161 628 6000
E manchester@chapmantaylor.com
www.chapmantaylor.com

DRAWING TITLE

SITE PLAN

Scale 1: 500 @ A1

20 50M

INTERNAL JOB NO 261MGY ISSUE DATE 29.10.18 DRAWN BY AE CHECKED BY MD

PROGRAMME ID | PROJECT ID | ORIGINATOR | VOLUME | LEVEL | TYPE | ROLE | NUMBER | REVISION

SJQ 600 CTA XX ZZ DR A 01001 R01