


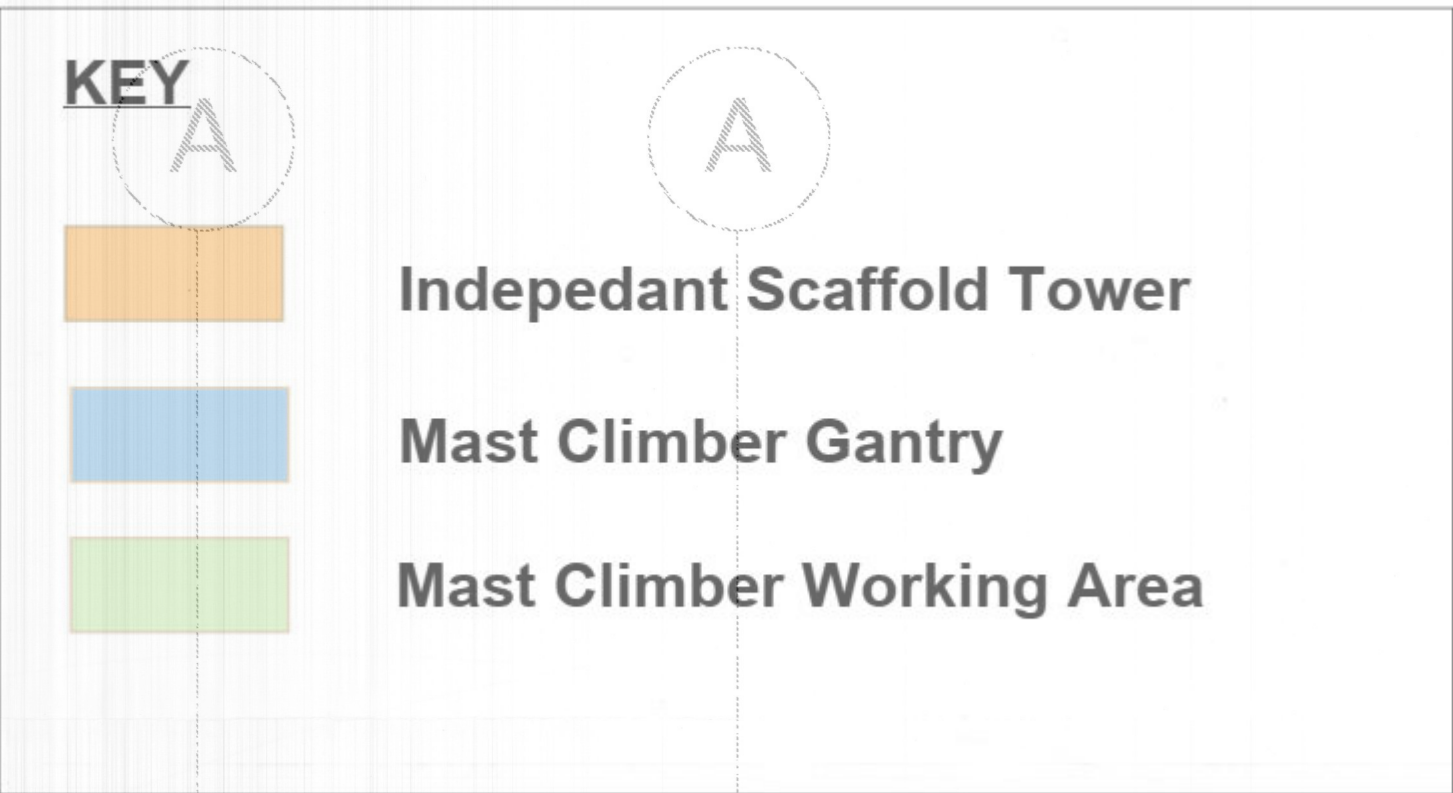

GENERAL NOTES

25.08.00

All setting out must be checked on site

All levels must be checked on site and refer to Ordnance Datum. Newly given alternative Datum given

Half 7 days and weather conditions must be checked on site

All dimensions must be checked on site

This drawing must not be scaled

This drawing must be read in conjunction with the relevant specification clauses

This drawing must not be used for land transfer purposes

Calculated areas in accordance with Assael Architecture's Definition of Areas for Schedule of Areas

This drawing must not be used on site unless issued for construction

Revision Status

T=Preliminary/Planning T=Tender C=Construction/Contract

© 2006 Assael Architecture Limited

DRAWING NOTES

ELECTRONIC FILE REF N°		A1621 4337-F1		
STATUS	REVISION	DATE	DRN	CHECK CDM
P1	PRELIMINARY ISSUE	24.02.06	DF	

NOTE
ALL THE DETAILS REFERRED TO ON THIS
DRAWING ARE NOT FOR CONSTRUCTION
UNTIL AND UNLESS THEY RECEIVE
CONSTRUCTION STATUS

Key

	Single glazed shadow box unit. Clear glass.
	Single glazed unit with solid wall behind. Opaque glass.
	Double glazed unit. Clear glass.



carillon

For information

☒

For comment

☐

For client sanction

☐

For construction

☐

CLIENT
George Wimpey City Ltd

PROJECT TITLE
**Slot Site
Manchester**

DRAWING TITLE	
Block C	
South Elevation	
AS BUILT	
SCALE @ A1 SIZE	DATE
1:100	Feb '06
DRAWING NO	STATUS & REVISION
A1621/4337	P1

Assael

Assael Architecture Limited
Studio 13
50 Carnwath Road
London SW6 3EG
T +44 (0) 20 7736 7744
F +44 (0) 20 7736 6677
E surname@assael.co.uk
W www.assael.co.uk