


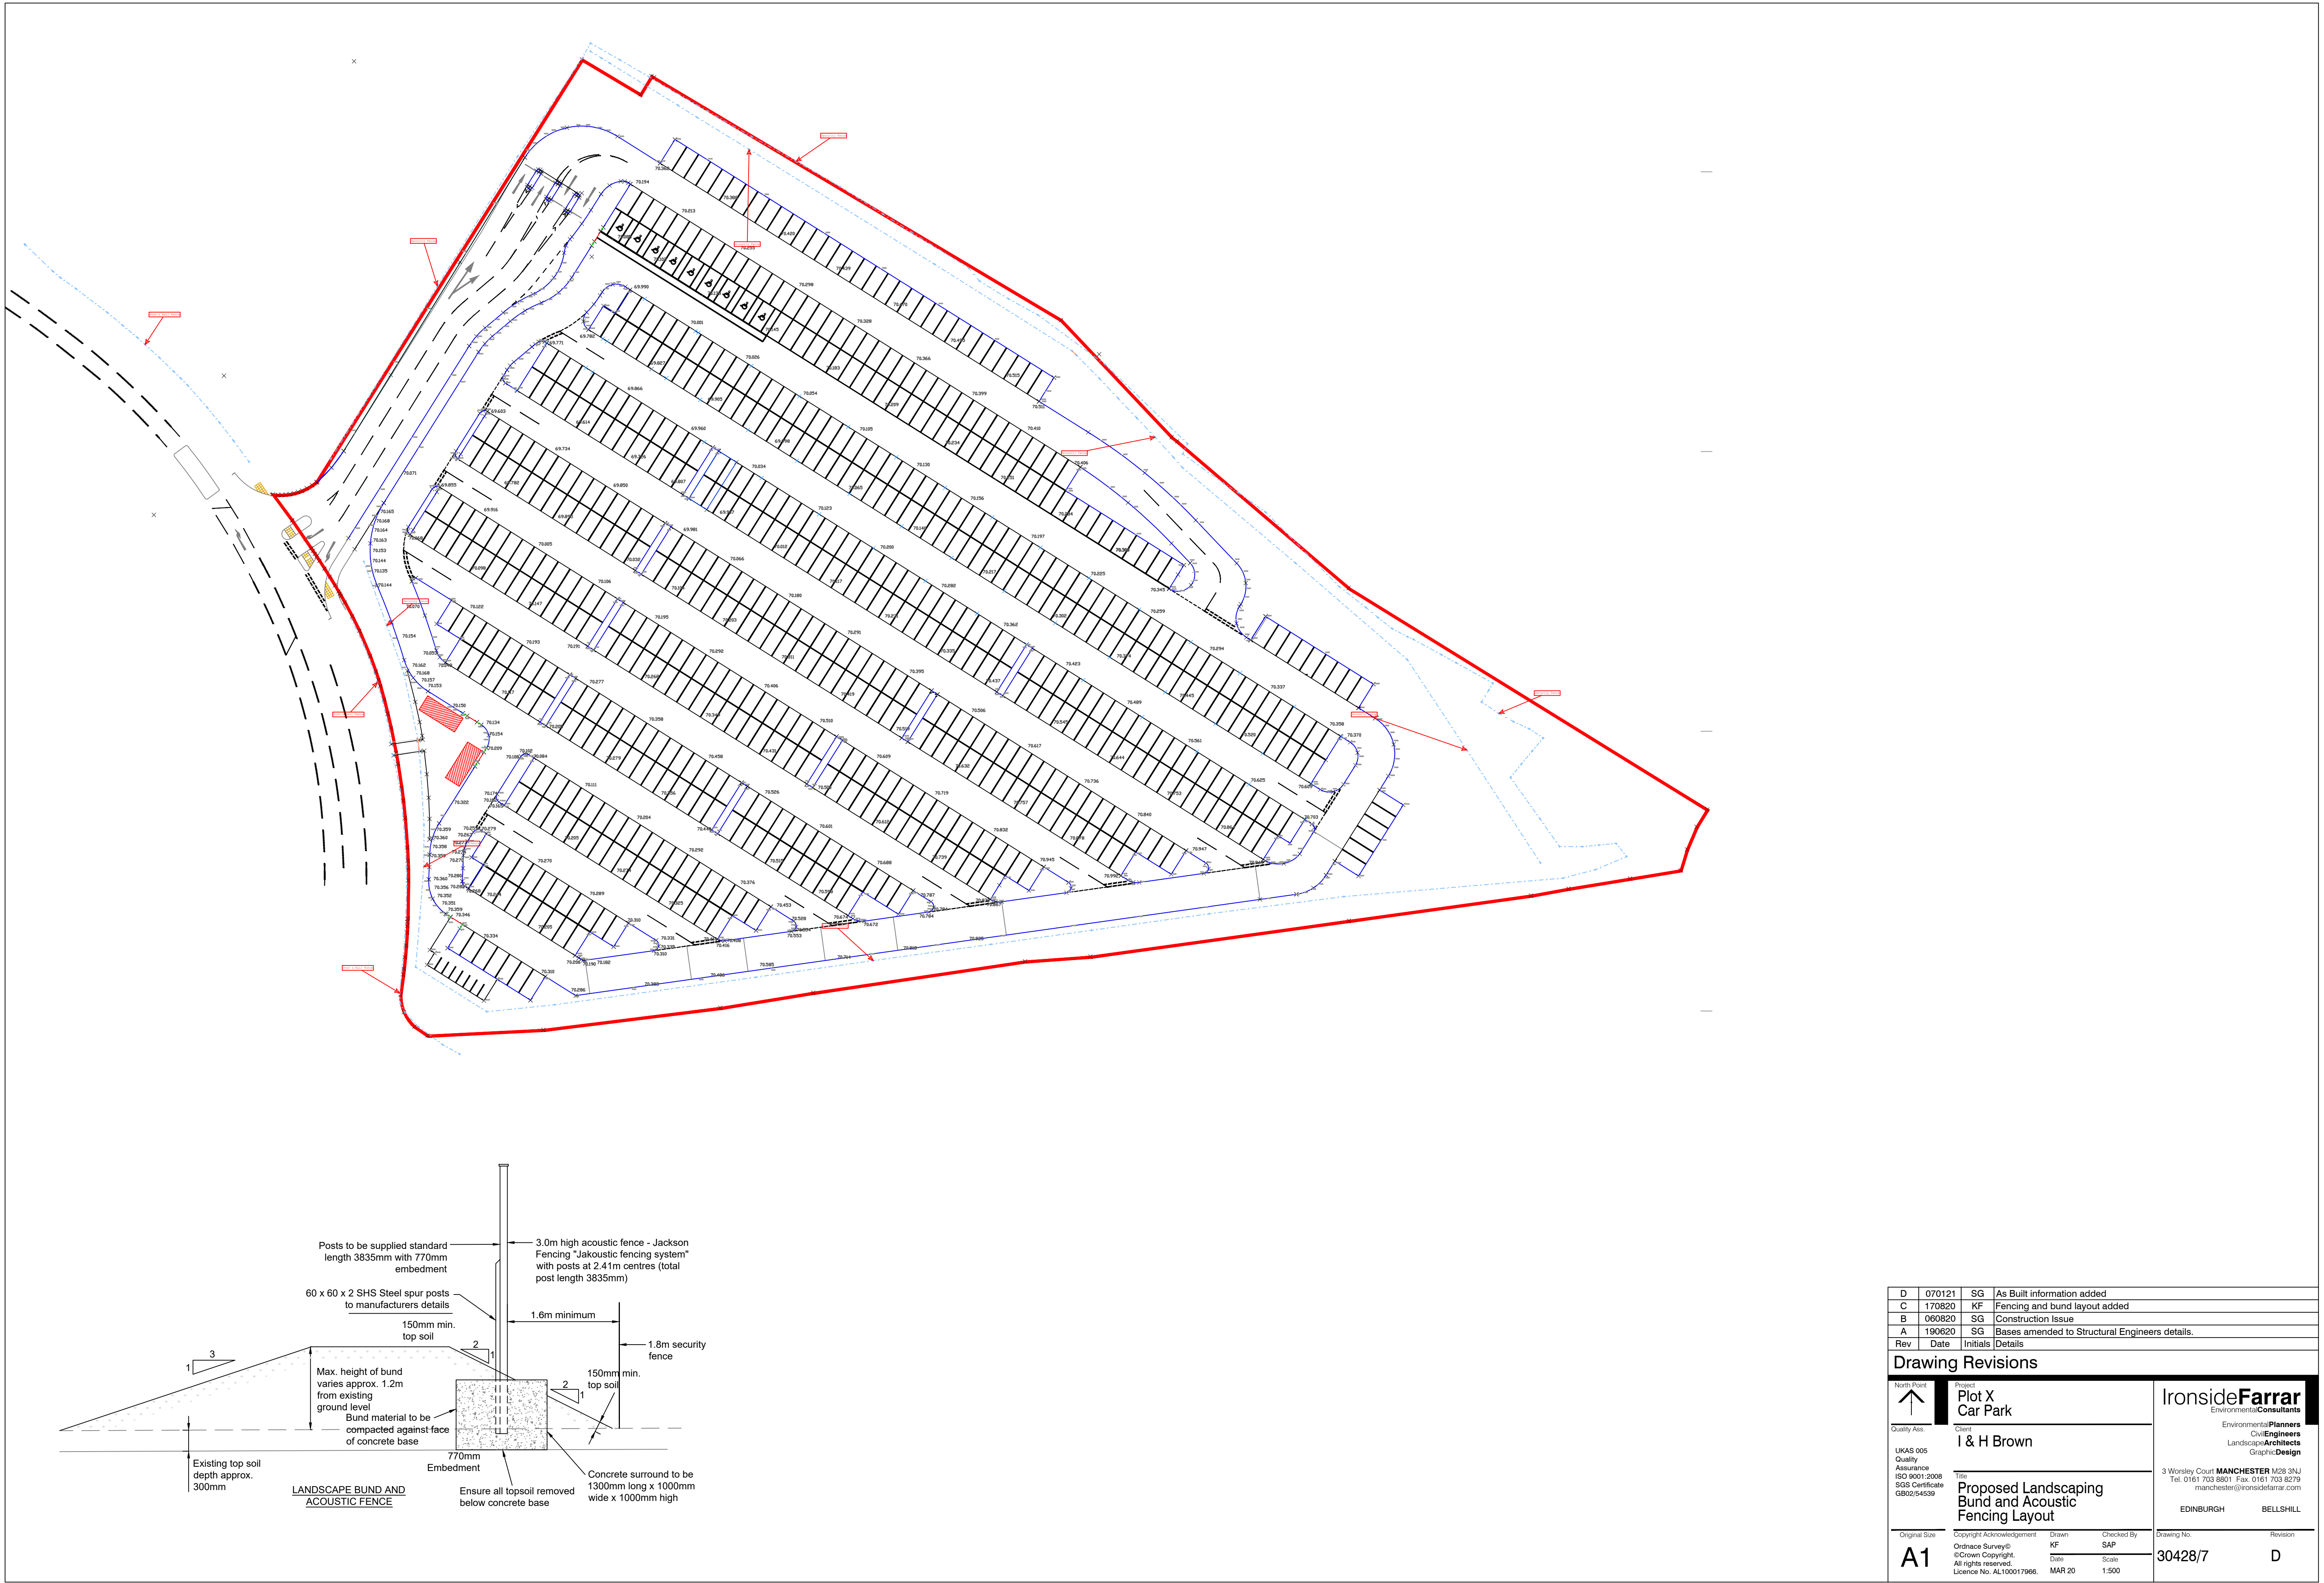

D	070121	SG	As Built information added
C	170820	KF	Fencing and bund layout added
B	060820	SG	Construction Issue
A	190620	SG	Bases amended to Structural Engineers details.
Rev	Date	Initials	Details
Drawing Revisions			
North Point		Plot X Car Park	IronsidedFarrar EnvironmentalPlanners CivilEngineers LandscapeArchitects GraphicDesign 3 Worsley Court Tel: 0161 703 8801 Fax: 0161 703 8279 manchester@ironsidefarrar.com EDINBURGH BELLSHILL
Quality Ass.		Client I & H Brown	
UKAS 005 Quality Assurance ISO 9001:2008 SGS Certificate GB0254539		Title Proposed Landscaping Bund and Acoustic Fencing Layout	
Original Size	Copyright Acknowledgement	Drawn	Checked By
A1	Ordinance Survey ©Crown Copyright. All rights reserved. Licence No. AL100017966.	KF SAP	HF Date MAR 20
		Scale	1:500
Drawing No.		Revision	
30428/7		D	