




Markup of Existing
Impermeable Areas
OuRLeague Hub
Manchester

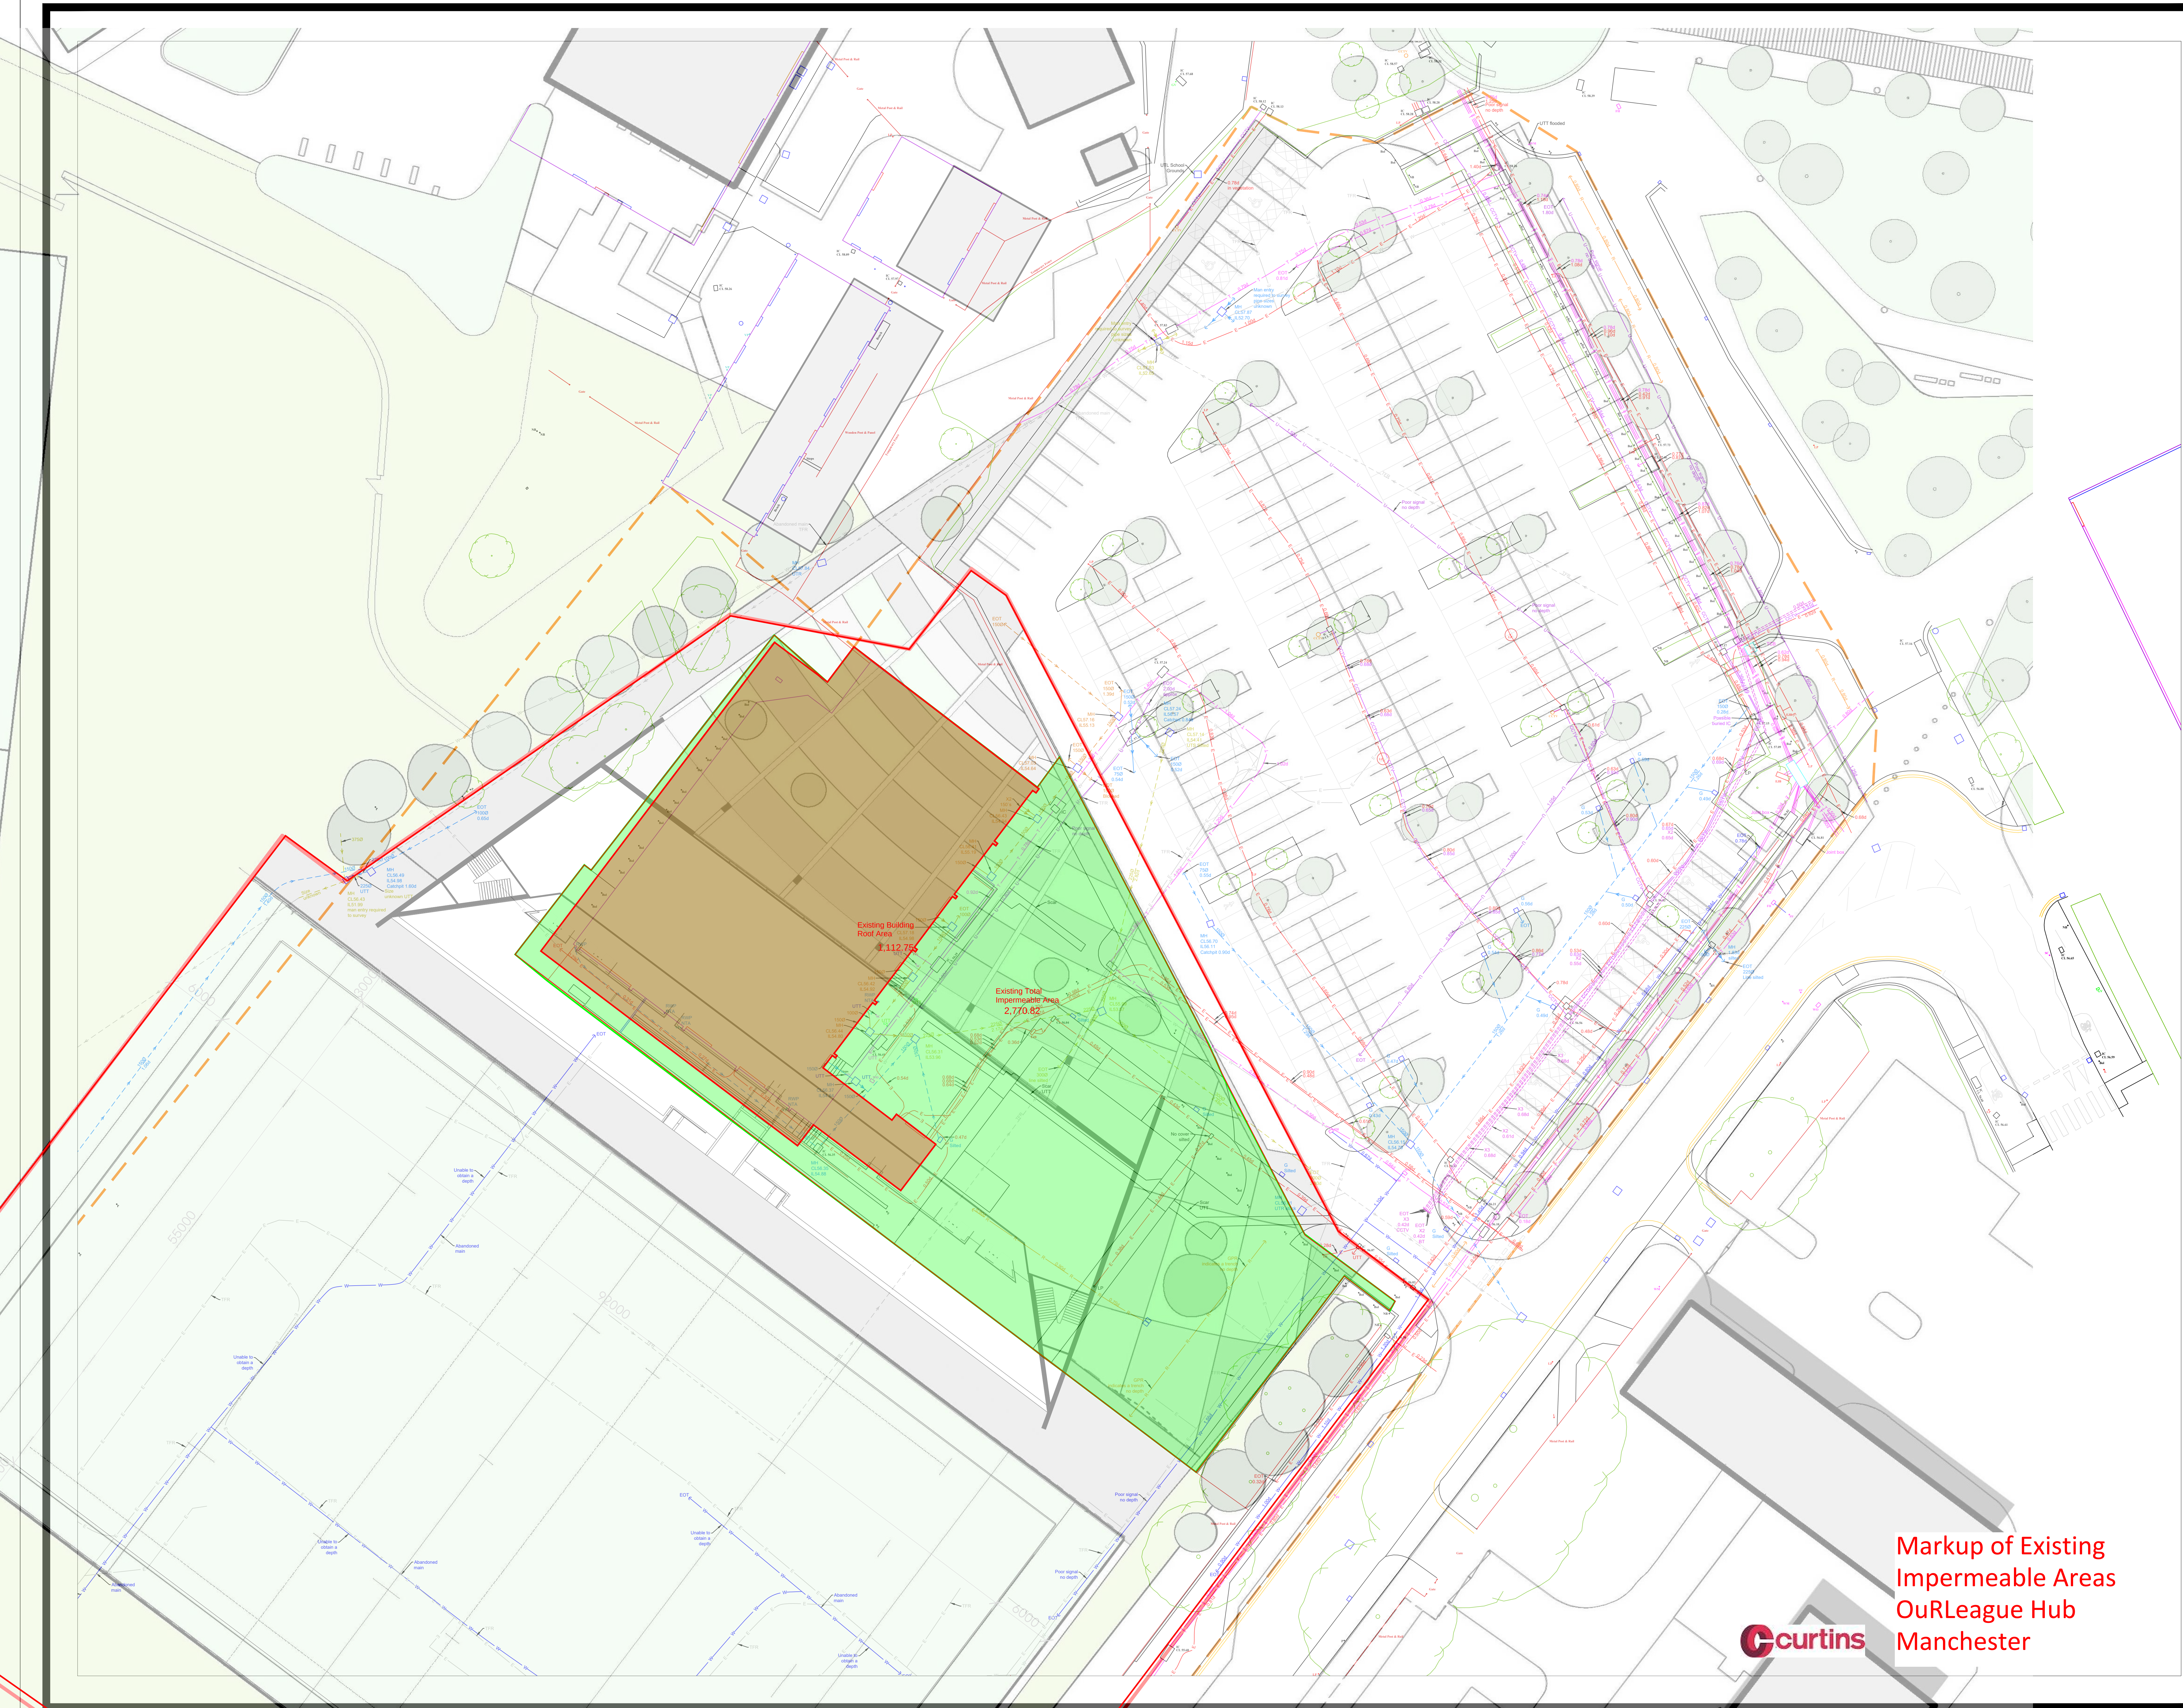

General Notes

- Please use in conjunction with all available statutory utility record information. No records available at time of the utility survey.
- The school field was previously a road and buildings and services could possibly still be in the ground. These are to deep to locate due to school field ground levels been raised.

Disclaimer

The location of underground services shown on this drawing has been determined using electro-magnetic and GPR radar techniques and visual observations. No guarantee can be given that all services have been shown on the drawing. The relevant service drawings should be obtained from the appropriate service providers company and used in conjunction with this drawing. No guarantee can be given to the accuracy and completeness of any service provider record information shown in this drawing and no liability will be accepted for any losses that arise due to a lack of accuracy in any service providers record information. Reference should also be made to historical plans and as built drawings. Excavations in the vicinity of services should be carried out with due diligence ref: HSG47 document. Location accuracy is determined by referring to manufacturers guidelines for the systems deployed. Reference should be made to the latest version of Discovery Surveys Ltd site procedures document for utility location surveys.

ABBREVIATIONS

AR	ASSUMED ROUTE	NFI	NO FURTHER INFORMATION
BD	BACKDROP	NTA	NO TRANSMITTER ACCESS
BTIC	BRITISH TELECOM CHAMBER	OSA	OUTSIDE SURVEY AREA
CI	CAST IRON	PE	POLYETHYLENE
CL	COVER LEVEL	PR	PIPE RISER
CO	CONCRETE	PVC	POLYVINYL CHLORIDE
CP	CABLE PIT	RE	RODDING EYE
CR	CABLE RISER	RWP	RAINWATER PIPE
D	DEPTH IN METRES	SV	STOP VALVE
EM	EARTH MAT	SVP	SOL VENT PIPE
EP	ELECTRICITY POLE	TFR	TAKEN FROM RECORDS
EOT	END OF TRACE	TP	TELEGRAPH POLE
FE	FENCE EARTH POINT	UDI	UNRELIABLE DEPTH INFO
FH	FIRE HYDRANT	UTL	UNABLE TO LOCATE
G	GULLY	UNR	UNABLE TO RAISE
GPR	TRACED BY G.P.R.	UTS	UNABLE TO SURVEY
GV	GAS VALVE	UTT	UNABLE TO TRACE
GR	GAS RISER	VL	WATER LEVEL
IC	INSPECTION CHAMBER	VR	WATER RISER
IL	INVERT LEVEL	VP	VENT PIPE
LP	LAMP POST	VR	VAPOUR RECOVERY
MH	MANHOLE	WM	WATER METER
MCW	MAINS COLD WATER	WV	WASH OUT VALVE
ND	NO DEPTH (Unable to acquire depth)	WWP	WASTE WATER PIPE

LEGEND

CATV	CATV	CATV	CABLE TELEVISION
CCTV	CCTV	CCTV	CLOSED CIRCUIT TELEVISION
COM	COM	COM	COMMUNICATIONS CABLE
COMP	COMP	COMP	COMPRESSED AIR
DUCT	DUCT	DUCT	DUCTING
ELEC	ELEC	ELEC	ELECTRIC CABLE
EARTH	EARTH	EARTH	EARTH CABLE
FOUL	FOUL	FOUL	FOUL WATER SEWER
COMB	COMB	COMB	COMBINED WATER SEWER
SURF	SURF	SURF	SURFACE WATER SEWER
FUEL	FUEL	FUEL	FUEL PIPE
GAS	GAS	GAS	GAS PIPE
GAUGE	GAUGE	GAUGE	GAUGE LINE
HEAT	HEAT	HEAT	HEATING
OFFSET	OFFSET	OFFSET	OFFSET FILL PIPE
RADAR	RADAR	RADAR	RADAR TRACE
TELECOMS	TELECOMS	TELECOMS	TELECOMS CABLE
TRAFFIC	TRAFFIC	TRAFFIC	TRAFFIC LIGHT CABLE
UNIDENTIFIED	UNIDENTIFIED	UNIDENTIFIED	UNIDENTIFIED SERVICE
VAPOUR	VAPOUR	VAPOUR	VAPOUR RECOVERY
VENT	VENT	VENT	VENT PIPE
WATER	WATER	WATER	WATER PIPE
SURVEY	SURVEY	SURVEY	SURVEY BOUNDARY
END OF TRACE	END OF TRACE	END OF TRACE	END OF TRACE (Signal lost, unless stated otherwise)

No.	Revision/Issue	By	Date

Winning Post Centre
MoorendsThorne
Doncaster
DN6 4PB

Project Name and Address

Grey Mare Lane
Kirkstead Close
Manchester
M11 3SW

Drawing No	SHEET	
CUR 230621 050a	1 of 2	
Date	13/08/2021	
Scale	1:200@A0	
Client	Drawn	Approved
Curtins	JH	SR