




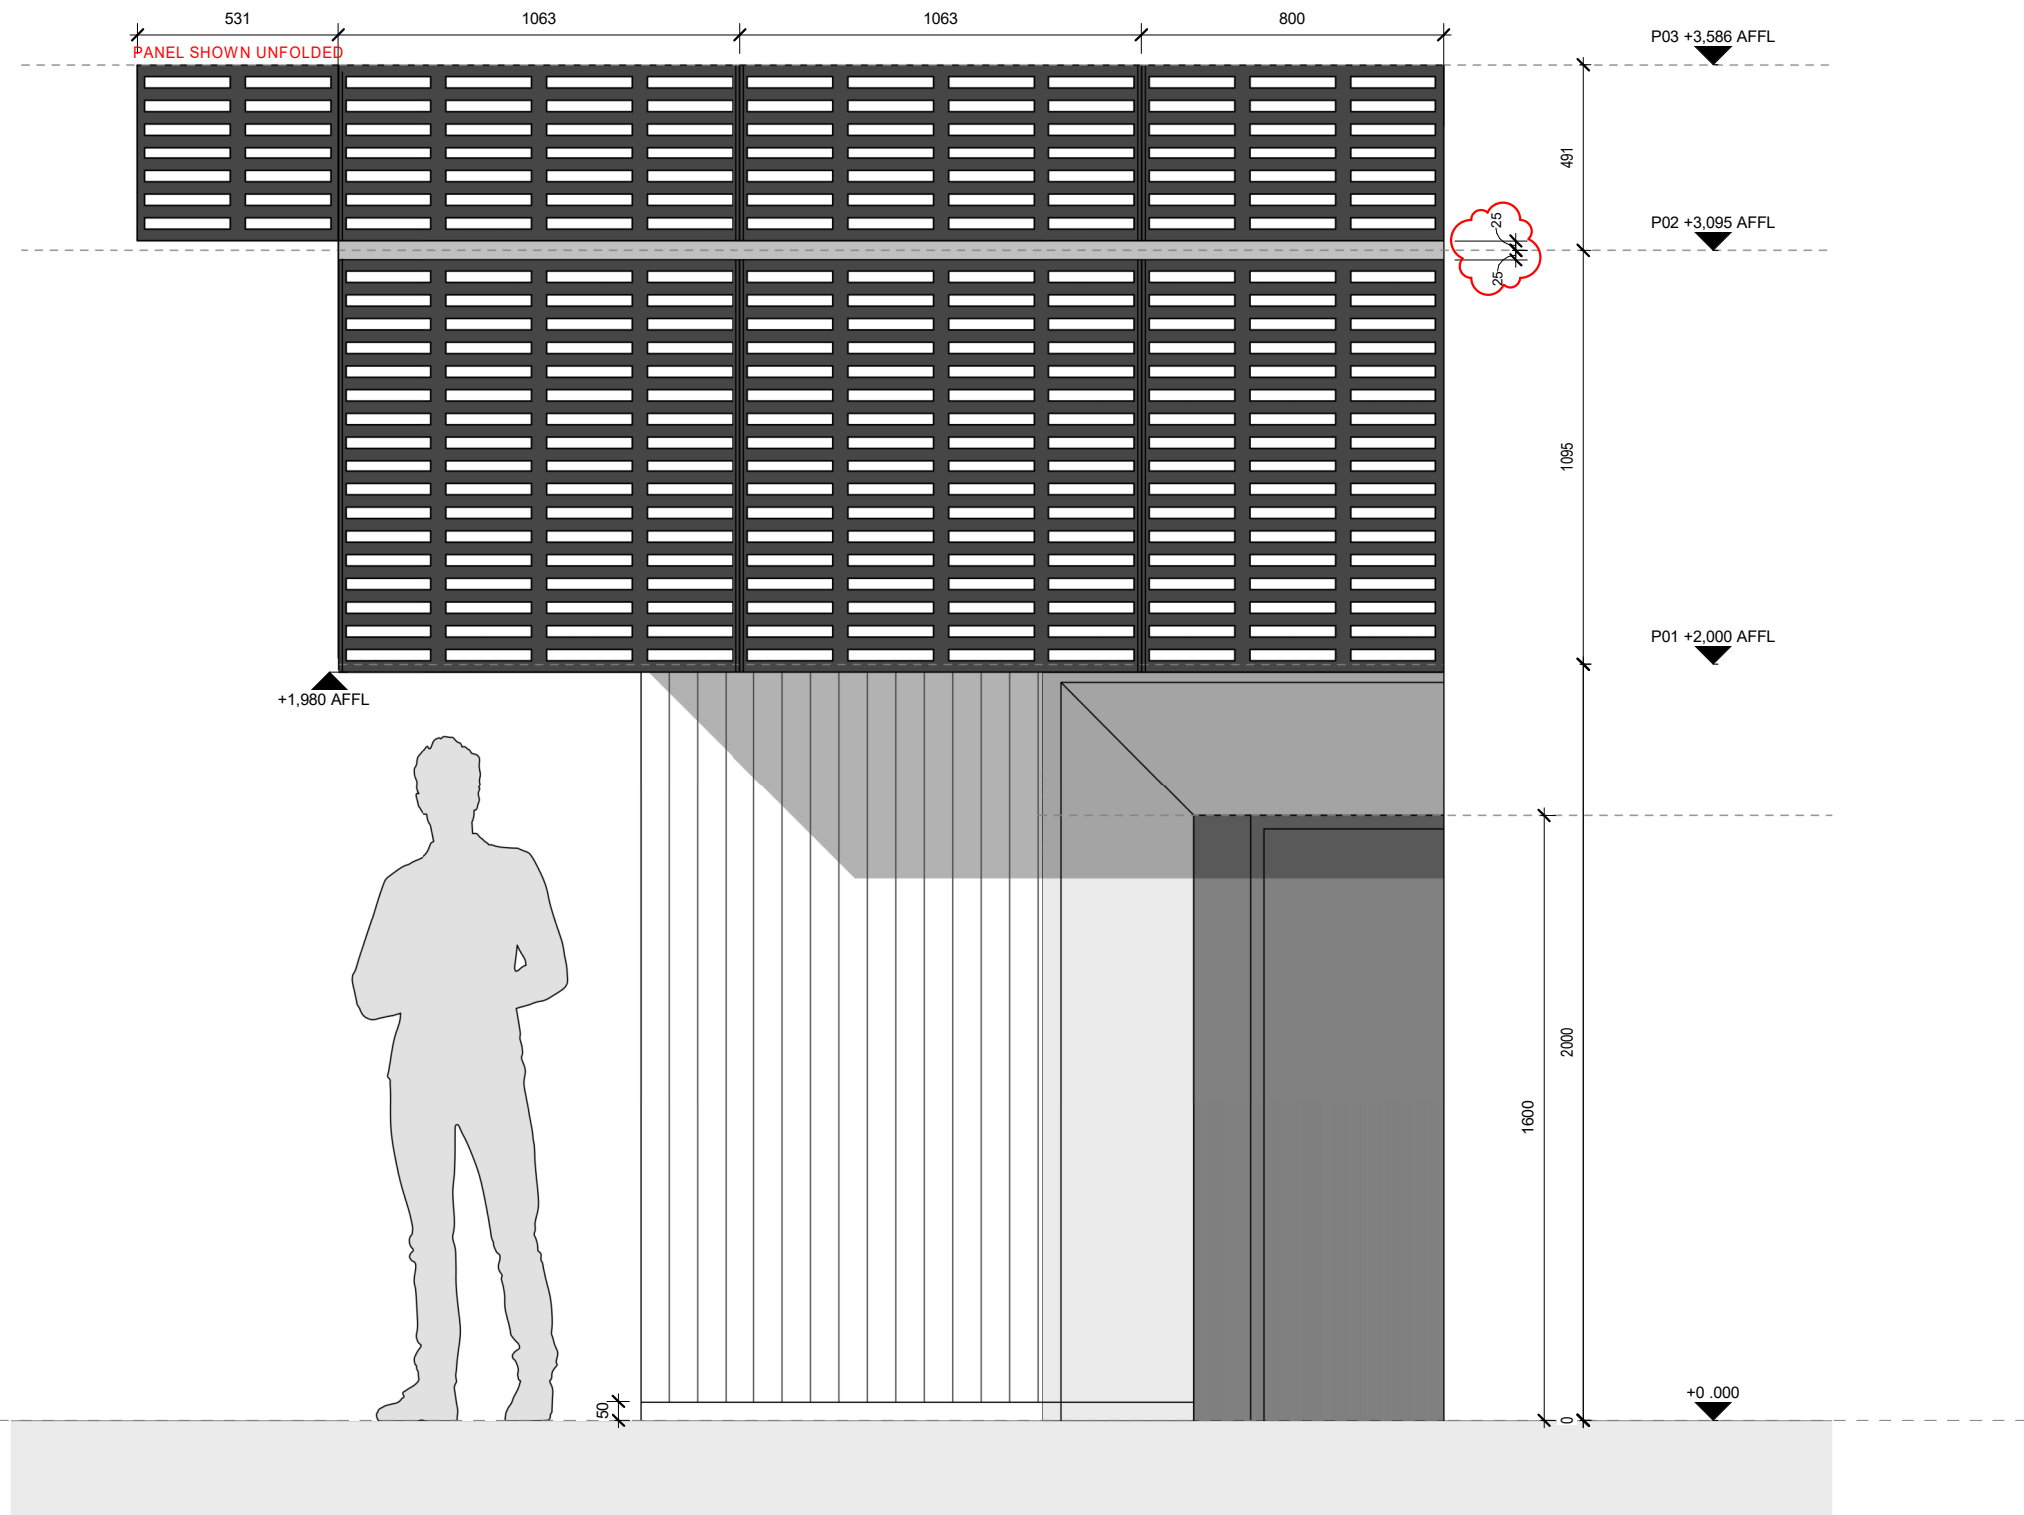


2 ELEVATION - MOCKUP

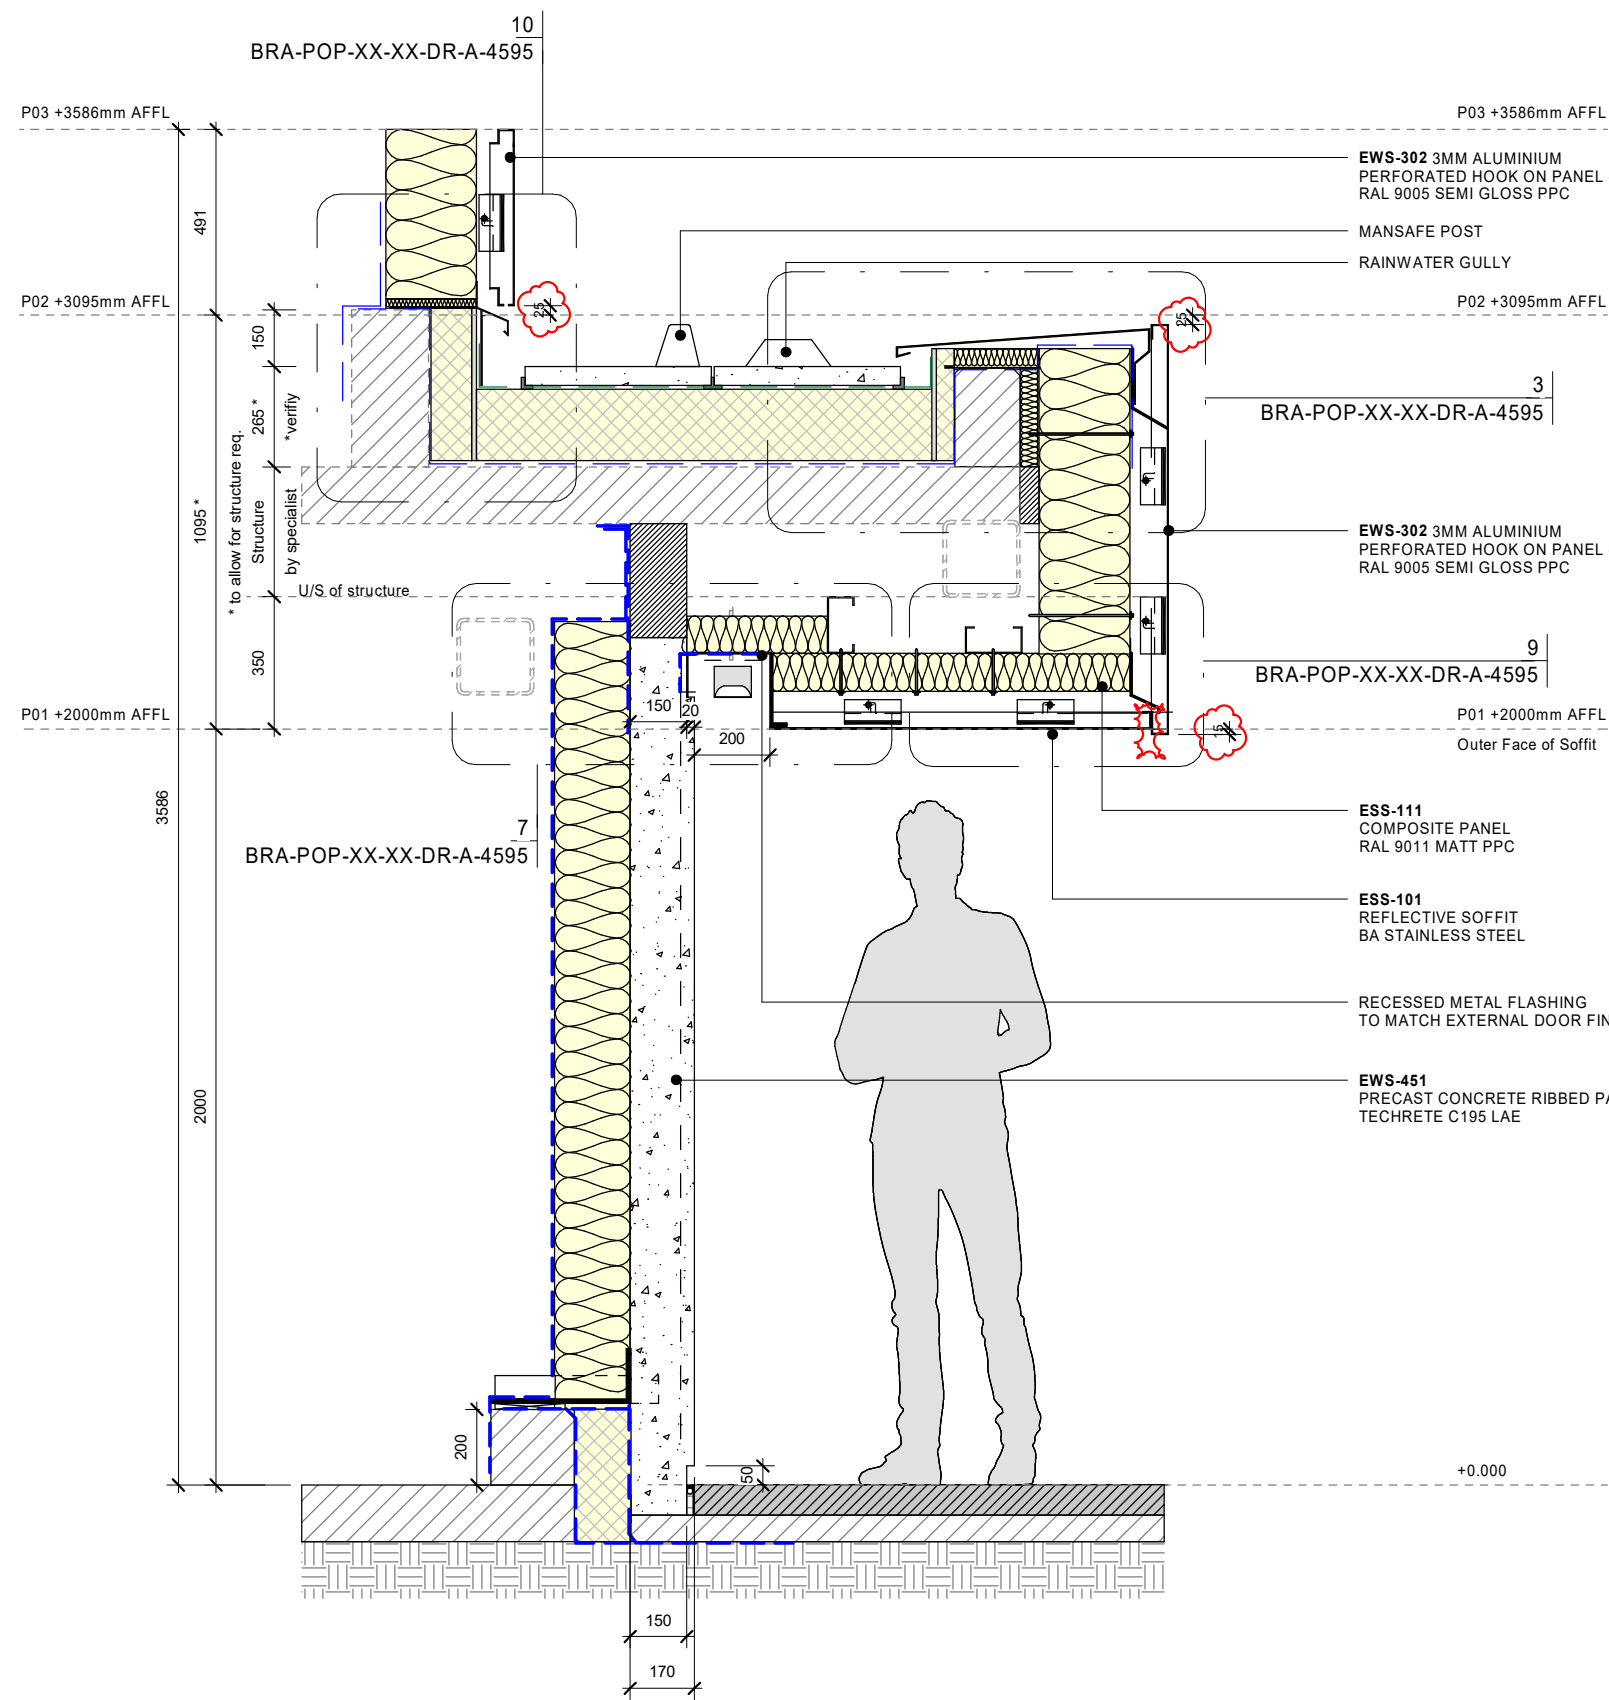


4 FRONT SECTION - MOCKUP

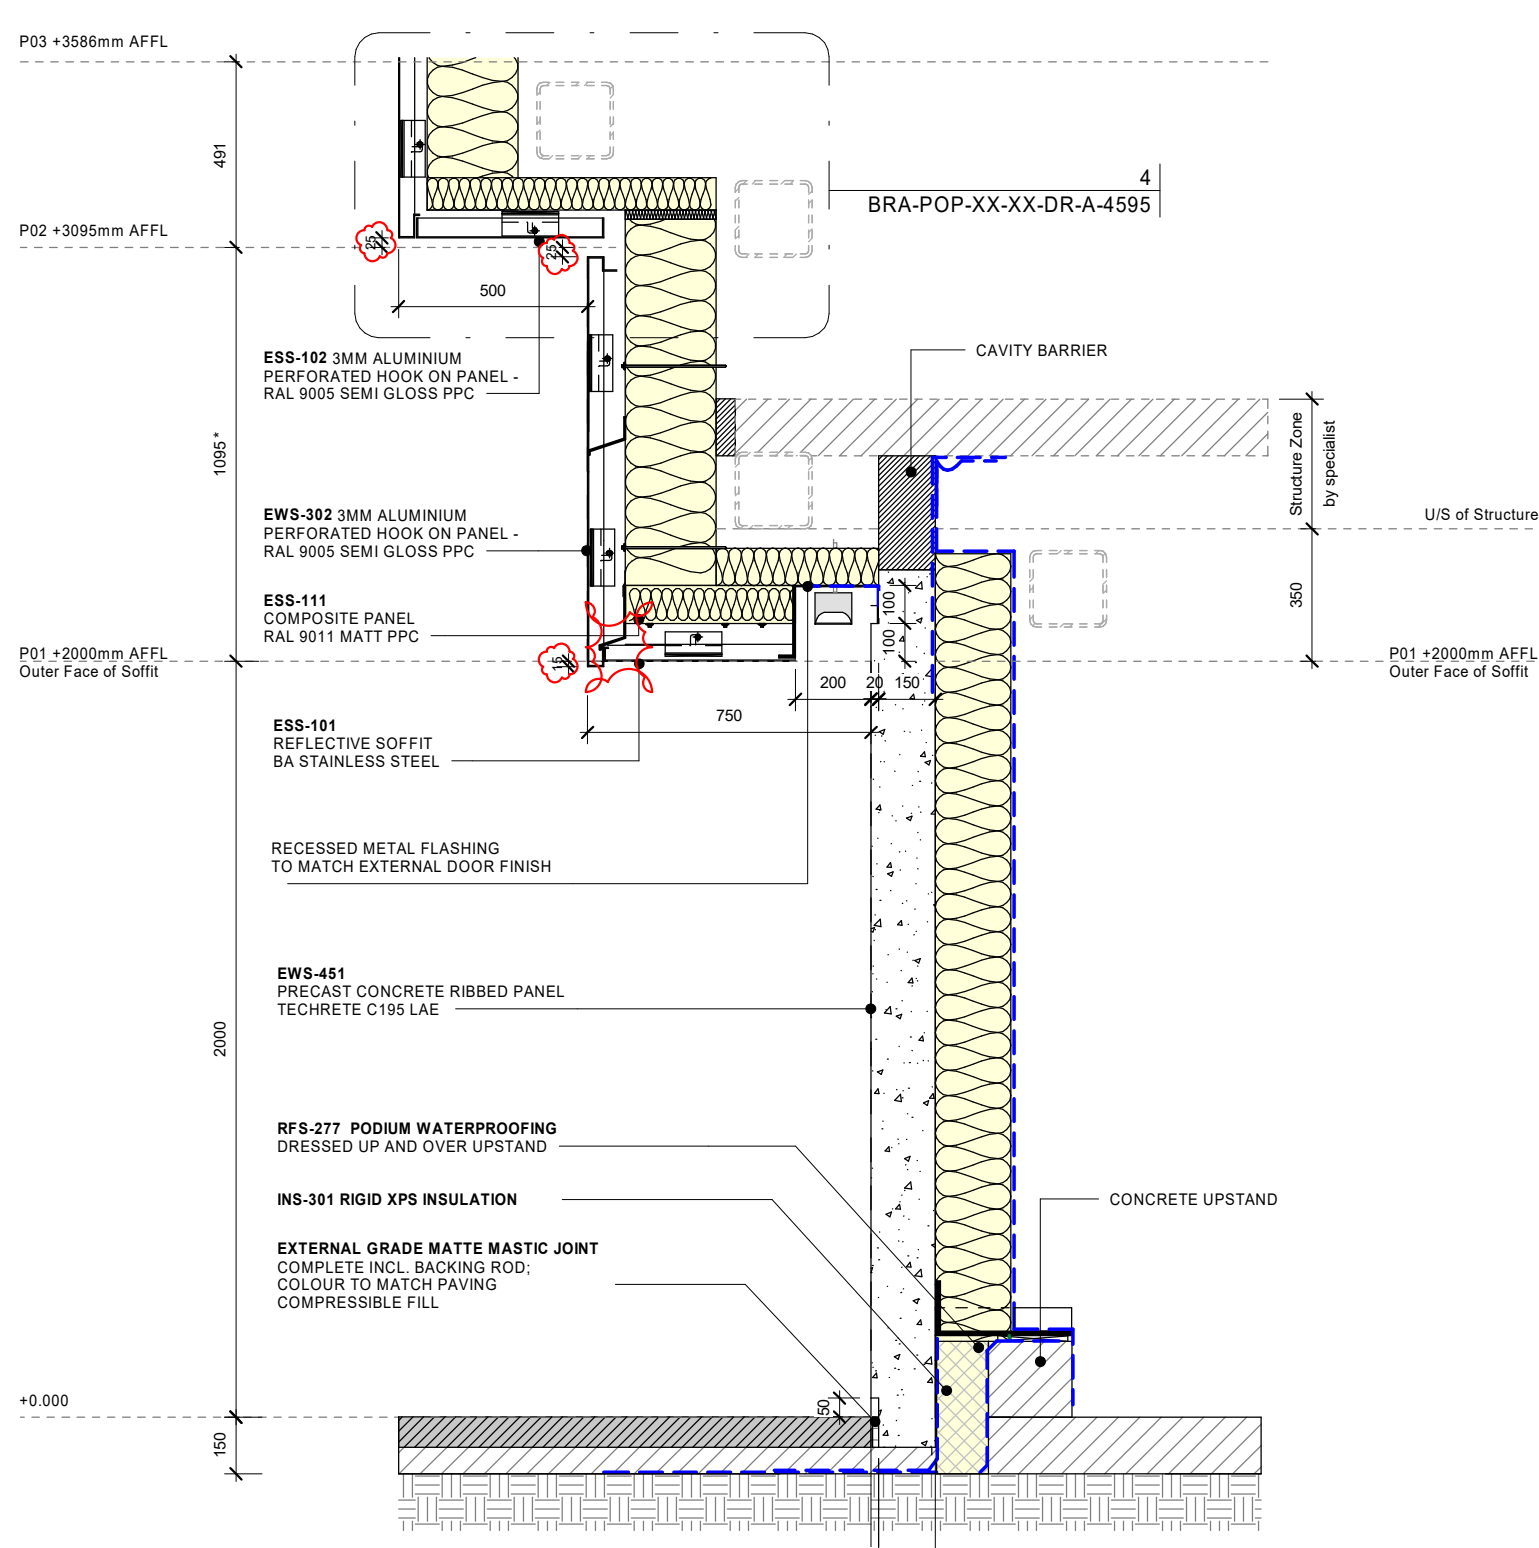


5 SIDE SECTION - MOCKUP

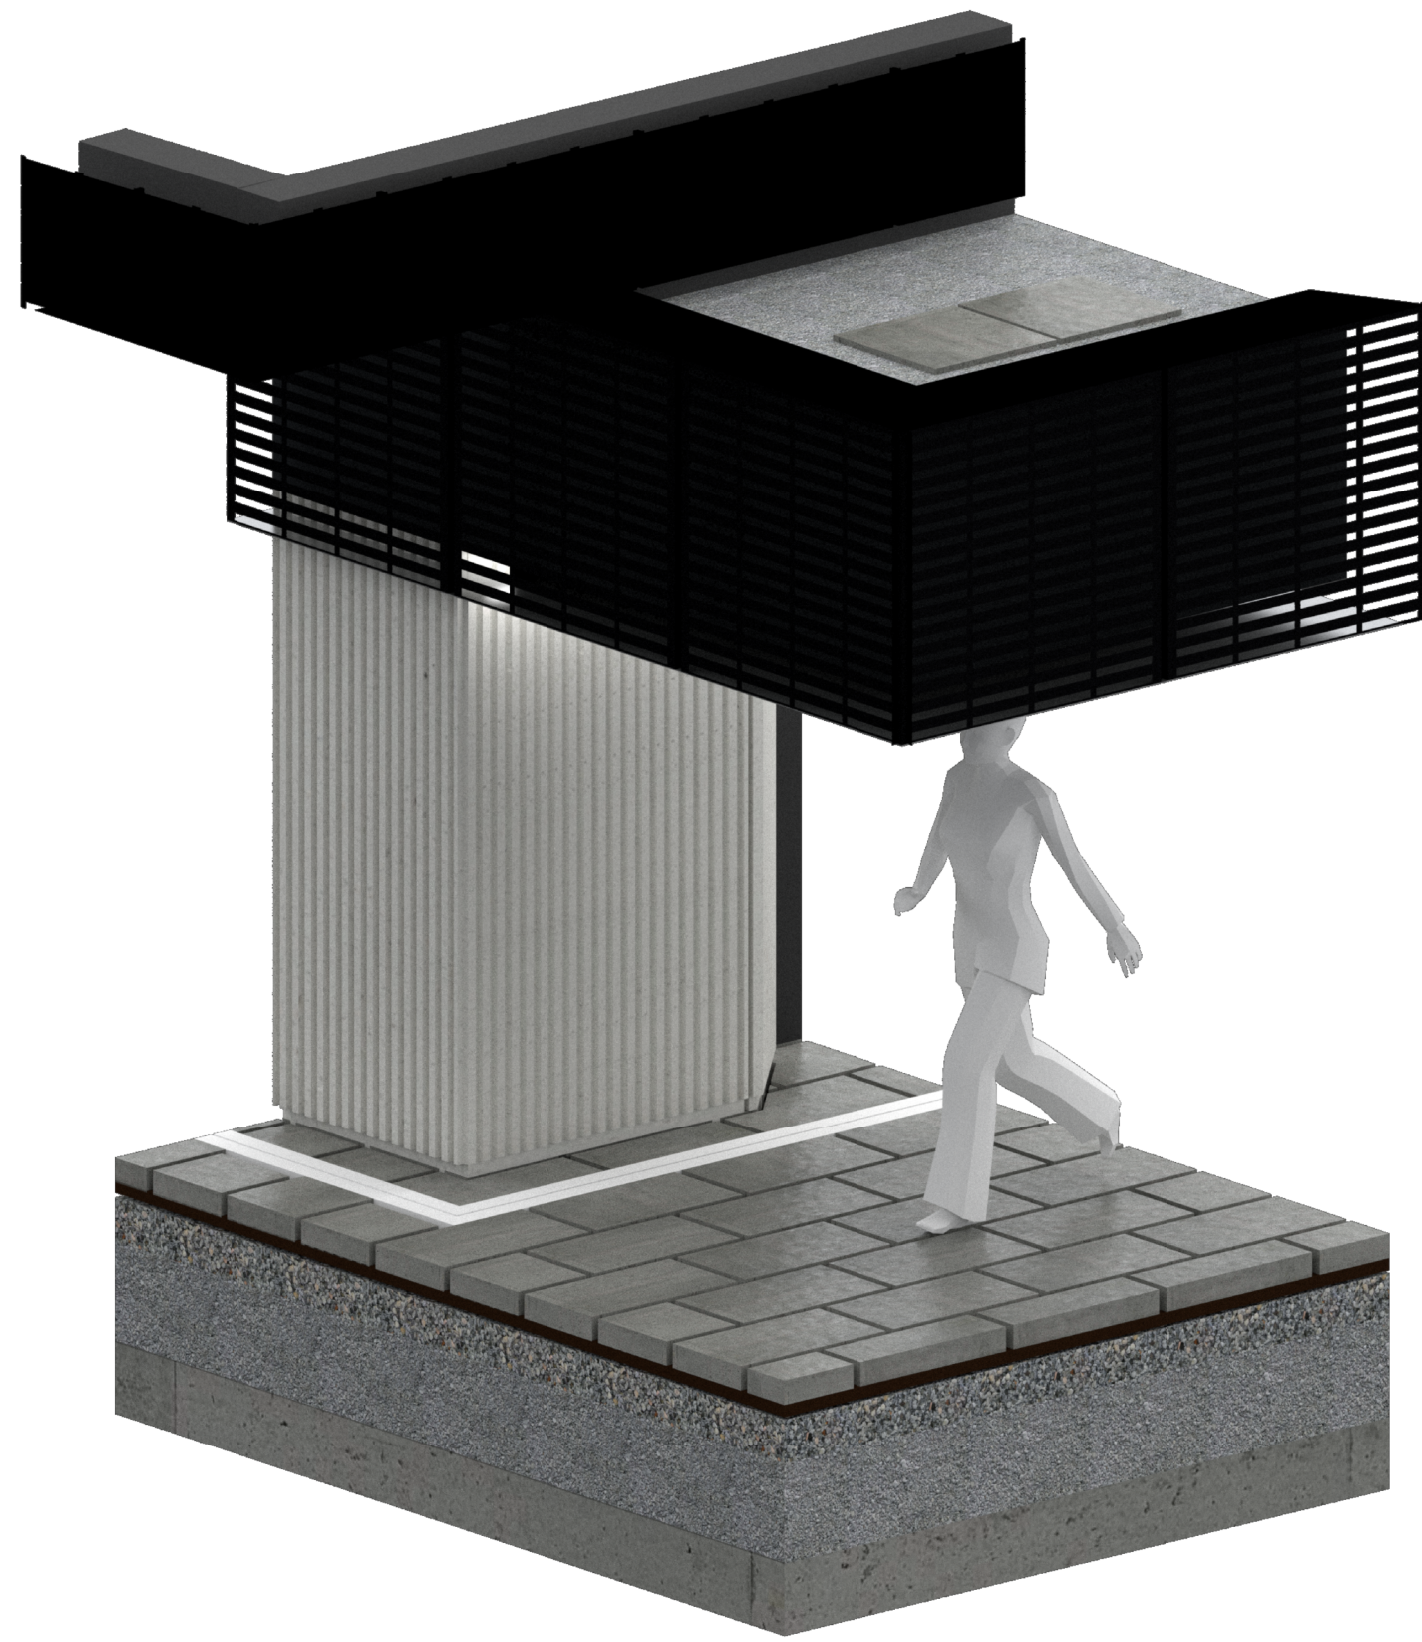


3 AXONOMETRIC - MOCKUP

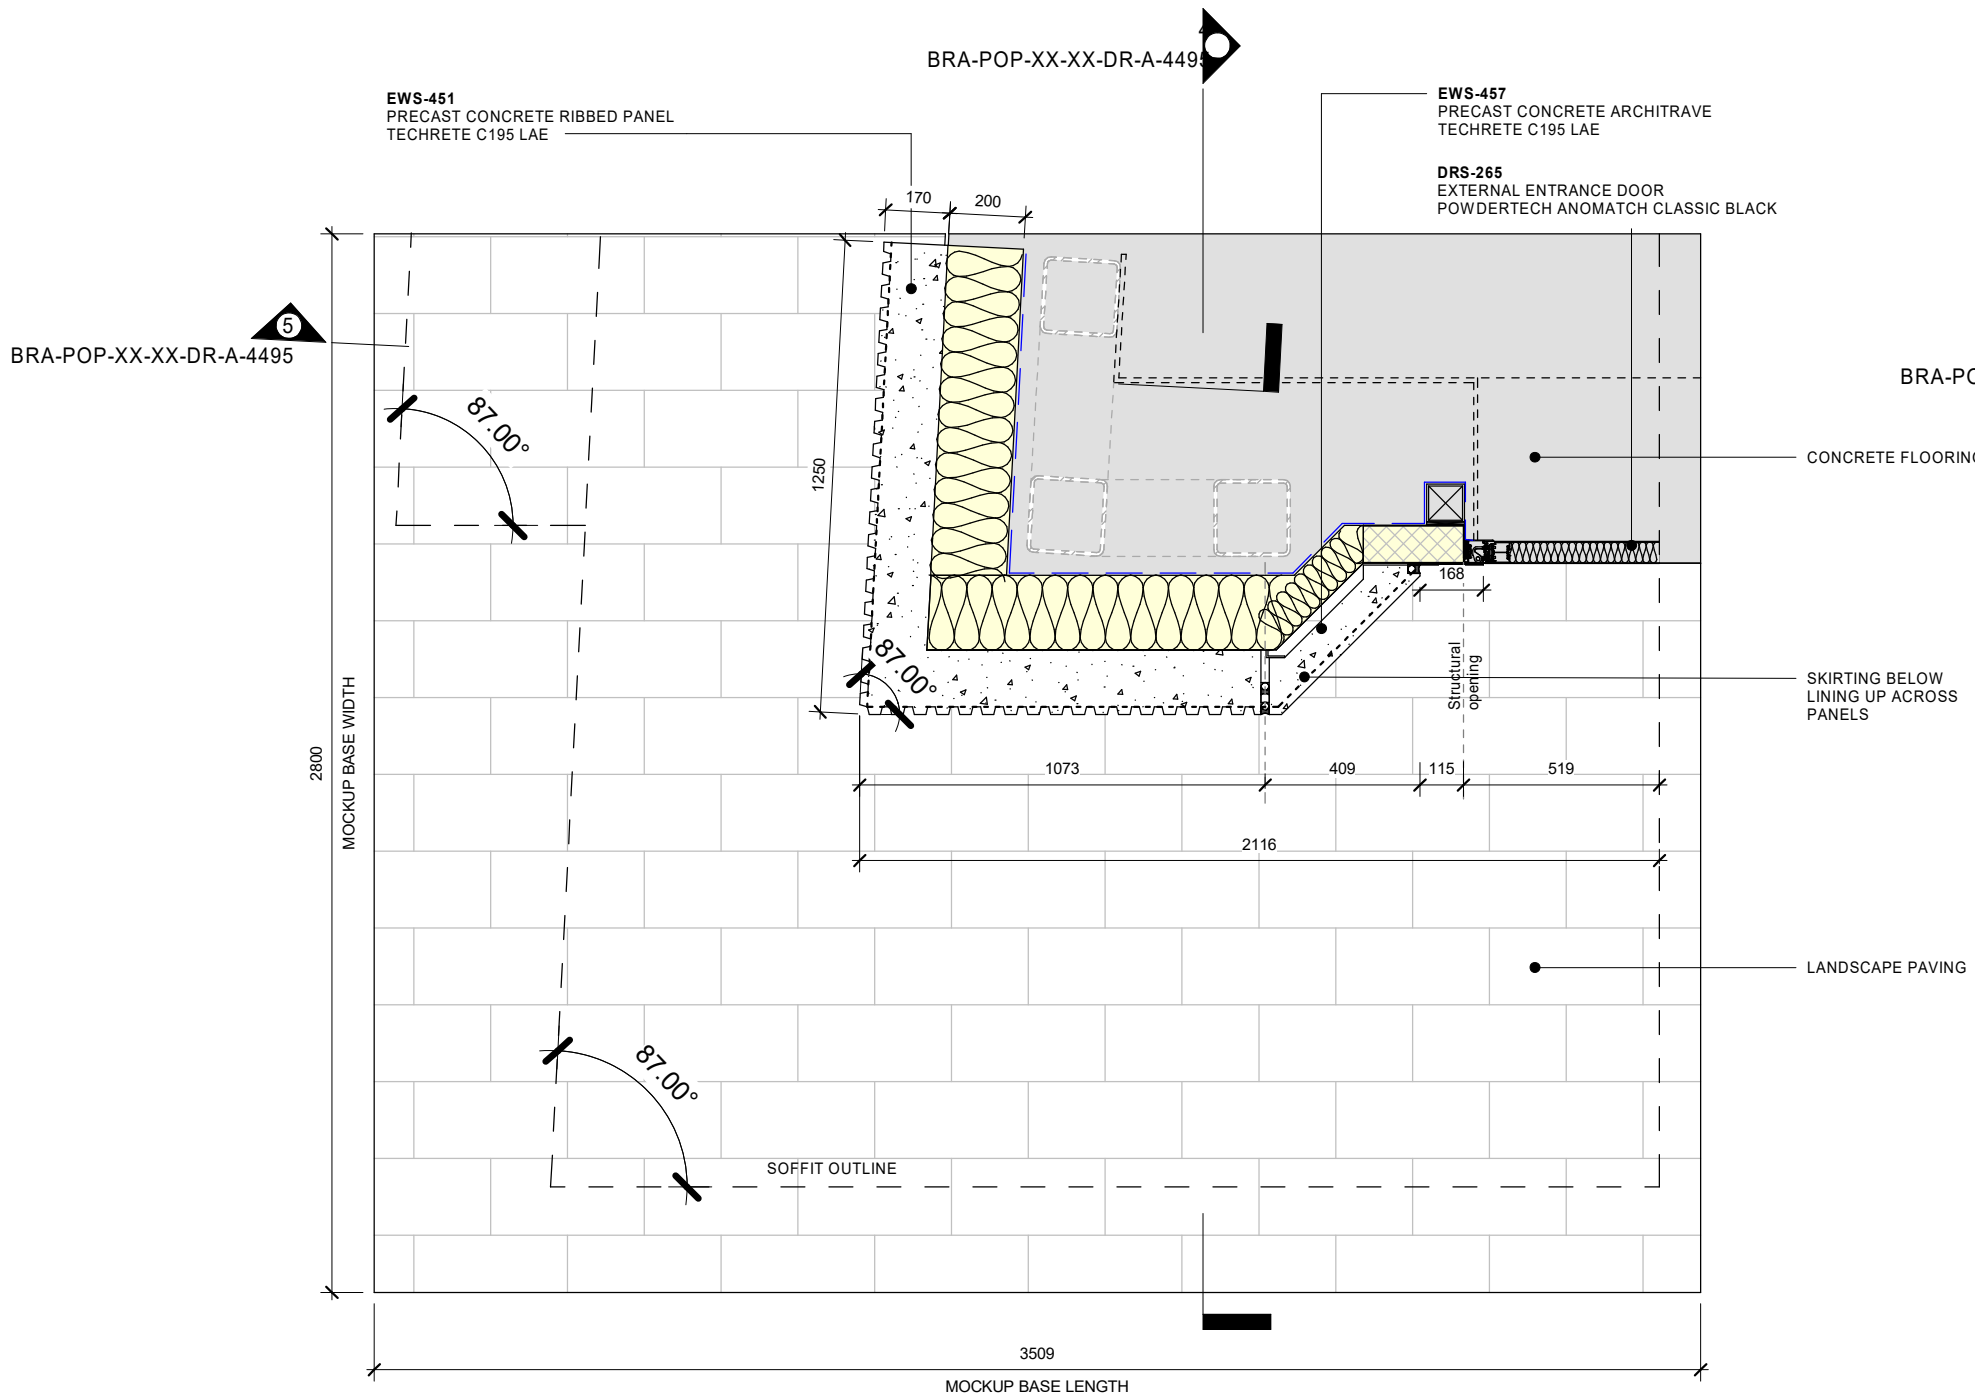


1 PLAN - MOCKUP

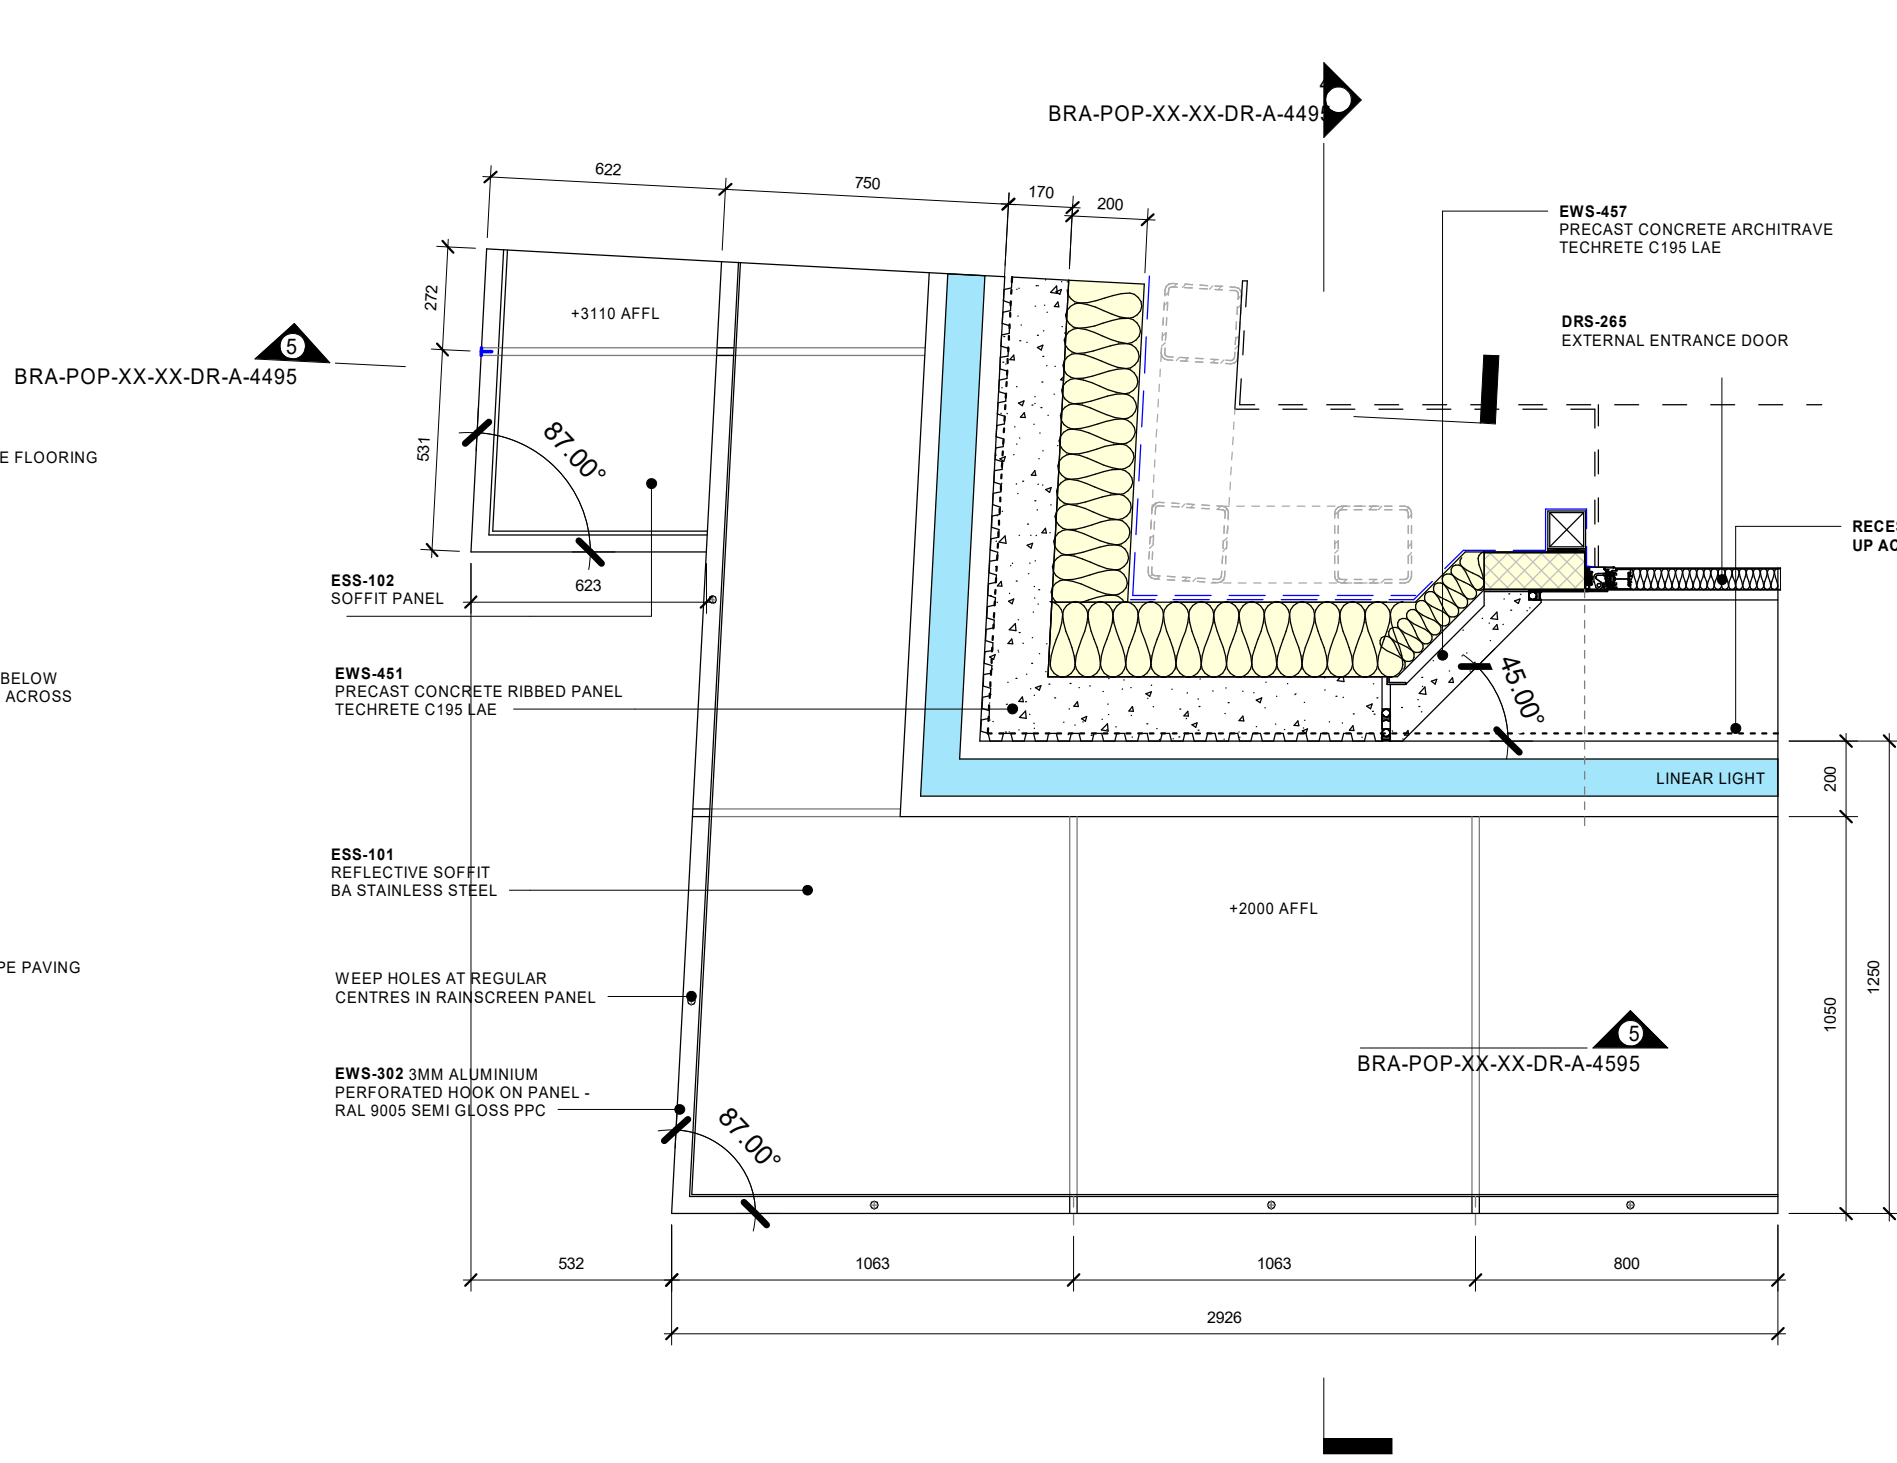

3 RCP PLAN - MOCKUP

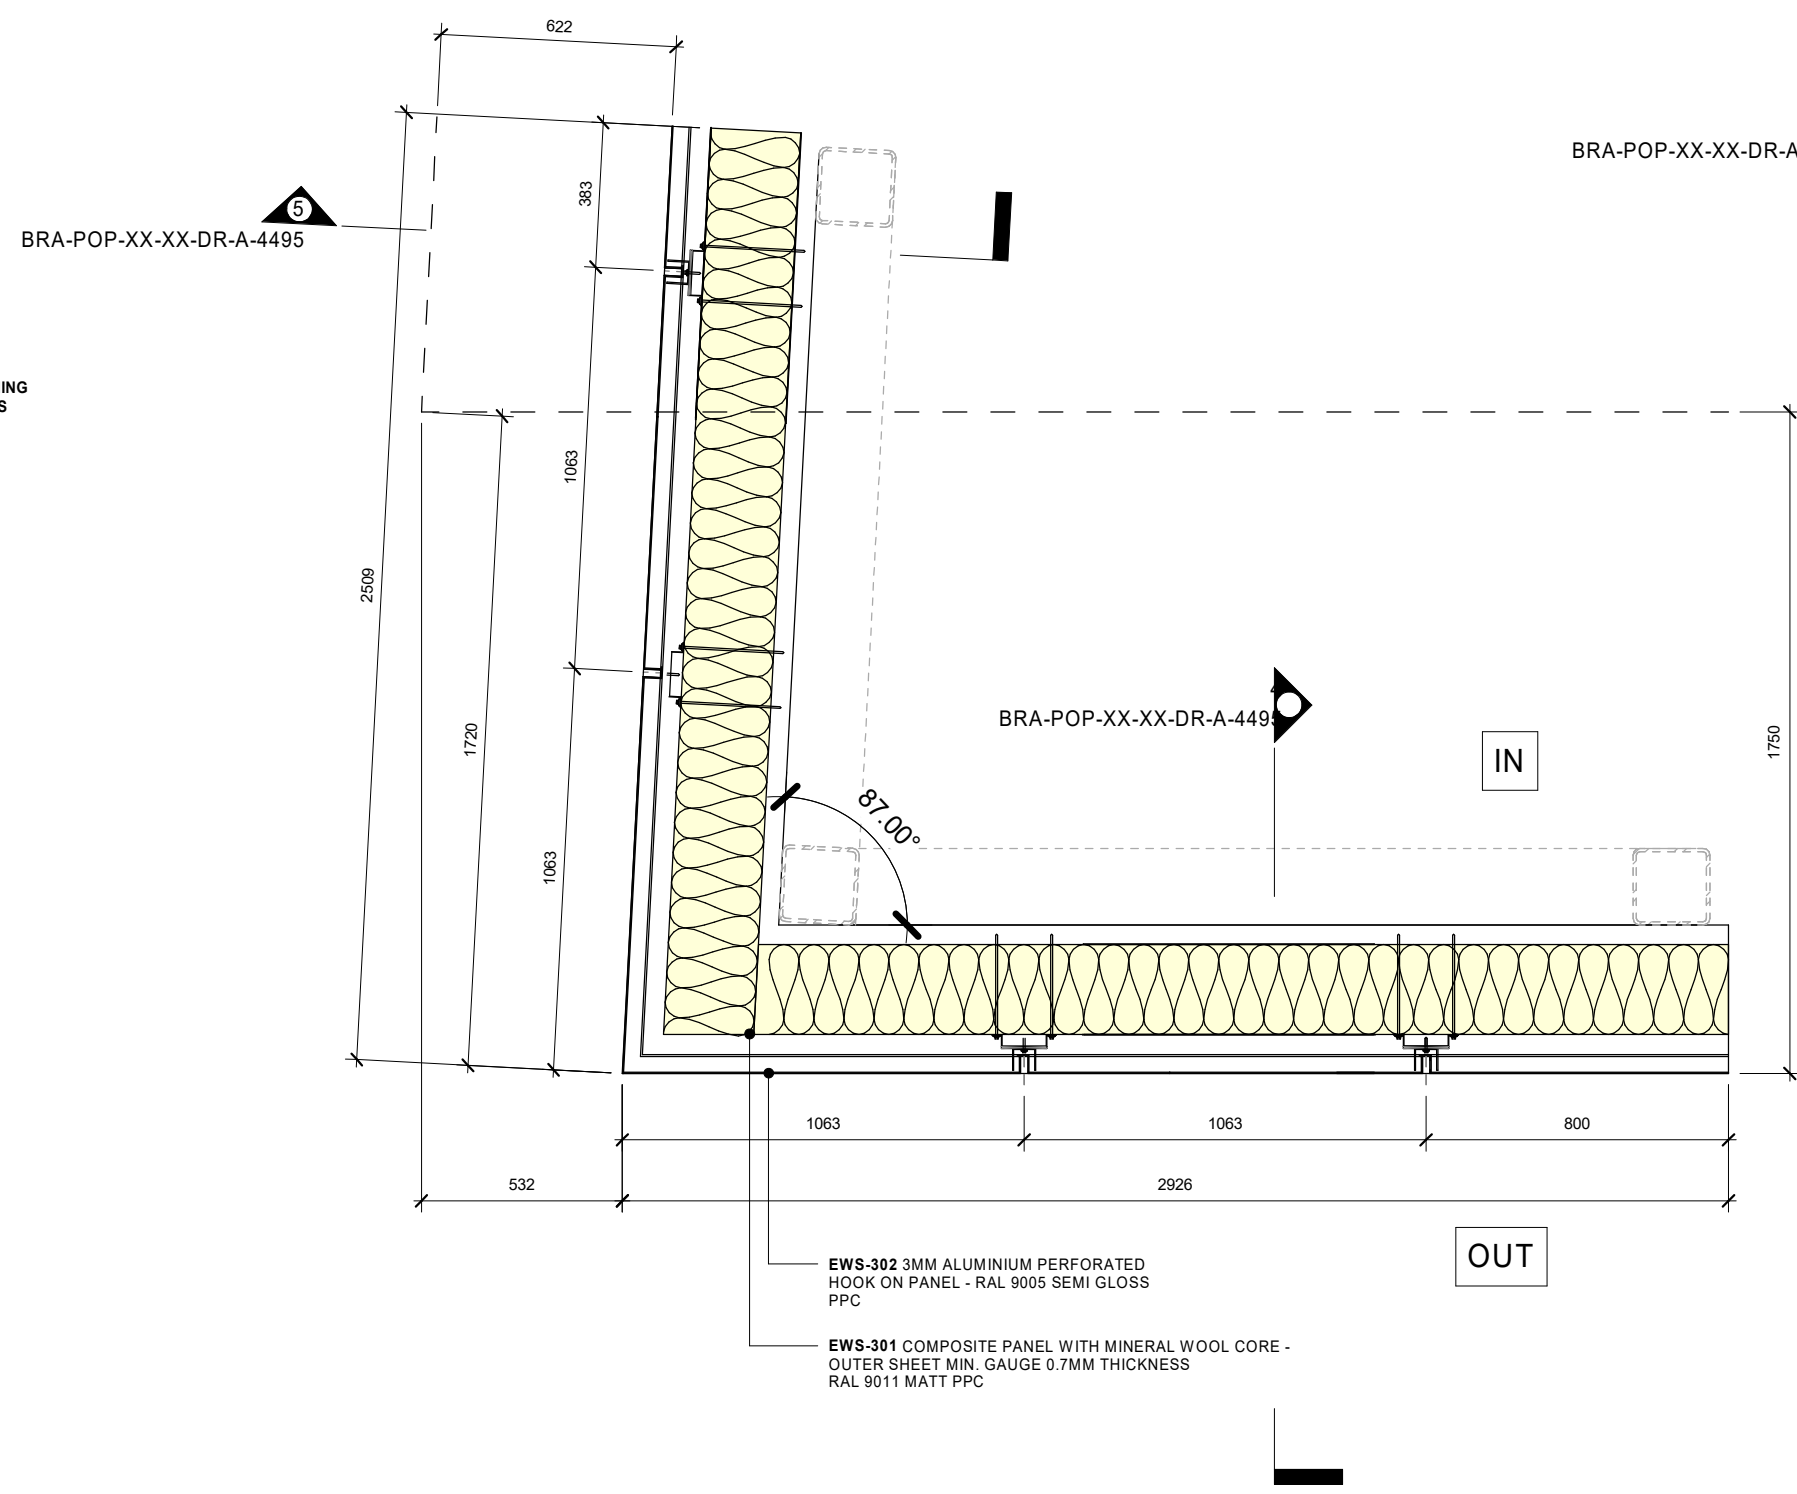

6 LEVEL P01 PLAN - MOCKUP

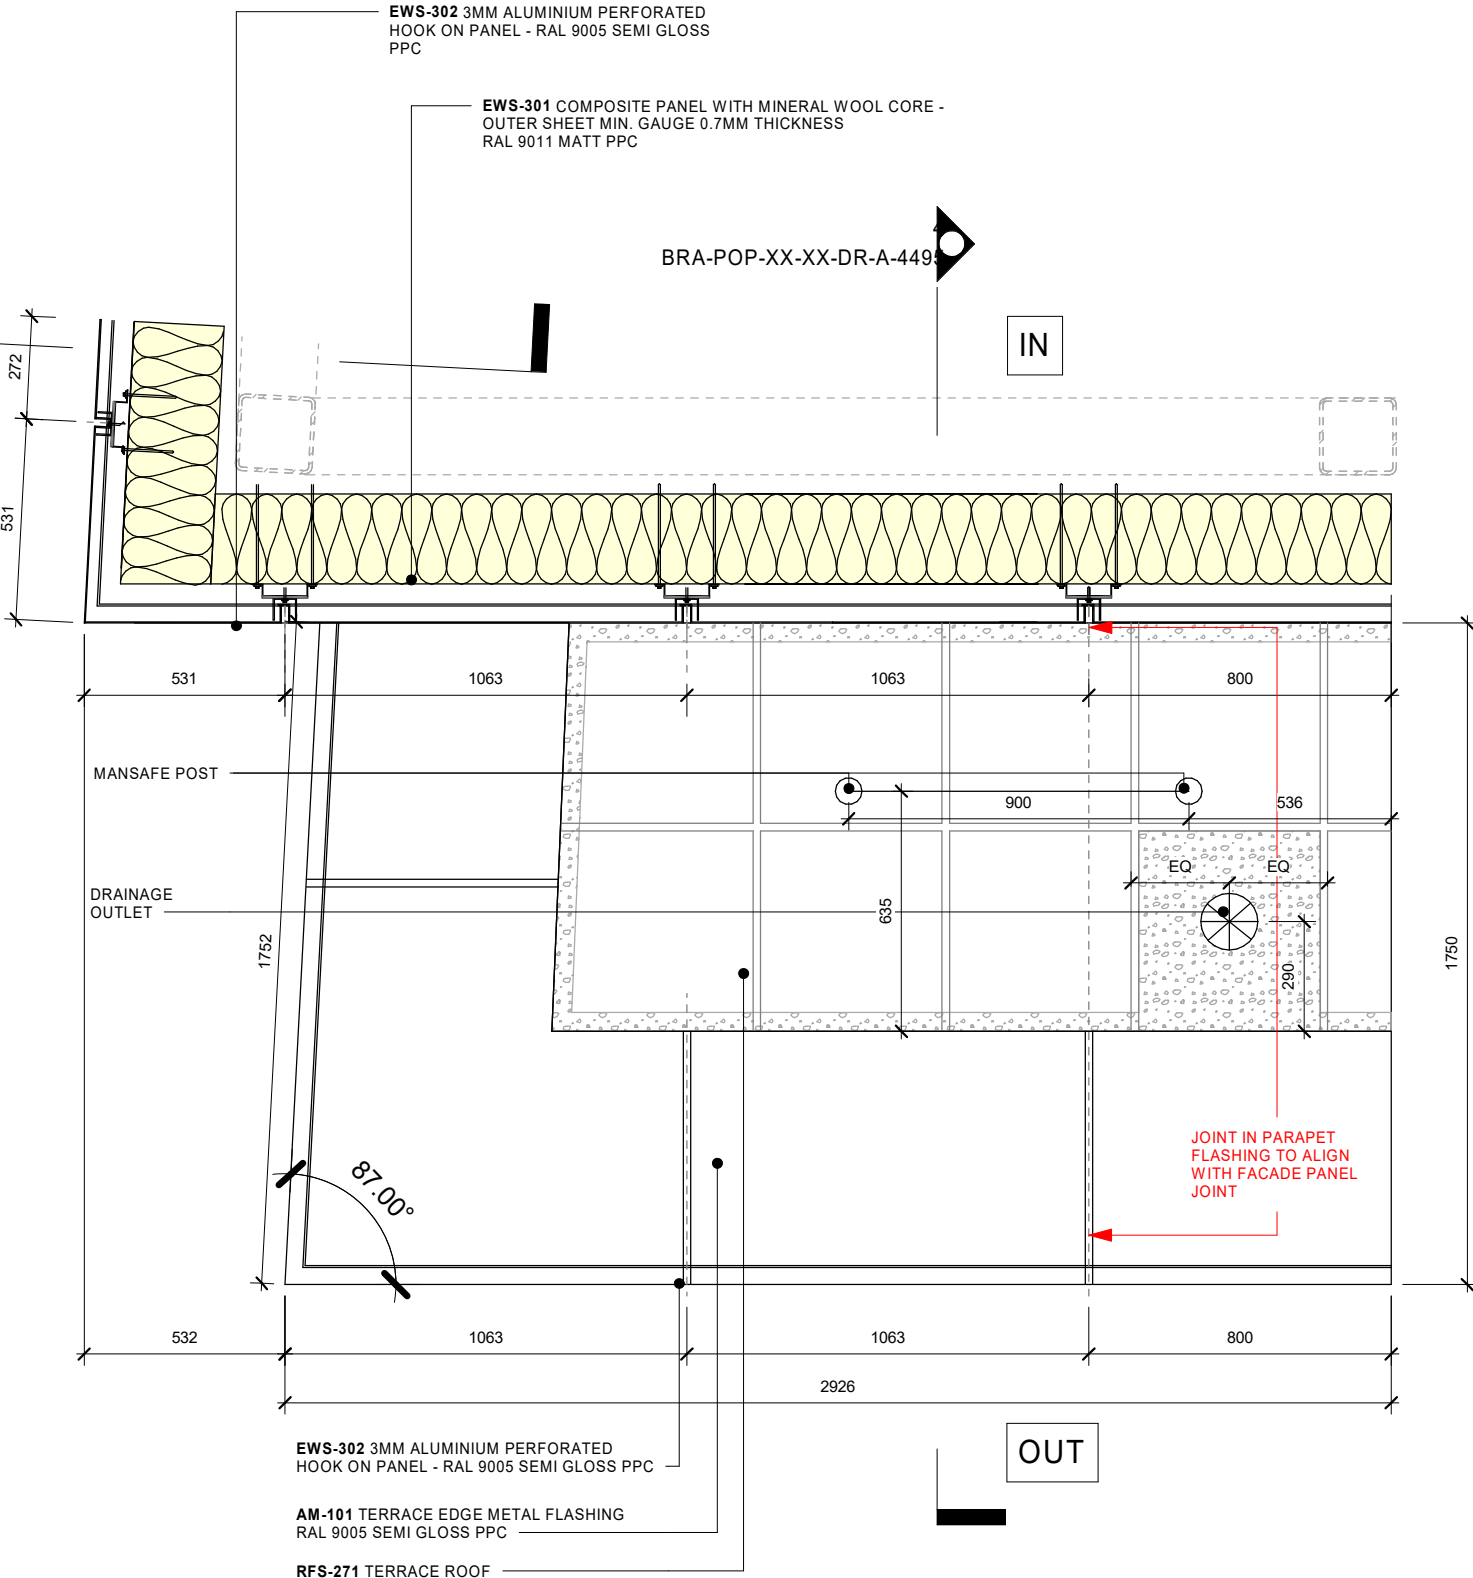

7 LEVEL P02 PLAN - MOCKUP

Suitability Code (as defined in ISO 19659-2:2018)

Work in Progress (WIP)

S0 - Under Review

Shared (Non-Contractual)

S1 - Suitable for co-ordination

S2 - Suitable for information

S3 - Suitable for review & comment

S4 - Suitable for stage approval

S5 - Withdrawn

S6 - Suitable for PIM authorisation

S7 - Suitable for AIM authorisation

Published (Contractual)

A1, A2, A3, Etc. - Authorised and accepted

B1, B2, B3, Etc. - Partial sign-off (with comments)

Published (AIM Acceptance)

CR - As constructed record document

KEY PLAN



FAÇADE MOCKUP

- EW5-451 TYPICAL RIBBED PANEL (THERMAL)
- EW5-455 A TYPICAL RIBBED CORNER PANEL (THERMAL)
- EW5-456 TYPICAL ARCHITRAVE (LIFT)
- ESS-468 TYPICAL SOFFIT PANEL
- EW5-467 RECESSED WALL CLADDING
- INS-301 SLAB EDGE INSULATION
- EW5-302 COMPOSITE PANEL
- EW5-302 PERFORATED PANEL - TYPE A
- ESS-101 SOFFIT PANEL - MIRROR
- ESS-102 SOFFIT PANEL - PERFORATED
- ESS-111 SOFFIT PANEL - COMPOSITE
- DWS-365 ENTRANCE DOORS
- RFS-271 TERRACE ROOF
- AM-101 TERRACE EDGE METAL FLASHING
- ASE-101 LINE ACCESS SYSTEM

MEP ITEMS TO BE INCLUDED IN THE MOCK-UP:

- LIGHTNING PROTECTION TAPE
- WFI UNIT (IF MOUNTED ON MAIN FAÇADE/SOFFIT - TBC BY CLIENT)
- CCTV
- BIRD DETERRENT (SUPER-SOONIC SOUND)
- L01 SOFFIT LIGHT (OPTELMA QUAD 100)
- DRAINAGE OUTLET TO ROOF
- DAKTRONICS FAÇADE EMBEDDED LED STICK SYSTEM
- CHAUVET ARCHITECTURAL WASH LIGHT

NOTES

- ALL STRUCTURE SHOWN INDICATIVELY ONLY - REFER TO S.E.'S DRAWINGS FOR SIZE AND SETTING OUT
- DRAWING ASSUMES VE 16.09 FOR ROOF-BUILDUP TAKEN. INSULATION THICKNESS TO BE VERIFIED AGAINST U-VALUE REQUIREMENTS
- PRECAST FAÇADE TO INCLUDE ANTI-GRAFFITI TREATMENT ON 50% OF SURFACE ONLY TO ALLOW FOR COMPARISON. PLEASE REFER TO SPECIFICATION SECTION H42 (P.9) AND BH FAÇADE REPORT (P.53)
- TO BE READ IN CONJUNCTION WITH FAÇADE MATRIX DOCUMENT BRA-PP-22-ZZ-3H-A-7400



© COPYRIGHT. ALL RIGHTS RESERVED.

THIS WORK IS COPYRIGHT AND CANNOT BE REPRODUCED OR COPIED IN ANY FORM OR BY ANY MEANS, WITHOUT THE WRITTEN PERMISSION OF POPULOUS. ANY LICENSE, EXPRESS OR IMPLIED, TO USE THIS DOCUMENT FOR ANY PURPOSES WITHOUT THE WRITTEN PERMISSION OF THE INSTRUCTING PARTY.

USE PLANNED DIMENSIONS IN PREFERENCE TO SCALED. CHECK ALL DIMENSIONS ON SITE BEFORE FABRICATION OR SETTING OUT.

POPULOUS®

14 BLADES COURT | DEodar ROAD | LONDON | SW15 2NU | UNITED KINGDOM
TELEPHONE +44 (0)20 8874 7668 FACSIMILE +44 (0)20 8874 7475
ALL PRODUCTION & INTELLECTUAL PROPERTY RIGHTS RESERVED © POPULOUS 2020

REVISIONS

REV	DATE	DESCRIPTION
P00	08.01.2021	ISSUED FOR STAGE 4B - MOCK-UP
P01	18.02.2021	ISSUED FOR STAGE 4B - MOCK-UP
P02	02.03.2021	ISSUED FOR STAGE 4B - MOCK-UP - ADJUSTED TO SUBCONTRACTOR ADVISE

Project Name **OVG Manchester**

the **FAÇADE MOCK-UP**

scale As indicated @ A0 draw GK Project no. 4933 Subtitle **S2**

reference **BRA-POP-XX-XX-DR-A-4495** P02

THIS DRAWING IS ONLY TO SCALE IF IT IS REPRODUCED AT THE CORRECT PAPER SIZE

1:20@A0

ALL INTERNAL LAYOUTS AND USES ARE SHOWN FOR ILLUSTRATIVE PURPOSES ONLY AND ARE NOT FOR DETERMINATION