


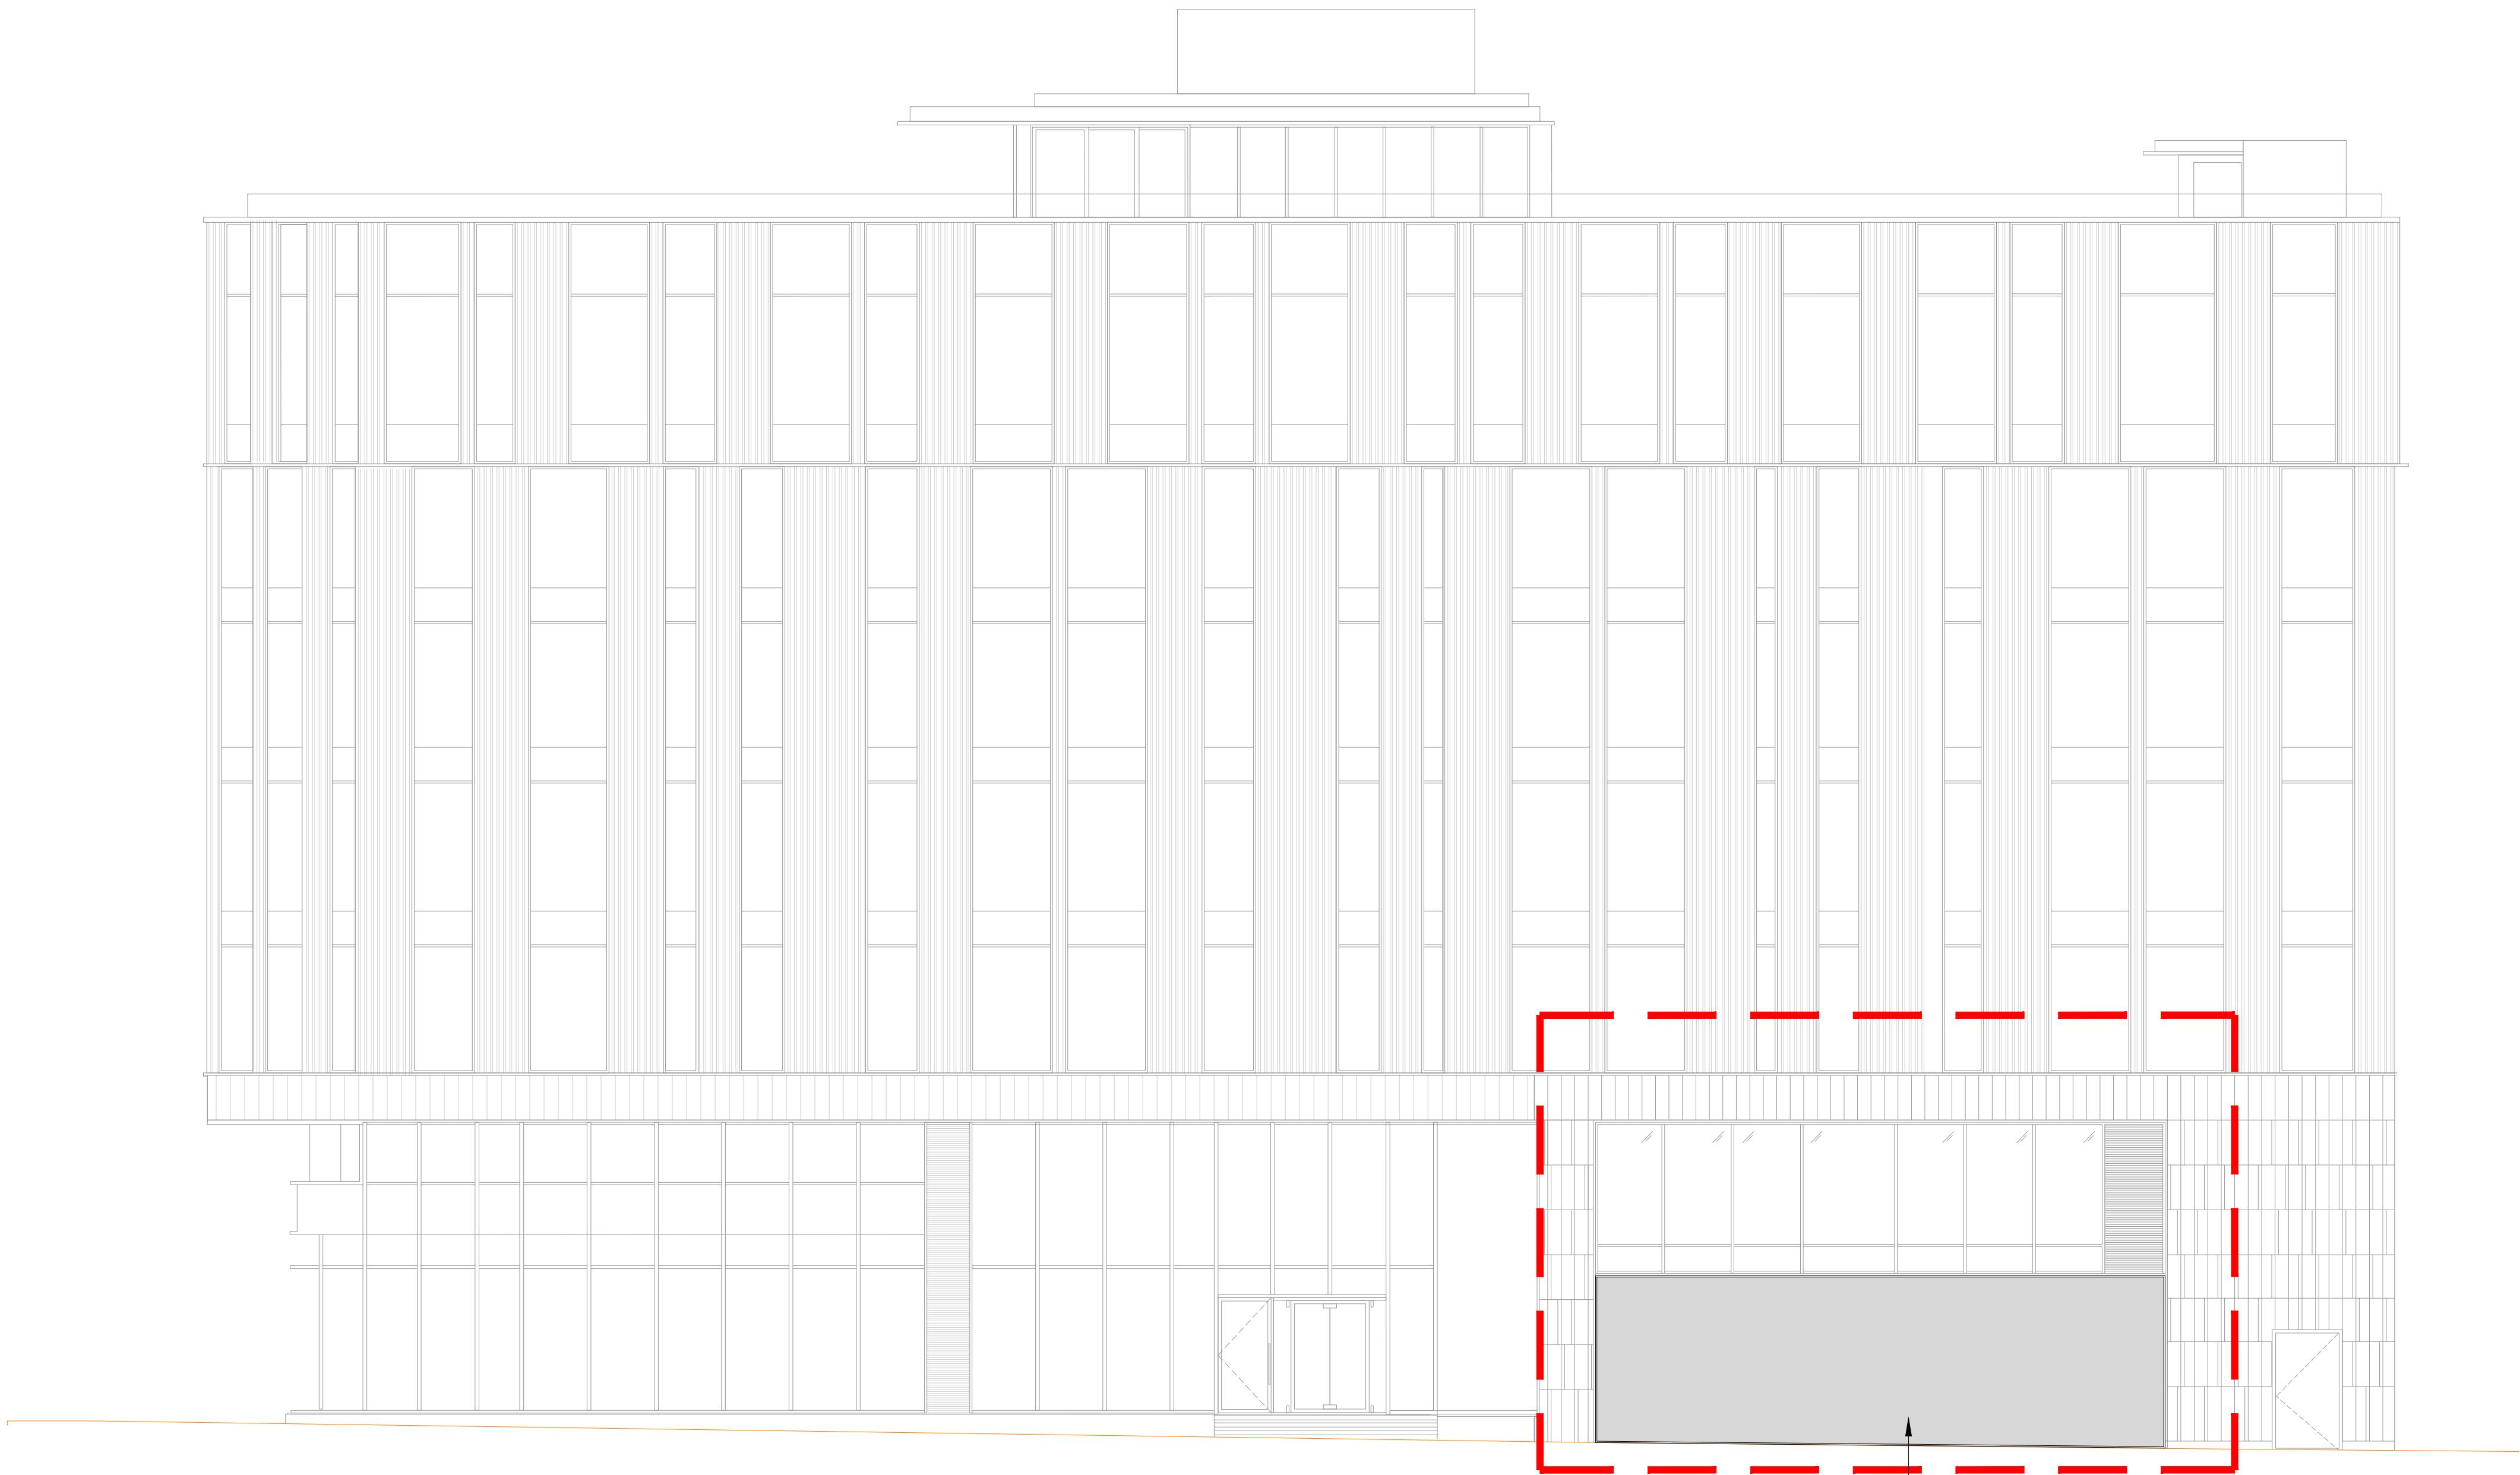

01 EXISTING MOUNT STREET ELEVATION
Scale: 1:100@A1

EXISTING HOARDING TO BE REMOVED

NOTES

THIRDWAY INTERIORS DO NOT ACCEPT LIABILITY FOR ANY ERRORS AND OMISSIONS ARISING FROM THE PREPARATION OF BASE BUILD DRAWINGS WHICH ARE DERIVED FROM ORIGINAL MATERIAL PROVIDED BY OTHERS.

ALL DISCREPANCIES ARE TO BE REPORTED TO THIRDWAY INTERIORS.

GRID LINES ARE FOR REFERENCE PURPOSES ONLY.

ALL DIMENSIONS TO BE VERIFIED BY CONTRACTOR ON SITE PRIOR TO ANY WORKS COMMENCING.

DO NOT SCALE FROM THIS DRAWING.

THIS DOCUMENT IS THE PROPERTY OF THIRDWAY INTERIORS. COPYRIGHT IS RESERVED BY THEM, AND THE DRAWING IS ISSUED ON THE CONDITION THAT IT IS NOT COPIED, REPRODUCED OR RETAINED BY, NOR DISCLOSED TO ANY UNAUTHORISED PERSON, EITHER WHOLLY OR IN PART, WITHOUT THE CONSENT IN WRITING FROM  THIRDWAY INTERIORS

STATUS

- ☒ Approval / Comment
- ☐ Information Only
- ☐ Building Control
- ☐ Contract
- ☐ Construction
- ☐ As-Built

REVISION DETAIL

REV	DETAIL	BY	DATE
P1	FIRST DRAWING ISSUE	RC	07.12.21

CLIENT

– WINDMILL GREEN

PROJECT ADDRESS

24 MOUNT STREET
MANCHESTER
M2 3NN

DRAWING TITLE

GROUND FLOOR
EXISTING MOUNT STREET ELEV
FOR APPROVAL

DWG NO: 00000–00–E.01

REVISION: P1

SCALE @A1: 1:100 @ A3: 1:200

DATE: 07.12.2021

DRAWN BY: RC

CHECKED BY: AC

