

Legend:

- 30 minutes fire resistance
- 60 minutes fire resistance
- 90 minutes fire resistance
- 120 minutes fire resistance
- 240 minutes fire resistance
- 30 minute fire door with smoke seal
- 30 minute fire door without smoke seal
- 60 minute fire door with smoke seal
- 60 minute fire door without smoke seal
- 90 minute fire door with smoke seal
- 90 minute fire door without smoke seal
- 120 minutes fire door with smoke seal
- 240 minute door with smoke seal

P2	14/01/22	Stage 2 Preliminary Issue Updated to current architect plans	OO	RMF
P1	06/12/21	Stage 2 Preliminary Issue	RMF	RMF
Rev	Date	Description	Drawn	Checked



hilsonmoran.com info@hilsonmoran.com

Client
Bruntwood

Project
38-42 Mosley Street
Grade 2* Listed Building Refurbishment

Drawing Title
Fire Strategy
Basement Level
Fire Compartmentation Mark-Up

Scale	Sheet Size	Checked	Approved
NTS	A3		

Status
RIBA STAGE 2


Drawing No.	Rev
MOSE-HMM-ZZ-B1-SK-F-0211	P2

Software: Bluebeam Revu

General note for lifts (applicable to all levels):
In order to maintain the compartmentation between floors one of the following provisions concerning the lifts in the building should be met:
1-Lift lobbies should should be deemed as a protected shaft and it should be 60 min fire-resisting.
Or,
2-Fire curtains (60 min) between the lifts and accommodation areas should be provided (e.g. first floor).

The tenant will be taking the unit 'as viewed' therefore fire safety provision will be undertaken as part of their fitout application.

General notes for shafts (applicable to all levels):
Fire separation is required between the shafts if those have different purpose. In the case of the presence of shafts with different uses, the walls between those should be fire rated.

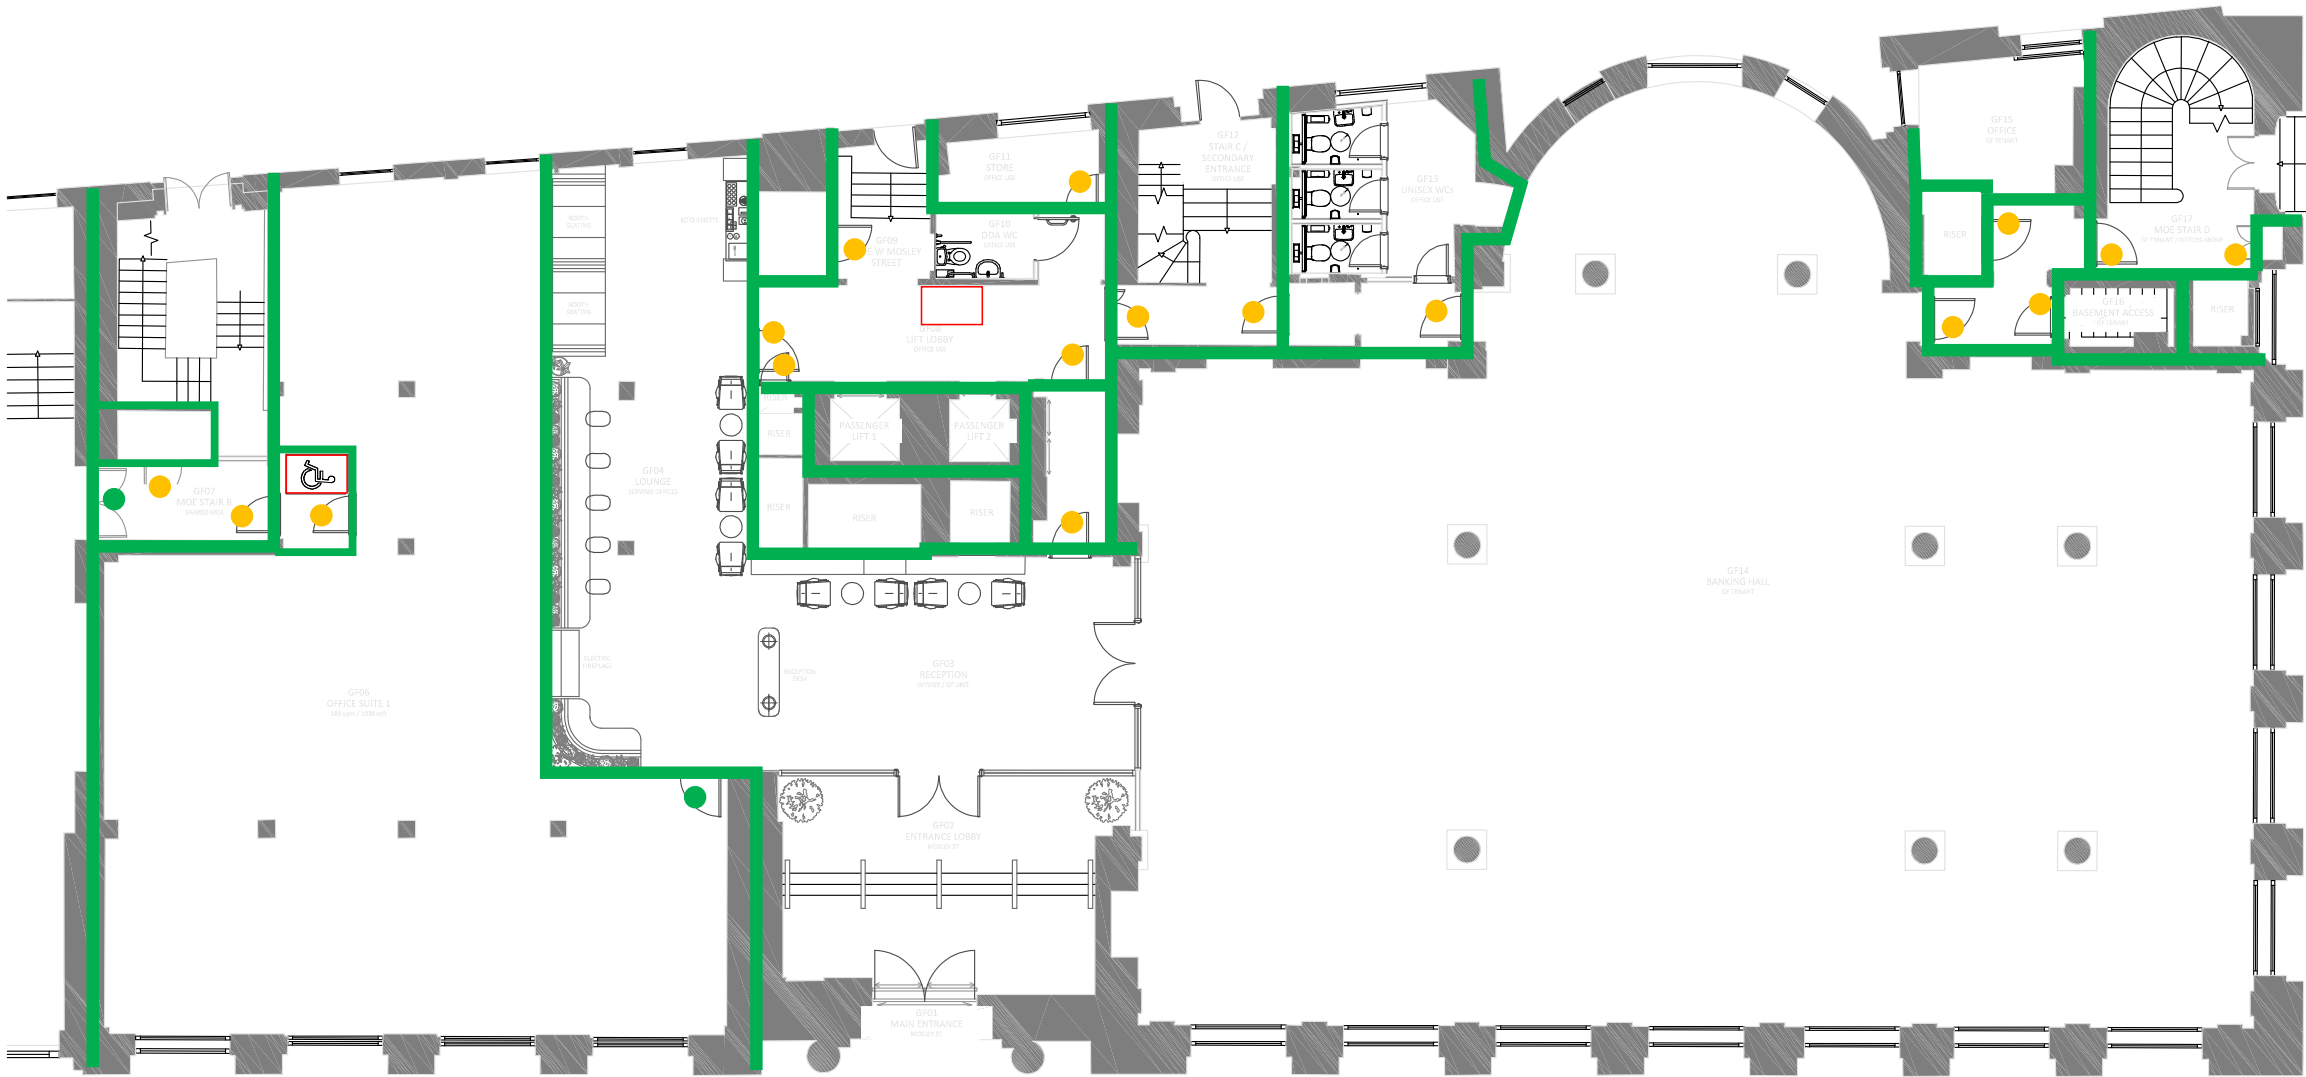

Do not scale from this drawing.
Verify dimensions by site measurement.
Read this drawing in conjunction with the latest architectural and structural drawings.
This drawing is based on the following information:-

- Legend:**
- 30 minutes fire resistance
 - 60 minutes fire resistance
 - 90 minutes fire resistance
 - 120 minutes fire resistance
 - 240 minutes fire resistance
 - 30 minute fire door
 - 30 minute fire door without smoke seal
 - 60 minute fire door with smoke seal
 - 60 minute fire door without smoke seal
 - 90 minute fire door with smoke seal
 - 90 minute fire door without smoke seal
 - 120 minutes fire door with smoke seal
 - 240 minute door with smoke seal

P2	14/01/22	Stage 2 Preliminary Issue Updated to current architect plans	OO	RMF
P1	06/12/21	Stage 2 Preliminary Issue	RMF	RMF
Rev	Date	Description	Drawn	Checked

H | M


hilsonmoran.cominfo@hilsonmoran.com

Client
Bruntwood

Project
38-42 Mosley Street
Grade 2* Listed Building Refurbishment

Drawing Title
Fire Strategy
Ground Floor
Fire Compartmentation Mark-Up

Scale	Sheet Size	Checked	Approved
NTS	A3		
Status	RIBA STAGE 2		
Drawing No.	Rev		
MOSE-HMM-ZZ-GF-SK-F-0212	P2		

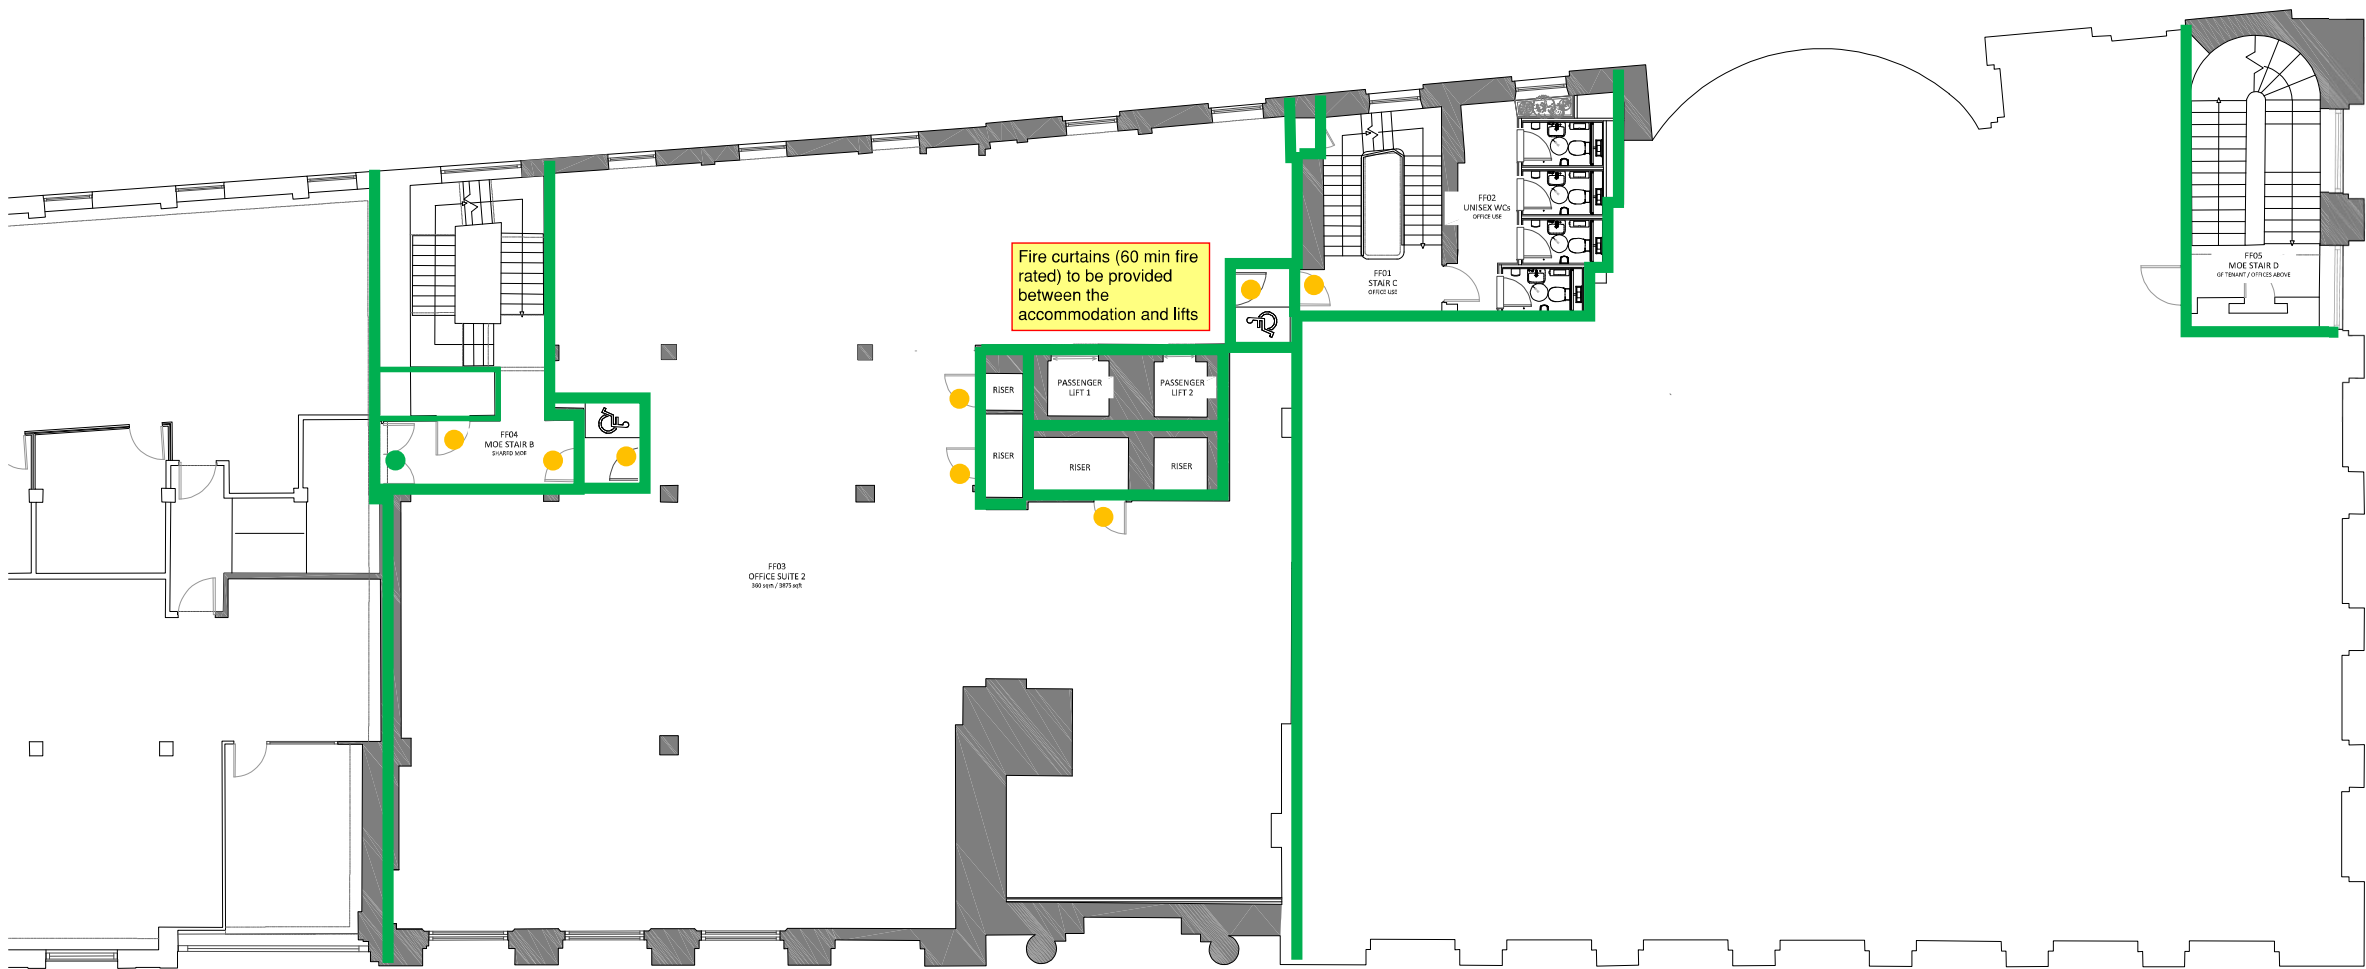

Do not scale from this drawing.
Verify dimensions by site measurement.
Read this drawing in conjunction with the latest architectural and structural drawings.
This drawing is based on the following information:-

- Legend:**
- 30 minutes fire resistance
 - 60 minutes fire resistance
 - 90 minutes fire resistance
 - 120 minutes fire resistance
 - 240 minutes fire resistance
 - 30 minute fire door
 - 30 minute fire door without smoke seal
 - 60 minute fire door with smoke seal
 - 60 minute fire door without smoke seal
 - 90 minute fire door with smoke seal
 - 90 minute fire door without smoke seal
 - 120 minutes fire door with smoke seal
 - 240 minute door with smoke seal

P2	14/01/22	Stage 2 Preliminary Issue Updated to current architect plans	OO	RMF
P1	06/12/21	Stage 2 Preliminary Issue	RMF	RMF
Rev	Date	Description	Drawn	Checked

H | M

hilsonmoran.cominfo@hilsonmoran.com

Client
Bruntwood

Project
38-42 Mosley Street
Grade 2* Listed Building Refurbishment

Drawing Title
Fire Strategy
1st Floor
Fire Compartmentation Mark-Up

Scale	Sheet Size	Checked	Approved
NTS	A3		
Status	RIBA STAGE 2		
Drawing No.	MOSE-HMM-ZZ-01-SK-F-0213		
Rev	P2		

Software: Bluebeam Revu



Do not scale from this drawing.
Verify dimensions by site measurement.
Read this drawing in conjunction with the latest architectural and structural drawings.
This drawing is based on the following information:-

- Legend:**
- 30 minutes fire resistance
 - 60 minutes fire resistance
 - 90 minutes fire resistance
 - 120 minutes fire resistance
 - 240 minutes fire resistance
 - 30 minute fire door
 - 30 minute fire door without smoke seal
 - 60 minute fire door with smoke seal
 - 60 minute fire door without smoke seal
 - 90 minute fire door with smoke seal
 - 90 minute fire door without smoke seal
 - 120 minutes fire door with smoke seal
 - 240 minute door with smoke seal

P2	14/01/22	Stage 2 Preliminary Issue Updated to current architect plans	OO	RMF
P1	06/12/21	Stage 2 Preliminary Issue	RMF	RMF
Rev	Date	Description	Drawn	Checked

H | M


hilsonmoran.cominfo@hilsonmoran.com

Client
Bruntwood

Project
38-42 Mosley Street
Grade 2* Listed Building Refurbishment

Drawing Title
Fire Strategy
2nd Floor
Fire Compartmentation Mark-Up

Scale	Sheet Size	Checked	Approved
NTS	A3		
Status	RIBA STAGE 2		
Drawing No.	MOSE-HMM-ZZ-02-SK-F-0214		
Rev	P2		

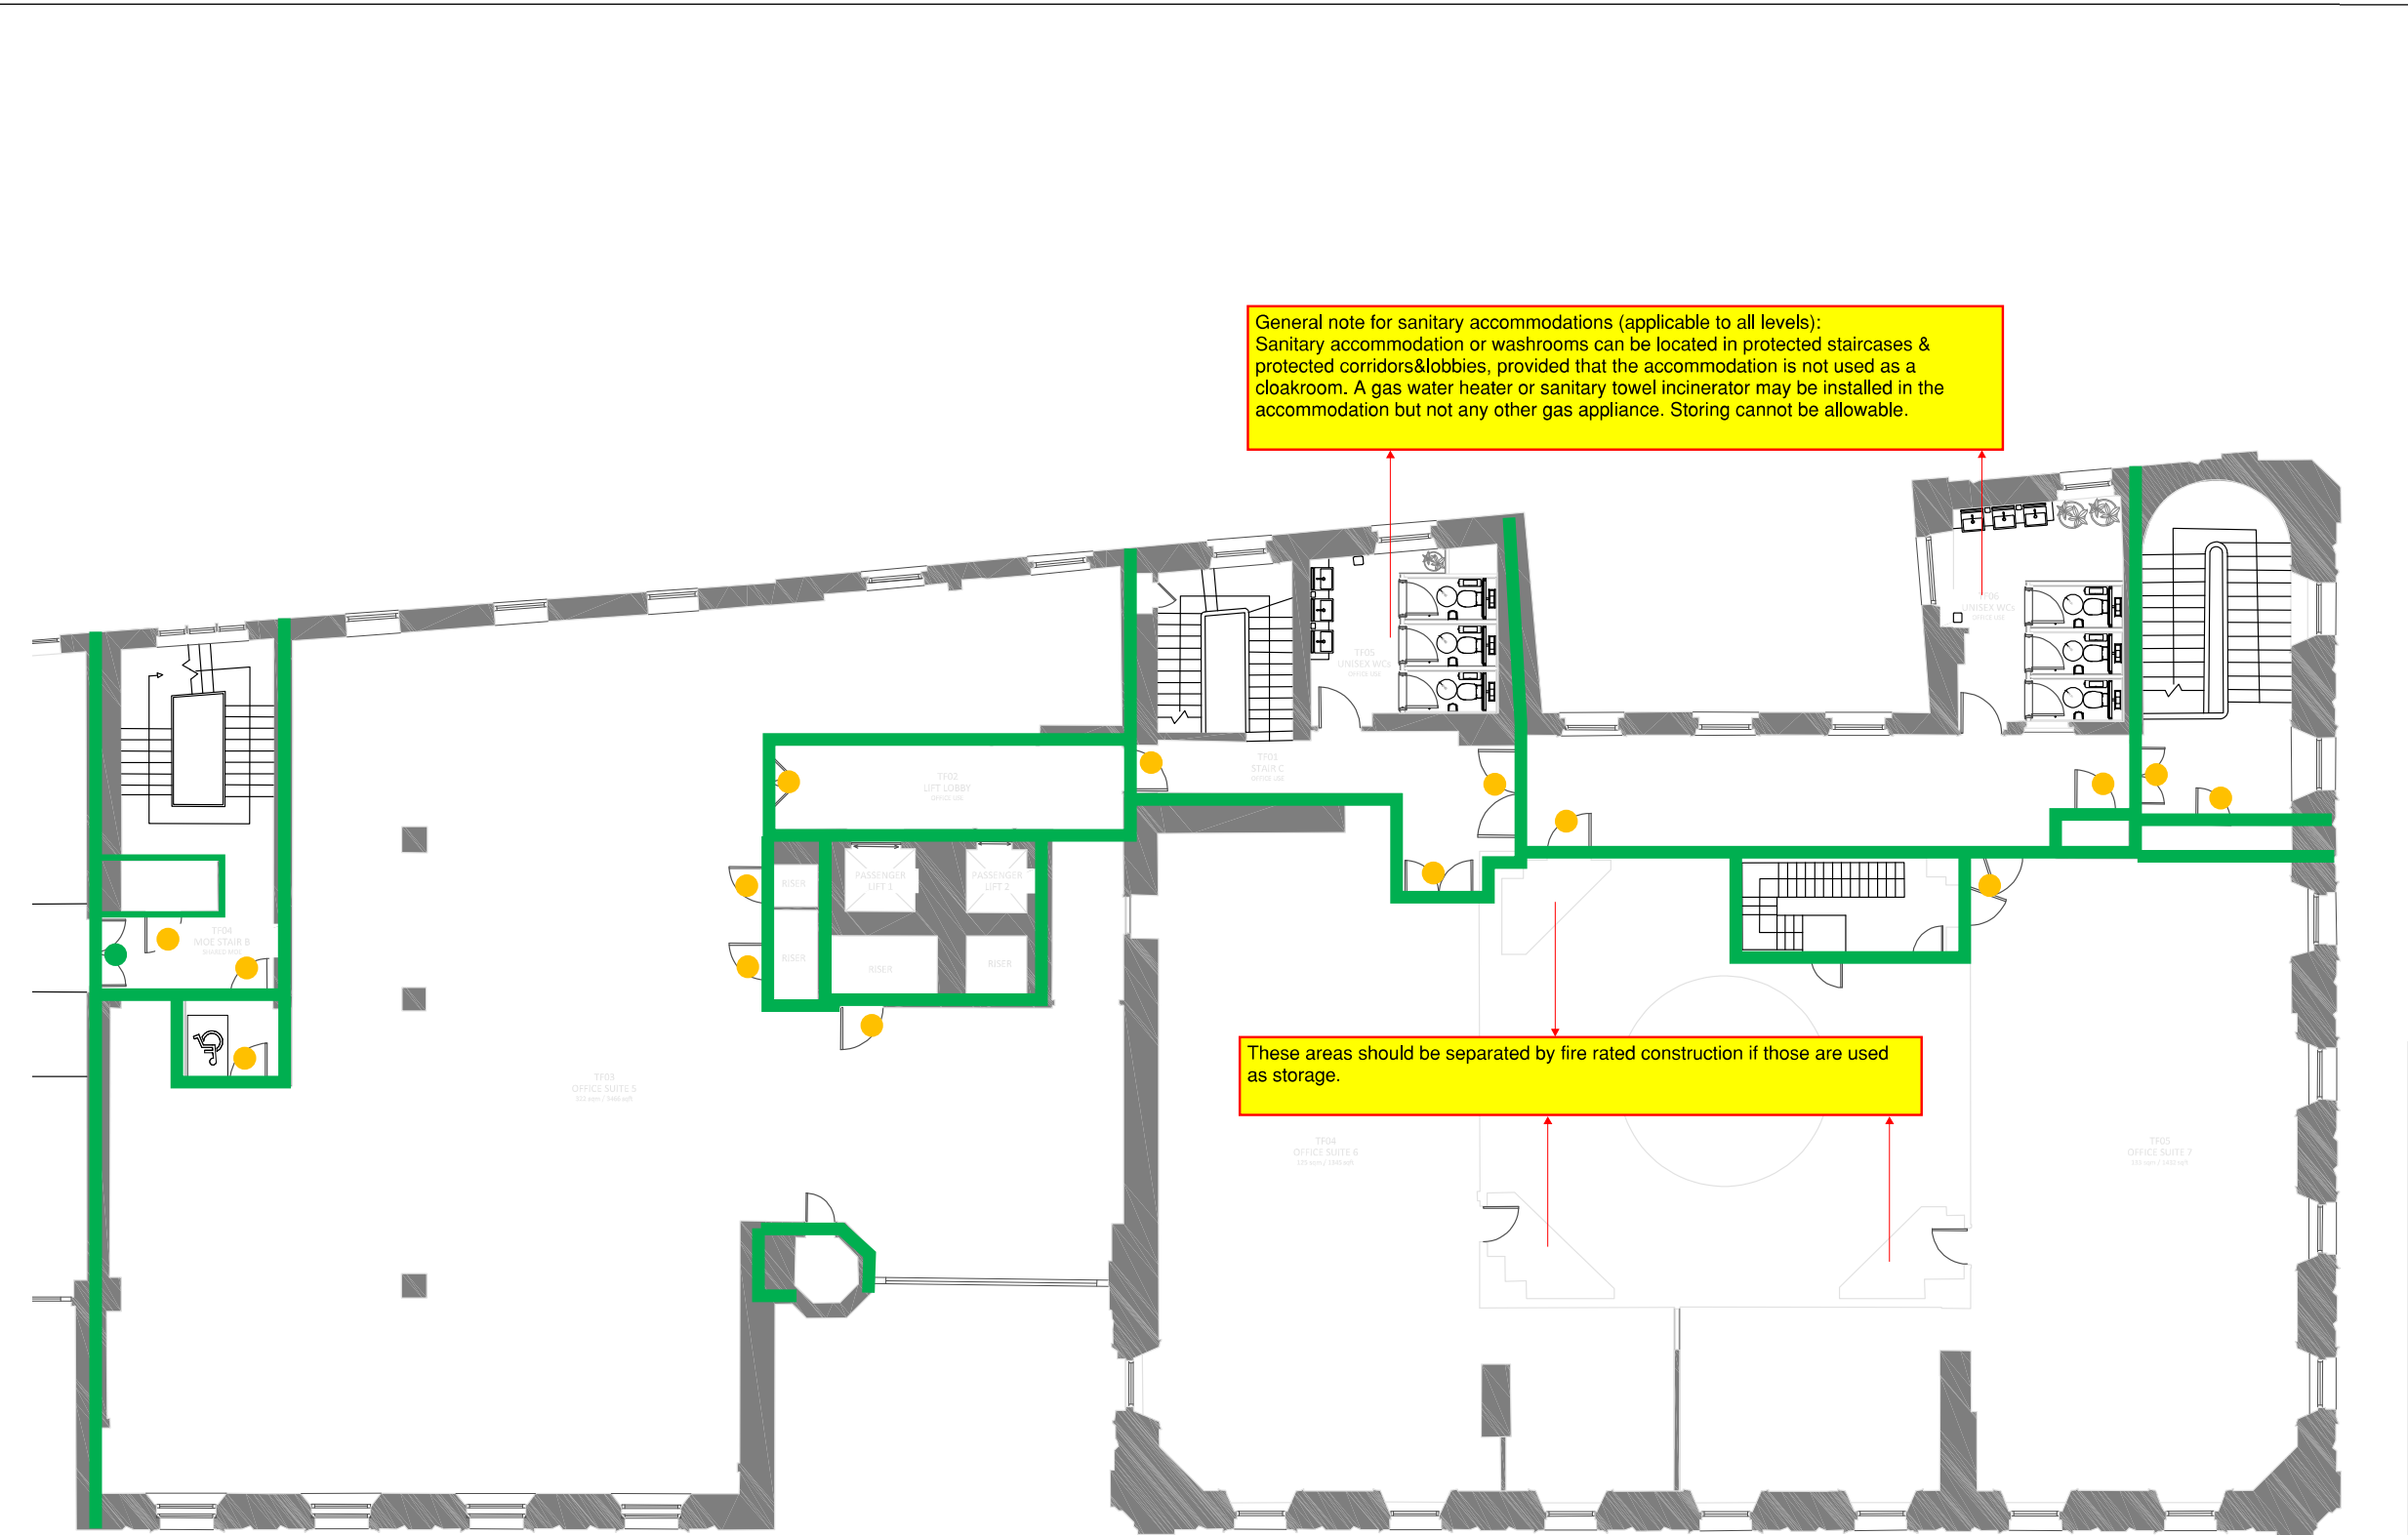

Do not scale from this drawing.
Verify dimensions by site measurement.
Read this drawing in conjunction with the latest architectural and structural drawings.
This drawing is based on the following information:-

- Legend:**
- 30 minutes fire resistance
 - 60 minutes fire resistance
 - 90 minutes fire resistance
 - 120 minutes fire resistance
 - 240 minutes fire resistance
 - 30 minute fire door
 - 30 minute fire door without smoke seal
 - 60 minute fire door with smoke seal
 - 60 minute fire door without smoke seal
 - 90 minute fire door with smoke seal
 - 90 minute fire door without smoke seal
 - 120 minutes fire door with smoke seal
 - 240 minute door with smoke seal

P2	14/01/22	Stage 2 Preliminary Issue Updated to current architect plans	OO	RMF
P1	06/12/21	Stage 2 Preliminary Issue	RMF	RMF
Rev	Date	Description	Drawn	Checked

H | M

hilsonmoran.cominfo@hilsonmoran.com

Client
Bruntwood

Project
38-42 Mosley Street
Grade 2* Listed Building Refurbishment

Drawing Title
Fire Strategy
3rd Floor
Fire Compartmentation Mark-Up

Scale	Sheet Size	Checked	Approved
NTS	A3		
Status	RIBA STAGE 2		
Drawing No.	MOSE-HMM-ZZ-03-SK-F-0215		
Rev	P2		