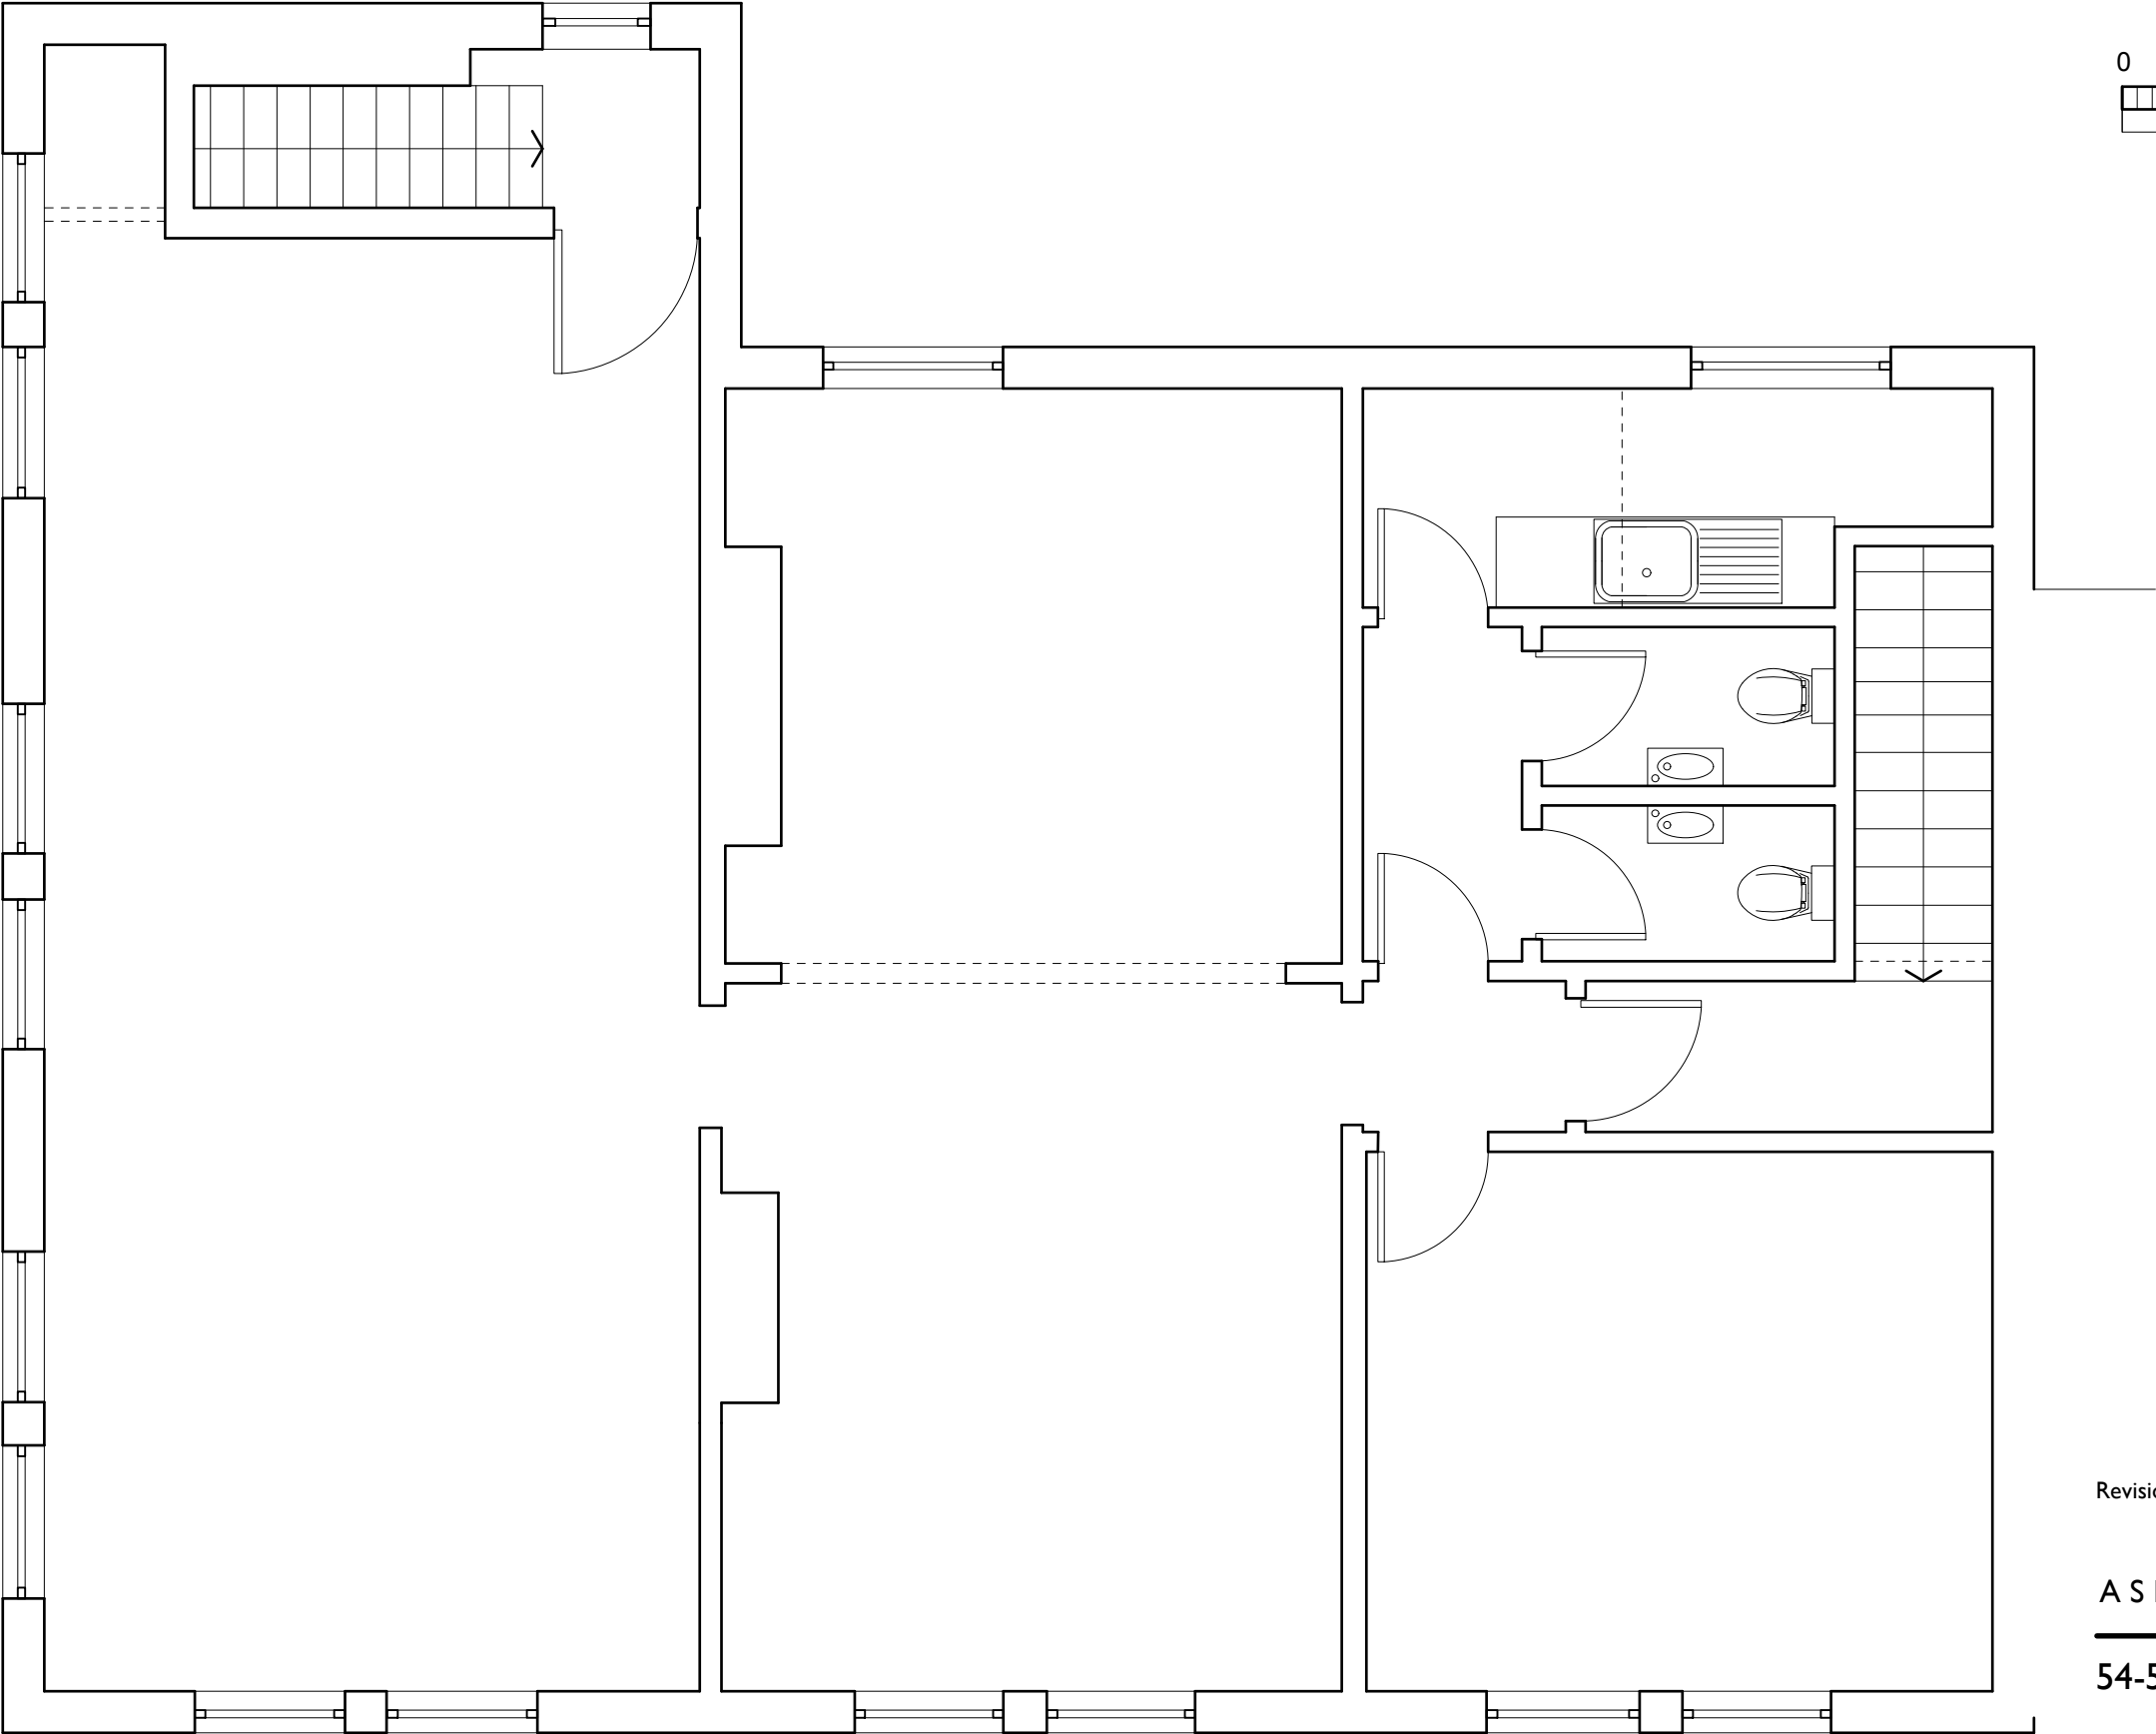


Revisions

ASHWORTH JACKSON & WALKER architects

54-58 Great Ancoats Street, Manchester

Second Floor Plan as Built

date	scale	drg no	rev
April 2011		1123.202	
1 Gilmore Street • Stockport • SK3 8DN • T: 0161 477 2616 • F: 0161 477 2617			