


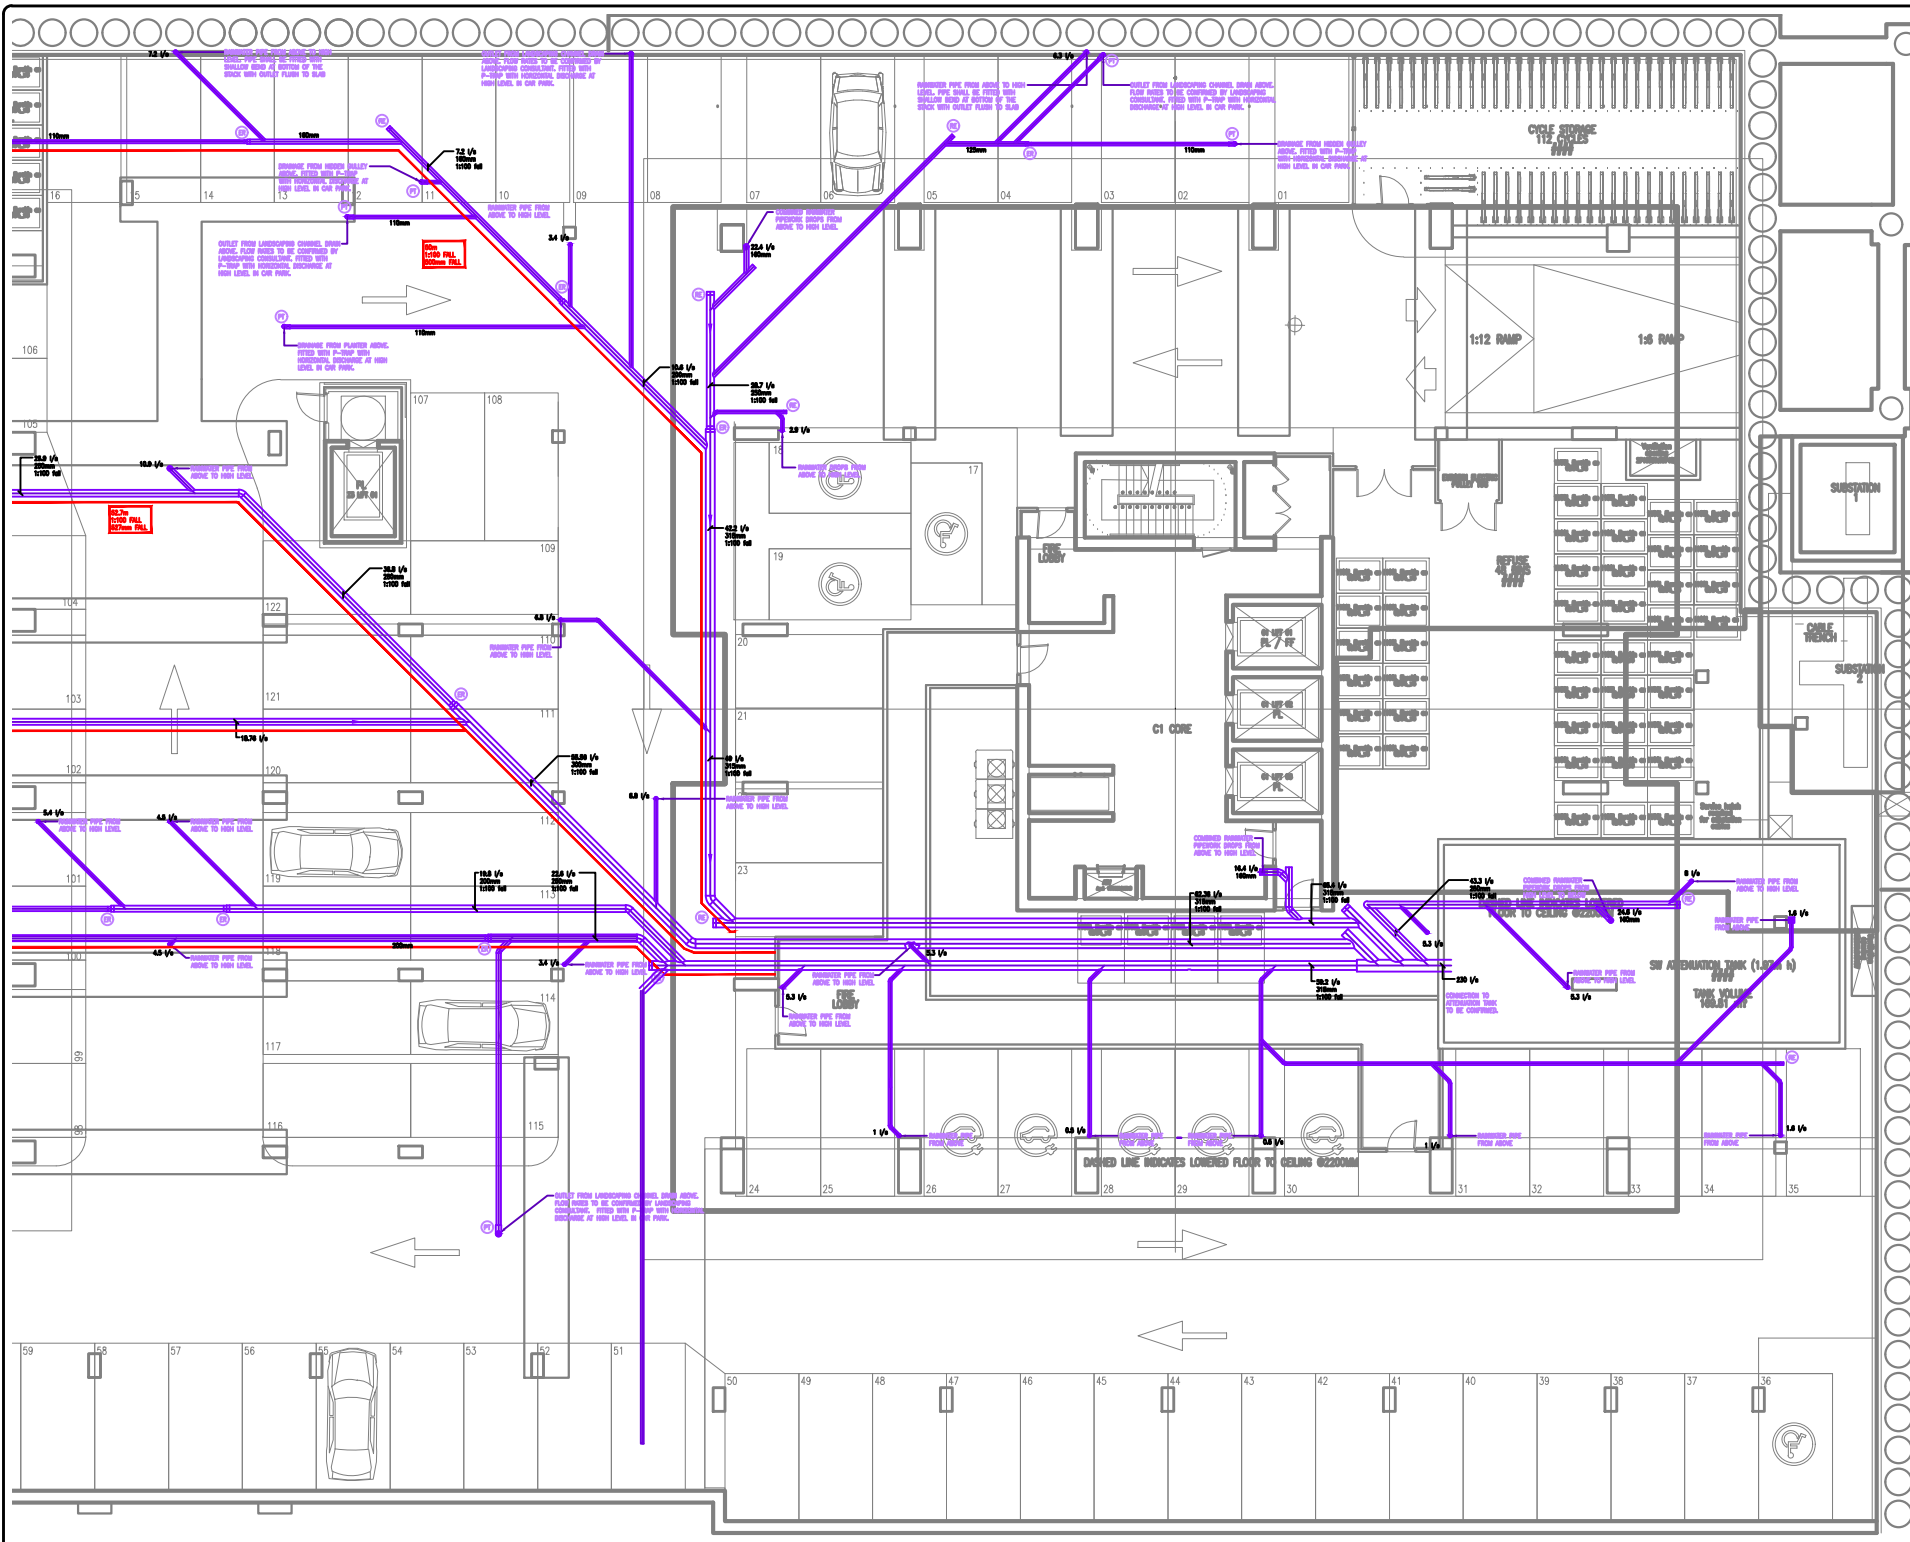

NOTES:

1. THIS DRAWING IS SUBJECT TO COPYRIGHT AND IS NOT TO BE REPRODUCED IN PART OR WHOLE WITHOUT PERMISSION.
2. DO NOT SCALE THIS DRAWING - CHECK ALL DIMENSIONS ON SITE.
3. THIS DRAWING SHALL BE USED IN CONJUNCTION WITH THE PROJECT SPECIFICATIONS AND ALL OTHER CONTRACT DOCUMENTATION.
4. ALL DIMENSIONS ARE IN MILLIMETERS UNLESS OTHERWISE STATED.

Date	Status/Amendments	By

RENAKER BUILD LIMITED

NQ Building, 47 Bengal Street, Manchester M4 6BB
www.renakerbuild.com

Client:

RENAKER

Project:

CROWN-STREET-PHASE1

Drawing Title:

As-Built Surface Water Drainage - Crown Street Phase 1

Drawn By:	Checked By:	Cost By:
G.M.	D.B.	G.M.

Scale:	Paper Size:	Date Created:
	A3	20/09/2021

Drawing Number:	Drawing Revision:
C2 - RBL - G580 - PI - B1 - 451	AS_BUILT