


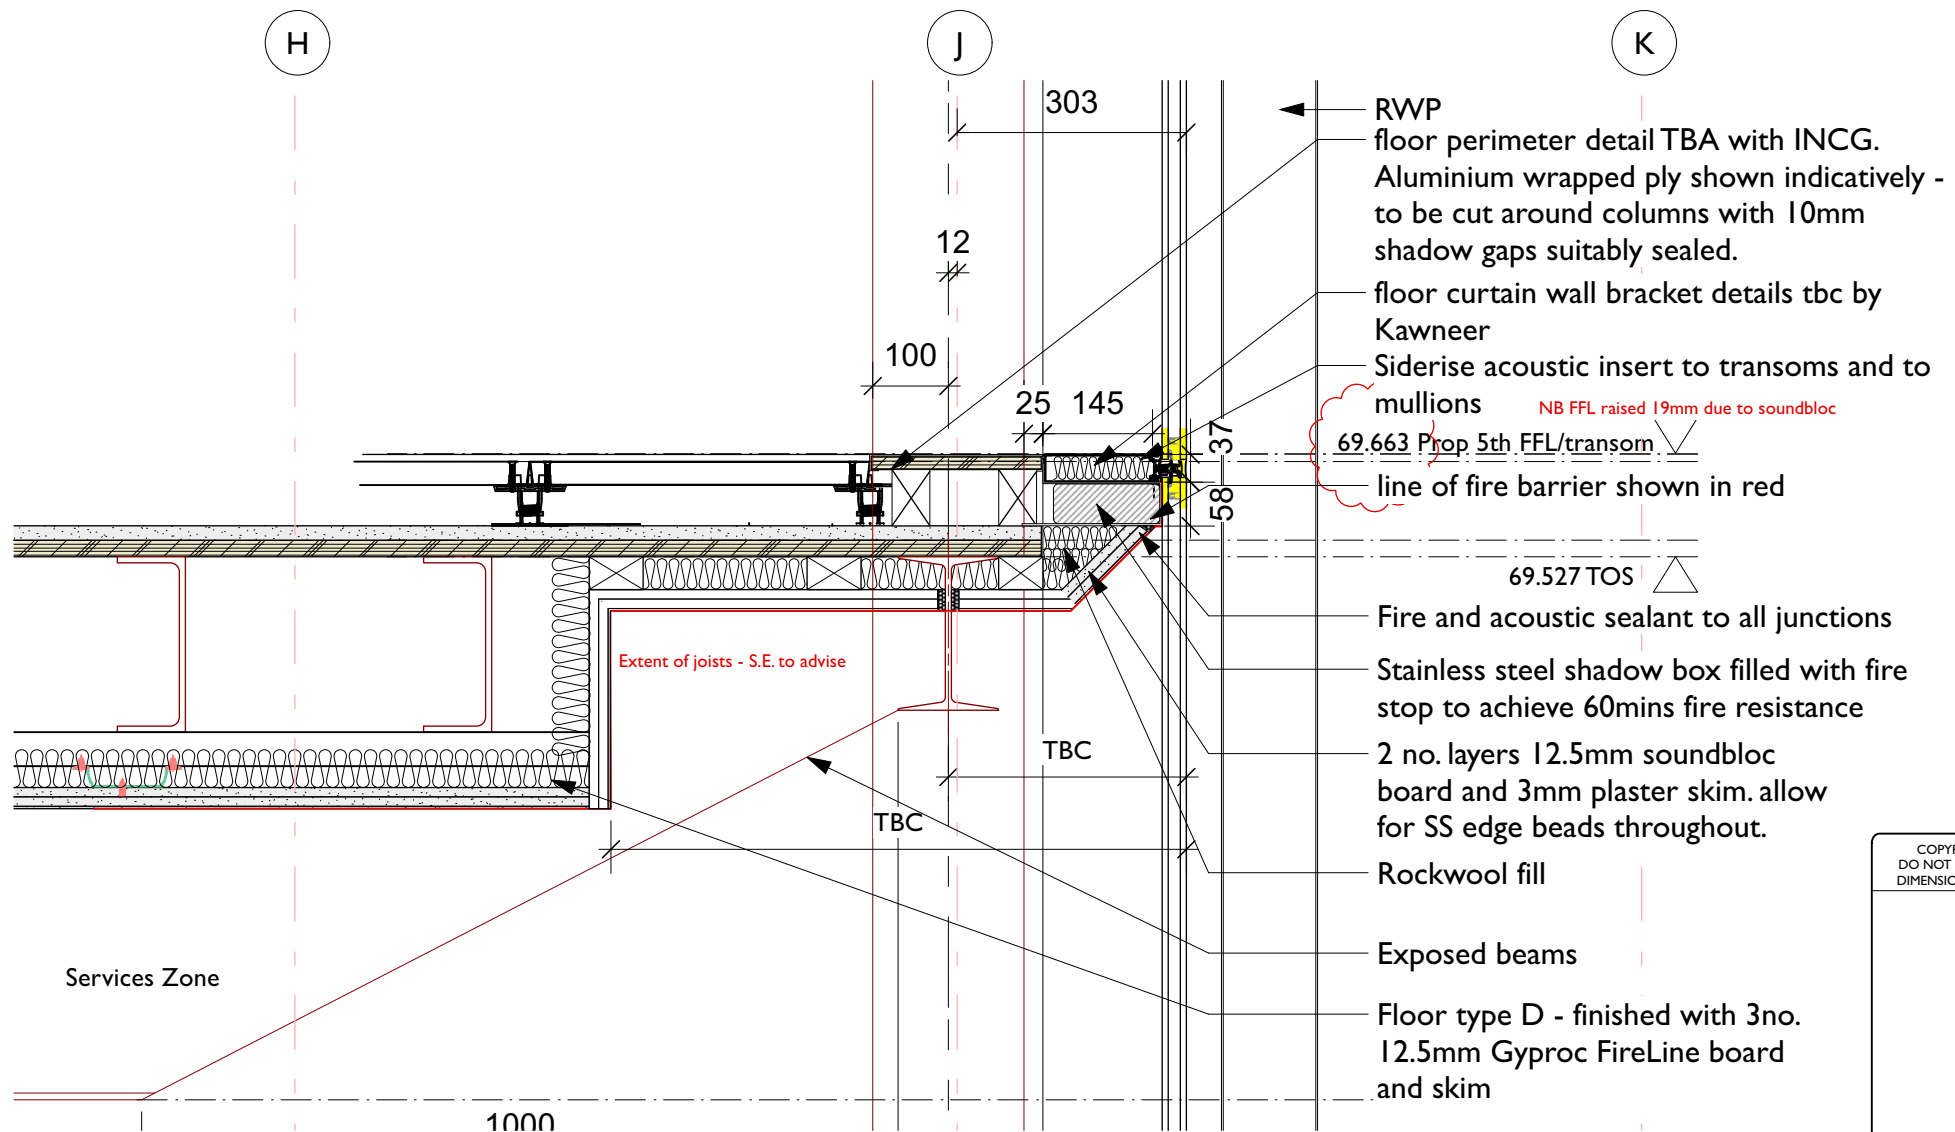

4th Floor Edge Along Pall Mall
Scale: 1:10

Membrane terminated at masonry joint with lead cover flashing and sealed wedge - in accordance with LSA recommended details.
Standard upstand waterproofing detail to manufacturer recommendations - see NBS CI
Insulation depth varies to create 1:40 falls. Min xxx
Roof membrane termination in accordance with manufacturer recommendations

Timber stud to form insulated upstand - 12mm plywood/19mm cement board linings, plasterboard and skim to inner face.
SS downpipe onto gutter shown indicatively
Skirting shown indicatively - to INCG details
Floor edge shown indicatively pending INCG input

Floor type D - see 411
Fire barrier
Fire protection line shown in red

2 no layers 12.5mm Soundbloc and skim
Black painted nominal 10mm wide shadow batten - scribed to suit beam profile.
Acoustic sealant to all joints

COPYRIGHT OF ATELIER MB LTD
DO NOT SCALE FROM THIS DRAWING
DIMENSIONS TO BE CHECKED ON SITE

Rev Note DRN CHK

Chapel Walks, Manchester
Investream Ltd

Section BB Details - Sheet 5

scheme 1814
drwg no. **T(449)**
revision

scale 1:25 @ A3
date first drawn March 2021
drawn BC

SK sketch E existing P proposed T tender C construction FI final issue

www.ateliermb.co.uk
0161 236 0051
architect@ateliermb.co.uk



Atelier MB
Urban Architects