

This drawing is the property of IPS Architects and copyright is reserved by them.
This drawing is not to be copied or disclosed by or to any unauthorized person without the prior written consent of IPS Architects.


Do not scale from this drawing.

All dimensions are to be checked on site prior to construction, manufacture of any components and ordering of materials and equipment.

Any discrepancies are to be reported to the architects for clarification.

All materials and workmanship to be accordance with the current British Standards and codes of practice.

This drawing is to be read in conjunction with all relevant Architectural Structural Engineers, Mechanical Engineers, Electrical Engineers and Specialists drawings and specifications.

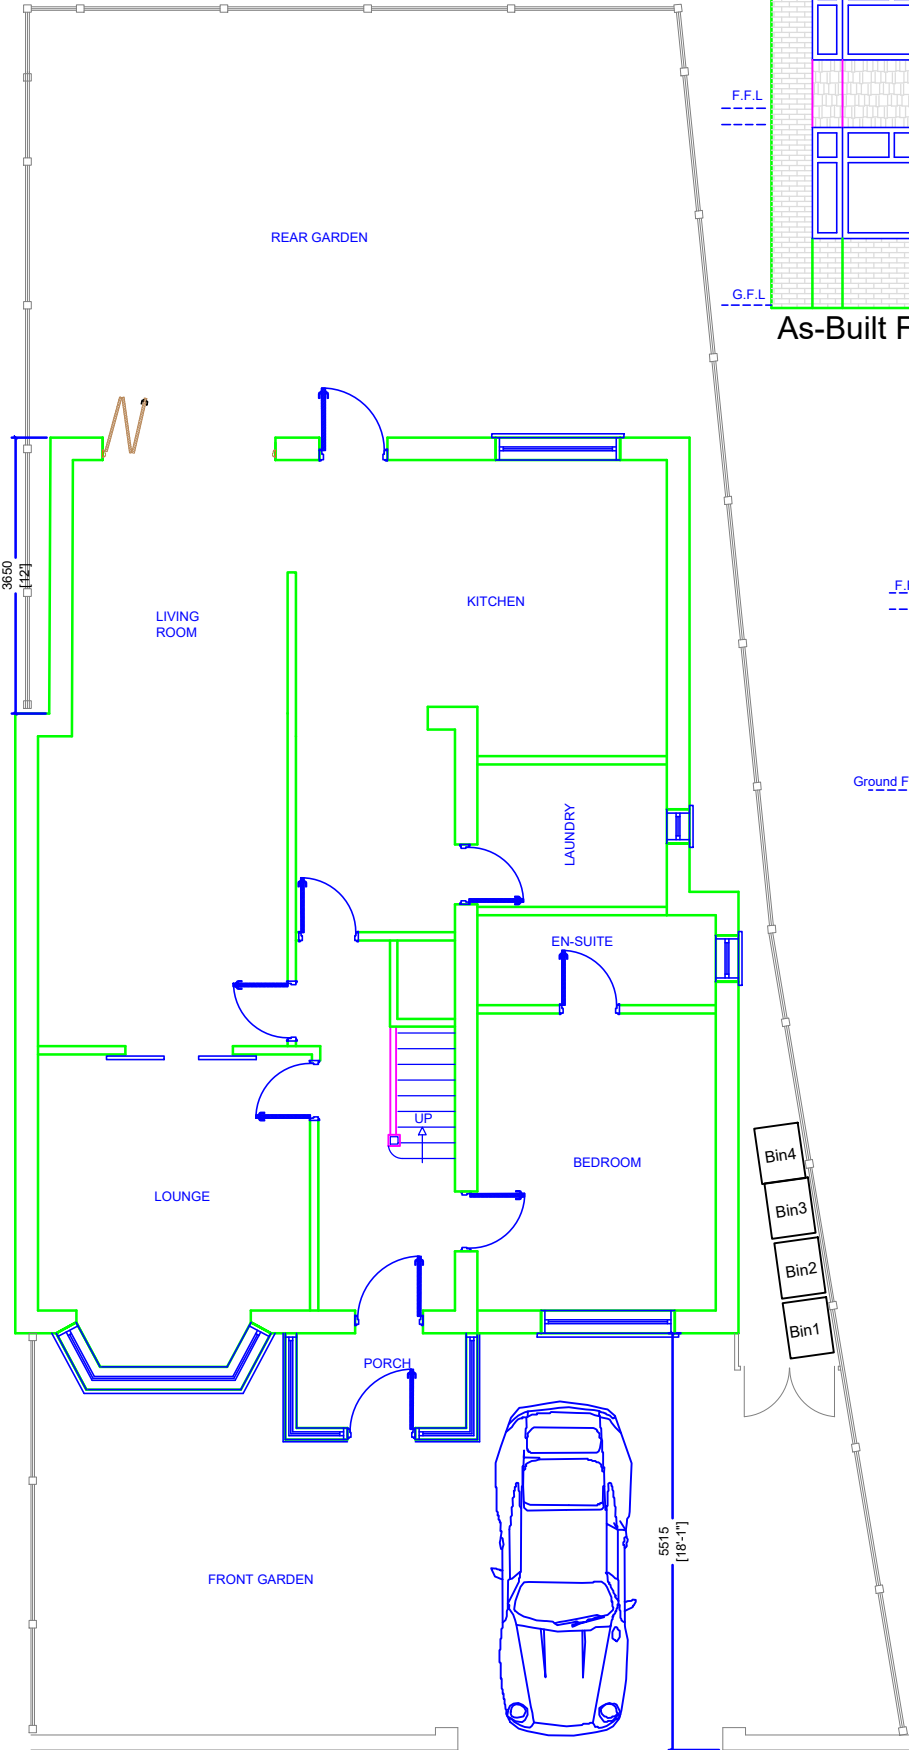


As-Built Ground Floor Plan Incl. Boundary

Bin Storage Area
Wooden gates finish with gray color
Wooden side walls finish with gray color


Bin Storage ground surface to be hard impervious service which can be washed down to remove any residue




As-Built Front Elevation

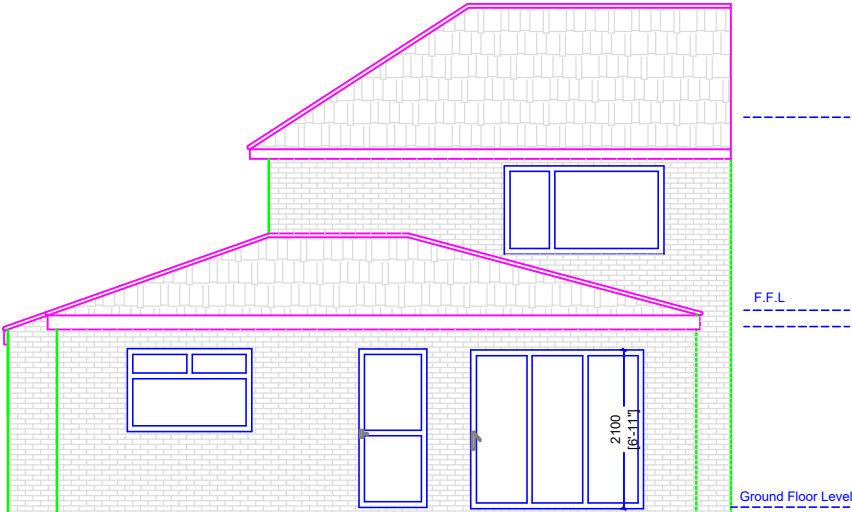


As-Built Rear Elevation

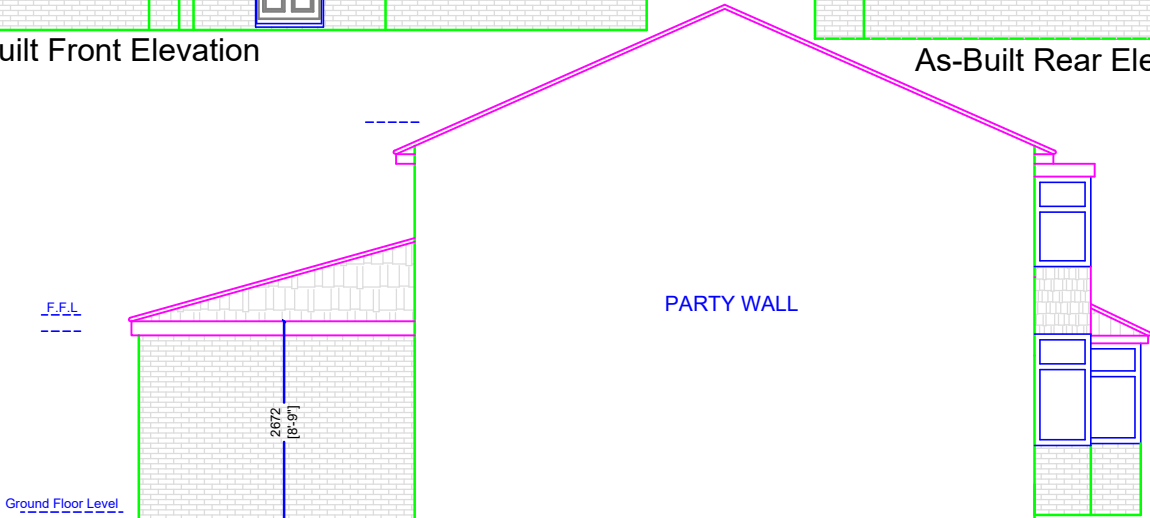


As-Built Side Elevation Facing House No: 17

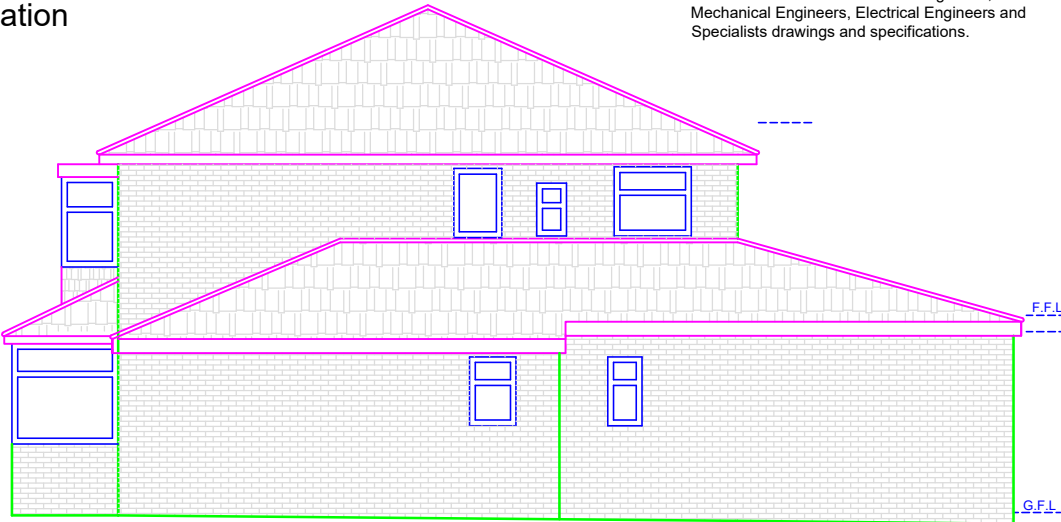

As-Built Side Elevation Facing 34 Morning Drive

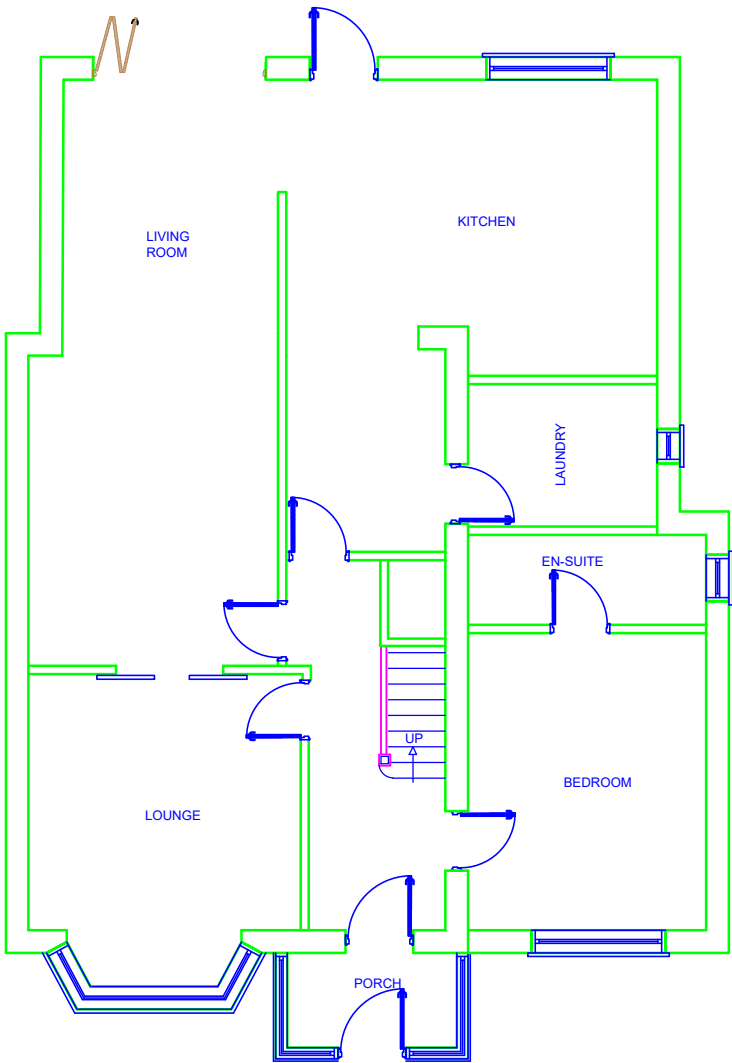

As-Built Ground Floor Plan

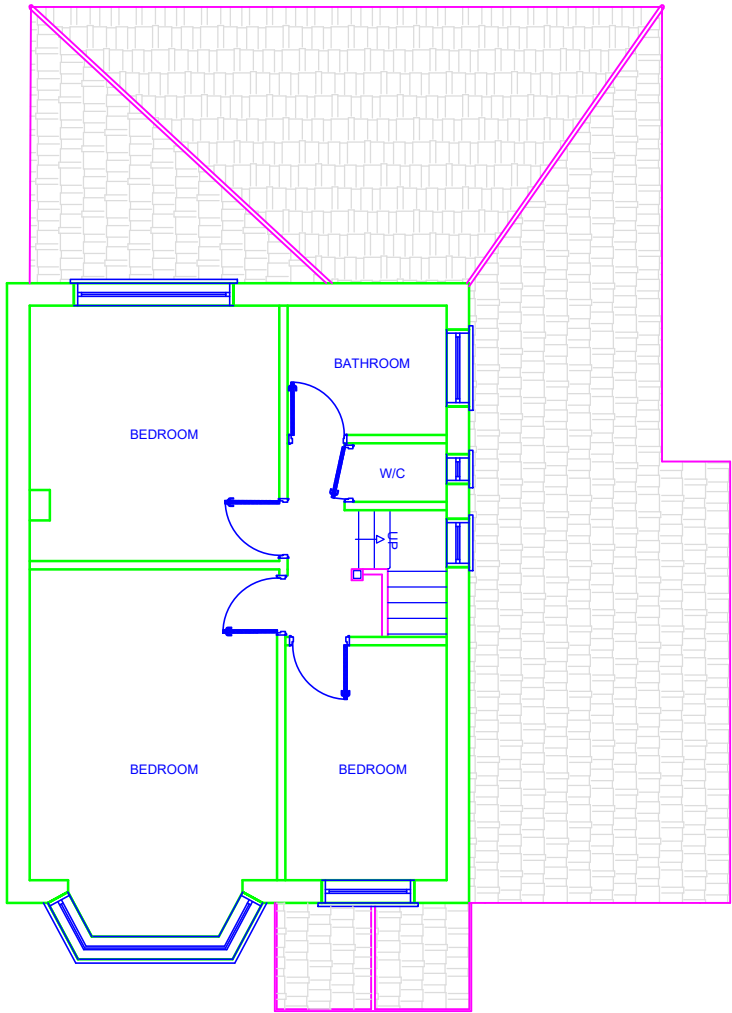

As-Built First Floor Plan

Planning Services

email: ipsuk@live.co.uk

6b Cook Street,
Bury, Lancashire,
BL9 0RP,
0161 8717405

As-Built Floor plans and Elevations
of 19 Fairmile Drive, Manchester, M20 5WS

Scale : 1 : 100 on A3

All Dimensions in Meters

Ref:: IPS/R/19/M205WS

Date : 07/11/2021

SHT 2a of 2

As-Built