


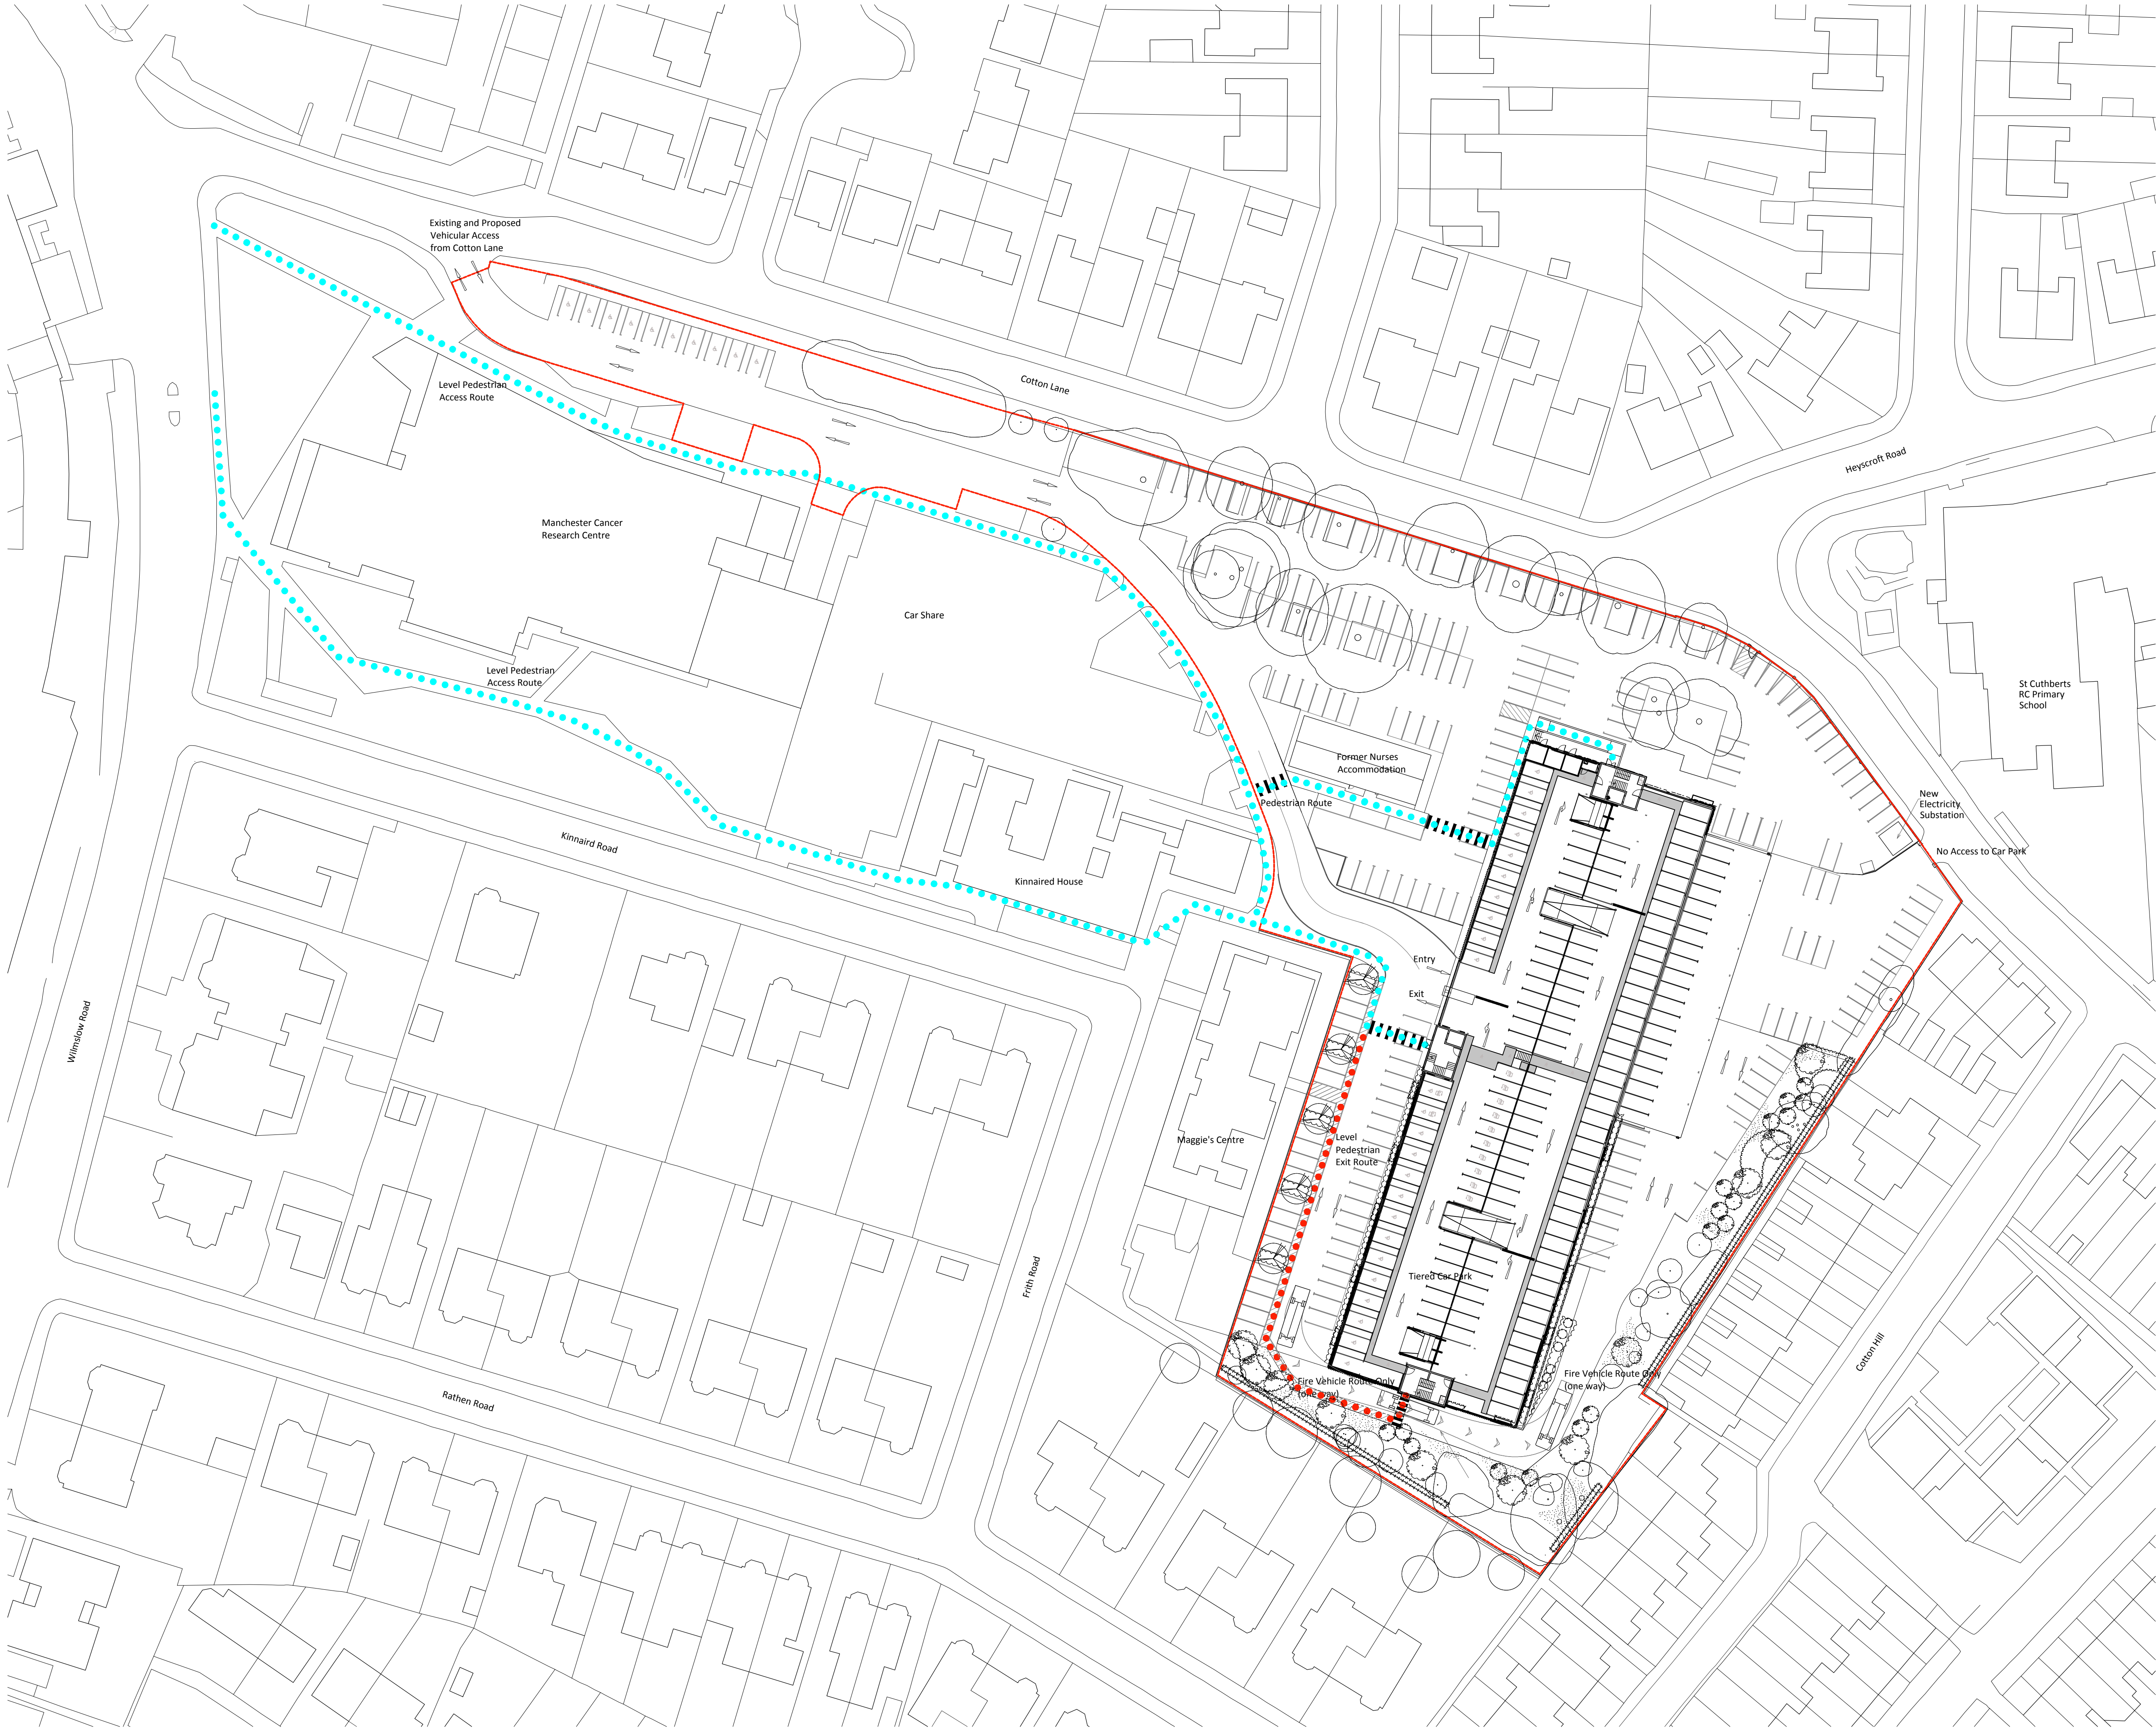

Notes:

- This drawing is copyright.
- Do not scale dimensions from this drawing.
- All discrepancies on this drawing are to be reported to the architect.
- Do not modify any element of this drawing.
- Use drawing only for purpose(s) issued.

North Sign / Key Plan

The following external model files are included within this drawing:

Rev	Date	Revision Notes	Dn	Rv
C3	30/11/21	PARKING SPACE HATCHED OUT AT TOP OF RAMPED ESCAPE ROUTE TO STAIR CORE 1		
C2	30/11/21	ROAD LAYOUT & PARKING AMENDED TO ALIGN WITH SITE PLAN		
C1	16/11/21	PURPOSE CHANGED TO FINAL CONSTRUCTION ISSUE		
P03	26/10/21	LAYOUT AMENDED TO MATCH SITE PLAN AND REVISION CLOUDS ADDED		
P02	09/07/21	RED LINE BOUNDARY AMENDED		
P01	02/07/21	RED LINE BOUNDARY AMENDED		

Client / Contractor



Project
CHRISTIE TIERED CAR PARK

Drawing Title
PROPOSED ACCESS PLAN

Job Number 124994	Date 01/04/21	Scale@A1 1:500
Status	Purpose FINAL CONSTRUCTION ISSUE	

Drawing Number TCP-IBI-XX-XX-PL-A-100004	Revision C3
---	----------------