



Existing Floor Plans

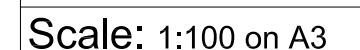

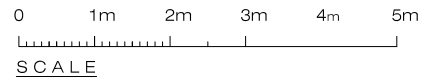

Non-Material Minor Amendments - 2 - 23/09/2021

(Proposed amended As Built, and approved by Building Control)

2


Rev: C

23/09/2021

07/10/2021


Proposed (As Built) Floor Plans

Centre Line / Boundary

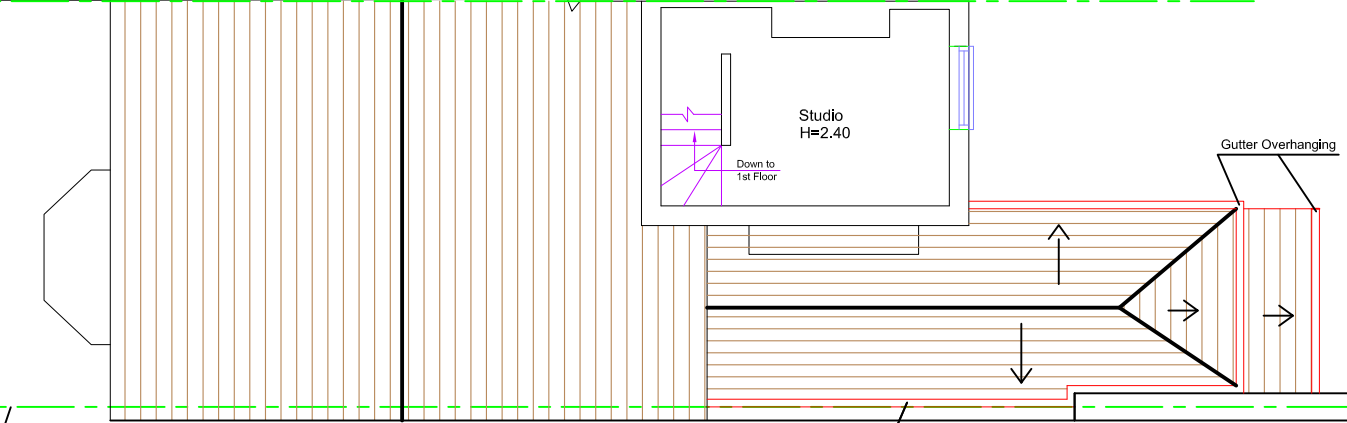

Proposed Second Floor Plan

Centre Line / Boundary

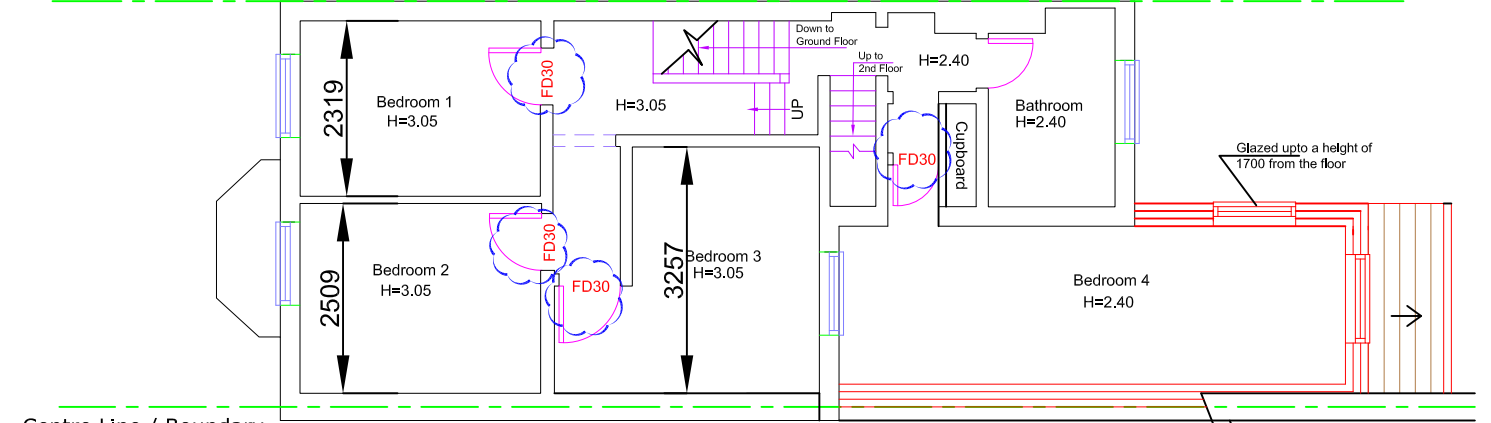

Proposed First Floor Plan

Neighbor,s Property
Flat Roof

PITCHED ROOF

Proposed Roof slope strictly NOT to be less than 15 Degree.
To avoid Roof Leakage, use Tiles strictly in accordance with manufacturer's Instructions.

Application number:
131820/NMC/2021

Application number: 131820/NMC/2021

Rev: C Dated: 23/09/2021

1. Ref Pro Groung Floor Plan: Proposed Door at Rear of Existing Kitchen is deleted. Existing Rear Window of Existing Kitchen is replaced by the Proposed Door with Openable Window.
2. Ballustrade and Steps deleted.
3. Landing position and size changed.
4. Kitchen Bay Window removed.
5. Fire Doors Installed

Rev: B Dated: 19/05/2020

Pro Flat Roof above First Floor amended to Pitched Roof
Pro Bed 4 Side Window details changed.

Rev: A Dated: 08/04/2020


Pro GF pitched Roof added

Sheet: 02

Rev: B

Date: 23/12/2019

Scale: 1:100 on A3

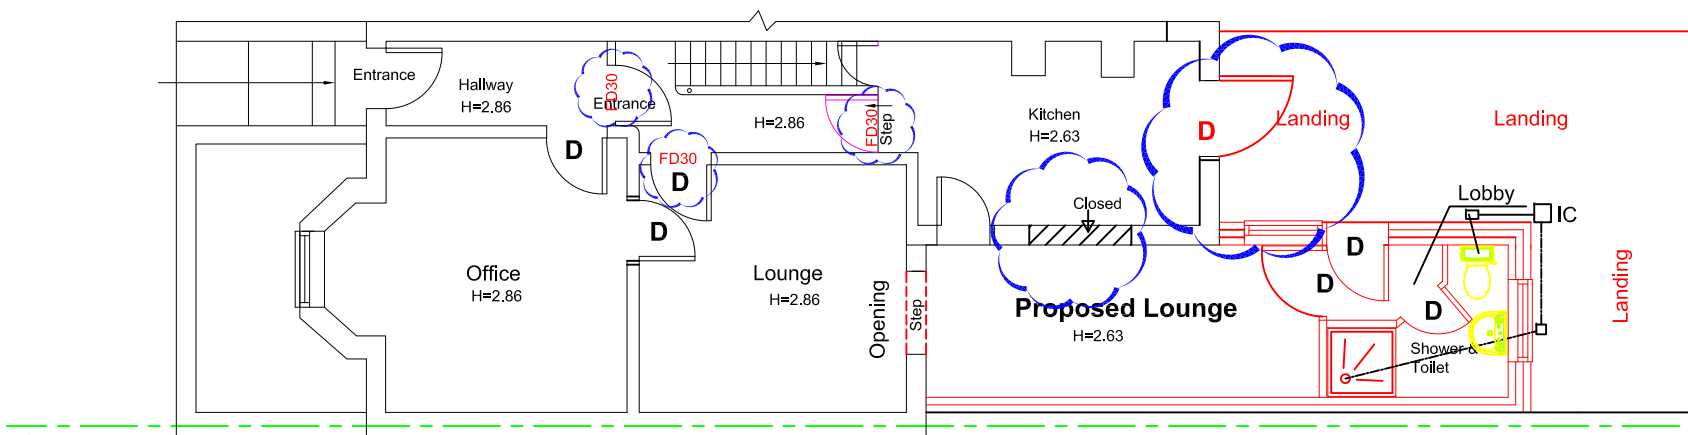

**Proposed Ground Floor Plan
(As Built)**

Neighbor,s Property
Ground Floor

Reference to Applications
128382/NMC/2020 and
126654/FO/2020



Applicant: Mrs. Iram Naz

Location: 18 Alma Road, Levenshulme, Manchester. M19 3NW

Sheet: Pro Floor Plans

Proposal: Proposed Double Storey Rear Extension

Ex & Pro Roof Plans and Front Elevation

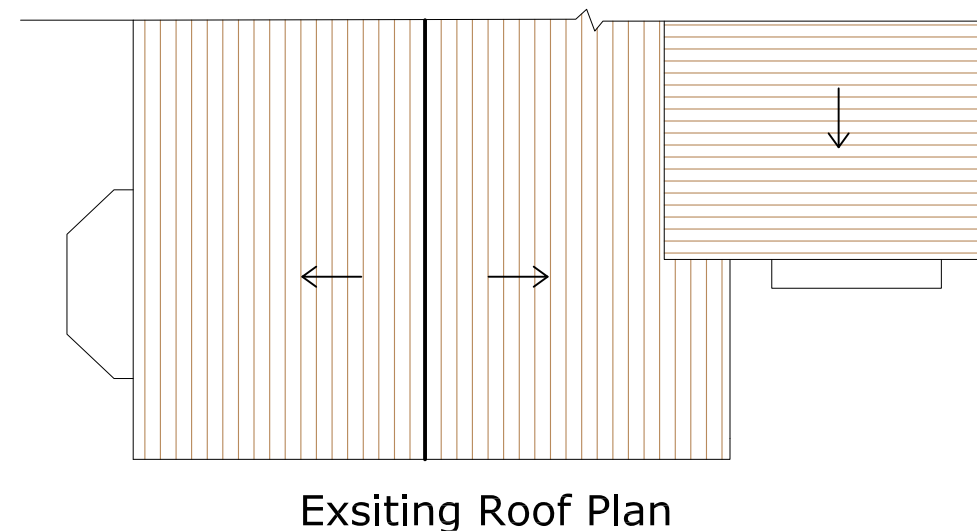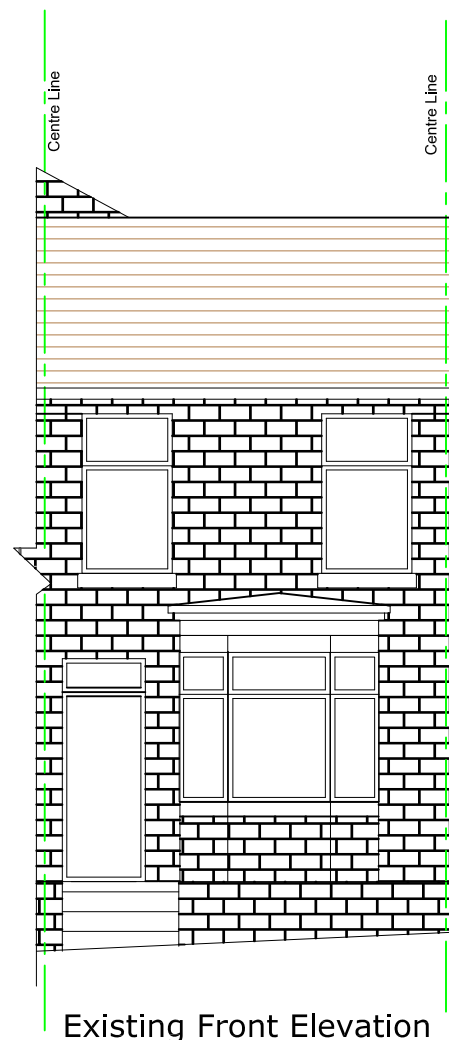


Reference to Applications
128382/NMC/2020 and
126654/FO/2020

Application number:
131820/NMC/2021

PITCHED ROOF

Proposed Roof slope strictly NOT to be less than 15 Degree.
To avoid Roof Leakage, use Tiles strictly in accordance with manufacturer's Instructions.

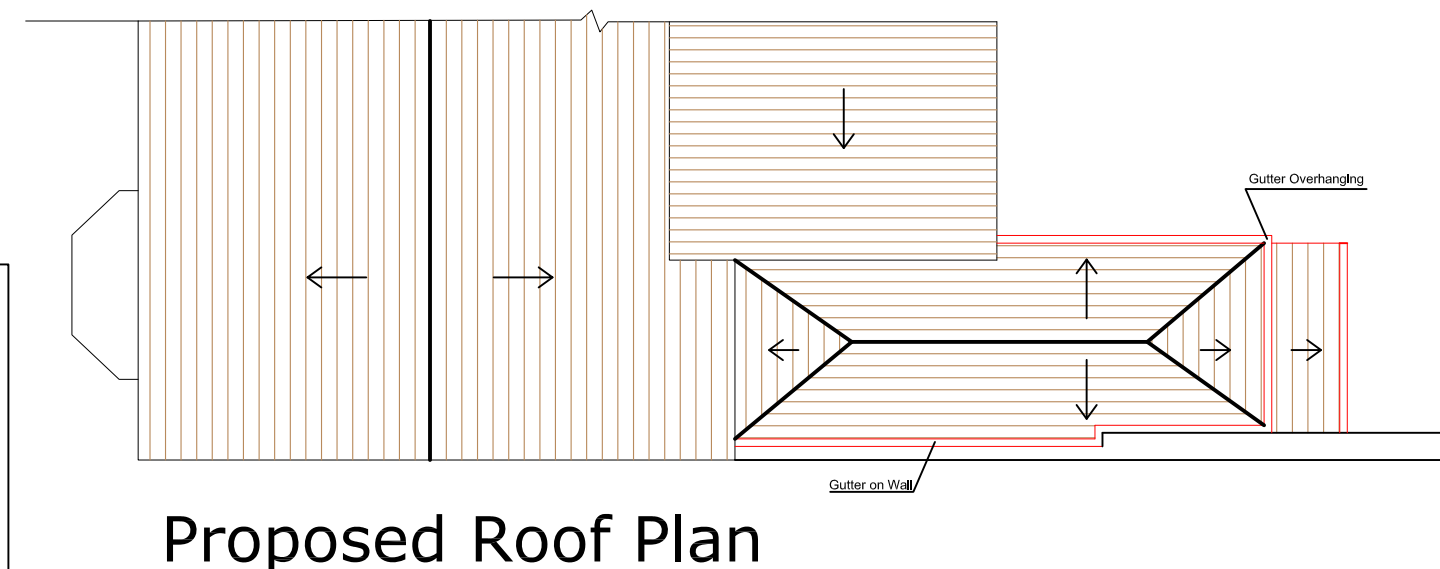

Rev: C/1 Dated: 02/11/2020

1. Building Heights corrected.
2. Pro Pitched Roof hipped on end near Bed 3.
3. Pro Windows for Bed 3 changed.

Rev: B Dated: 19/05/2020

Pro Flat Roof above First Floor amended to Pitched Roof
Pro Bed 4 Side Window details changed.

Rev: A Dated: 08/04/2020

Pro GF pitched Roof added

Applicant: Mrs. Iram Naz

Location: 18 Alma Road, Levenshulme, Manchester. M19 3NW

Sheet: Roof Plans & Front Elevation

Proposal: Proposed Double Storey Rear Extension

Sheet: 03 Rev: c

Date: 23/12/2019

Scale: 1:100 on A3


Non-Material Minor Amendments - 2 - 23/09/2021

4

Rev: D
23/09/2021
07/10 /2021

(Proposed amended As Built, and approved by Building Control)

Existing Elevation 1 from 20 Alma Road

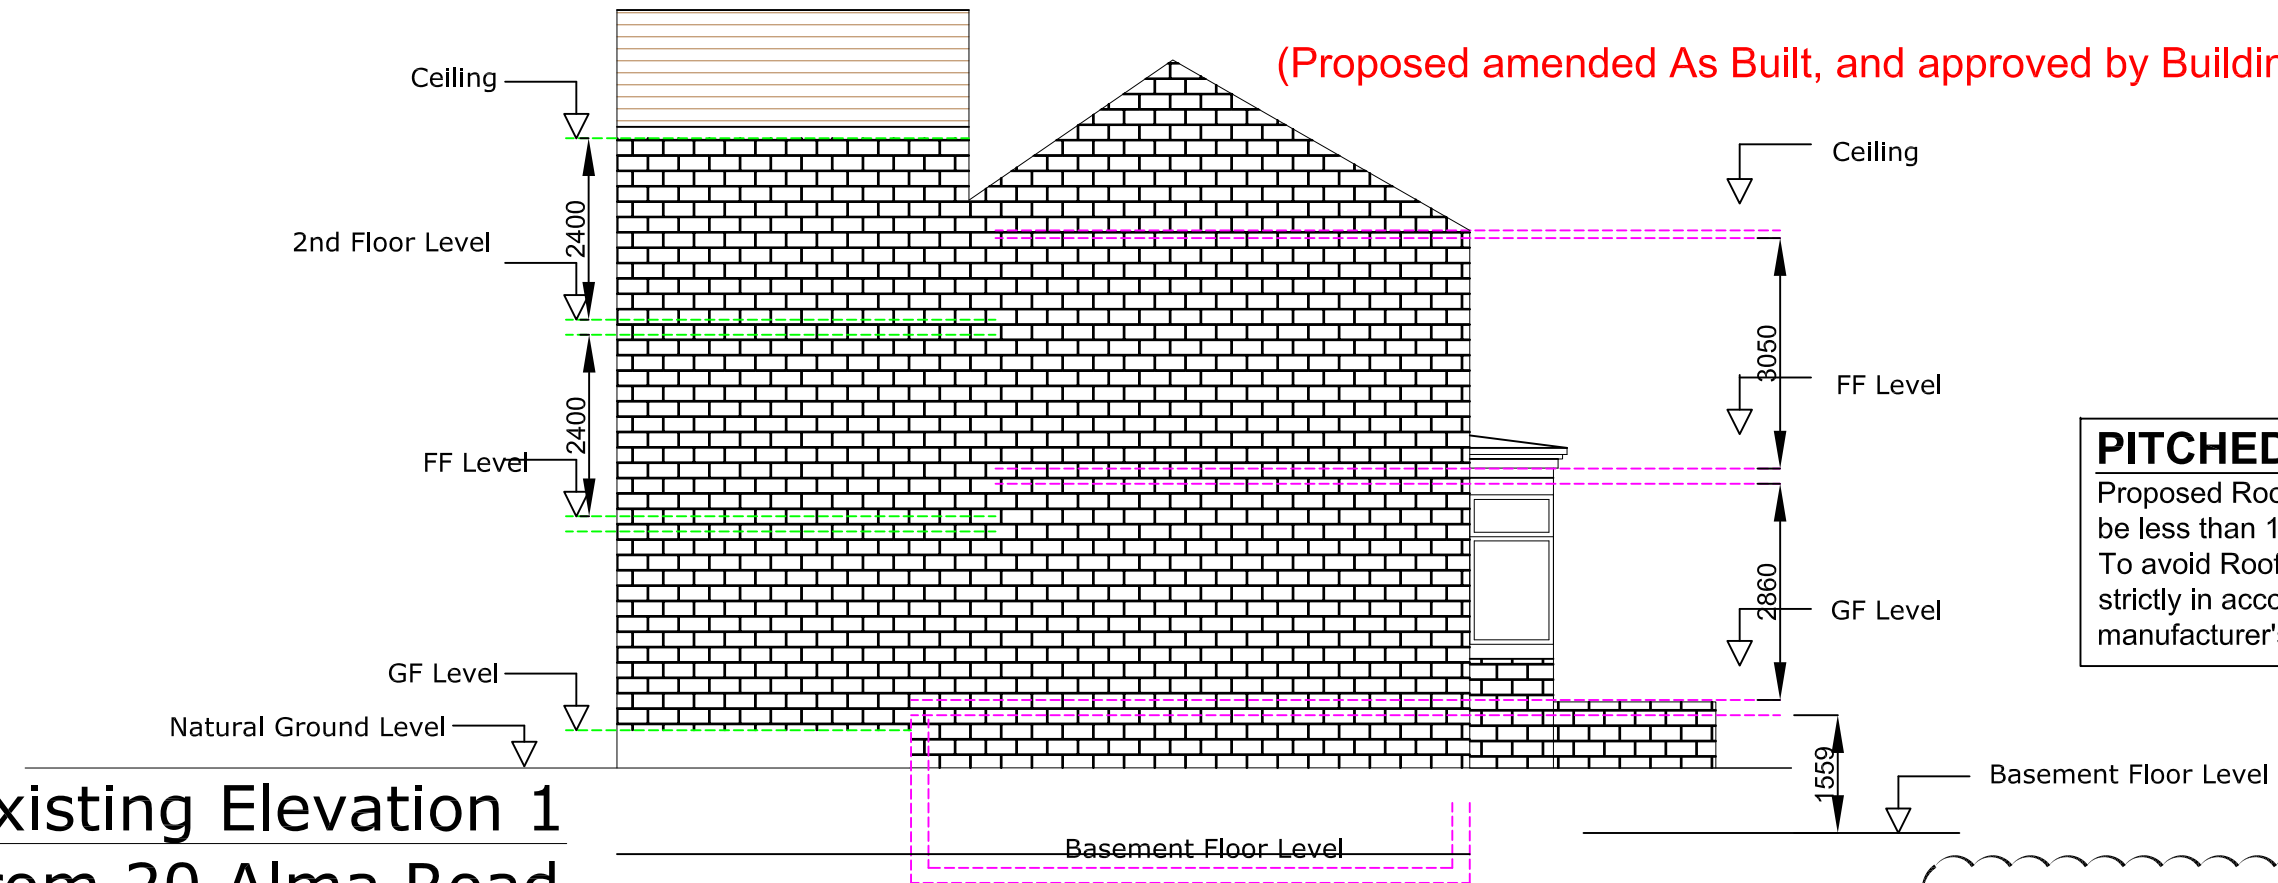


PITCHED ROOF

Proposed Roof slope strictly NOT to be less than 15 Degree.
To avoid Roof Leakage, use Tiles strictly in accordance with manufacturer's Instructions.

Reference to Applications
128382/NMC/2020 and
126654/FO/2020

Application number:
131820/NMC/2021

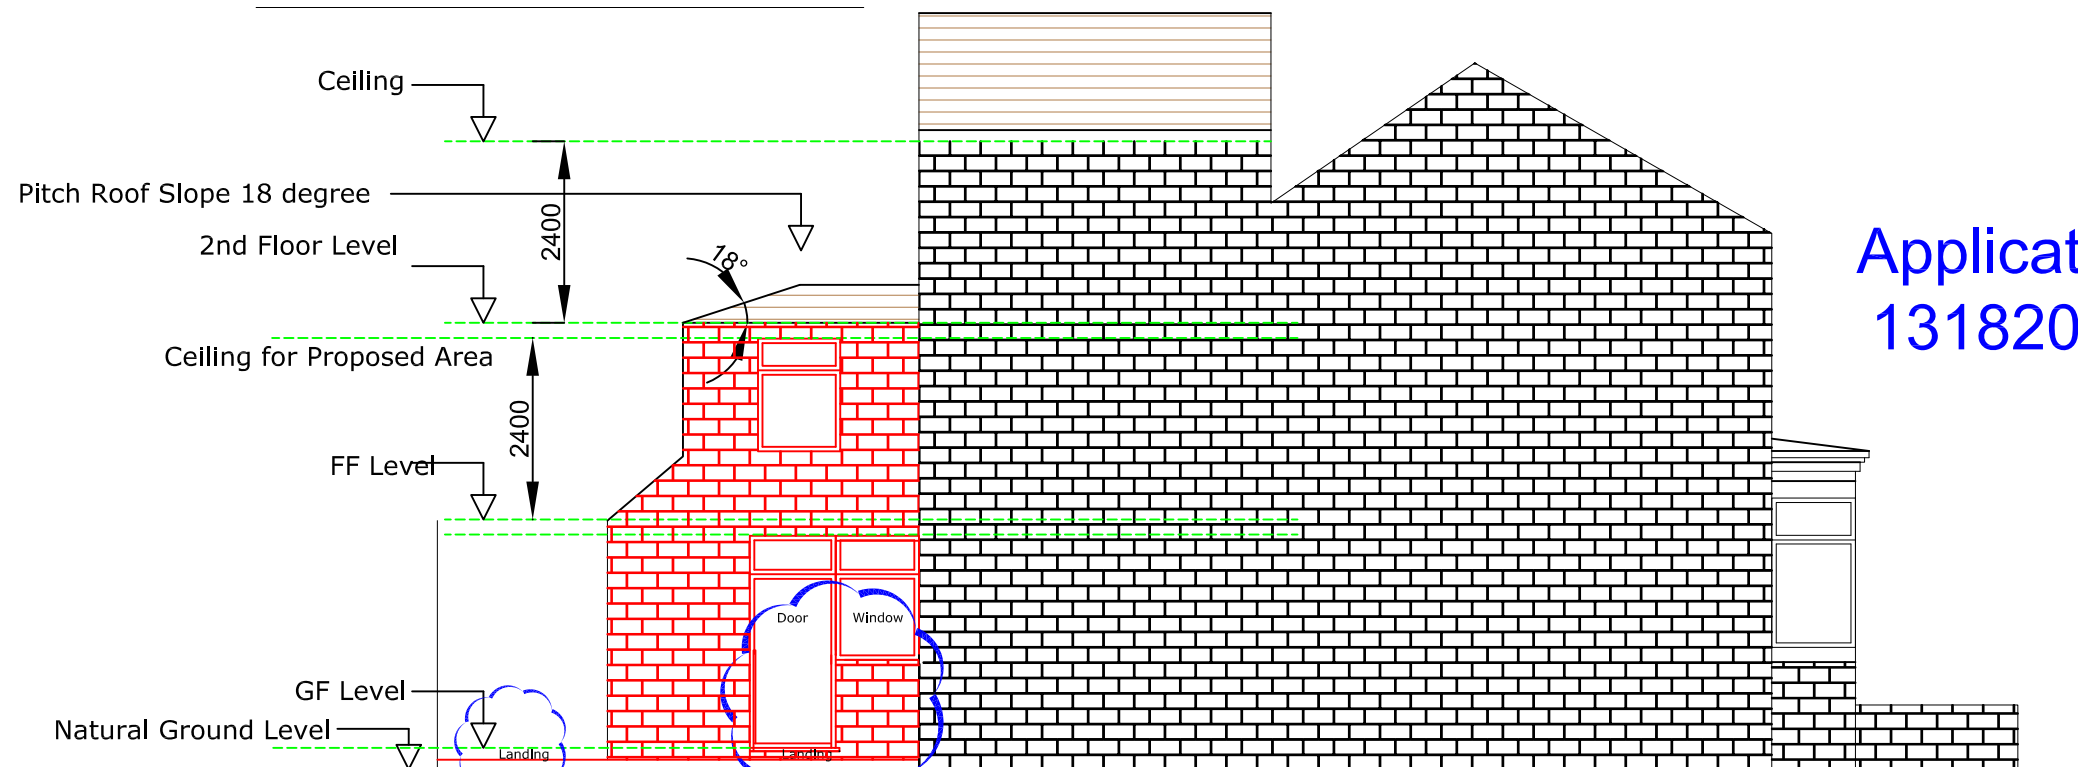

Proposed (As Built) Elevation 1 from 20 Alma Road

Applicant: Mrs. Iram Naz

Location: 18 Alma Road, Levenshulme, Manchester.
M19 3NW

Sheet: Ex & Pro Side Elevation from 20

Proposed Double Storey Rear Extension

Rev: D Dated: 23/09/2021

- Proposed Elevation 1: Balustrade and steps deleted.
- Landing position and Size changed as built.

Rev: C/1 Dated: 02/11/2020

- Building Heights corrected.
- Pro Pitched Roof hipped on end near Bed 3.
- Pro Windows for Bed 3 changed.

Rev: B Dated: 19/05/2020

Pro Flat Roof above First Floor amended to Pitched Roof
Pro Bed 4 Side Window details changed.

Rev: A Dated: 08/04/2020


Pro GF pitched Roof added

Sheet: 04

Rev:C

Date: 23/12/2019


Scale: 1:100 on A3

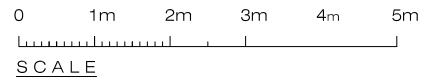

Non-Material Minor Amendments - 2 23/09/2021

5

Rev: C/2
10/11/2020

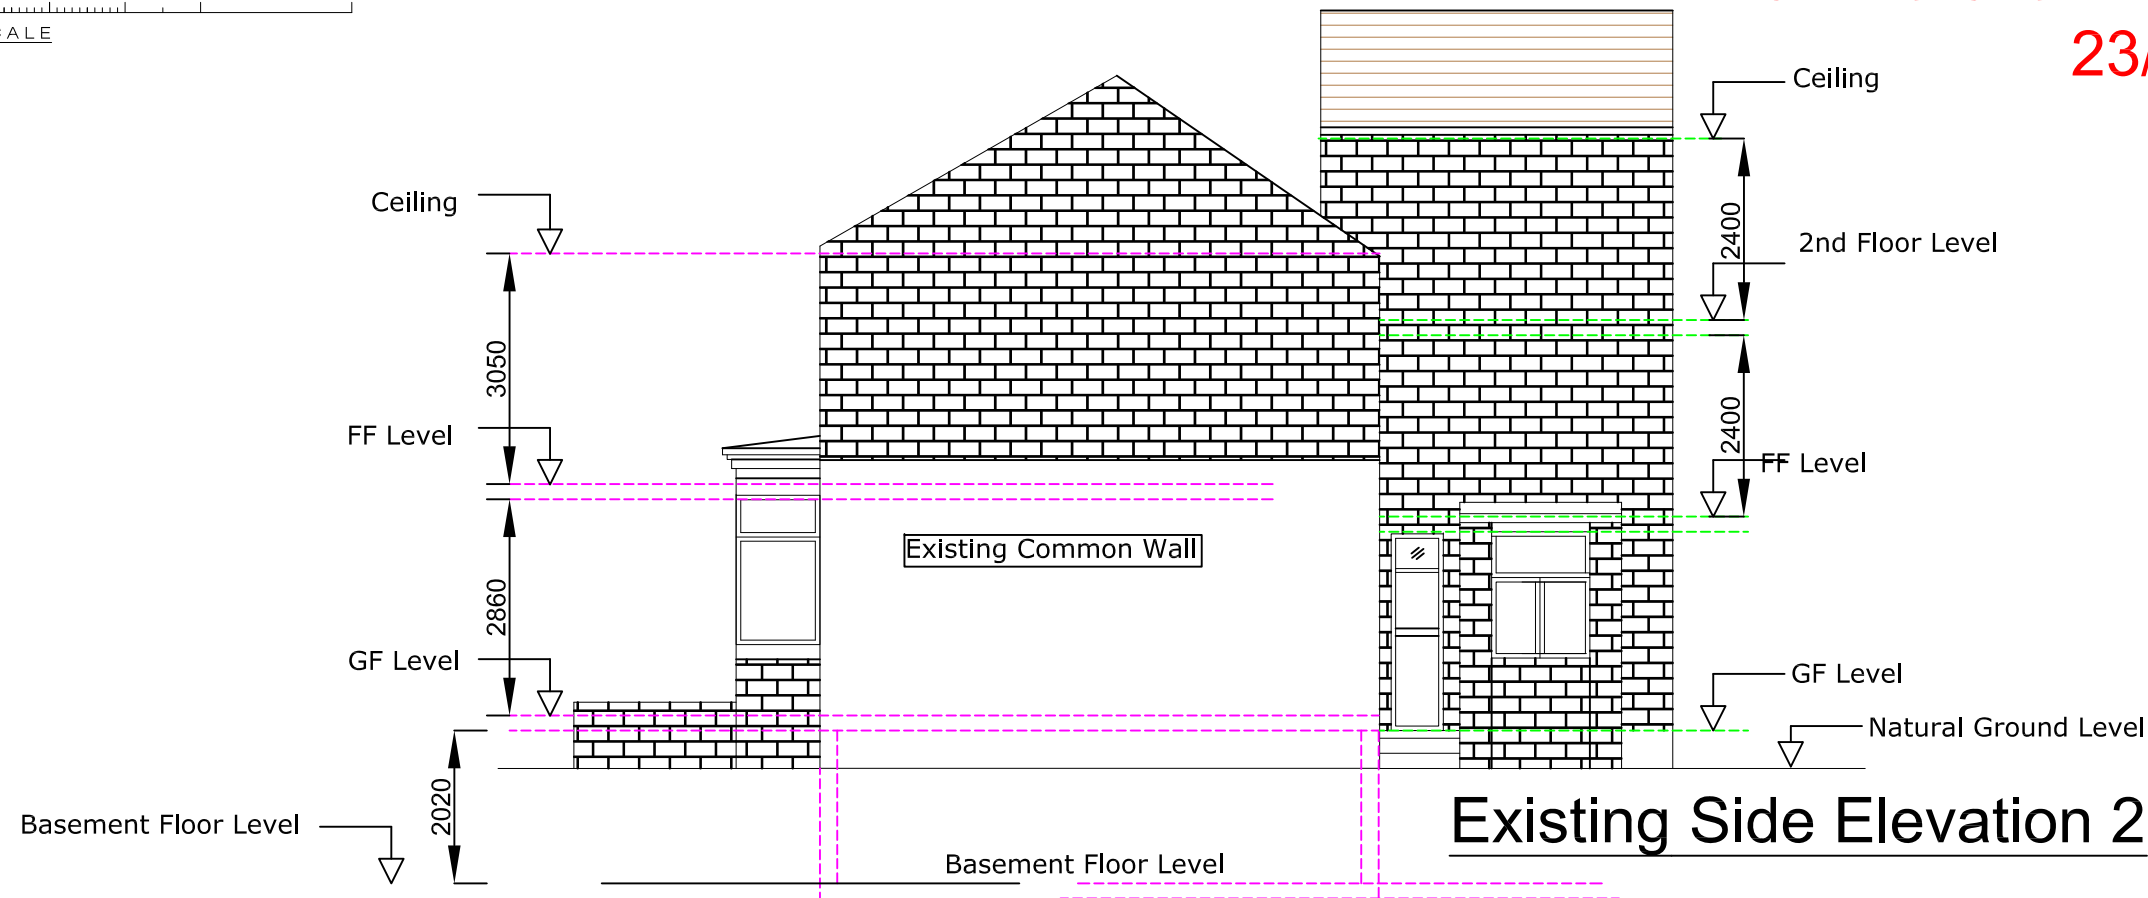


PITCHED ROOF

Proposed Roof slope strictly NOT to be less than 15 Degree.
To avoid Roof Leakage, use Tiles strictly in accordance with manufacturer's Instructions.

Reference to Applications
128382/NMC/2020 and
126654/FO/2020

Application number:
131820/NMC/2021

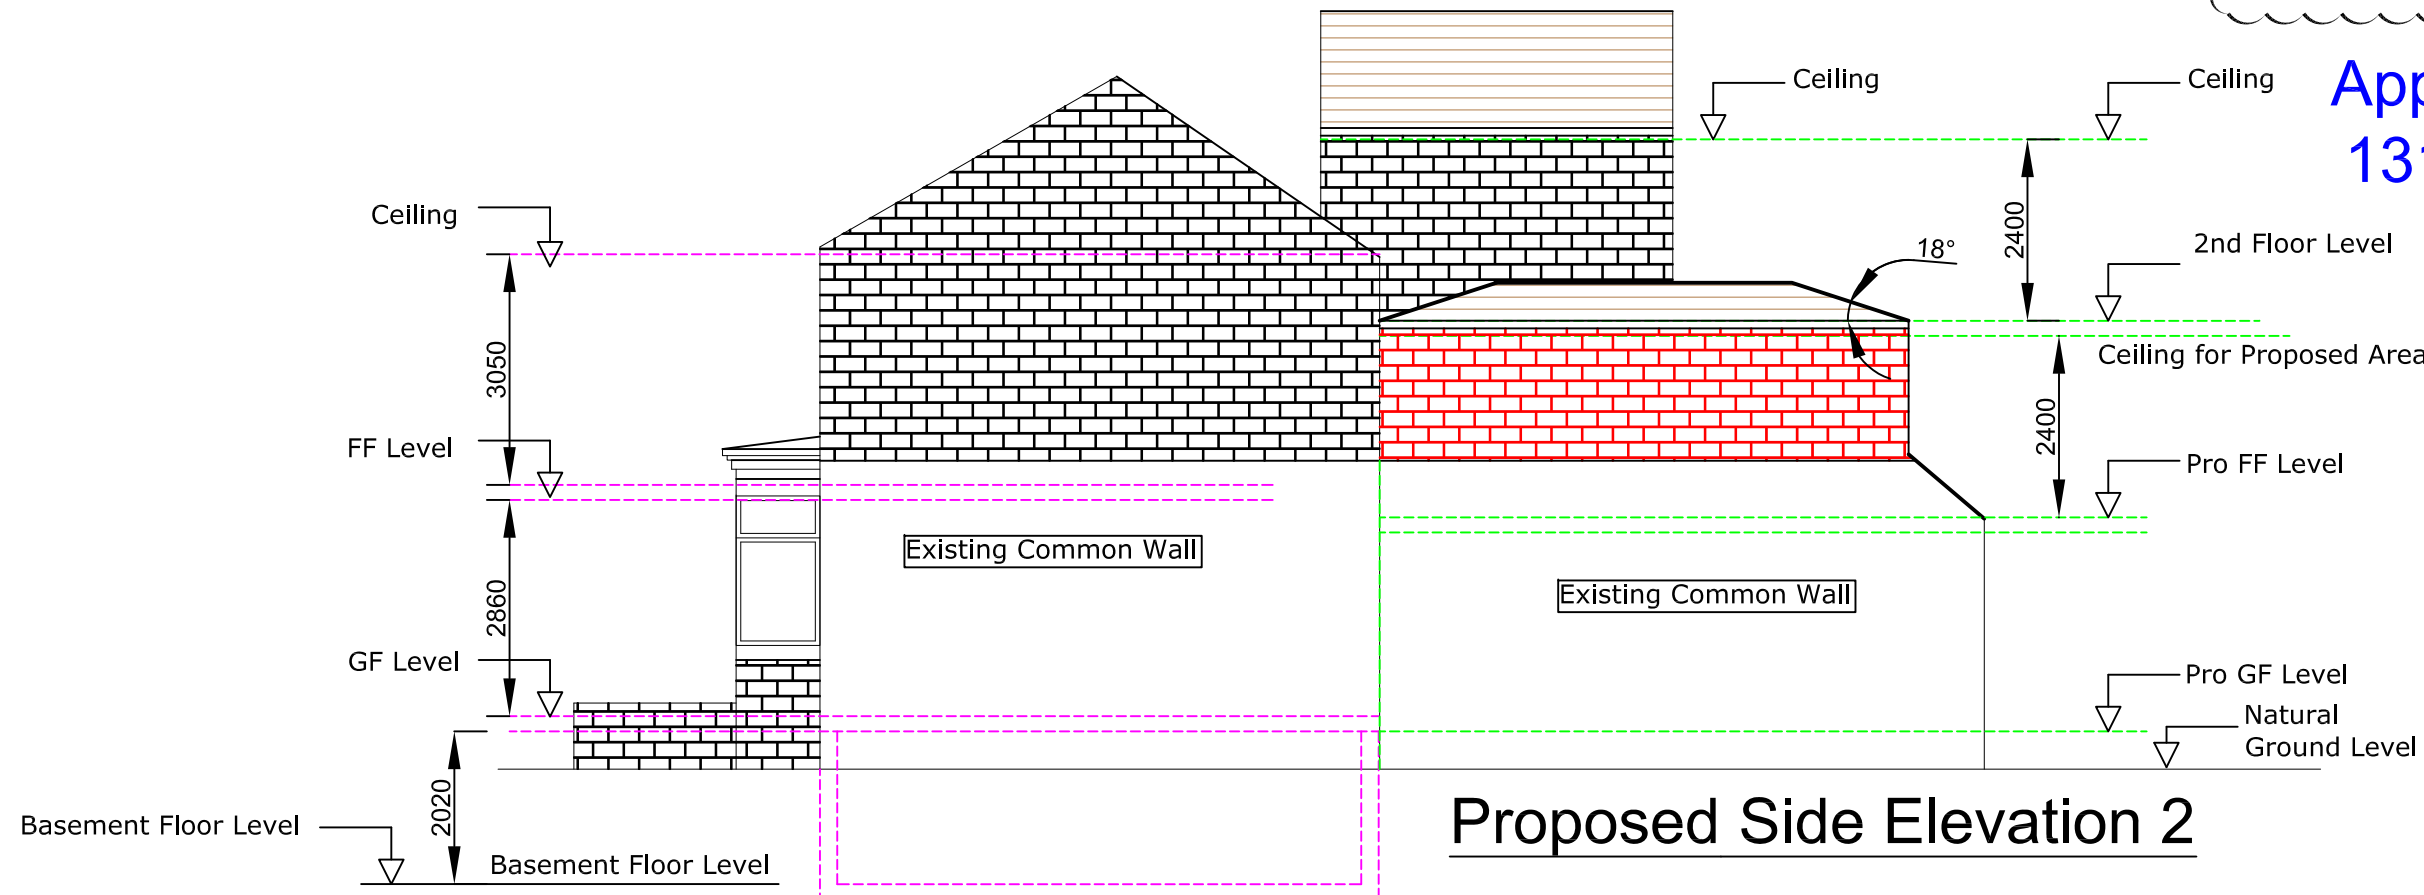

Rev: C/2 Dated: 10/11/2020

- Building Heights corrected.
- Pro Pitched Roof hipped on end near Bed 3.
- Pro Windows for Bed 3 changed.

Rev: B Dated: 19/05/2020

Pro Flat Roof above First Floor amended to Pitched Roof
Pro Bed 4 Side Window details changed.

Rev: A Dated: 08/04/2020

Pro GF pitched Roof added

Applicant: Mrs. Iram Naz

Location: 18 Alma Road, Levenshulme, Manchester. M19 3NW

Sheet: Ex & Pro Side Elevation 2

Proposed Double Storey Rear Extension

Sheet: 05

Rev: c

Date: 23/12/2019


Scale: 1:100 on A3

Non-Material Minor Amendments - 2 - 23/09/2021

(Proposed amended As Built, and approved by Building Control)


6

Rev: D
23/09/2021
07/10/ 2021

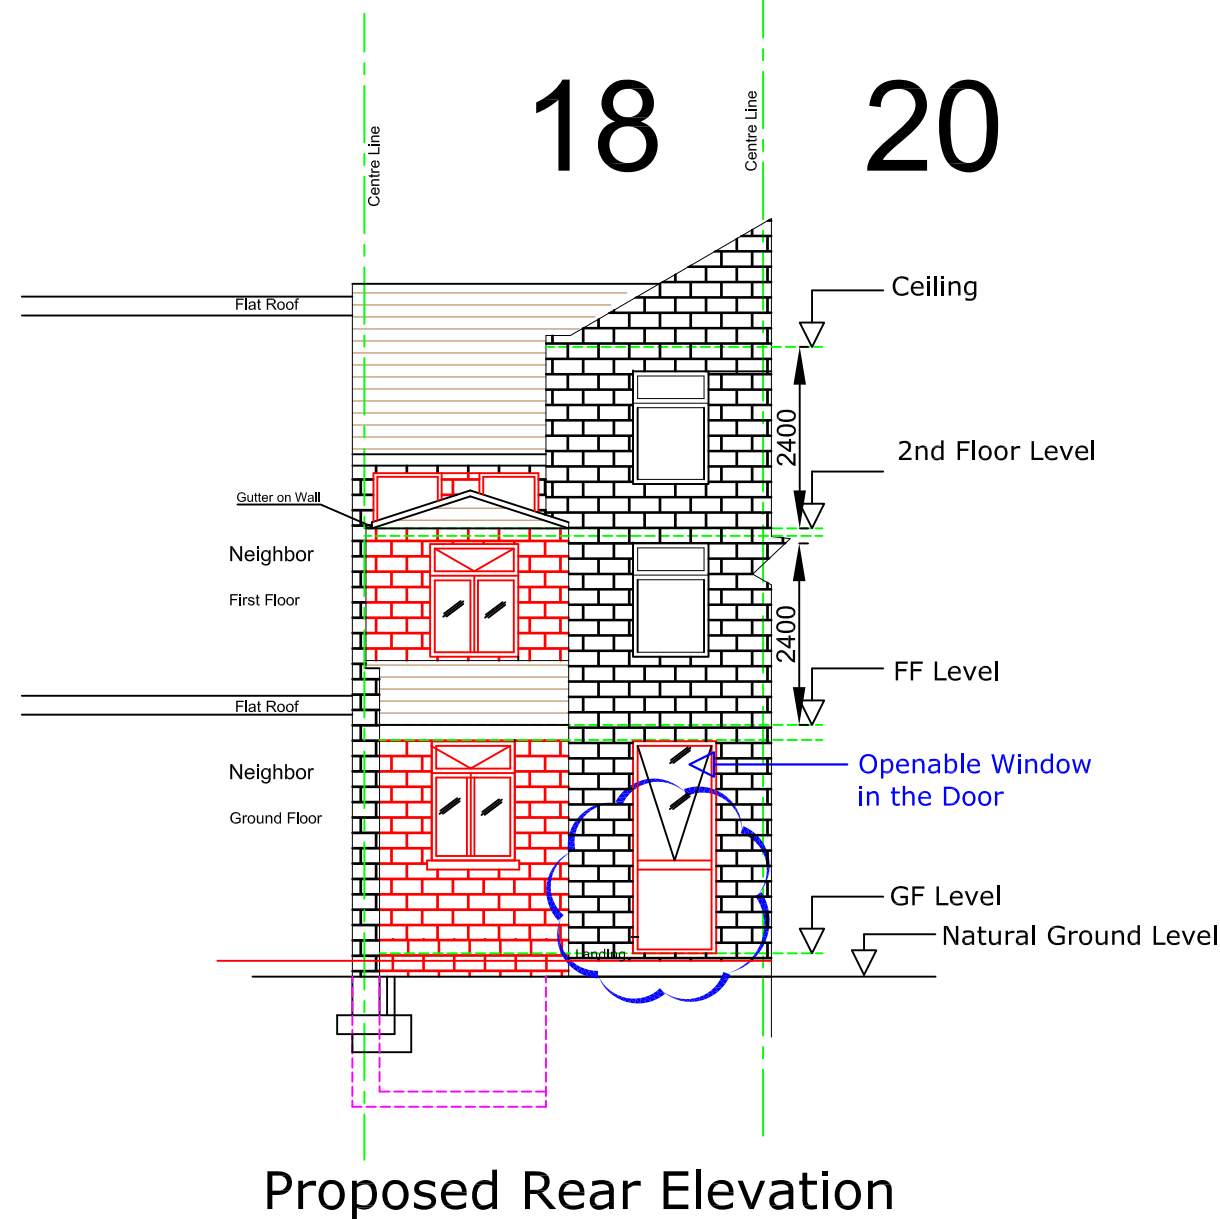

PITCHED ROOF

Proposed Roof slope strictly NOT to be less than 15 Degree.
To avoid Roof Leakage, use Tiles strictly in accordance with manufacturer's Instructions.

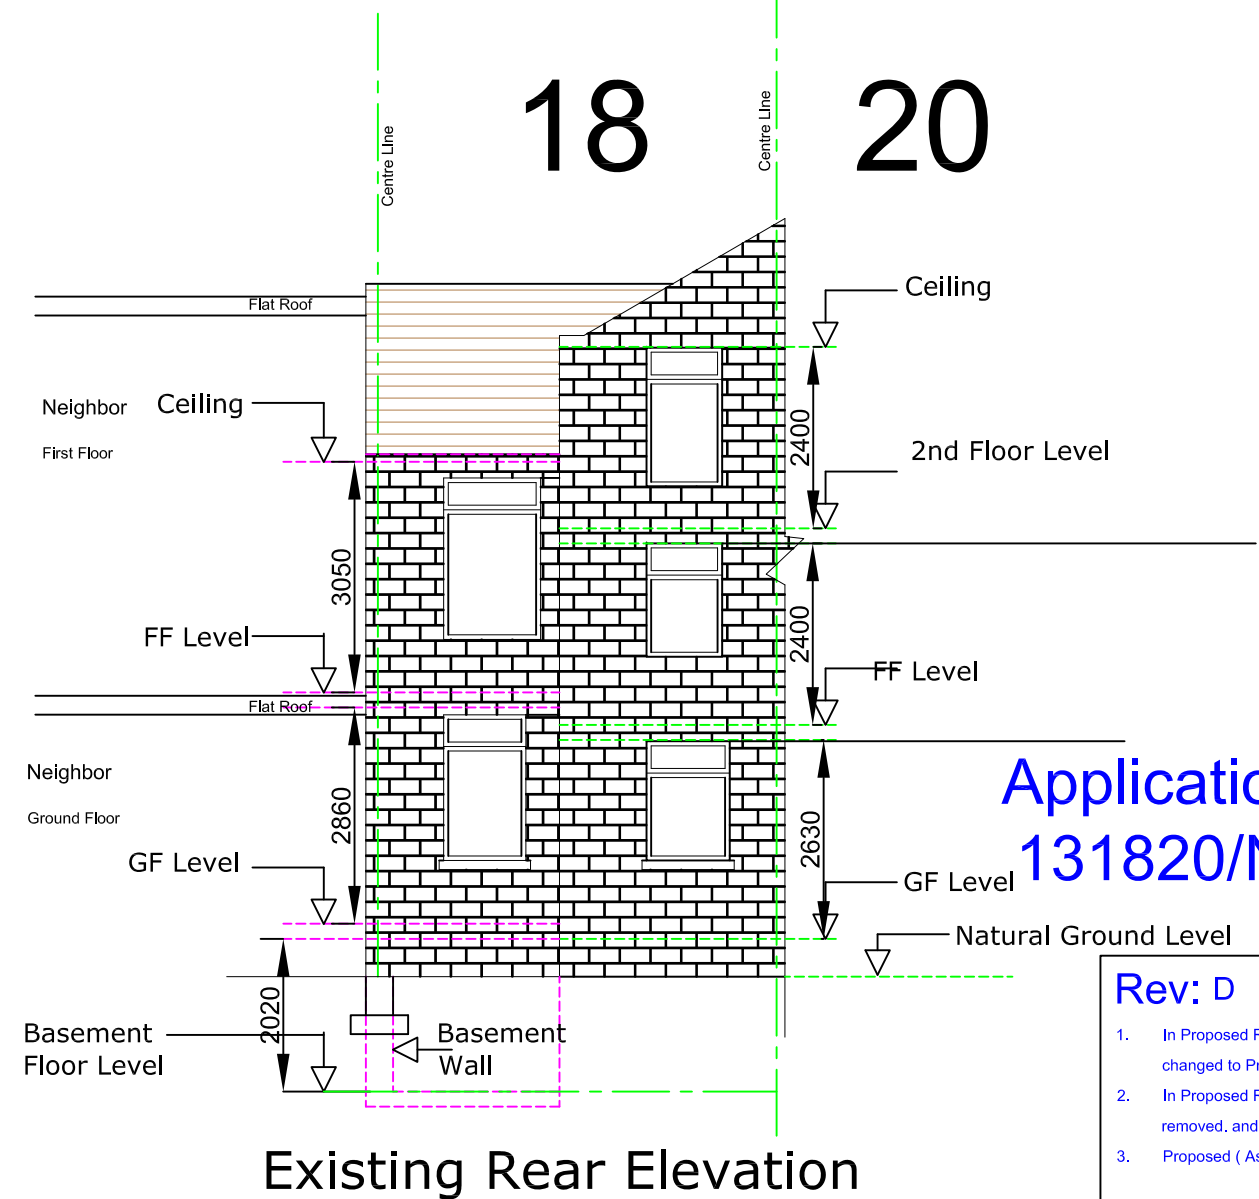

Application number:
131820/NMC/2021

Rev: D Dated:23/09/2021

1. In Proposed Rear Elevation, Existing Window of Kitchen is changed to Proposed (As Built) Door with Openable Window
2. In Proposed Rear Elevation, Balustrade & steps are removed, and
3. Proposed (As Built) Landing position shown

1. Rev: C/1 Dated:02/11/2020

2. Building Heights corrected.
3. Pro Pitched Roof hipped on end near Bed 3.
4. Pro Windows for Bed 3 changed.

Rev: B Dated: 19/05/2020

Pro Flat Roof above First Floor amended to Pitched Roof
Pro Bed 4 Side Window details changed.

Rev: A Dated: 08/04/2020

Pro GF pitched Roof added

Applicant: Mrs. Iram Naz

Sheet: Ex & Pro Rear Elevation

Location: 18 Alma Road, Levenshulme, Manchester. M19 3NW

Proposal: Proposed Double Storey Rear Extension

Sheet: 06

Rev: D

Date: 23/09/2021

Scale: 1:100 on A3

Reference to Applications
128382/NMC/2020 and
126654/FO/2020