


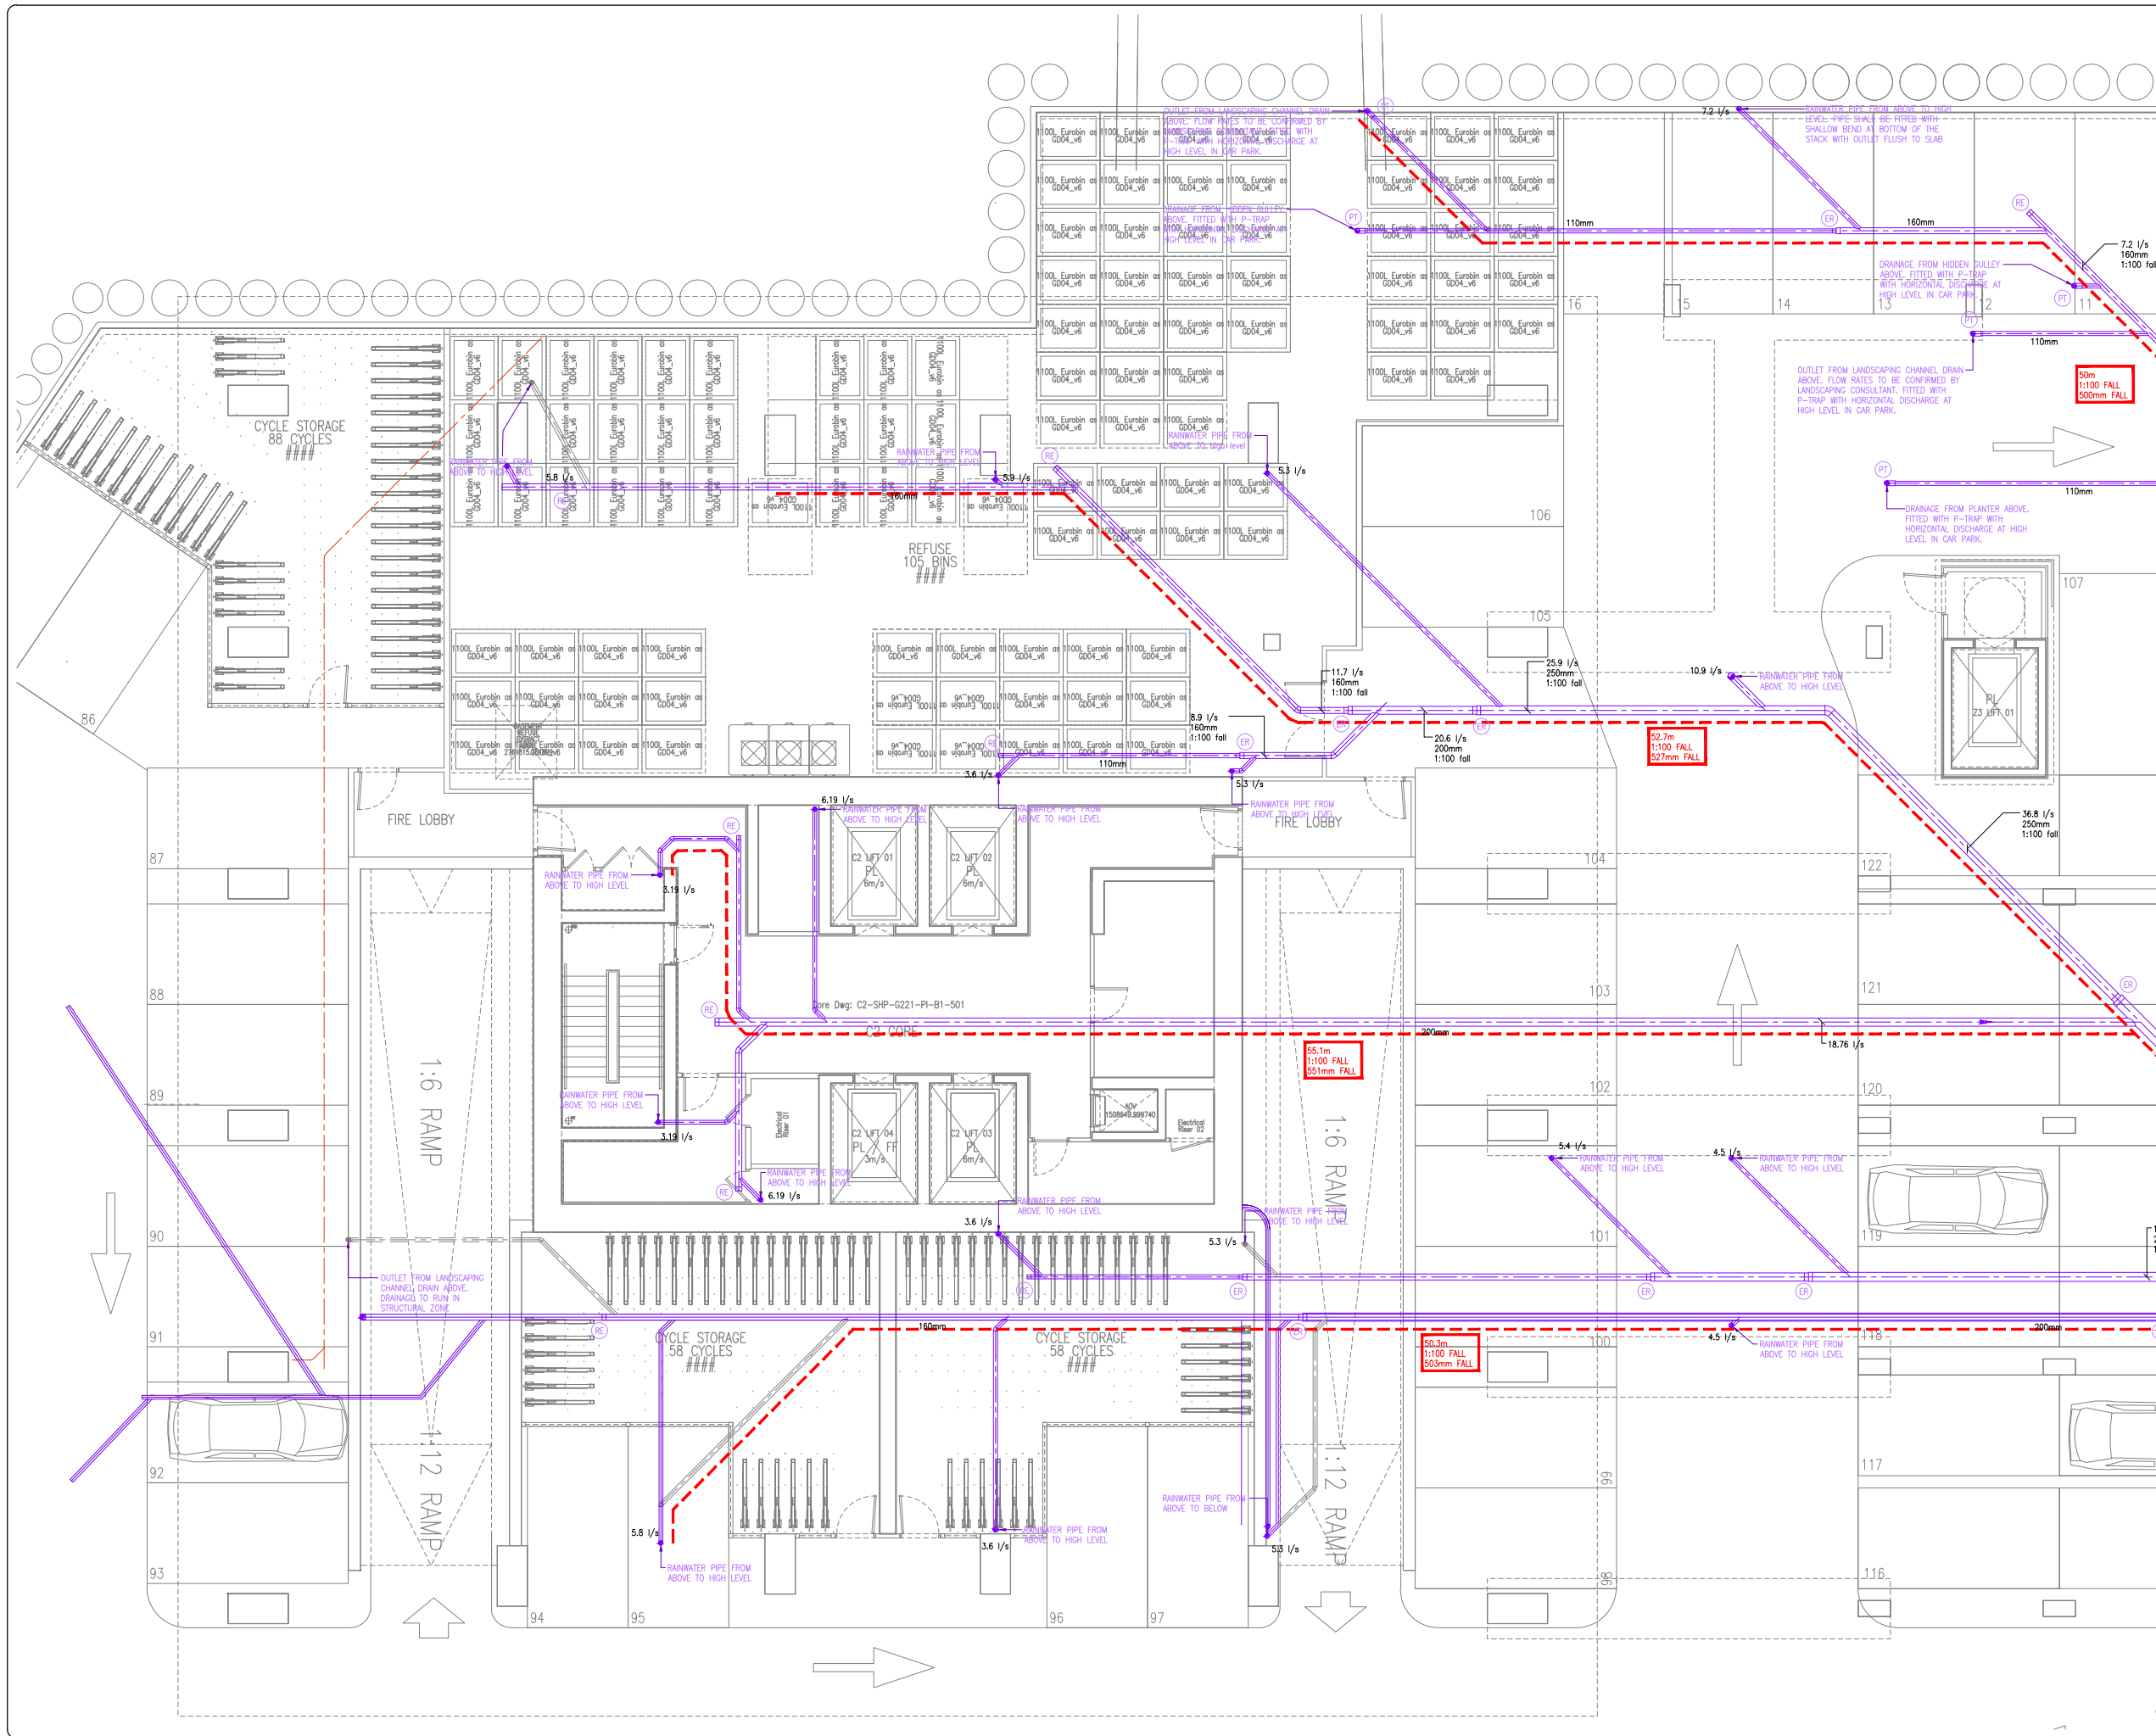

- NOTES:
1. THIS DRAWING IS SUBJECT TO COPYRIGHT AND IS NOT TO BE REPRODUCED IN PART OR WHOLE WITHOUT APPROVAL.
 2. DO NOT SCALE THIS DRAWING - CHECK ALL DIMENSIONS ON SITE.
 3. THIS DRAWING SHALL BE READ IN CONJUNCTION WITH THE PROJECT SPECIFICATION(S) AND ALL OTHER CONTRACT DOCUMENTATION.
 4. ALL DIMENSIONS ARE IN MILLIMETRES UNLESS OTHERWISE STATED.

- LEGEND:
- RAINWATER PIPE LOCATION FROM ABOVE
 - RAINWATER PIPE LOCATION TO BELOW
 - HIGH LEVEL DRAINAGE
 - - - BELOW GROUND DRAINAGE
 - DRAINAGE RUN
 - FA FROM ABOVE
 - TB TO BELOW
 - HL TO HIGH LEVEL
 - AV AIR INLET VALVE
 - RE RODDING EYE
 - ER ECCENTRIC REDUCER TO KEEP THE UNDERSIDE OF DRAINAGE AS HIGH AS POSSIBLE IN THE CAR PARK
 - PT HIGH LEVEL P TRAP WITH HORIZONTAL DISCHARGE

Rev	Date	Status/Amendments	By
19			
20			
1			

RENAKER
RENAKER BUILD LIMITED
NQ Building, 47 Bengal Street, Manchester
M4 6BB
www.renakerbuild.com

Client:
RENAKER

Project:
CROWN-STREET-PHASE1

Drawing Title:
As-Built Surface Water
Drainage - Crown Street Phase 1

Drawn By: G.M.	Checked By: D.B.	Cad By: G.M.
Scale:	Paper Size: A3	Date Created: 20/09/2021
Drawing Number: C2 - RBL - G580 - PI - B1 - 451	Drawing Revision: AS_BUILT	