
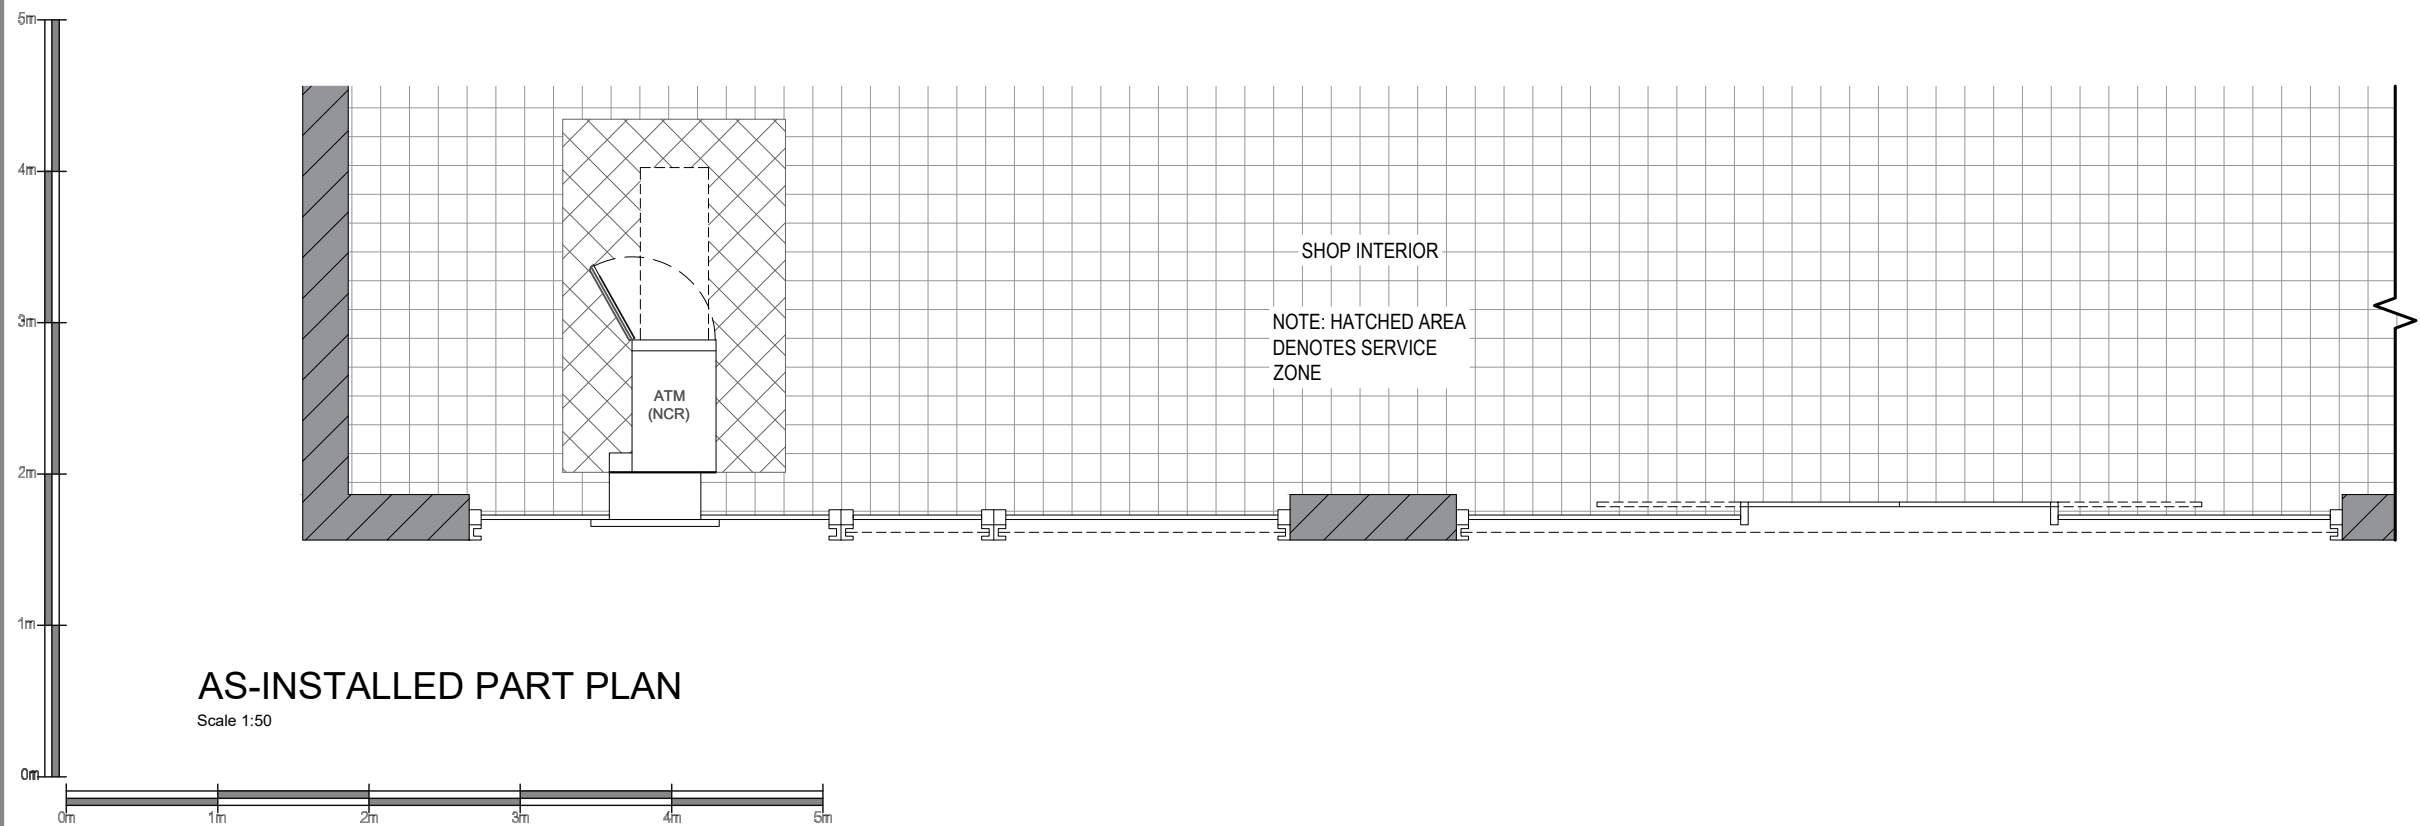


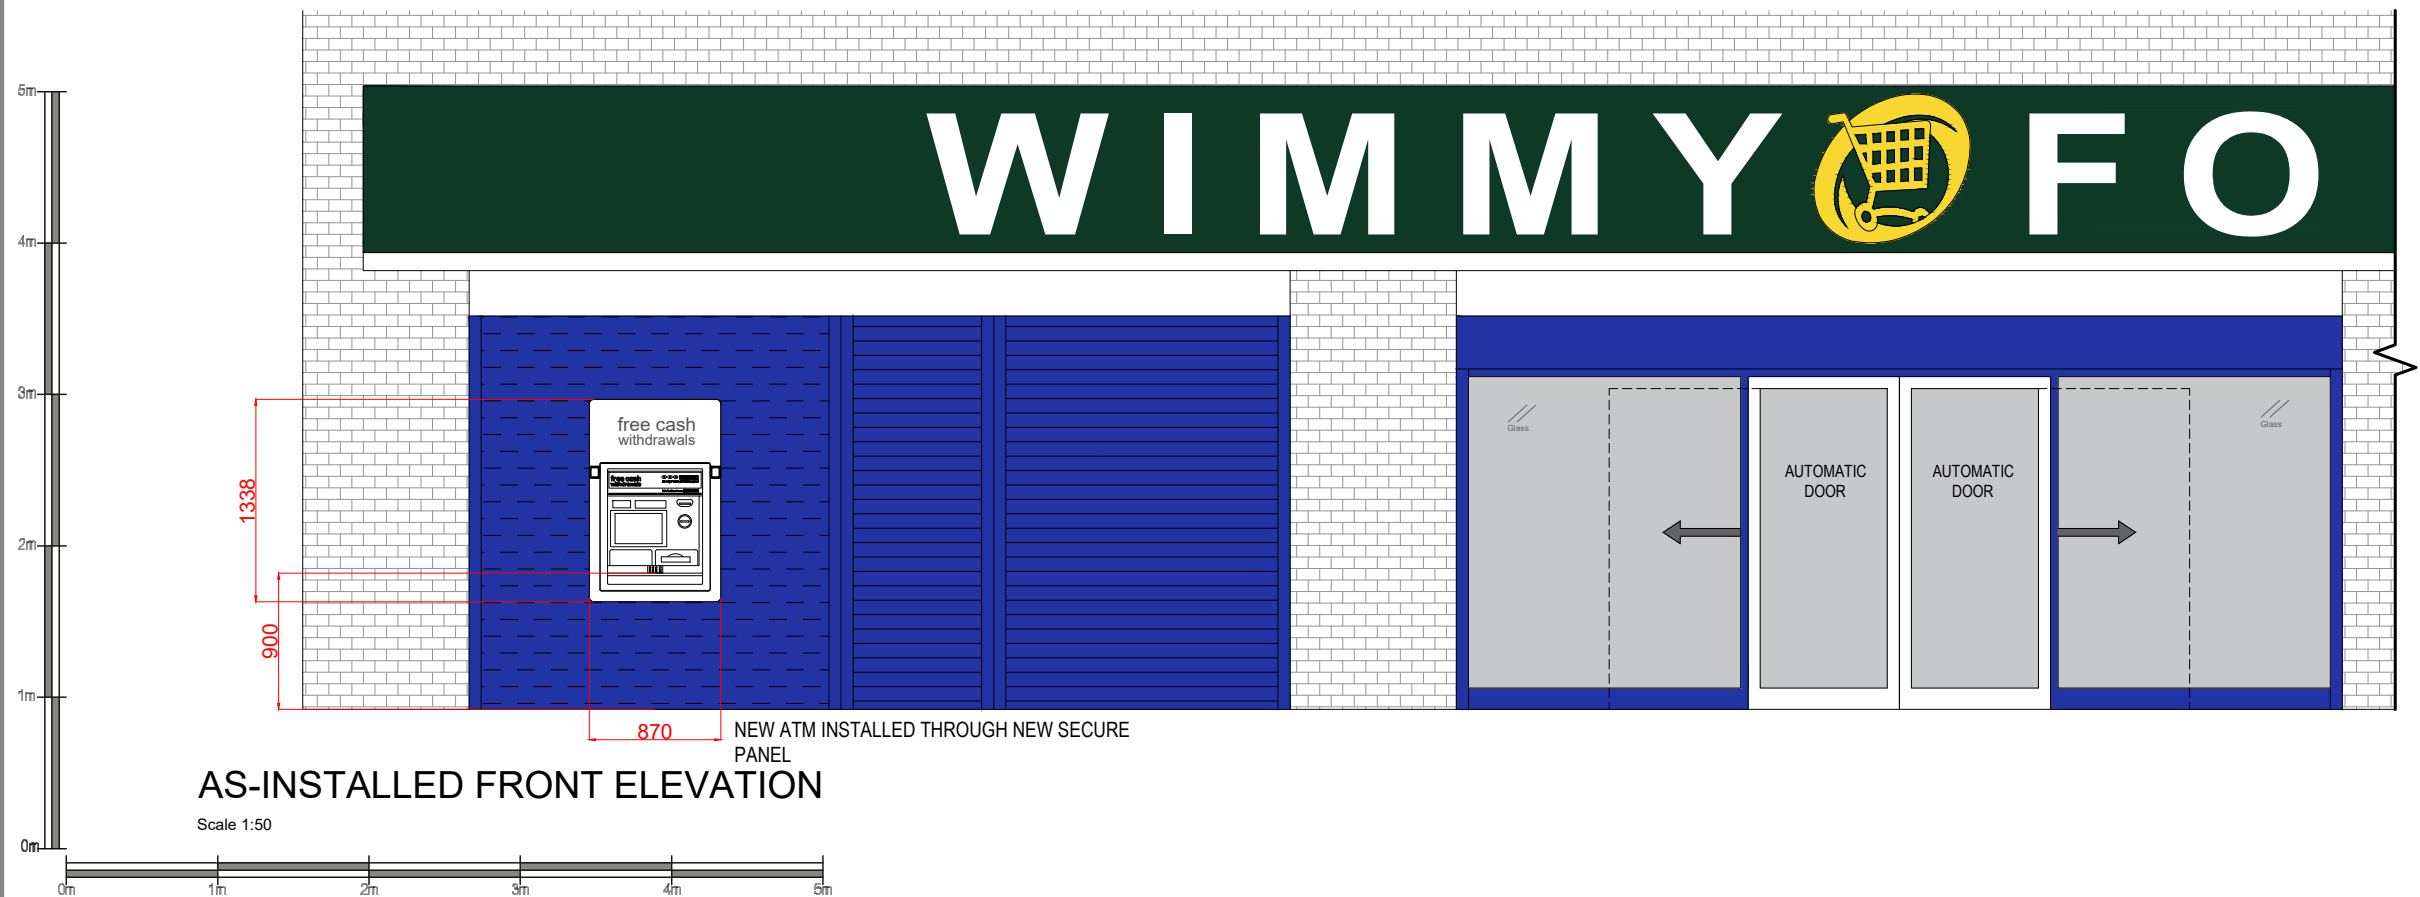

Date: Comments: By:

GENERAL NOTES:
1) All dimensions in millimeters unless otherwise stated.

Site:
Wimmy Food Store,
260 Wilmslow Road,
Manchester,
M14 6JR

Drawing Title:
As-Installed Plan and Elevation

Ref: T020343_AI	Date: 17/02/2021	Rev:
Scale: 1:50	Paper: A3	Date Rev: