

LEGEND

Site Boundary

A 12/08/21 SA SH Amended plans
- 27/07/21 SA SH Initial Issue
No. Date Dwn Chk App Revision or reason for issue

Client
Qais Ahmed

createit studios
Architects & Designers


Create It Studios (NW) Ltd
Universal Square
Devonshire Street North
Manchester M12 6JH
0161 974 6165
www.createitstudios.co.uk
info@createitstudios.co.uk

Project Title
270 Kings Rd, Manchester M21 0XQ

Scale / North Point
1 : 100

Drawing Title
As-Built Floor Plans


Drawing Number
A1311(03)002
Drawing Status
Preliminary
Revision
A

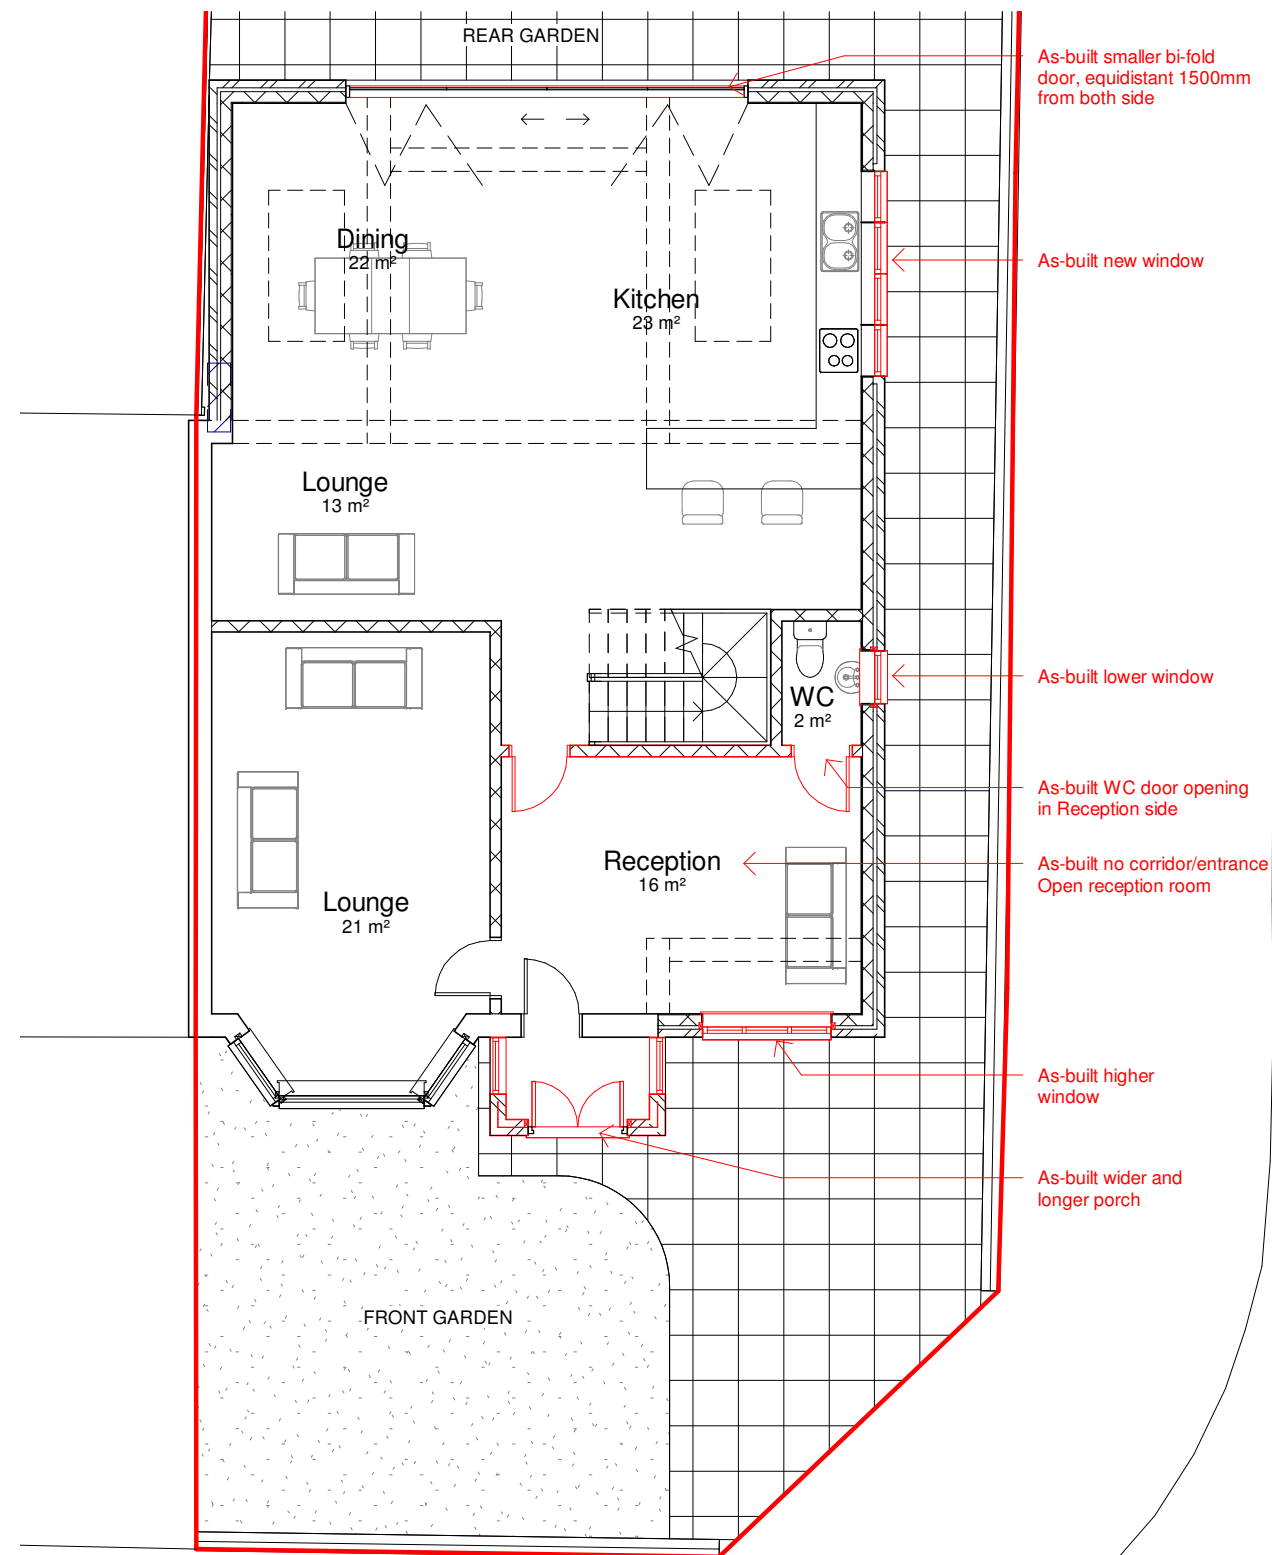

1

As-Built Ground Floor Plan

1 : 100

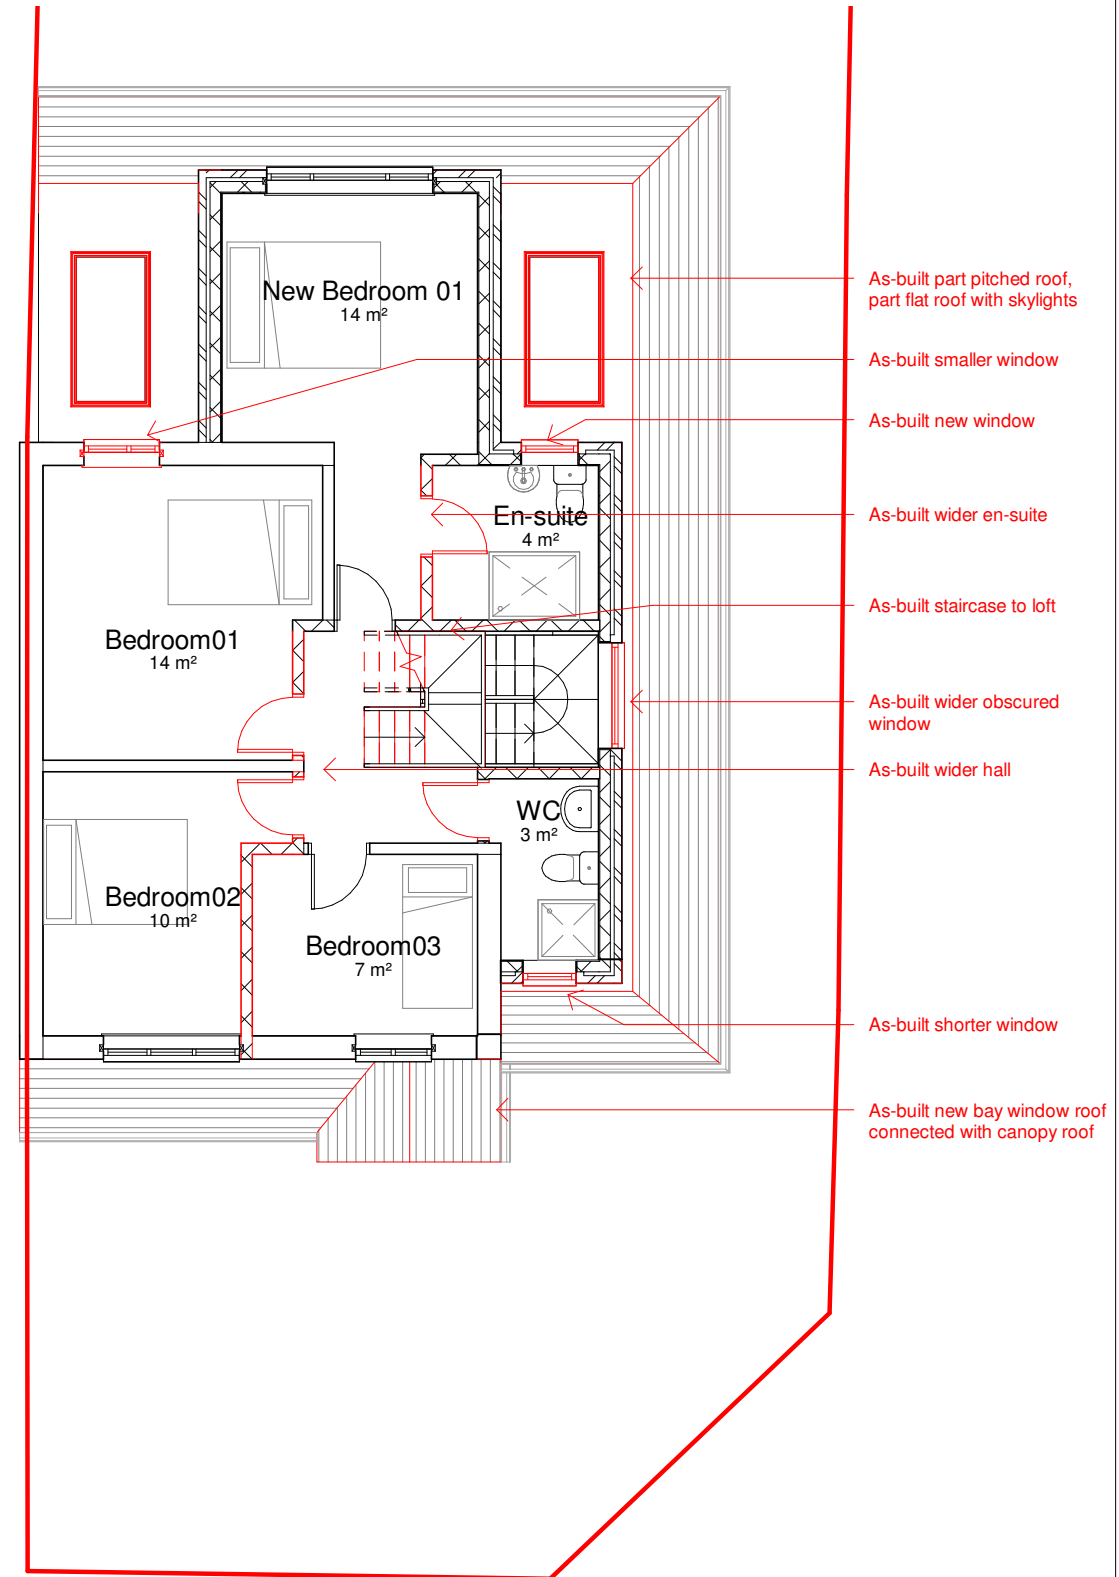

2

As-Built First Floor Plan

1 : 100

0 1 2 3 4m
1 : 100