




SFS Insulation - Rockwool Flexi

- Tech Sub: 355-TQS-SUB-00001
- Thickness: 100mm
- Reaction to fire: Euroclass A1 (EN13501-1)




Fire Break - Fischer

- Tech Sub: 355-TQS-SUB-00005 & 355-TQS-SUB-00006
- Horizontal FFB VS Ventistop Cavity Barrier & Vertical FCF CL Barrier
- Fire performance required: 60/60

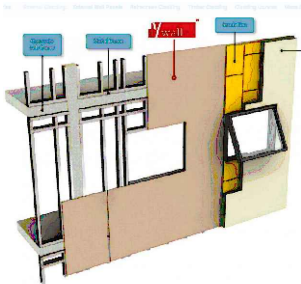

CP Board - Y-Wall 12mm

- Tech Sub: 355-TQS-SUB-00002
- Thickness: 12mm
- Reaction to fire: A1 Classification, BS 476 Part 4 Non-Combustible.

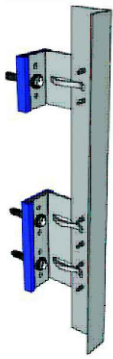


Helping Hand System - Fast Frame

- Tech Sub: 355-TQS-SUB-00020
- Reaction to fire: The System has an A1 Classification in Accordance With the National Building Regulations
- Vertical Subframe (Rail Fixed Into Brackets)
- 116mm Cavity to Allow for Air Flow
- For Fixing Specifications Please Refer to 355-TQS-SUB-00019




Breather Membrane - Cortex 0200FR

- Tech Sub: 355-TQS-SUB-00003
- Reaction to fire: A1 (EN 13501-1)

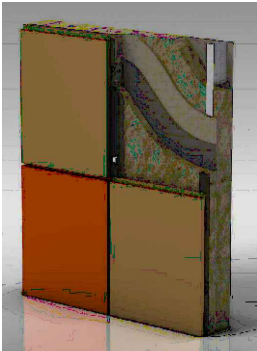

Hook On Panel - Genius Prime

- Tech Sub: 355-TQS-SUB-00010
- Reaction to fire: A1 Non-Combustible
- Finish: TBC
- Hooked On Clips and Fixed Into Rails @ Top of Panel

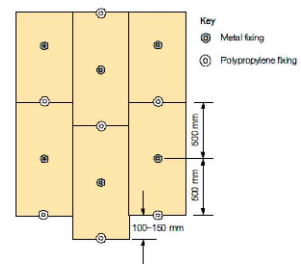


Insulation - Rockwool Duo-Slab

- Tech Sub: 355-TQS-SUB-00004
- Thickness: 75mm
- Reaction to fire: Euroclass A1 (EN13501-1)
- Fixings: Both Steel and Plastic Washers Required for Each piece of Insulation


U-Value

- The system achieve: TBC by Supplier

EXISTING SCHEME

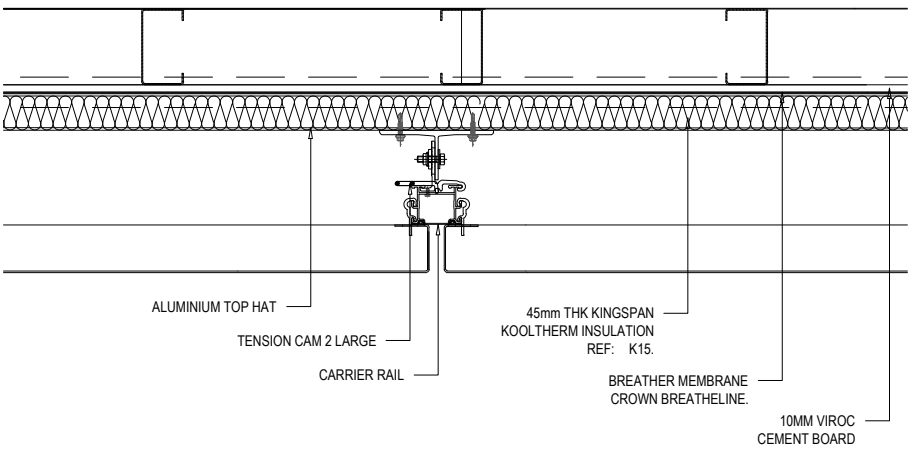

As-Built Drawings
O&M File No: 500-B3-003-C

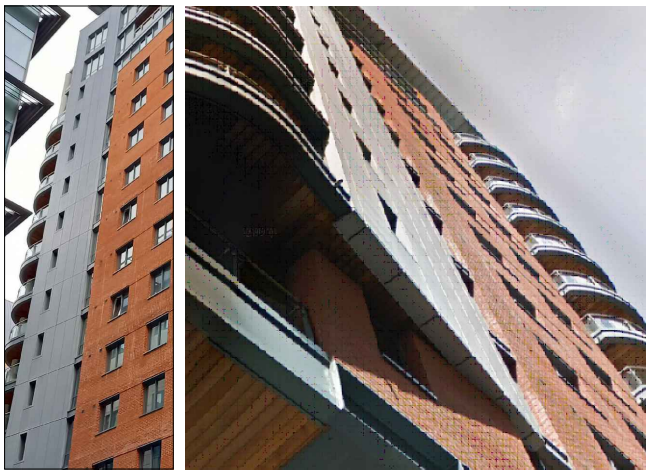


Existing Panels

****For Further Specification and Data, Please Refer to:**

- 1. NBS Spec: H92 - Rainscreen Cladding
- 2. O&M Files: Page 98**

PROPOSED SCHEME

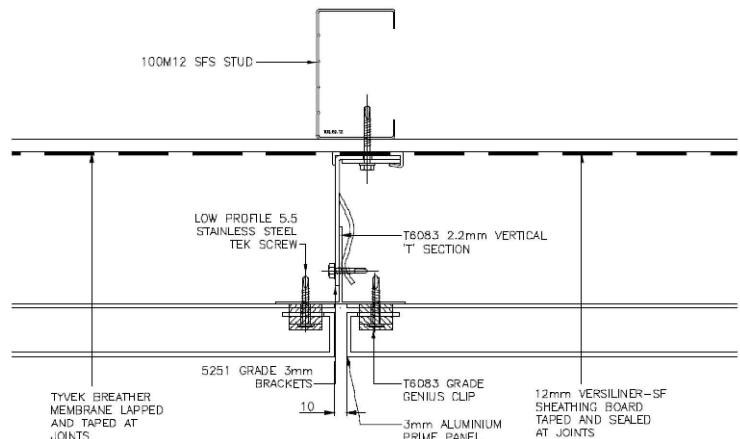

Manufacturer Detail
Genius Prime System



 F A C A D E S	Novo Facades LTD 74 Broadway Peterborough PE11SU Tel 01733 639020 www.novofacades.co.uk			Project Title	Leftbank	Drawing Title			Scale		NTS @A3	
				Location	M3 3AN	Specification - Hook On Panel Replacement Genius Prime			Drawn by	G.S.	Date	06.07.2021
									Checked by	D.L.	Date	
		☐ STATUS A ☐ STATUS B ☐ STATUS C		GENERAL NOTES: DIMENSIONS ARE FOR INSTALLATION PURPOSES ONLY. SITE DIMENSIONS MAY VARY. ANY DIMENSIONS ARE TO BE CONFIRMED ON SITE.			Drawing No	NV355-DRG-SUB-SP003	Rev.	P1	Sheet 01 of 01	