


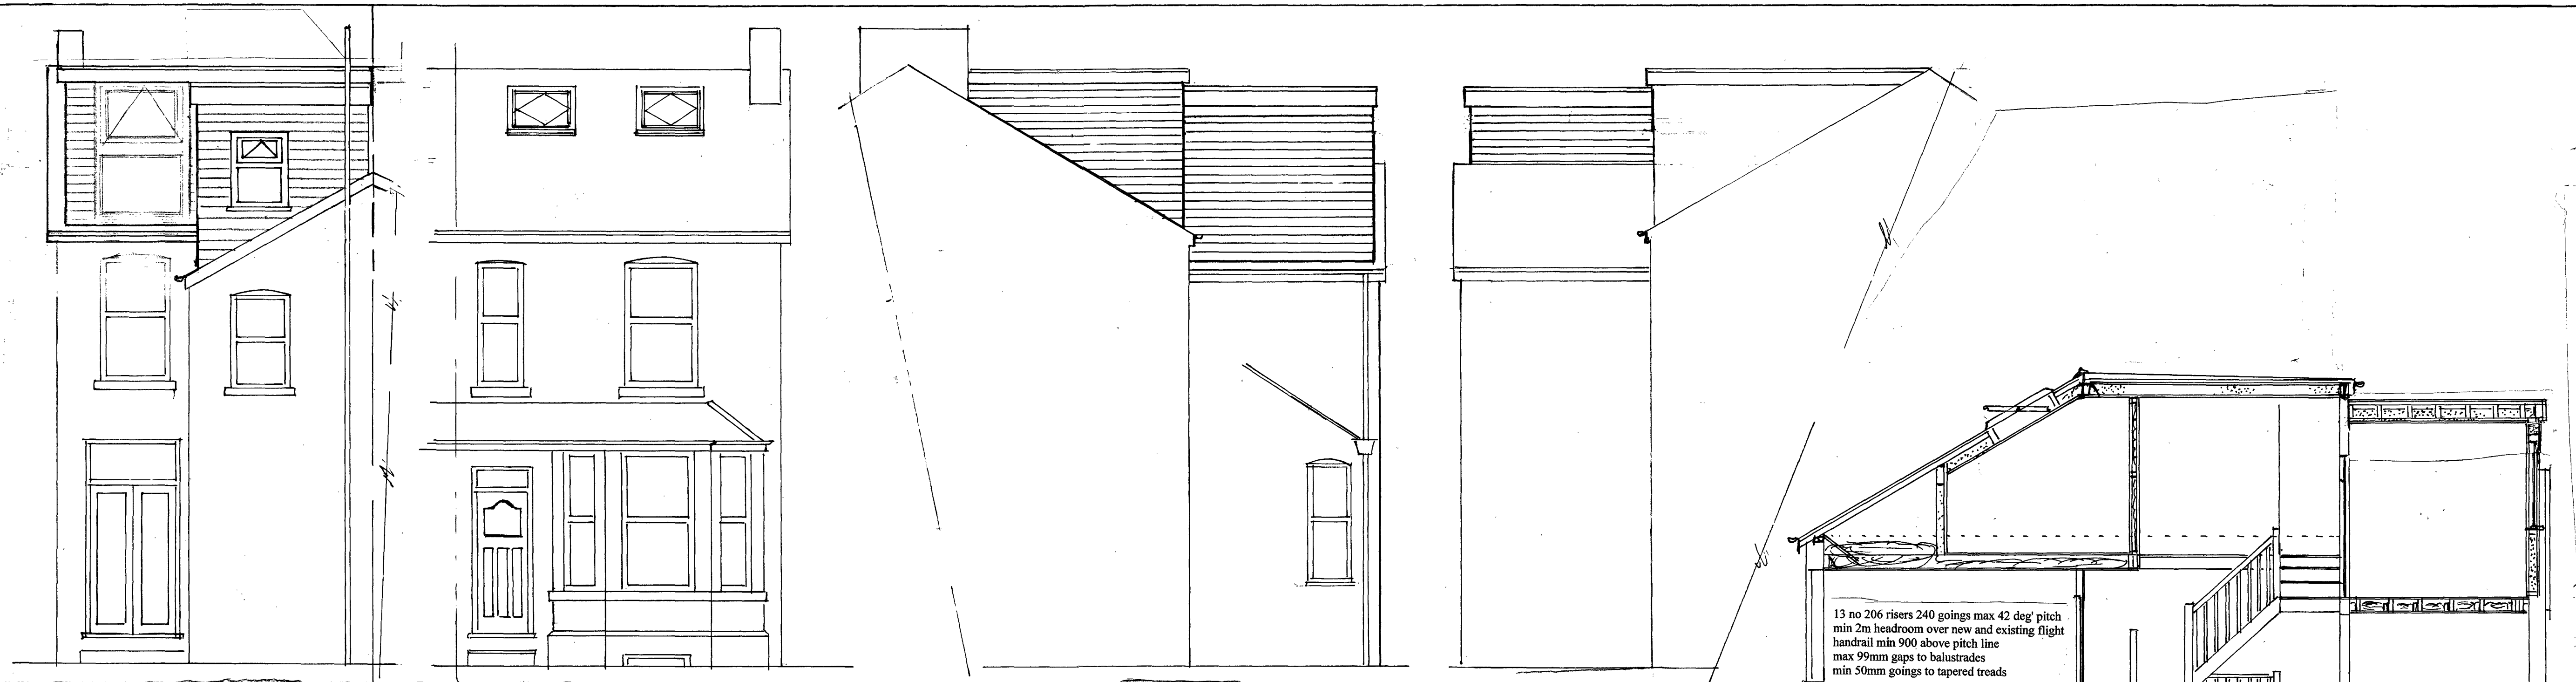

REAR

FRONT

SIDE

SIDE


13 no 206 risers 240 goings max 42 deg pitch
min 2m headroom over new and existing flight
handrail min 900 above pitch line
max 99mm gaps to balustrades
min 50mm goings to tapered treads




FRONT



REAR



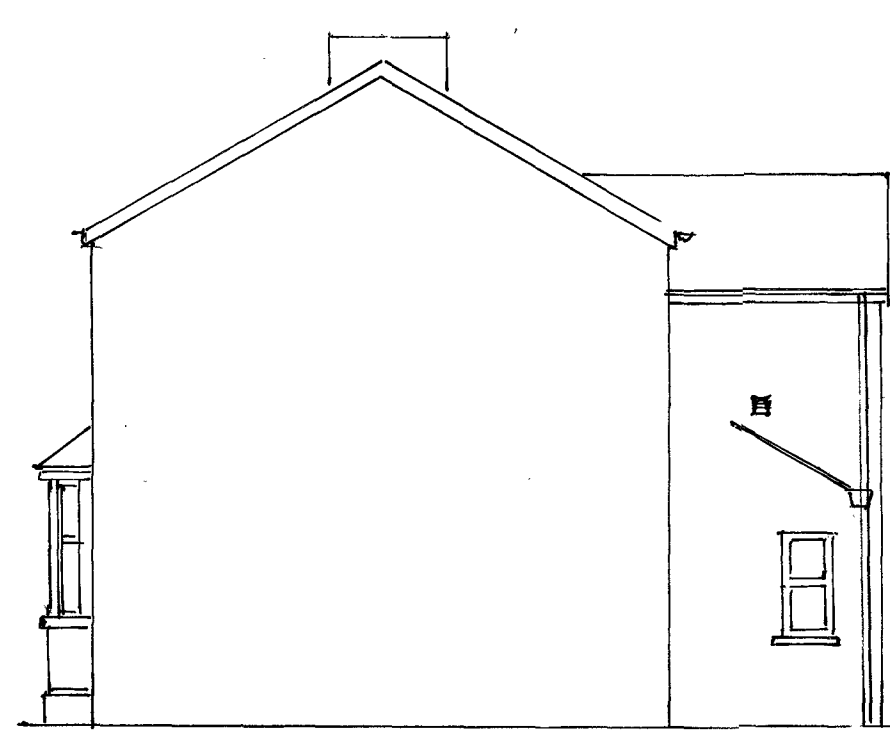


SIDE

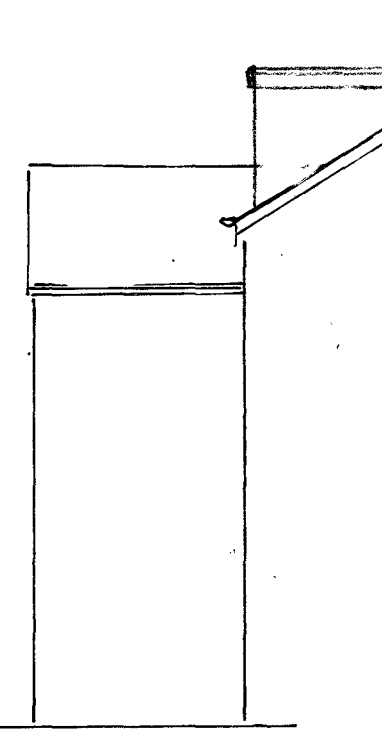


SIDE


Extract to En Suite 15lit/sec extraction rate
Waste pipes 38dia with DS traps to extg SVP
PVCu D/G Velux windows 28mm air gaps

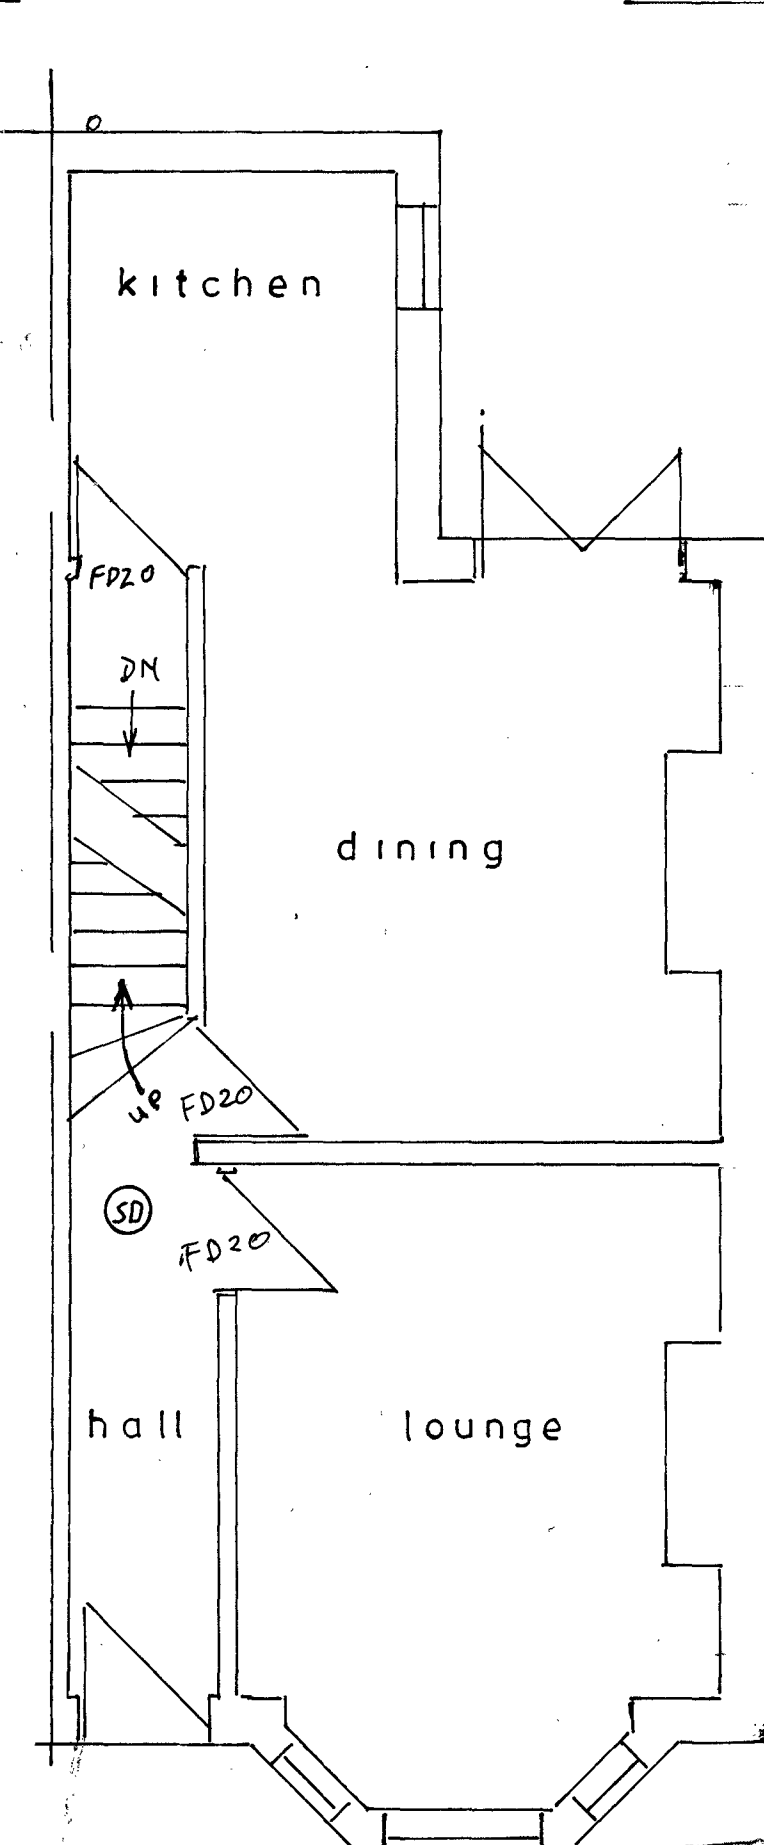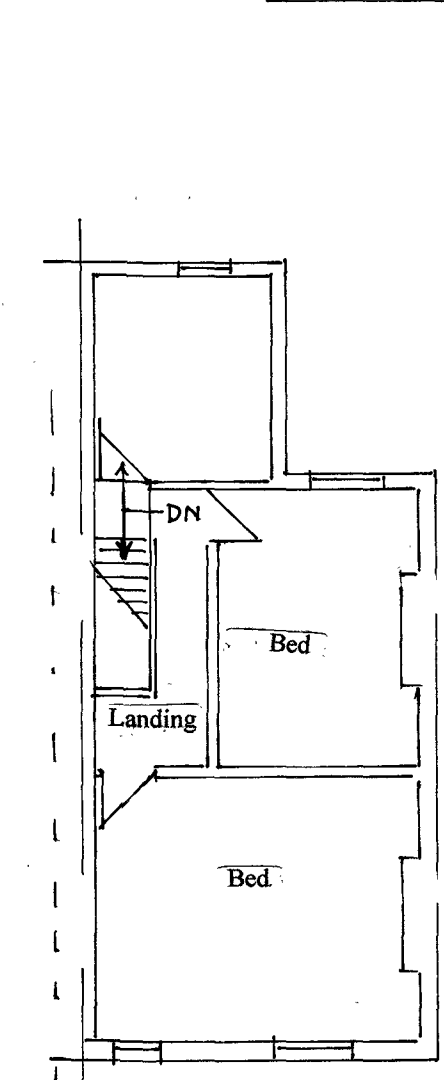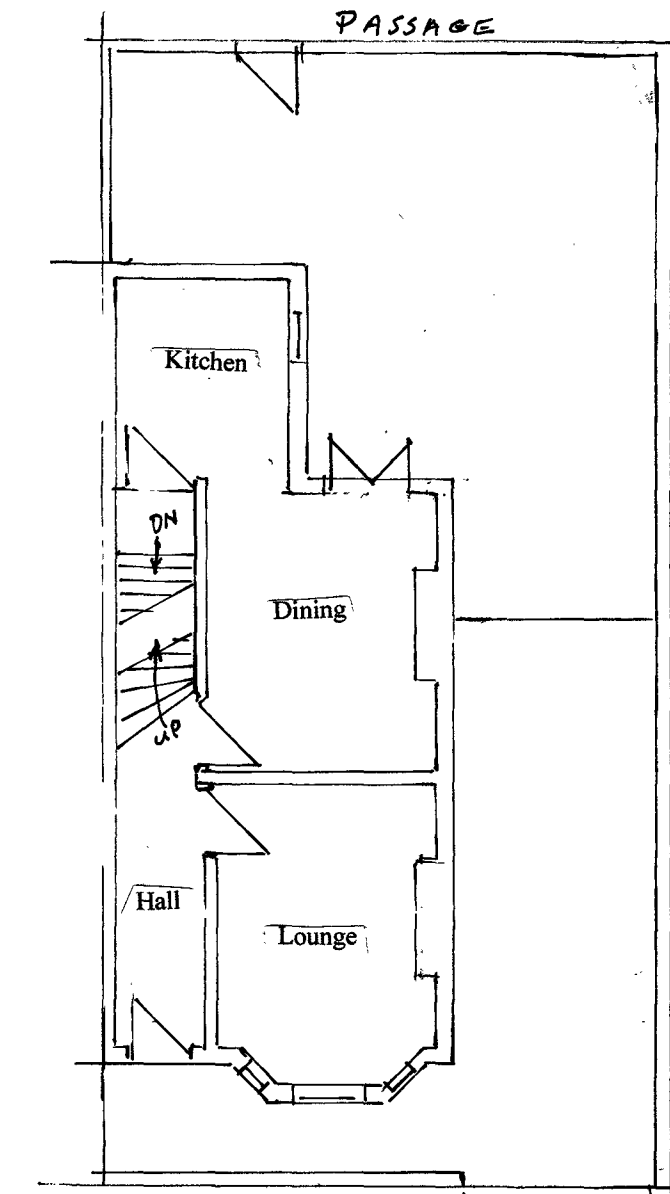


GROUND FLOOR

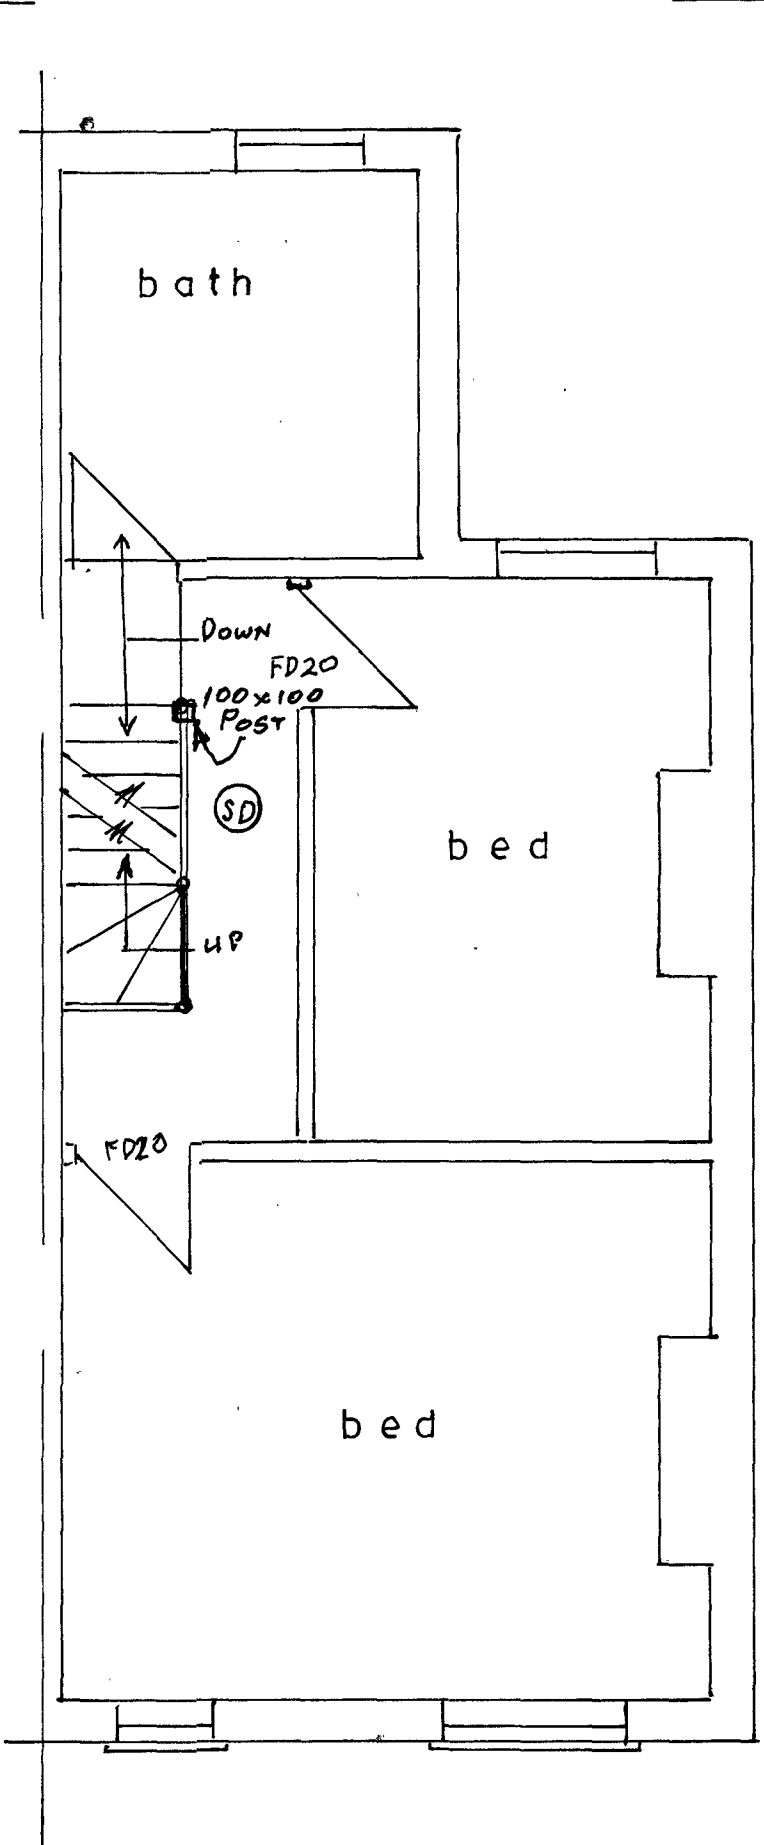


FIRST FLOOR

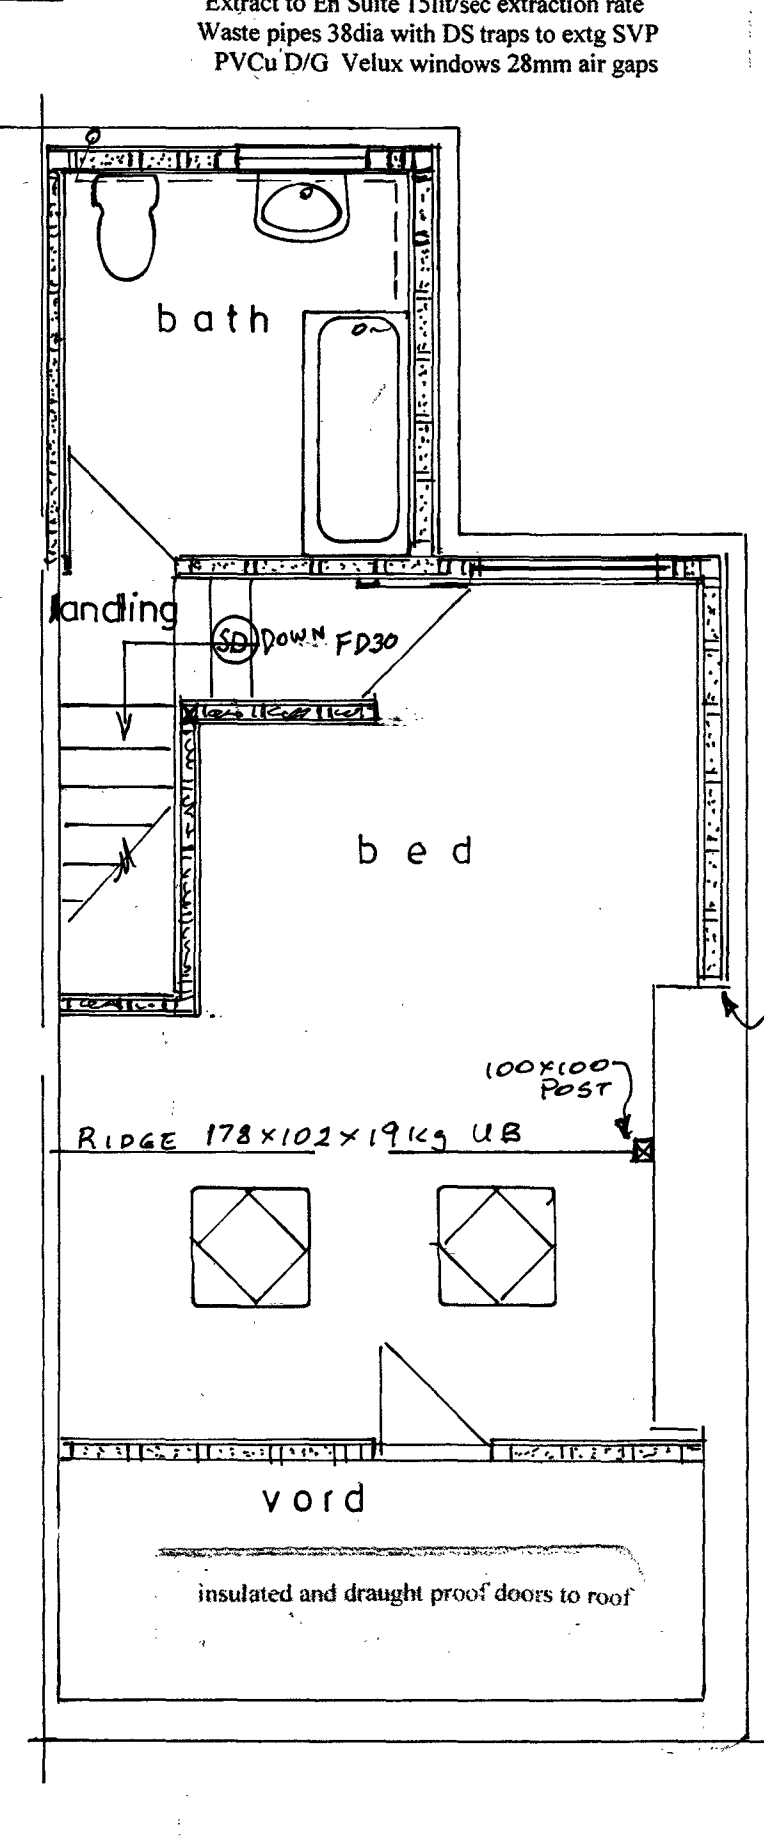

SECOND FLOOR

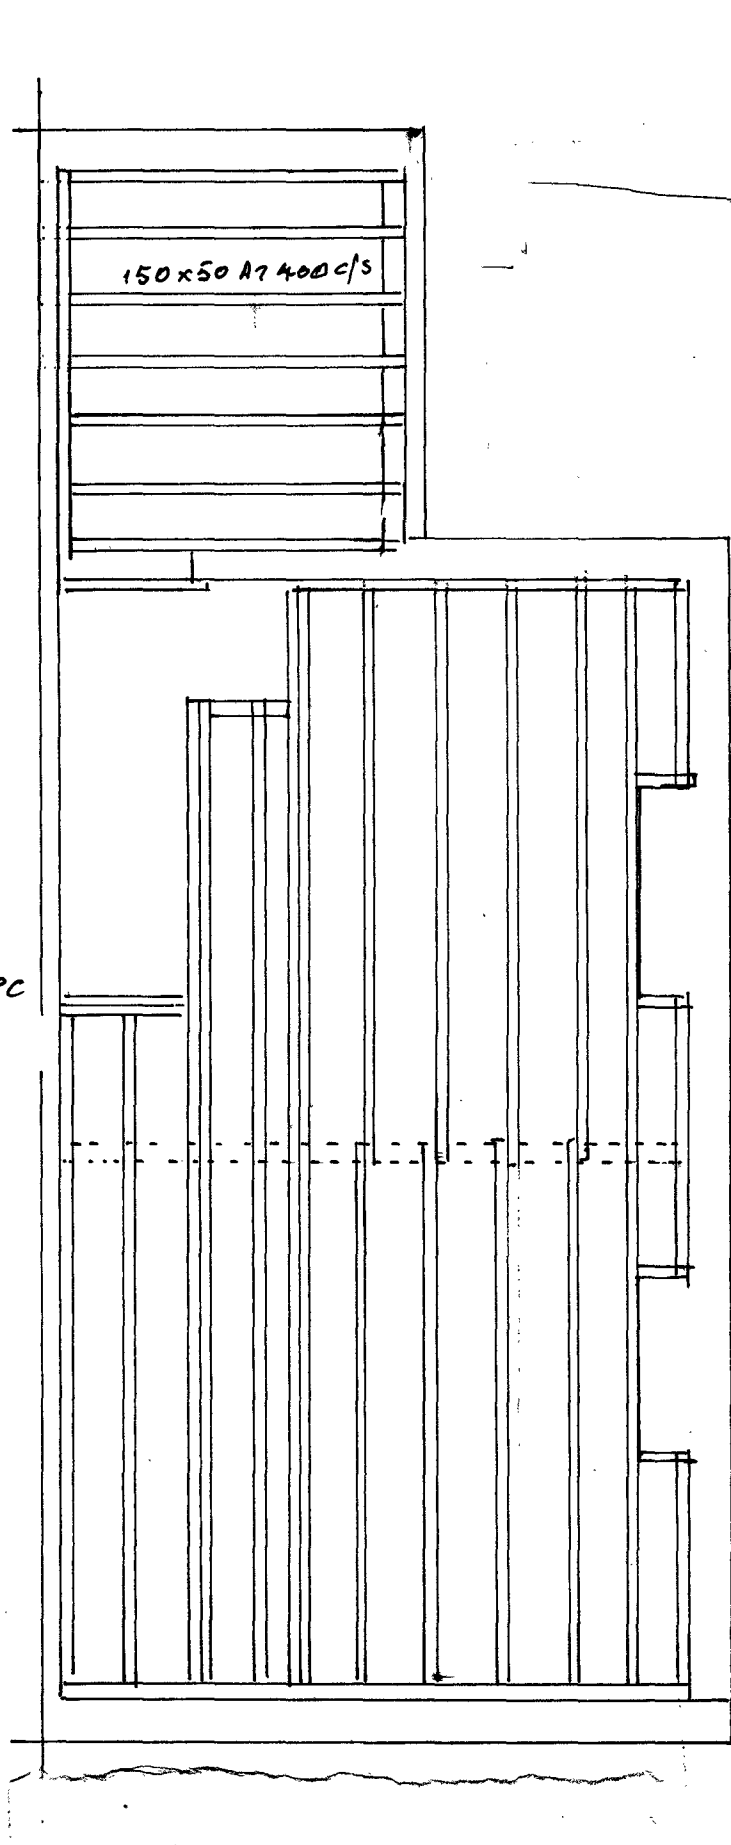

JOIST LAYOUT

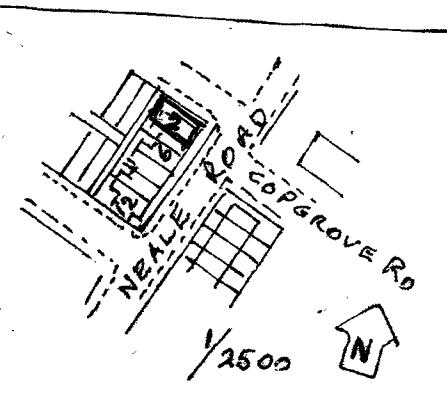

MAY21 REAR DORMER RAISED
AS BUILT.

LOFT CONVERSION
WITH DORMER
at 2 NEALE ROAD
CHORLTON M21 9DQ
for
MR & MRS T LINDSAY

1:100 1:50 AUG 20