


General Notes

The Architect shall have no responsibility for any use made of this document other than for that which it was prepared and issued.
All dimensions should be checked on site. Do not scale from this drawing. To be read in conjunction with all other Consultant's drawings. The Architect to be immediately notified of any discrepancies.

Copyright on this drawing retained by the Architect.

LEGEND

Site Boundary

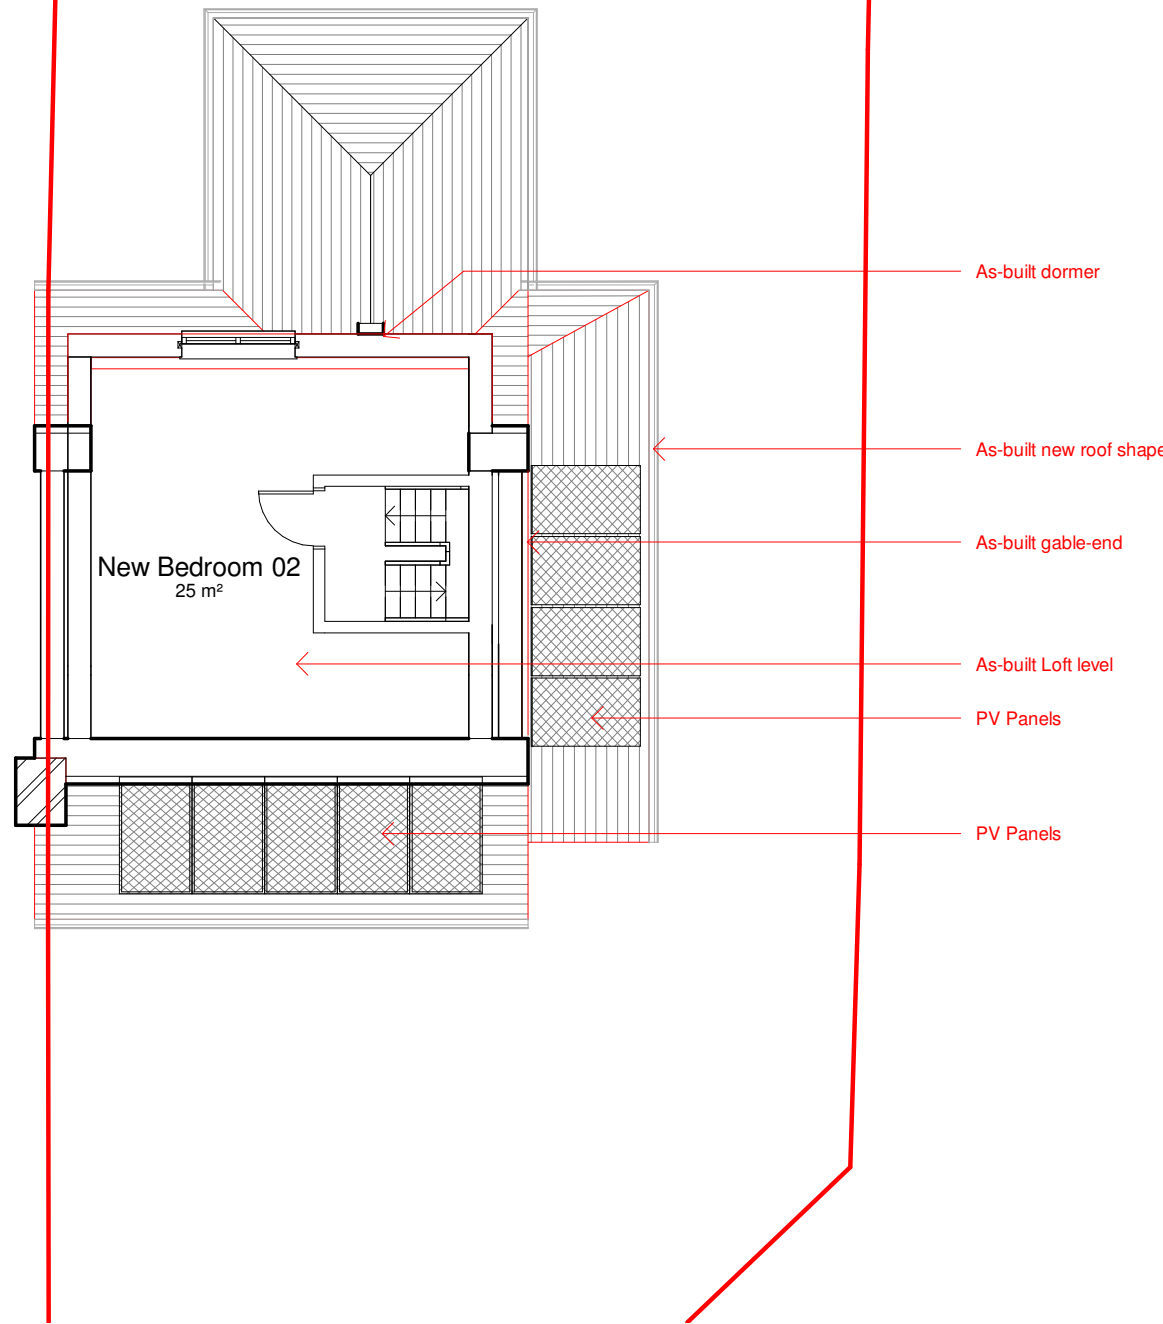

1 As-Built Loft Plan
1 : 100

0 1 2 3 4m
1:100

A 12/08/21 SA SH Amended plans
- 27/07/21 SA SH Initial Issue
No. Date Dwn Chk App Revision or reason for issue

Client
Qais Ahmed

create **it** studios
Architects & Designers

Create It Studios (NW) Ltd
Universal Square
Devonshire Street North
Manchester M12 6JH
0161 974 6165
www.createitstudios.co.uk
info@createitstudios.co.uk

Project Title
270 Kings Rd, Manchester M21 0XQ

Scale / North Point
1 : 100

Drawing Title
As-Built Loft Plan

Drawing Number
A1311(03)003
Drawing Status
Preliminary
Revision
A