


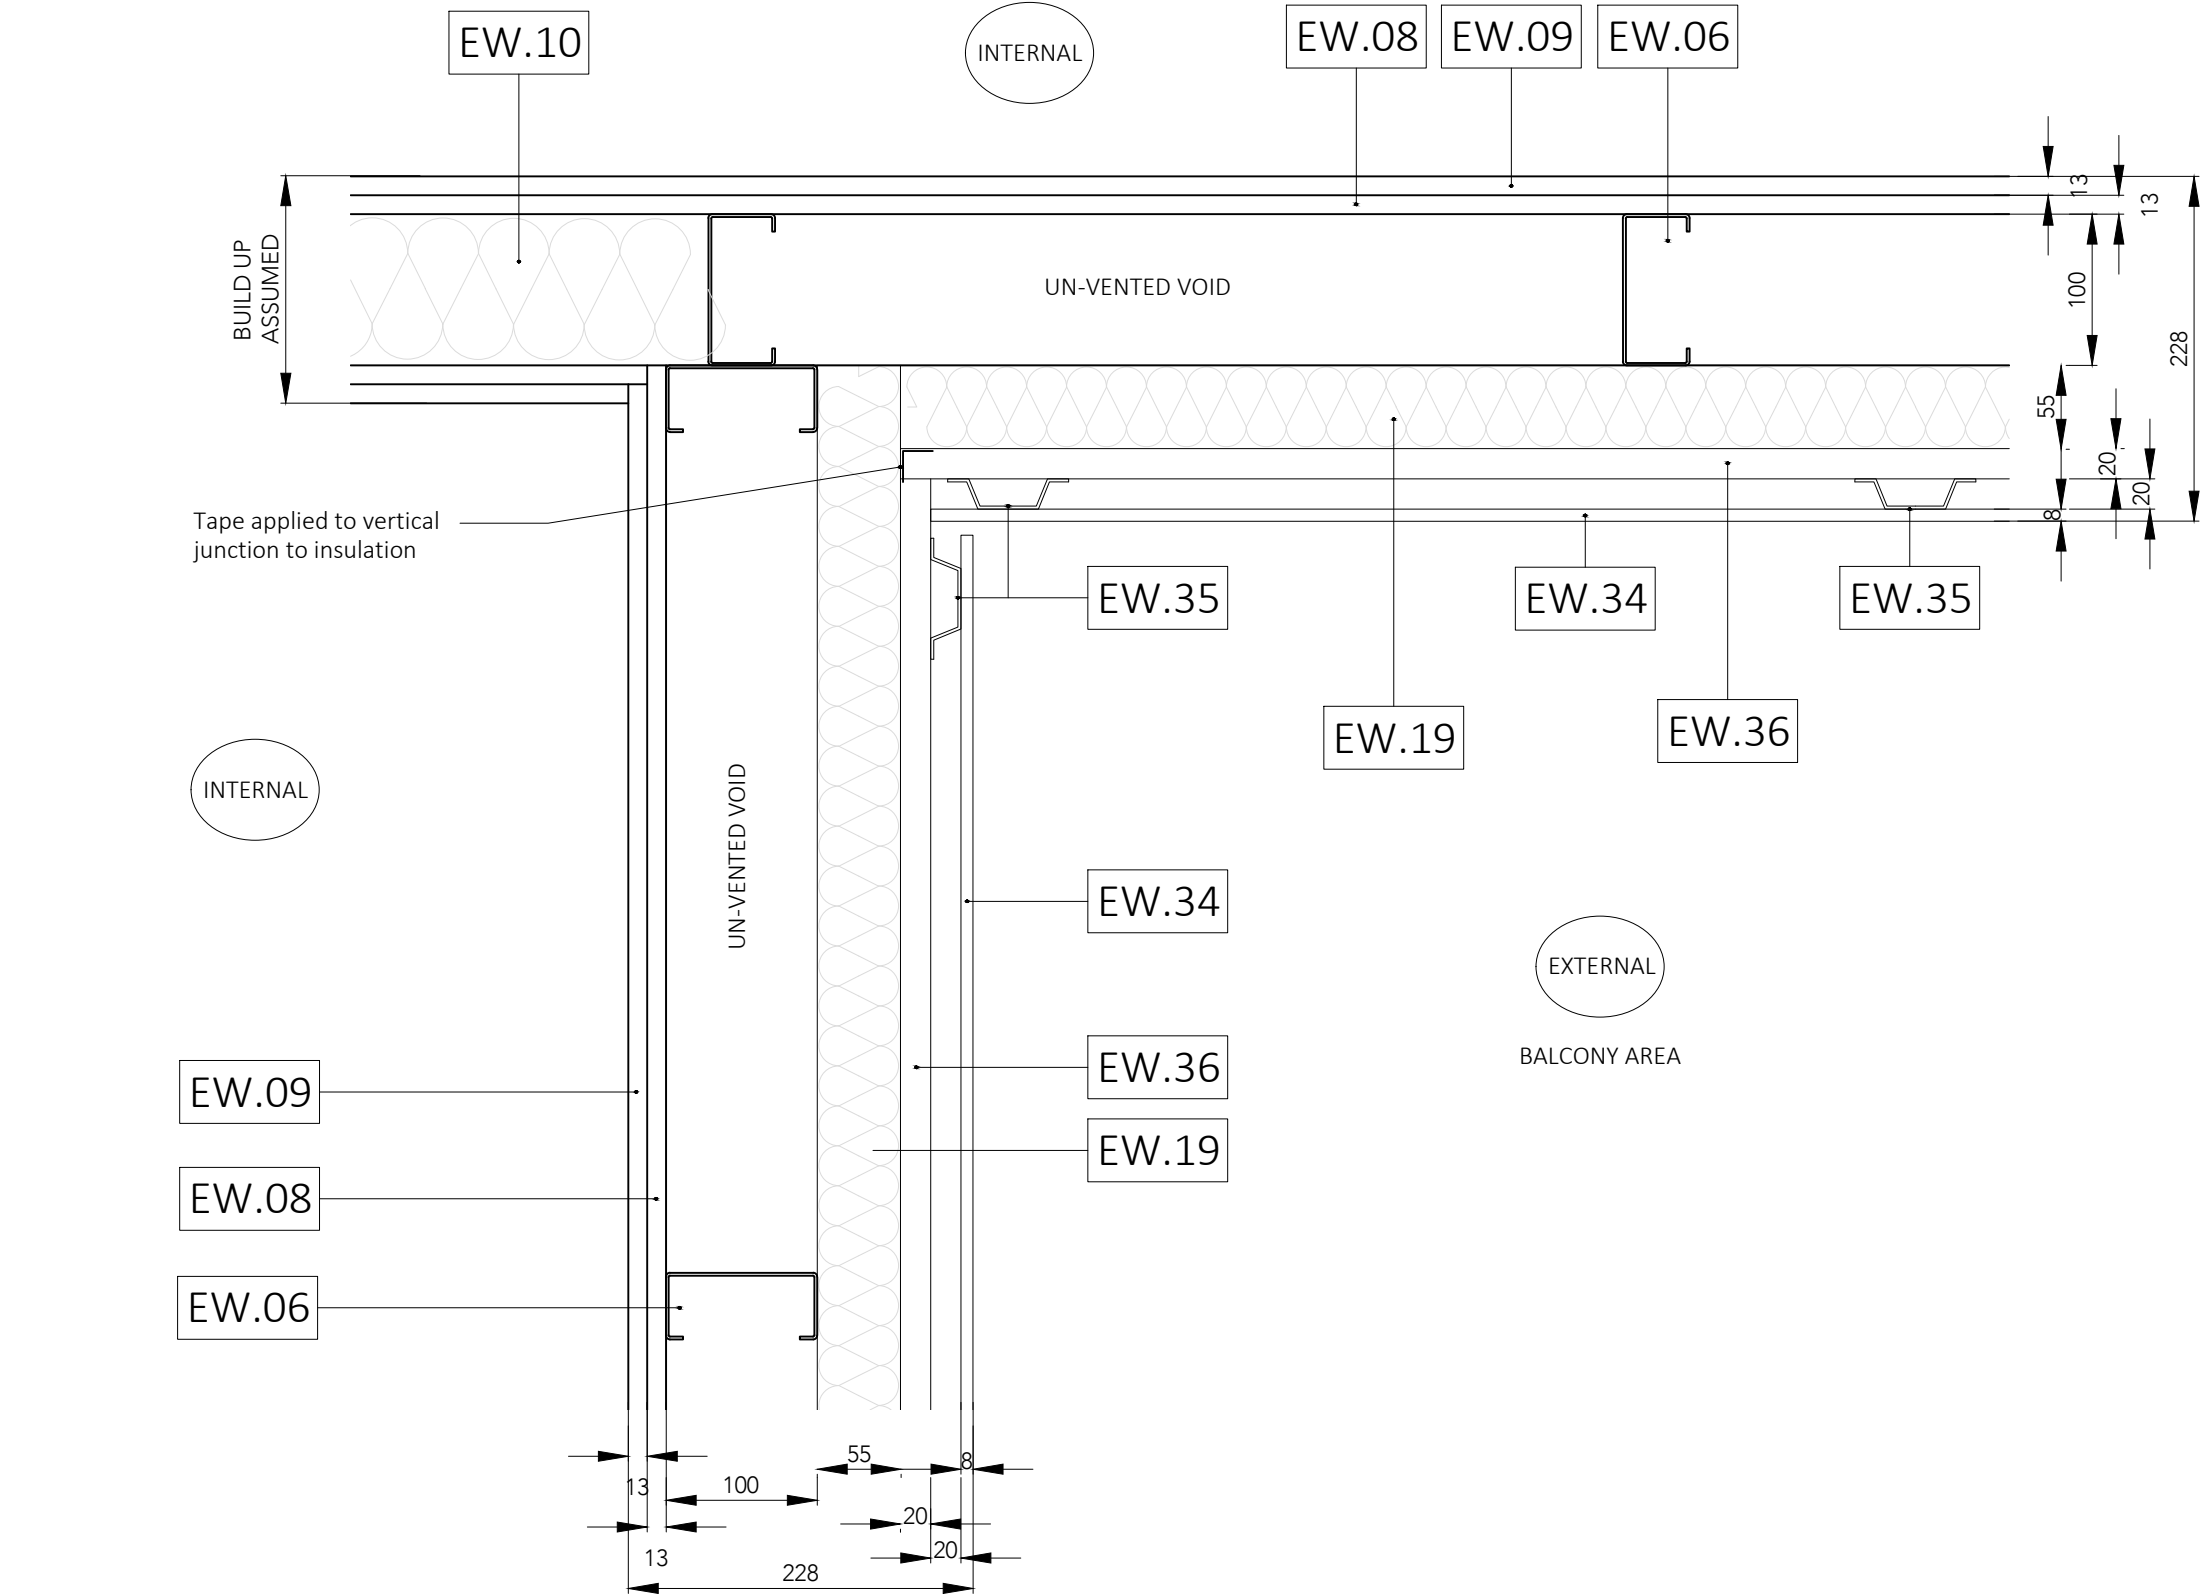

Note:
Do not scale from this drawing.
Dimensions are to be checked on site.
If in doubt please ask.

GENERAL NOTES

The Existing General Arrangement base drawings (Plans, Sections and Elevations) have been compiled with the limited drawing information provided to Buttress.

No checks have been made, or surveys undertaken, to confirm the accuracy of this information, nor any detailed modifications made to represent 'As built' information. Buttress do not accept any liability for this information, or reliance on these for any purpose.

Where any measurements, or information (being critical) and required for construction purposes, the contractor should undertake all necessary site surveys to ascertain accurate information to produce any detailed manufacturing drawings, or for any other purpose.

The Existing detail base drawings for the Wall Types have been compiled with the limited drawing information provided to Buttress in association with limited intrusive opening up carried out by others.

The limited extent of the intrusive opening up, is therefore only intended for the purpose of tender and compilation of the Existing Wall Type Base drawings and As Proposed design intent drawings.

Buttress do not accept any liability for the accuracy of this base information, or reliance on these for construction purposes.

Where any measurements or information being critical and required for construction purposes, the contractor should undertake all necessary site surveys to ascertain accurate information to enable the completion of the design. Were any significant variations are discovered these should be relayed to the CA for review.

The Design Intent 'As Proposed' detail Drawings have been produced in association with manufacturers input and should be read with the (NBS) specification for all associated components. These design intent drawings and NBS are for the purpose of Tender and for the contractor to complete their Sub-Contractor Detailed working drawings, as required under the CDP, as detailed in the Contract preliminaries and the NBS. The drawings are not intended to be utilised for construction purposes, nor are they fully representative of all the details or detailed interfaces required.

Sub-Contractors detailed fabrication drawings for construction should be submitted for comments in accordance with the contract documentation requirements.

T1 - 28/04/21 - Tender Issue

Buttress

41 Bengal St
Manchester
M4 6AF

T 0161 236 3303
E contact@buttress.net
W www.buttress.net

EXISTING WALL BUILD UP	
EW6	100 x 50mm Metsec steel frame system (S.F.S)
EW8	Plasterboard (type and thickness unknown)
EW9	Plasterboard with skim finish (Assumed)
EW10	Party wall (No intrusive survey carried out internally)
EW19	55mm Kingspan PIR rigid insulation

EW34	8mm fibre cement cladding panel (in two colours light and dark grey - Refer to elevation drawings for extent and location.
EW35	80 x 20mm vertical metal top hat sections @ 600cts typically
EW36	40 x 20mm horizontal metal Z sections @ 600cts typically

AS BUILT - BASED ON SITE INVESTIGATIONS	
WALL TYPE 2&3 - FIBRE CEMENT CLADDING PANELS BUILD UP. (EXTERNAL - INTERNAL)	
8mm 20mm 20mm 55mm 100mm 12.5mm 12.5mm	- GREY / WHITE FIBRE CEMENT CLADDING PANELS - VERTICAL METAL TOP HATS - HORIZONTAL METAL Z RAILS - PIR RIGID INSULATION - S.F.S. STEEL FRAME SYSTEM - PLASTERBOARD (ASSUMED) - PLASTERBOARD WITH SKIM FINISH
TOTAL U'VALUE - 0.33 w/m2K	

Project Title	TRINITY COURT		
Client	THOMASONS		
Location	MANCHESTER		
Drawing Title	WALL TYPE 2 & 3 AS EXISTING TYPICAL WALL BUILD UP		
Date	25/02/2021	Scale	1:5
Checked		Orig Paper Size	A3
Status TENDER			
Drawing ref	Job No	Drawing No	Revision
	9028	(04) 009	T1