

General Notes

The Architect shall have no responsibility for any use made of this document other than for that which it was prepared and issued.
All dimensions should be checked on site. Do not scale from this drawing. To be read in conjunction with all other Consultant's drawings. The Architect to be immediately notified of any discrepancies.


Copyright on this drawing retained by the Architect.



1

As-Built South Elevation


1 : 100

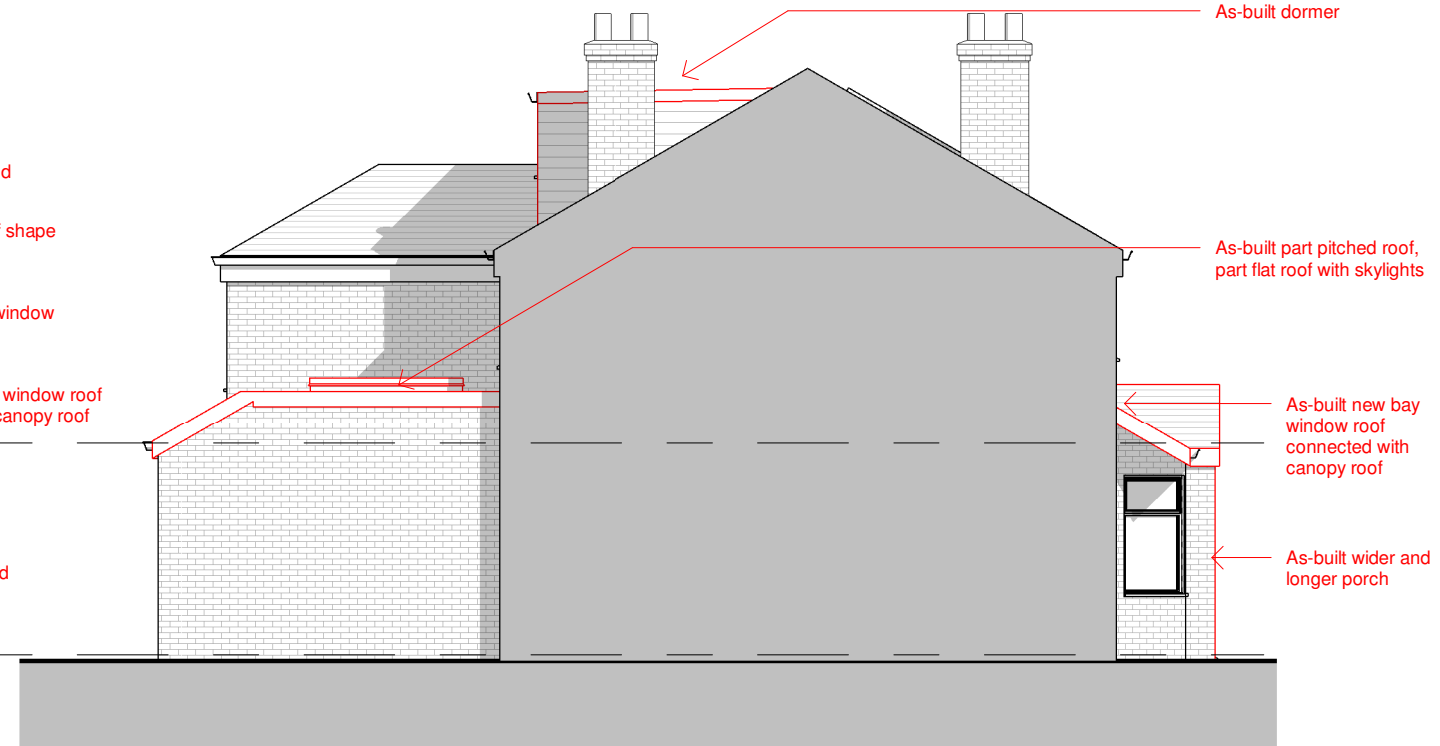

2

As-Built West Elevation


1 : 100

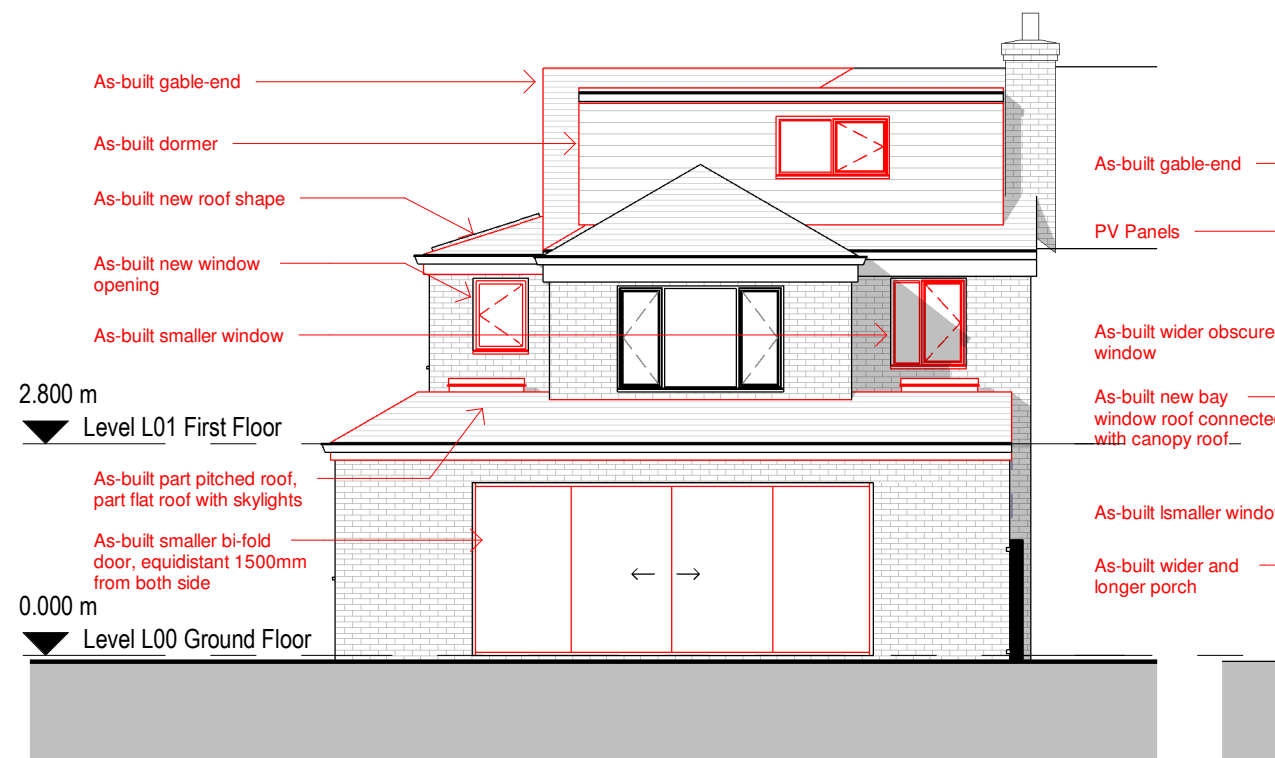

3

As-Built North Elevation

1 : 100

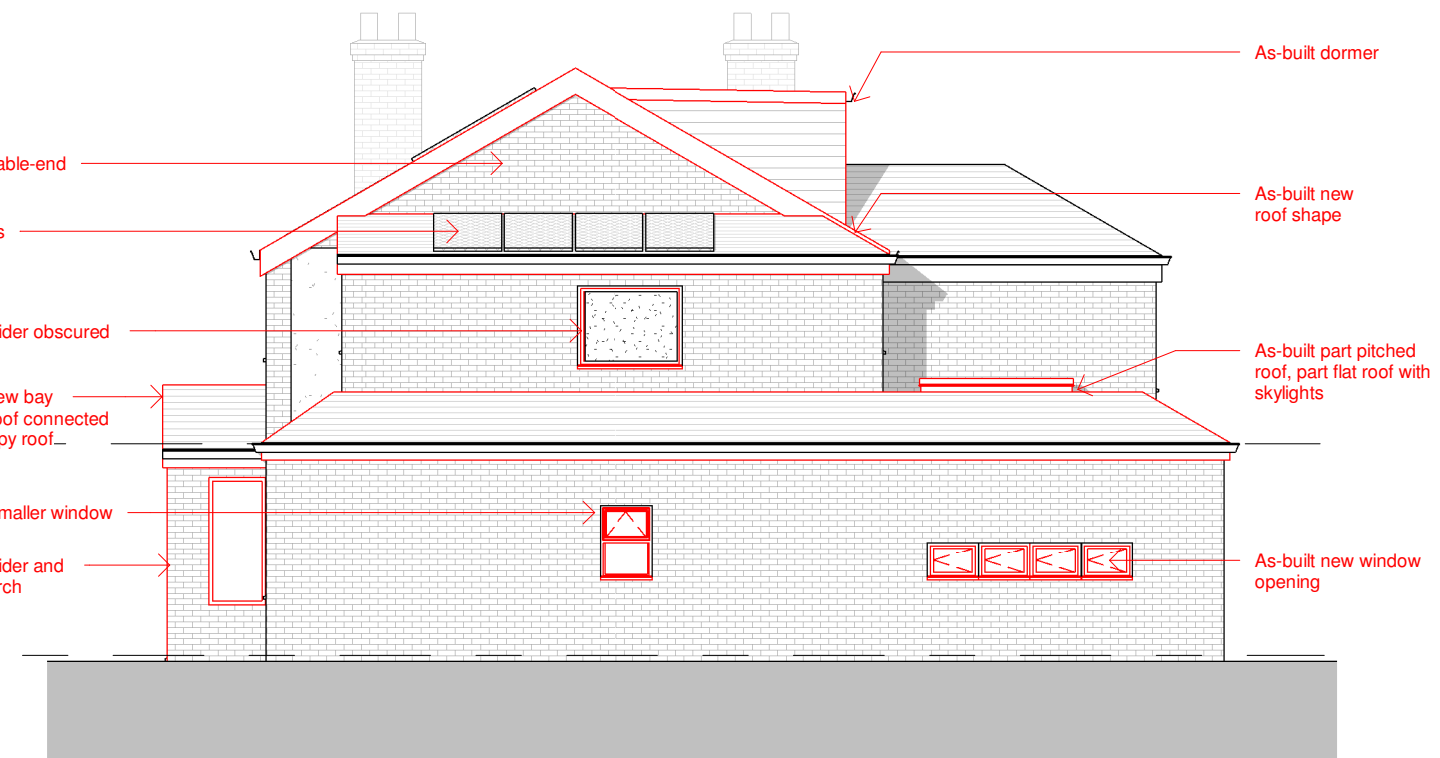

4

As-Built East Elevation

1 : 100

0 1 2 3 4m
1:100

A 12/08/21 SA SH Amended plans
27/07/21 SA SH Initial Issue
No. Date Dwn Chk App Revision or reason for issue

Client

Qais Ahmed

createit studios
Architects & Designers

Create It Studios (NW) Ltd
Universal Square
Devonshire Street North
Manchester M12 6JH
0161 974 6165
www.createitstudios.co.uk
info@createitstudios.co.uk

Project Title

270 Kings Rd, Manchester M21 0XQ

Scale / North Point

1 : 100

Drawing Title

As-Built Elevation

Drawing Number
A1311(03)004

Drawing Status
Preliminary

Revision
A