
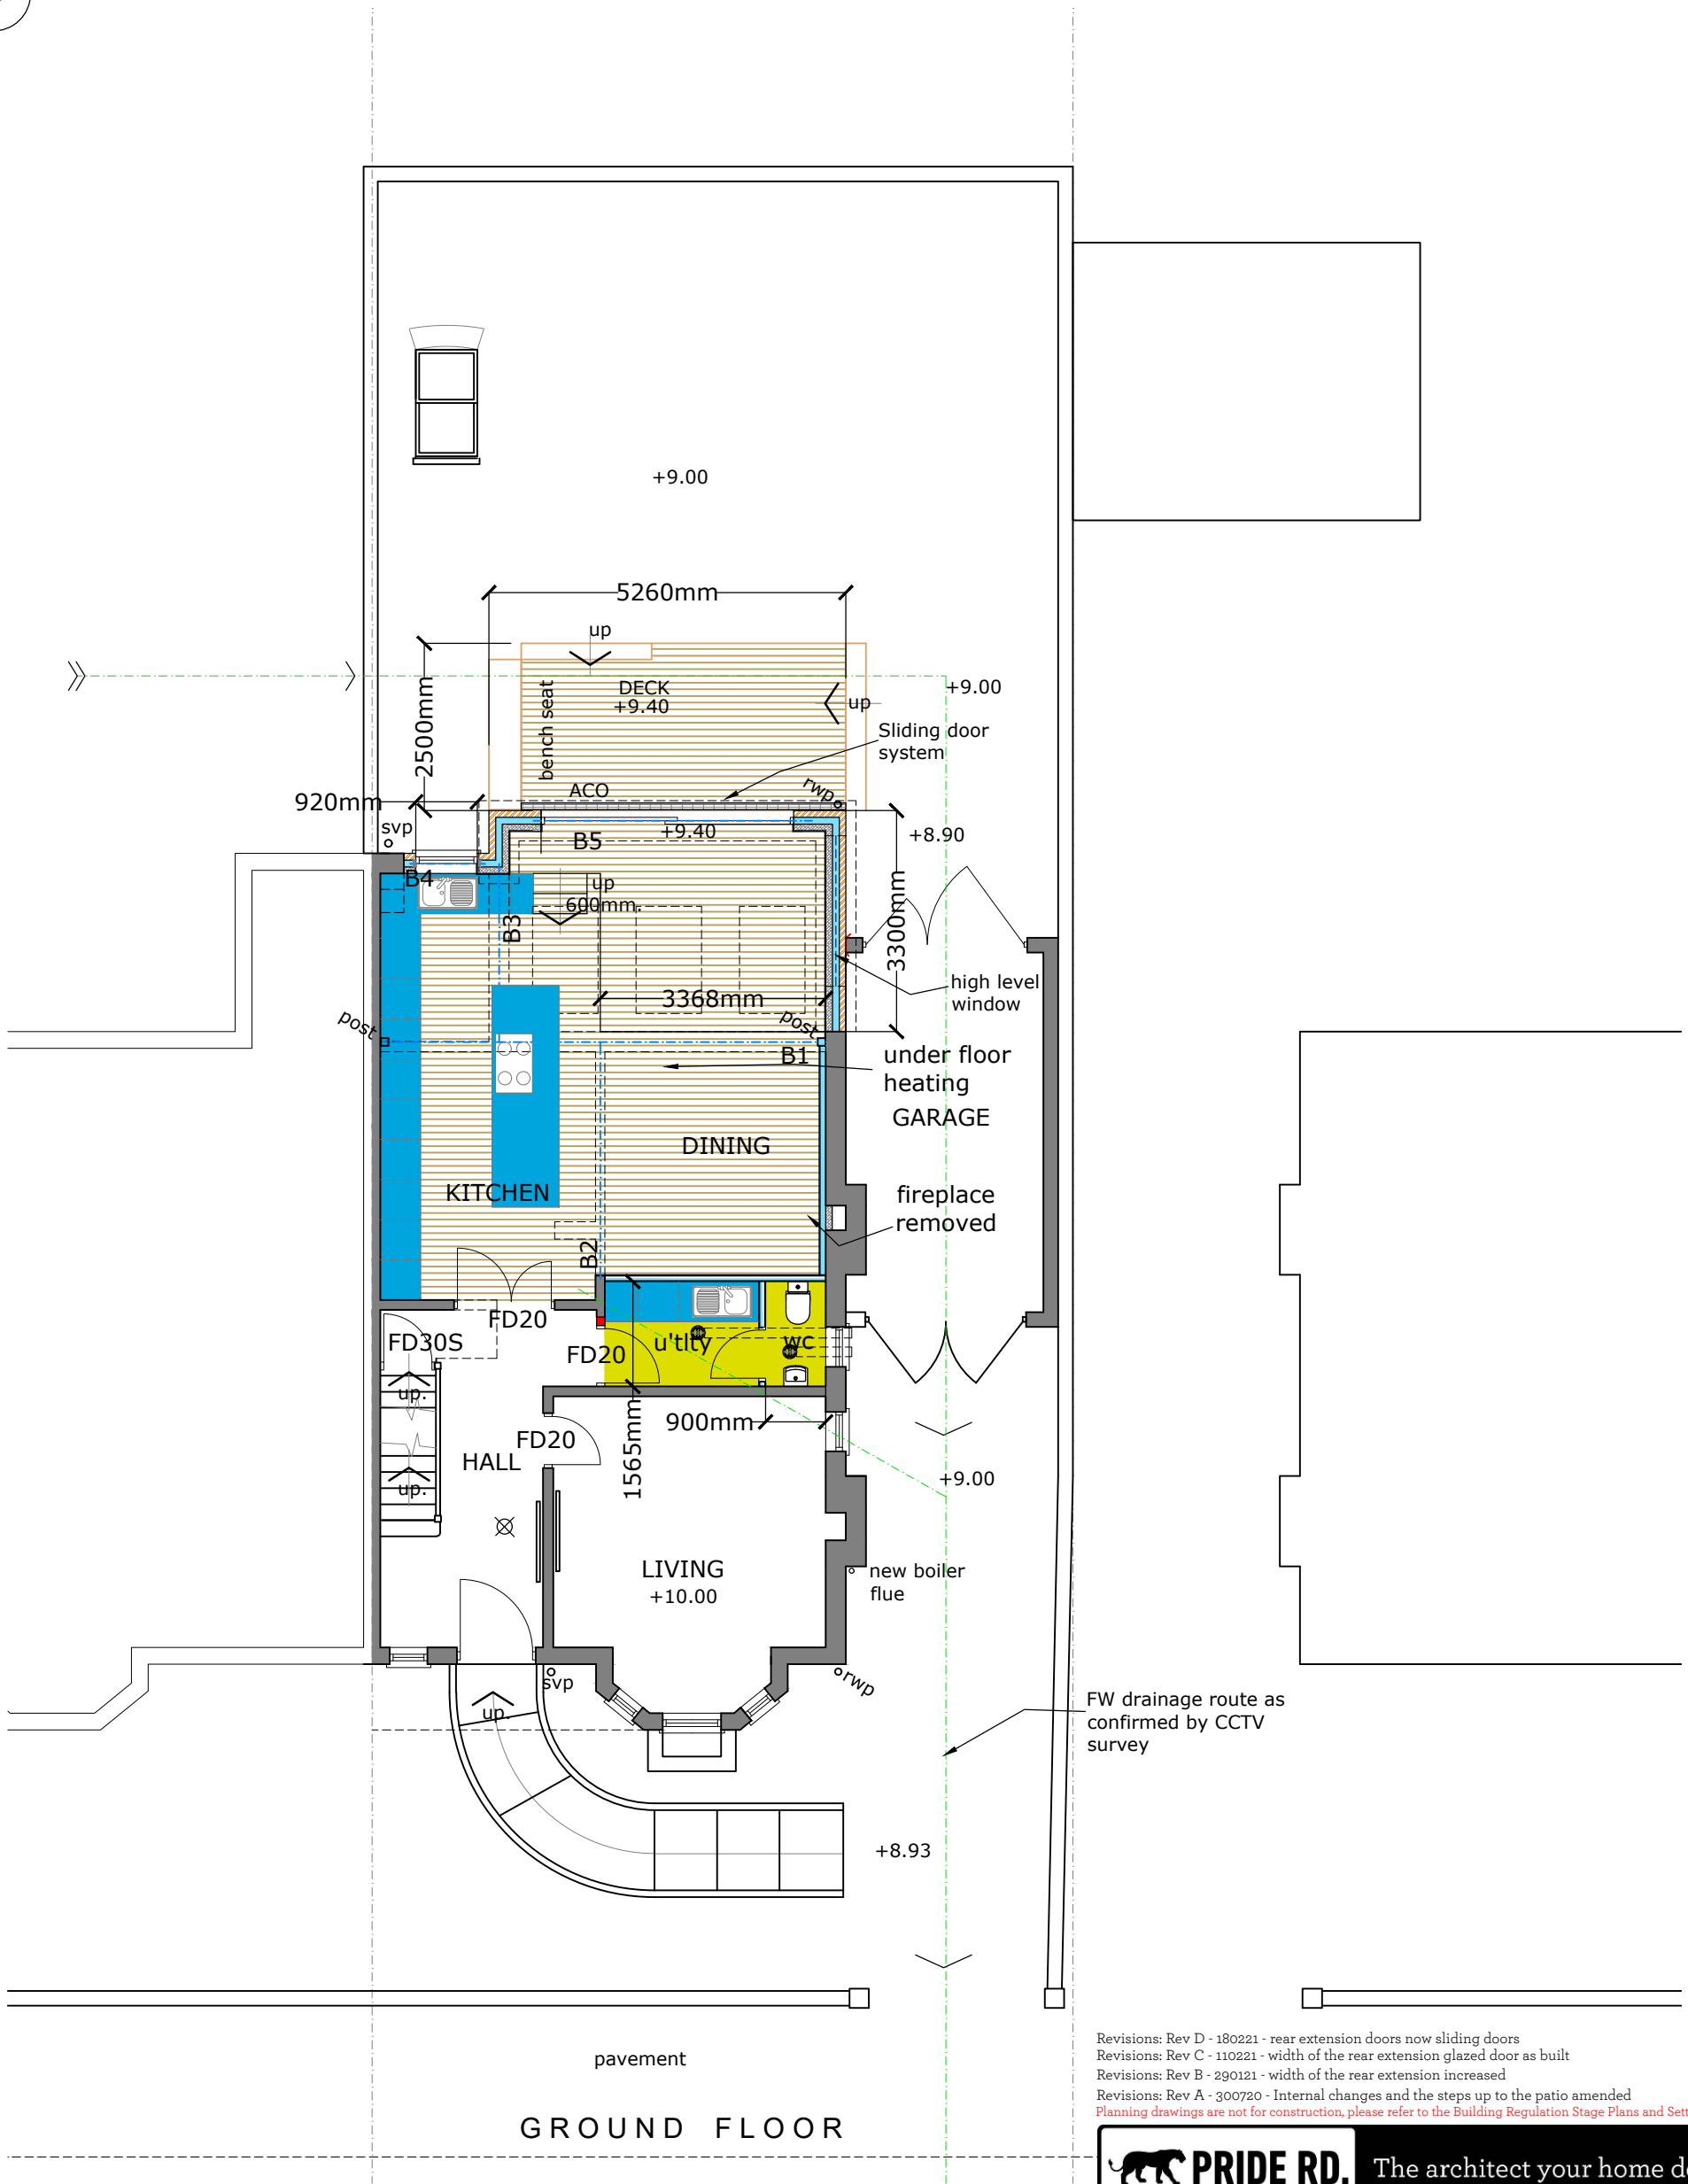


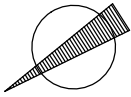

Revisions: Rev D - 180221 - rear extension doors now sliding doors
Revisions: Rev C - 110221 - width of the rear extension glazed door as built
Revisions: Rev B - 290121 - width of the rear extension increased
Revisions: Rev A - 300720 - Internal changes and the steps up to the patio amended
Planning drawings are not for construction, please refer to the Building Regulation Stage Plans and Setting out drawings.

PRIDE RD. The architect your home deserves

www.prideroad.co.uk Tel: 0151 665 0103 Email: magda@prideroad.co.uk @architectMagda |Manchester
©Pride Rd. Ltd. 2020. All rights reserved. This drawing must not be reproduced without permission. Do not scale from this drawing. All dimension are in millimeters unless otherwise stated. Any discrepancies should be reported to the Architect. NB.
Contractor must check and confirm all dimensions on site prior to manufacture. Concept design drawings are not suitable for planning applications or Building Regulations applications. Client and Contractor to ensure that structural design has been approved by a Building inspector and works in general to be approved by a Building Inspector.

Stage: Planning		Client: L.Marsh and F.Markus				
Title: Proposed Ground Floor Plan		Project: 6 Burton Ave Withington Manchester M20 3EL				
0	1	2	3	Scale@A3 1:100	Date: 25/07/20	Drawn: BR
		Job no: M241	No. 10	Rev: D		