
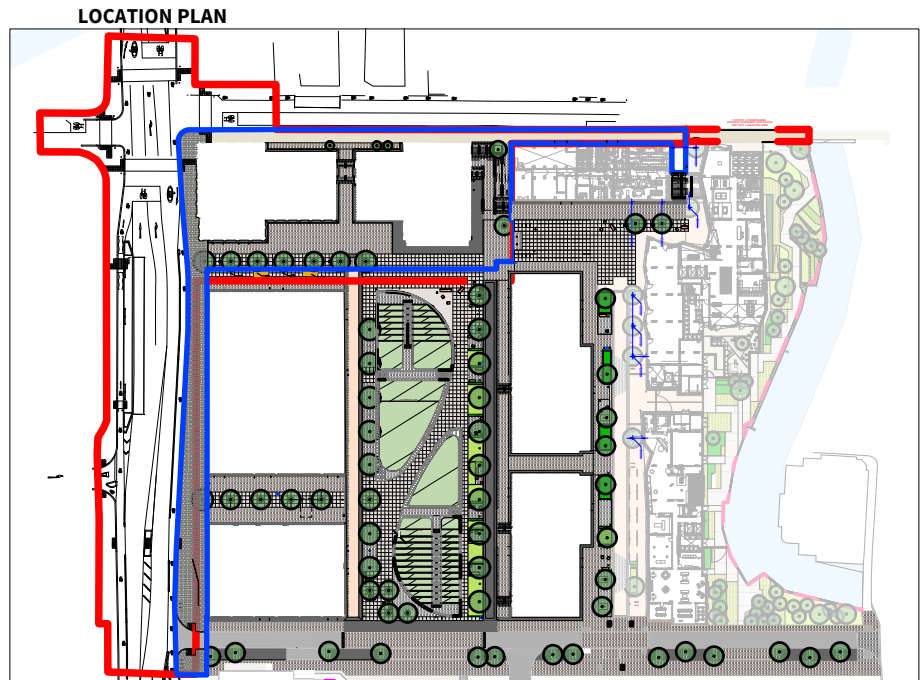


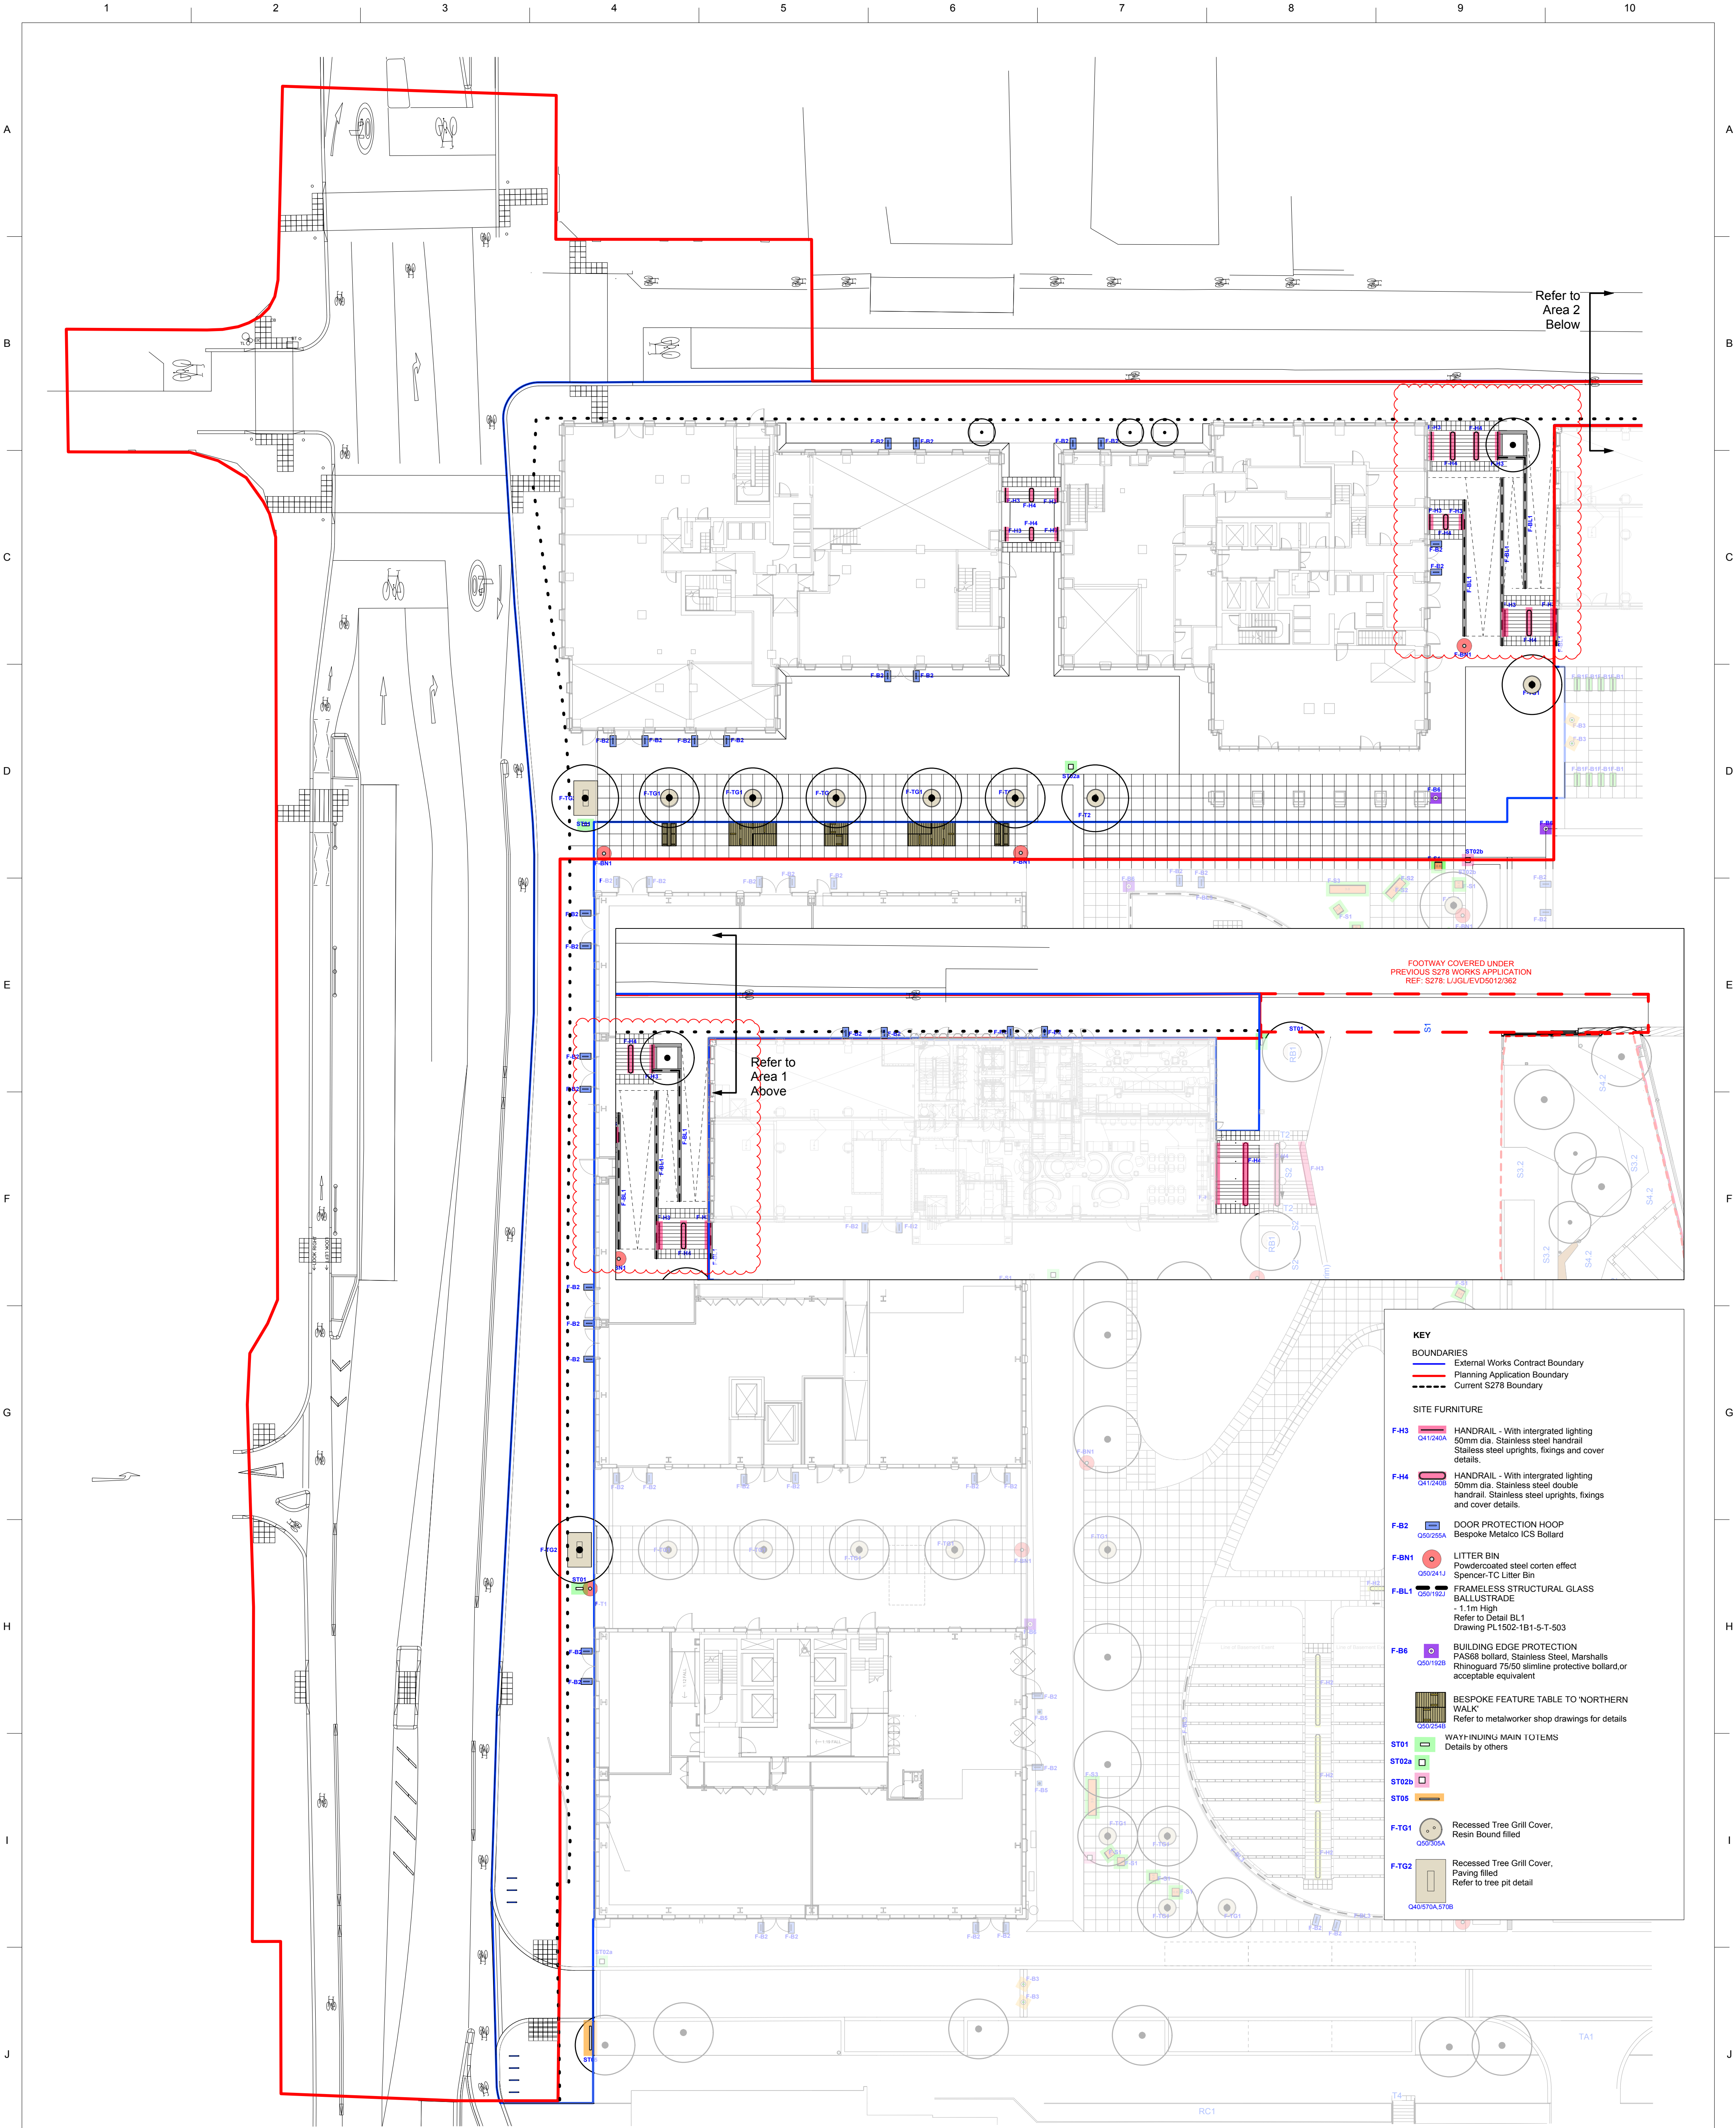

CR-C09	05-07-21	Updated step & ramp arrangement to north.	FF	FF
CR-C08	22-06-21	Updated architects layout with additional door protection hoops.	CB	FF
CR-C07	04-05-21	Final Construction	FF	RM
S3-C06	01-12-20	Seating design updated in line with access officer comments.	FF	RM
S3-C05	11-11-20	Line tree repositioned on Charles Street to avoid service cash.	FF	RM
S3-C04	12-08-20	Feature seat layout updated to reflect latest design & shop drawings.	FF	RM
S3-C03	16-07-20	Signage and wayfinding co-ordinated.	FF	RM
S3-C02	15-01-20	Drawing updated to show both contract boundary and red line planning application boundary. Drawing scale revised.	FF	RM
S3-C01	02-08-19	Building Footprint Updated and Door Protection Hoop location amended.	EG	FF
S3-P03	09-04-19	Amendments to key.	FF	RM
S3-P02	26-02-19	STAGE 05 UPDATE 1. Building Footprint updated and Door Protection Hoops amended. 2. Power Supply added to key, spec clauses added.	EG	RM
S3-P01	09-10-18	STAGE 05	EG	RM

Issue	Date	Status	Drawn	Apprvd.
S3-P01	09-10-18	STAGE 05	EG	RM

Client	John Sisk & Son Ltd		
Project	Circle Square Plots 5 & 6		
Drg Title	Furniture General Arrangement		
Created on	21-08-18	Created by	VE
Approved by	RM	Workstage	Final Construction
Scale	1:250	Size	A1
Prev Drg No.	PL1502-56-T-401		
Drg No.	CSAL-PLA-ZT-XX-DR-L-0401		
Suitability	CR	Revision	C09

Planit I.E. Limited
E: info@planit-ie.com W: planit-ie.com

MANCHESTER
2 Back Grafton St
W14 1DY
T: 0161 928 9281

LONDON
Unit 6 Waterside
44-48 Wharf Road
N13 7UX
T: 0207 253 5678

THIS DRAWING IS COPYRIGHT PROTECTED AND MAY NOT BE REPRODUCED IN WHOLE OR PART WITHOUT WRITTEN AUTHORITY FROM THE OWNER.

NOTE:

- Do not scale from this drawing. Always work to noted dimensions.
- All dimensions are in millimetres unless otherwise stated.
- All setting out, levels and dimensions to be agreed on site.
- The dimensions of all materials must be checked on site before being laid out.
- This drawing must be read with the relevant specification clauses and detail drawings.
- Order of construction and setting out to be agreed on site.