


General Notes
The Architect shall have no responsibility for any use made of this document other than for that which it was prepared and issued.
All dimensions should be checked on site. Do not scale from this drawing. To be read in conjunction with all other Consultant's drawings. The Architect to be immediately notified of any discrepancies.
Copyright on this drawing retained by the Architect.

LEGEND
 Site Boundary

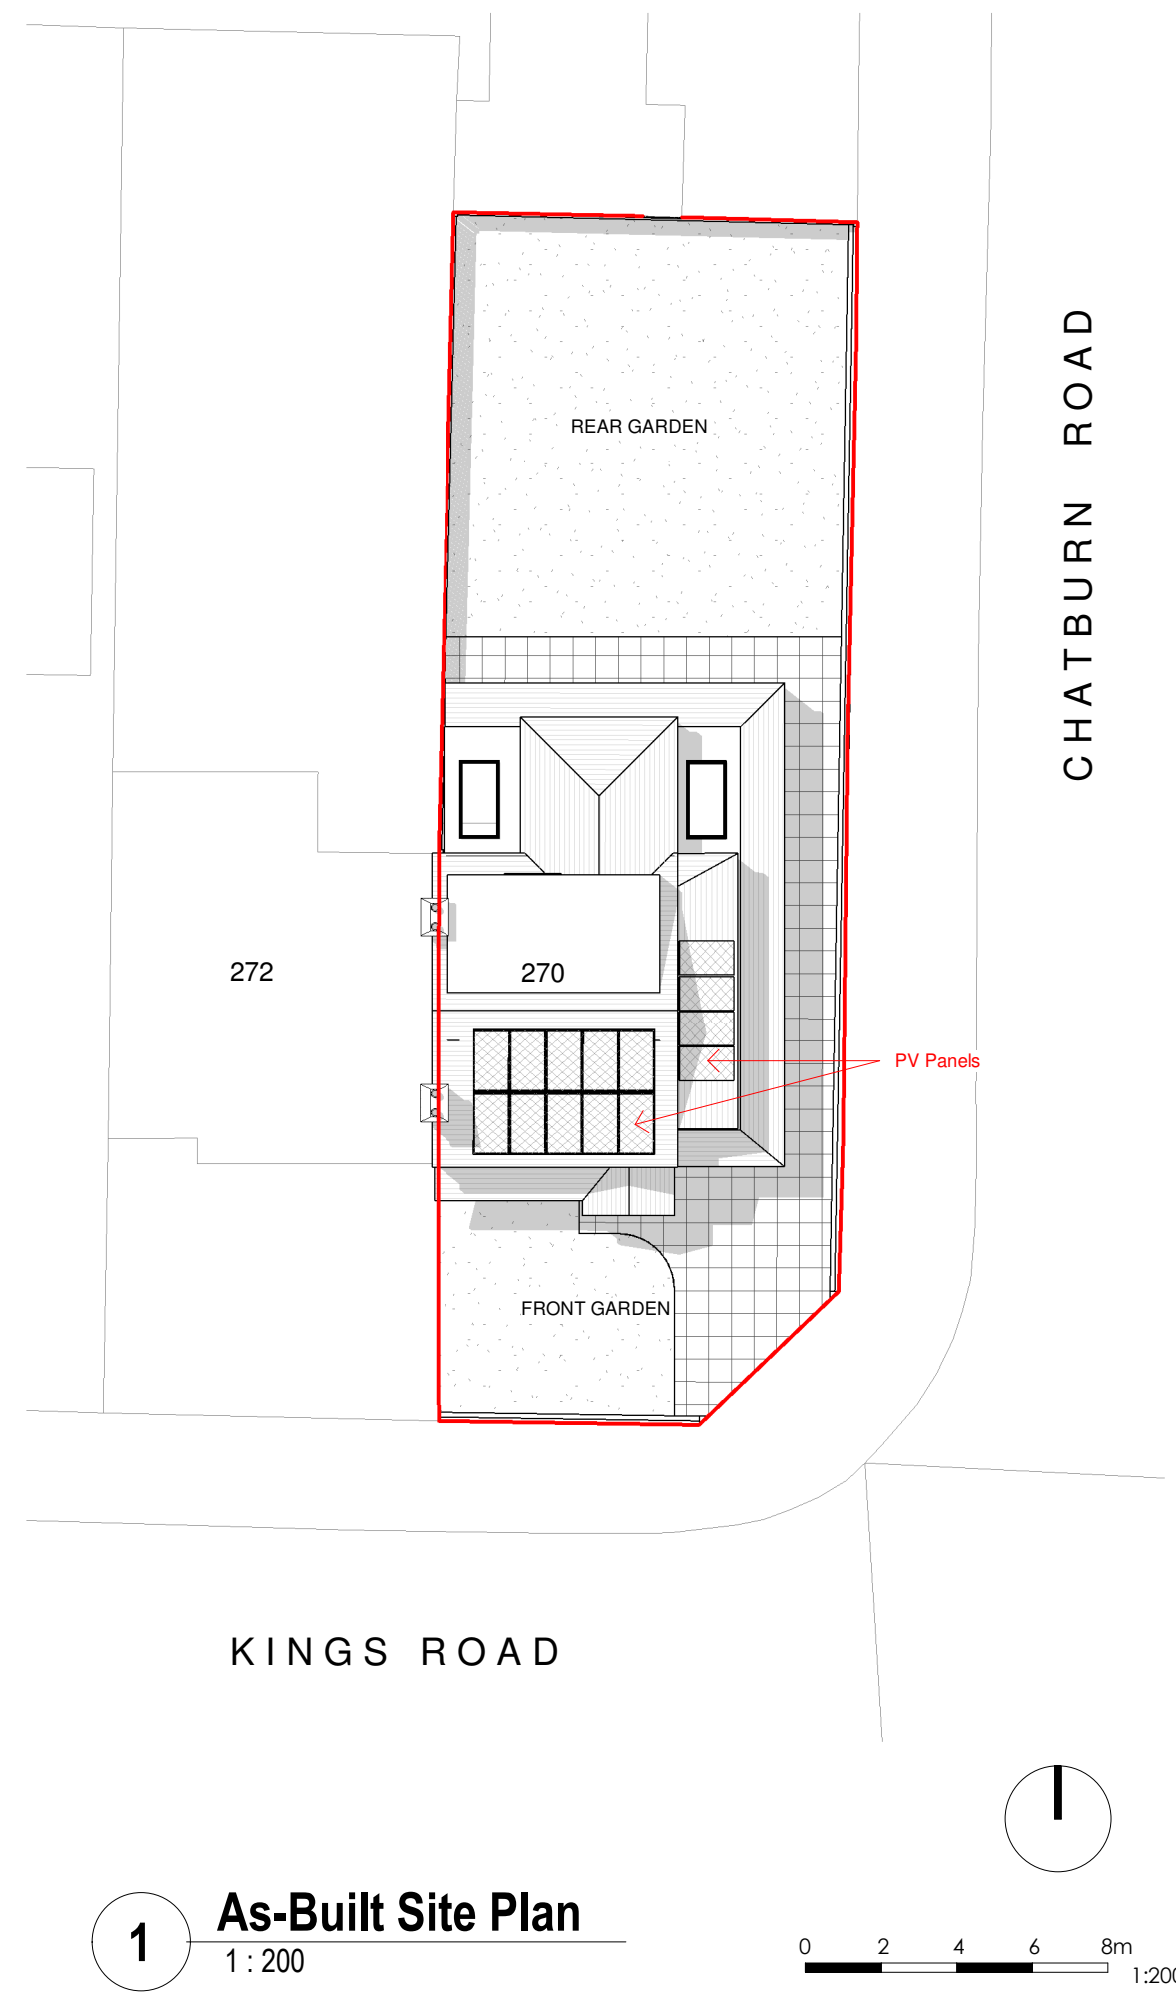

1 As-Built Site Plan
1 : 200



2 As-Built Front View



3 As-Built Rear View

A	12/08/21	SA	SH	Amended plans
-	27/07/21	SA	SH	Initial Issue
No.	Date	Dwn	Chk	App
				Revision or reason for issue

Client
Qais Ahmed

create it studios
Architects & Designers

Create It Studios (NW) Ltd
Universal Square
Devonshire Street North
Manchester M12 6JH
0161 974 6165
www.createitstudios.co.uk
info@createitstudios.co.uk

Project Title
270 Kings Rd, Manchester M21 0XQ

Scale / North Point
1 : 200

Drawing Title
As-Built Site Plan & 3D View

Drawing Number	Revision
A1311(03)001	A
Drawing Status	
Preliminary	