


General Notes
The Architect shall have no responsibility for any use made of this document other than for that which it was prepared and issued.
All dimensions should be checked on site. Do not scale from this drawing. To be read in conjunction with all other Consultant's drawings. The Architect to be immediately notified of any discrepancies.
Copyright on this drawing retained by the Architect.

LEGEND
 Site Boundary

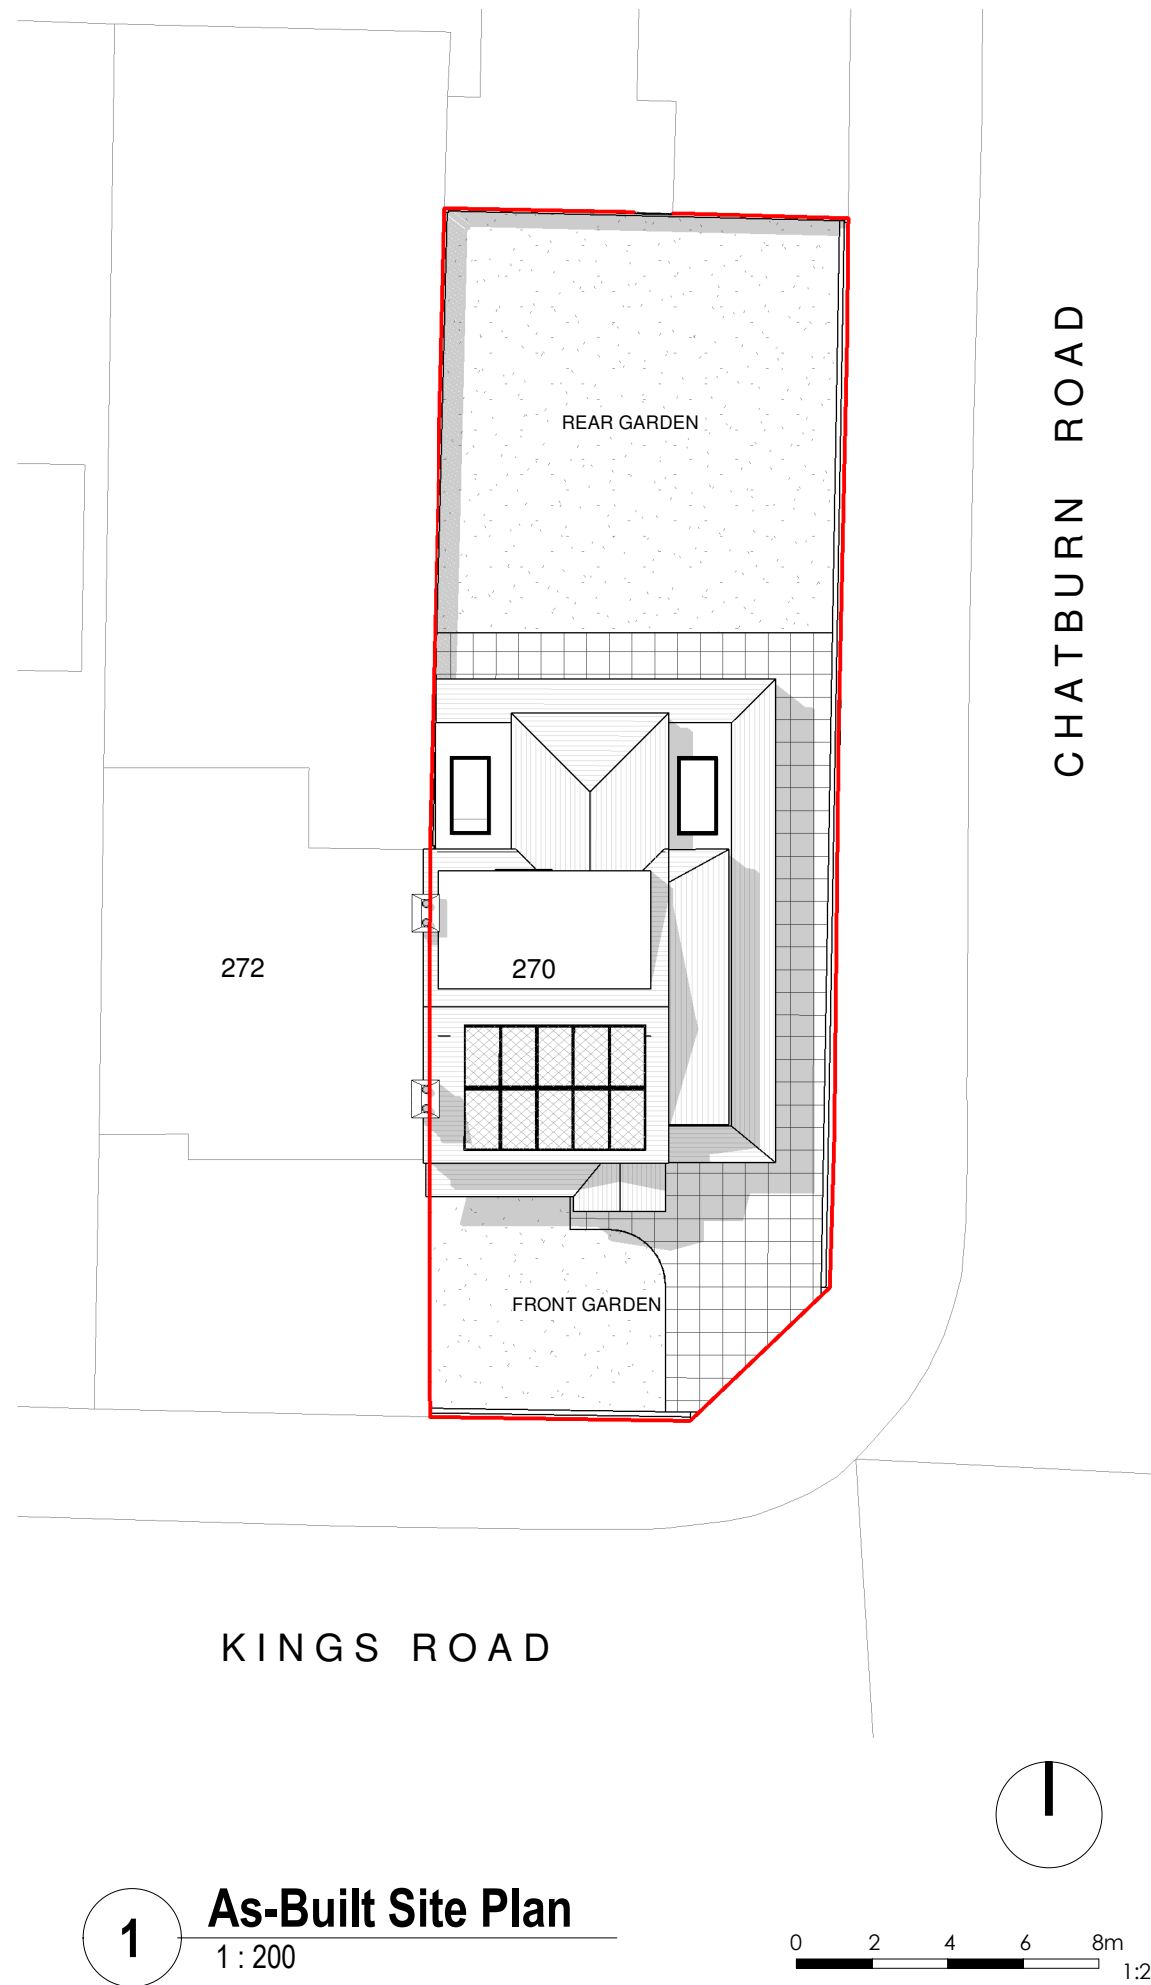

1 As-Built Site Plan
1 : 200



2 As-Built Front View



3 As-Built Rear View

No.	Date	Dwn	Chk	App	Revision or reason for issue
1	27/07/21	SA	SH		Initial Issue

Client
Qais Ahmed

create it studios
Architects & Designers

Create It Studios (NW) Ltd
Universal Square
Devonshire Street North
Manchester M12 6JH
0161 974 6165
www.createitstudios.co.uk
info@createitstudios.co.uk

Project Title
270 Kings Rd, Manchester M21 0XQ

Scale / North Point
1 : 200

Drawing Title
As-Built Site Plan & 3D View

Drawing Number	Revision
A1311(03)001	-
Drawing Status Preliminary	

LEGEND

Site Boundary

27/07/21 SA SH Initial Issue
No. Date Dwn Chk App Revision or reason for issue

Client
Qais Ahmed

createit studios
Architects & Designers




Create It Studios (NW) Ltd
Universal Square
Devonshire Street North
Manchester M12 6JH
0161 974 6165
www.createitstudios.co.uk
info@createitstudios.co.uk

Project Title
270 Kings Rd, Manchester M21 0XQ

Scale / North Point
1 : 100

Drawing Title
As-Built Floor Plans

Drawing Number
A1311(03)002
Drawing Status
Preliminary

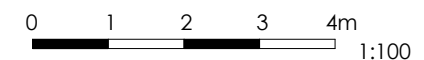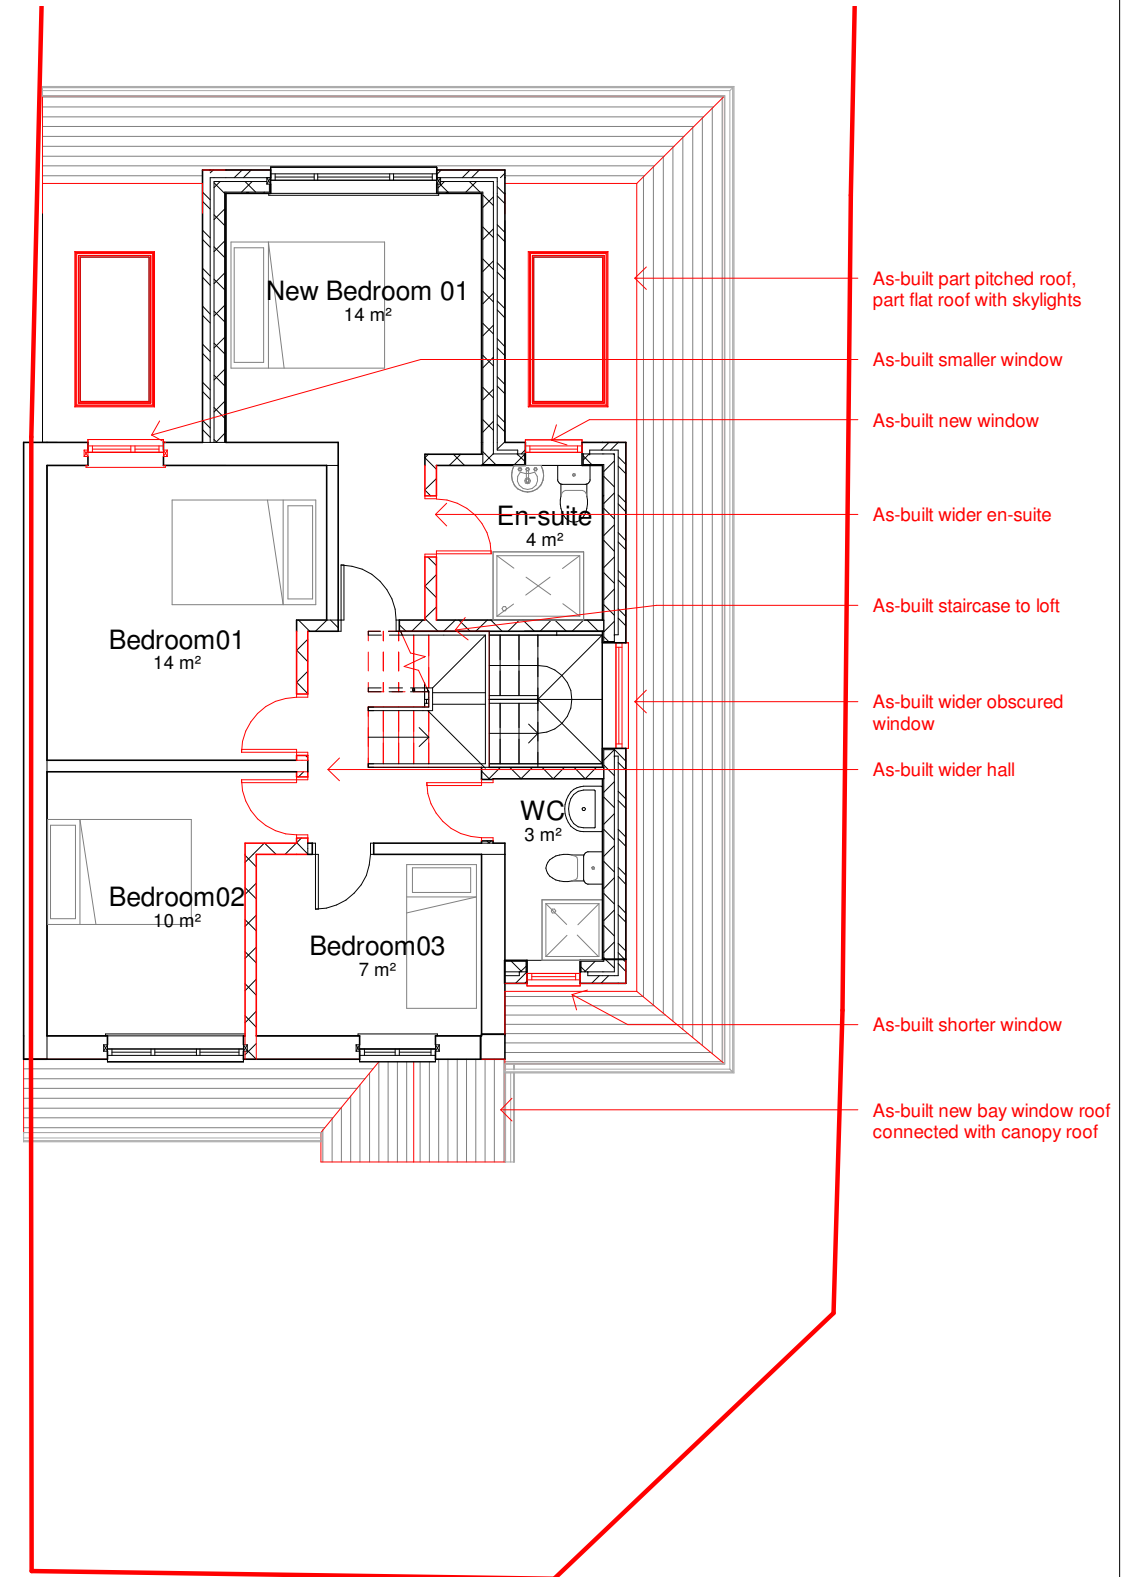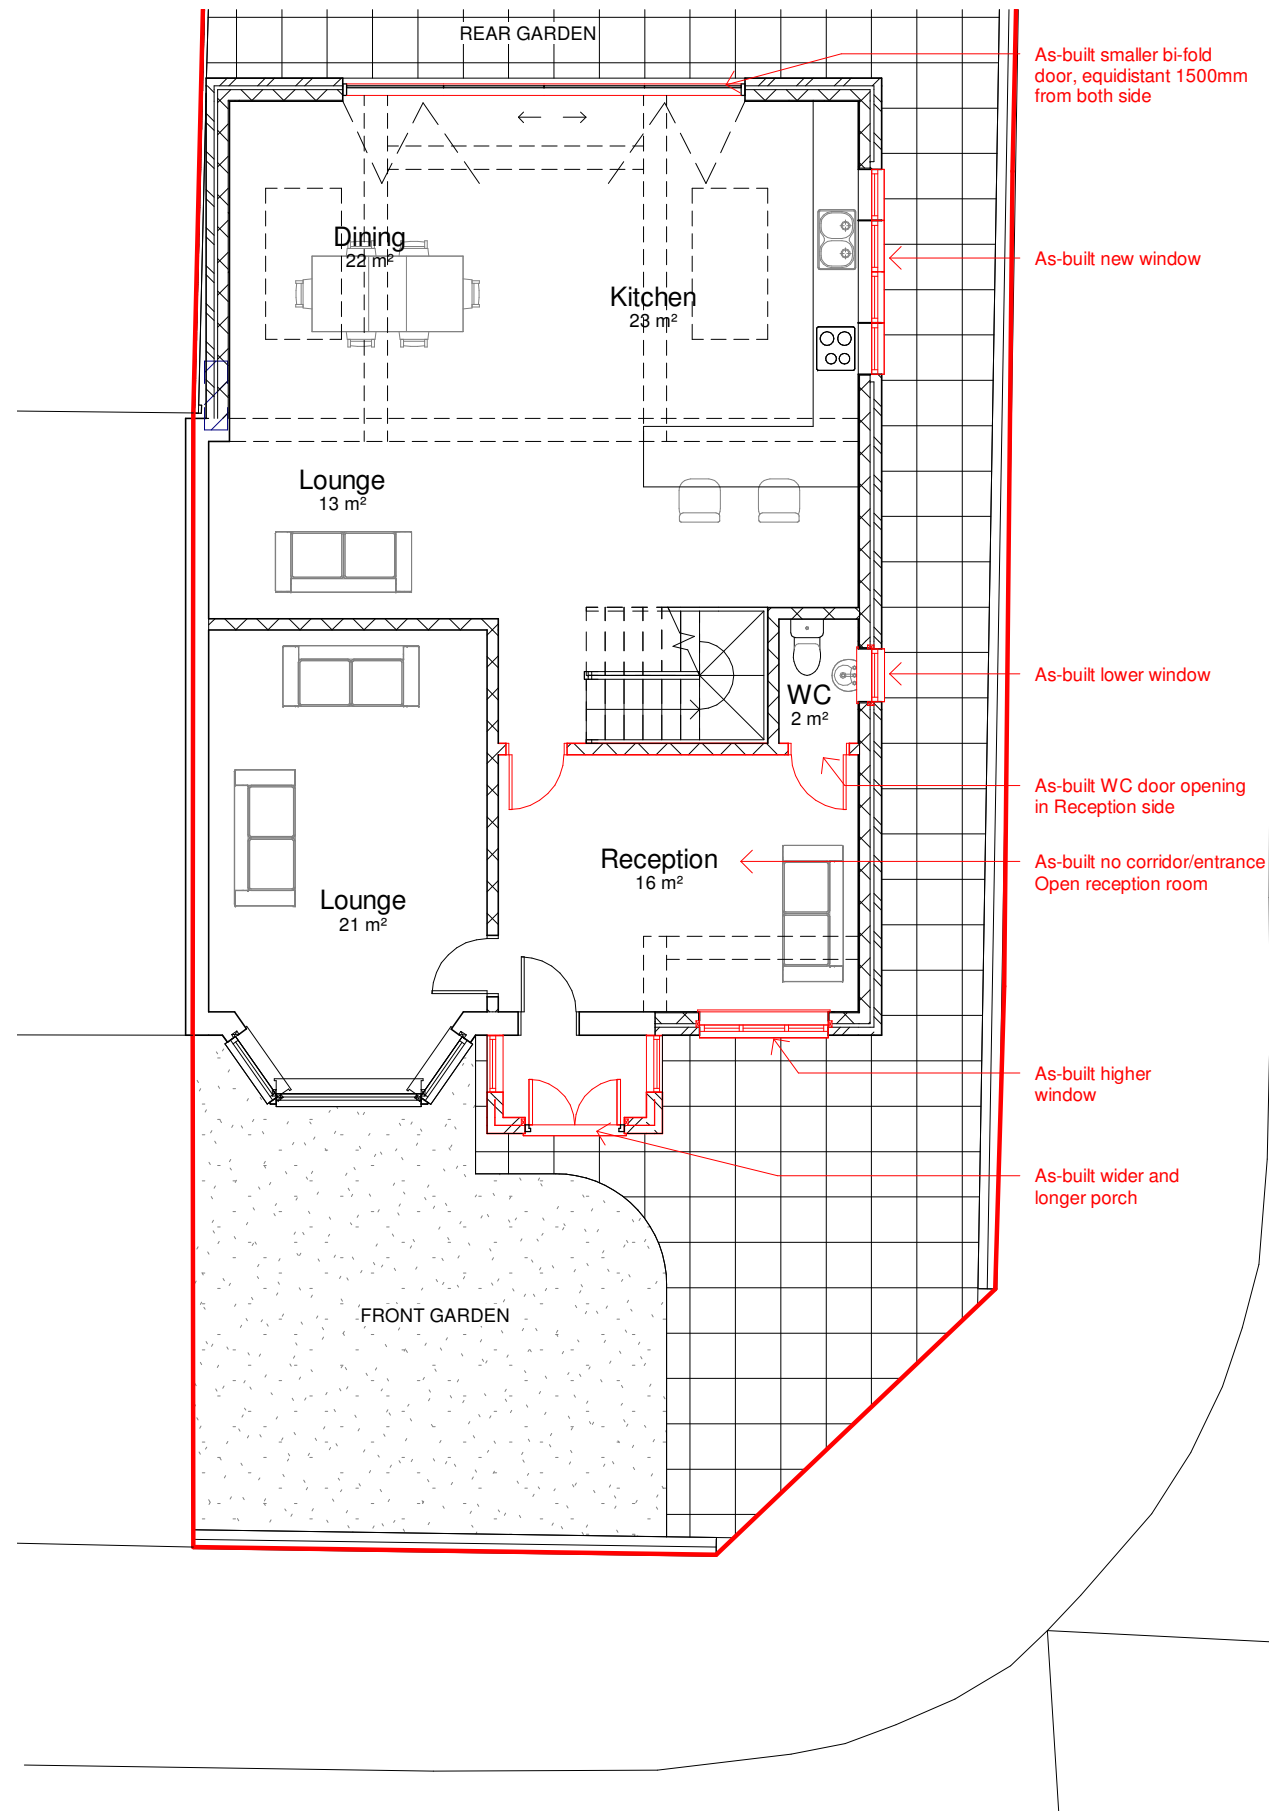


General Notes

The Architect shall have no responsibility for any use made of this document other than for that which it was prepared and issued.
All dimensions should be checked on site. Do not scale from this drawing. To be read in conjunction with all other Consultant's drawings. The Architect to be immediately notified of any discrepancies.

Copyright on this drawing retained by the Architect.


LEGEND

Site Boundary

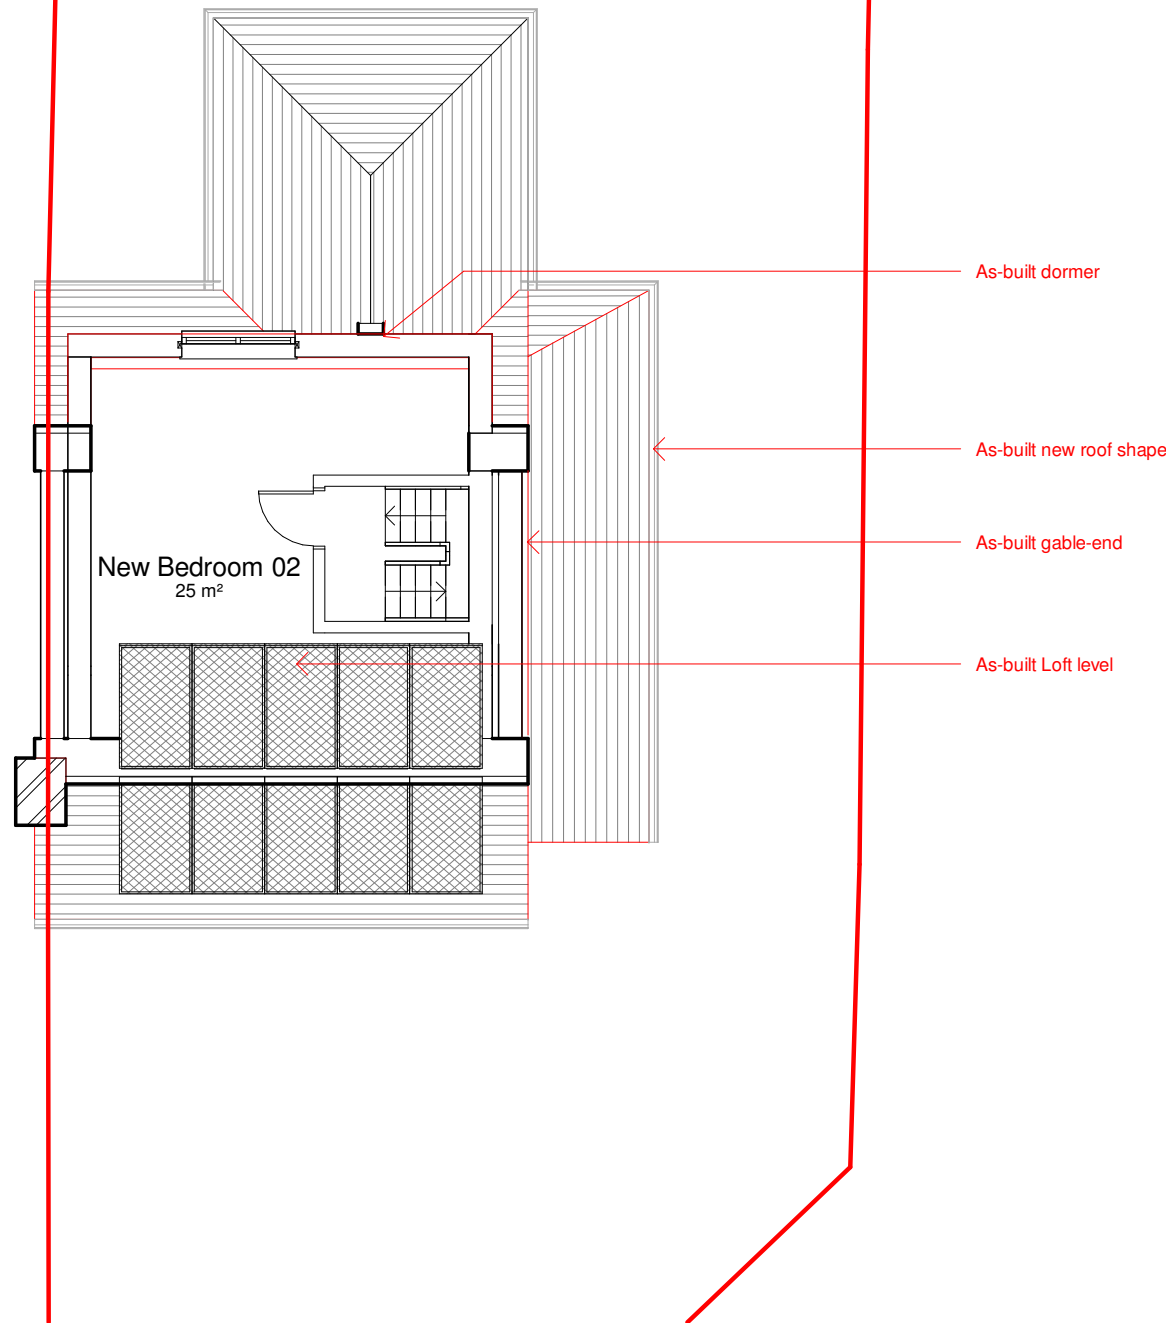

1 As-Built Loft Plan
1 : 100

0 1 2 3 4m
1:100

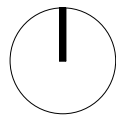

27/07/21 SA SH Initial Issue
No. Date Dwn Chk App Revision or reason for issue

Client
Qais Ahmed

create **it** studios
Architects & Designers

Create It Studios (NW) Ltd
Universal Square
Devonshire Street North
Manchester M12 6JH
0161 974 6165
www.createitstudios.co.uk
info@createitstudios.co.uk

Project Title
270 Kings Rd, Manchester M21 0XQ

Scale / North Point
1 : 100

Drawing Title
As-Built Loft Plan

Drawing Number
A1311(03)003
Drawing Status
Preliminary
Revision
-

General Notes

The Architect shall have no responsibility for any use made of this document other than for that which it was prepared and issued.
All dimensions should be checked on site. Do not scale from this drawing. To be read in conjunction with all other Consultant's drawings. The Architect to be immediately notified of any discrepancies.


Copyright on this drawing retained by the Architect.



1

As-Built South Elevation


1 : 100

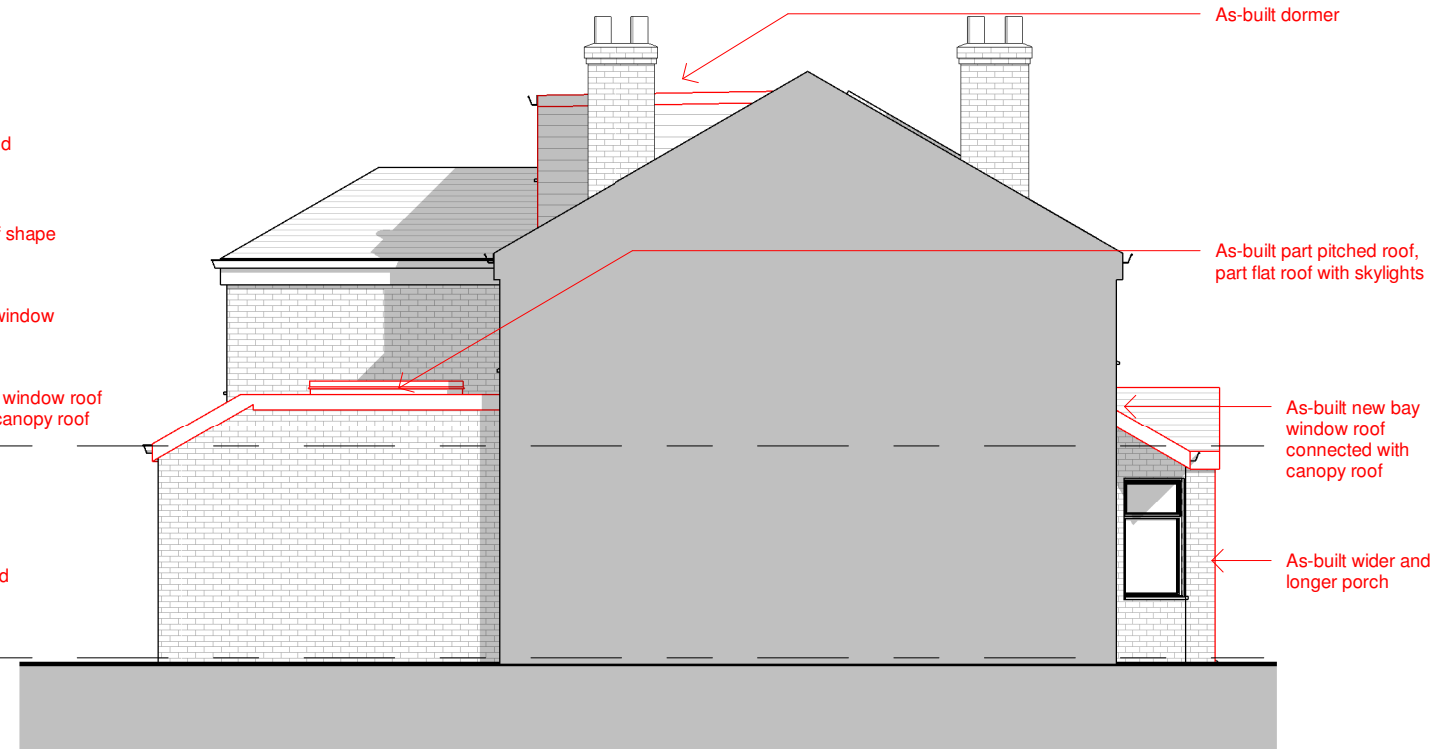

2

As-Built West Elevation


1 : 100

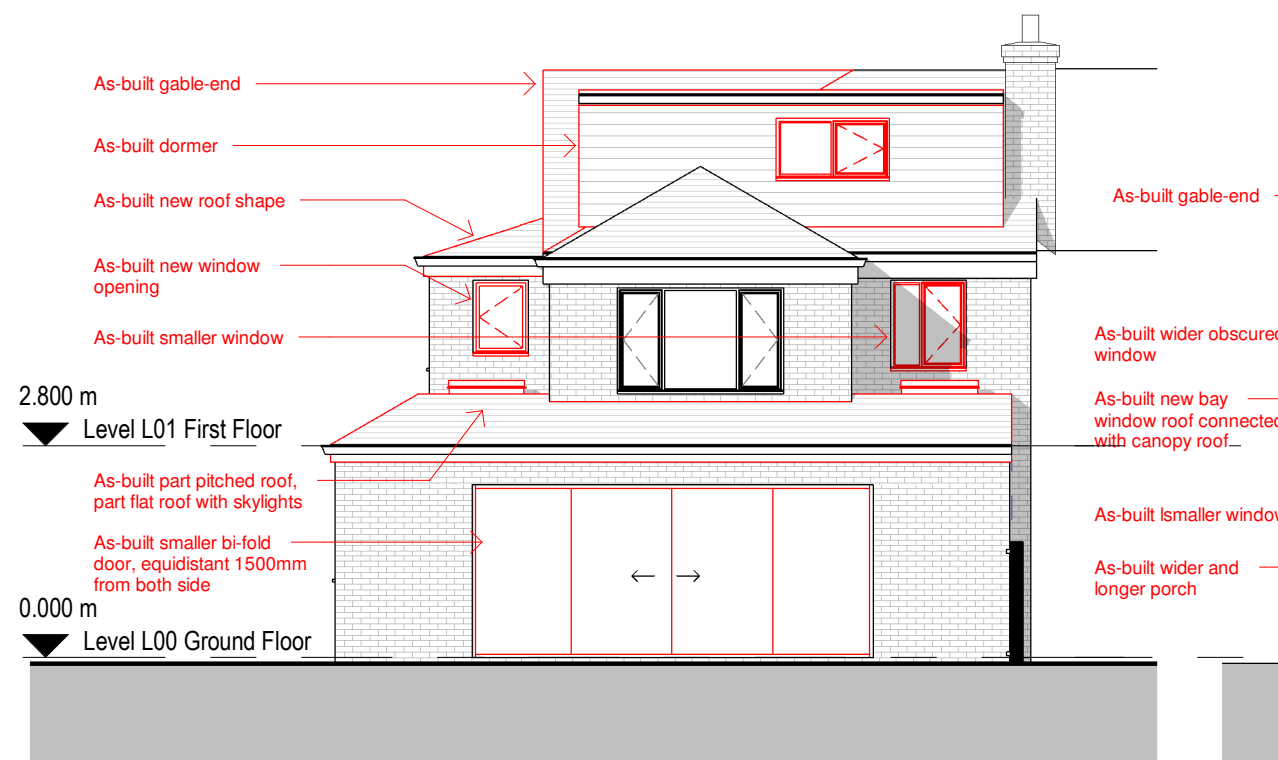

3

As-Built North Elevation


1 : 100

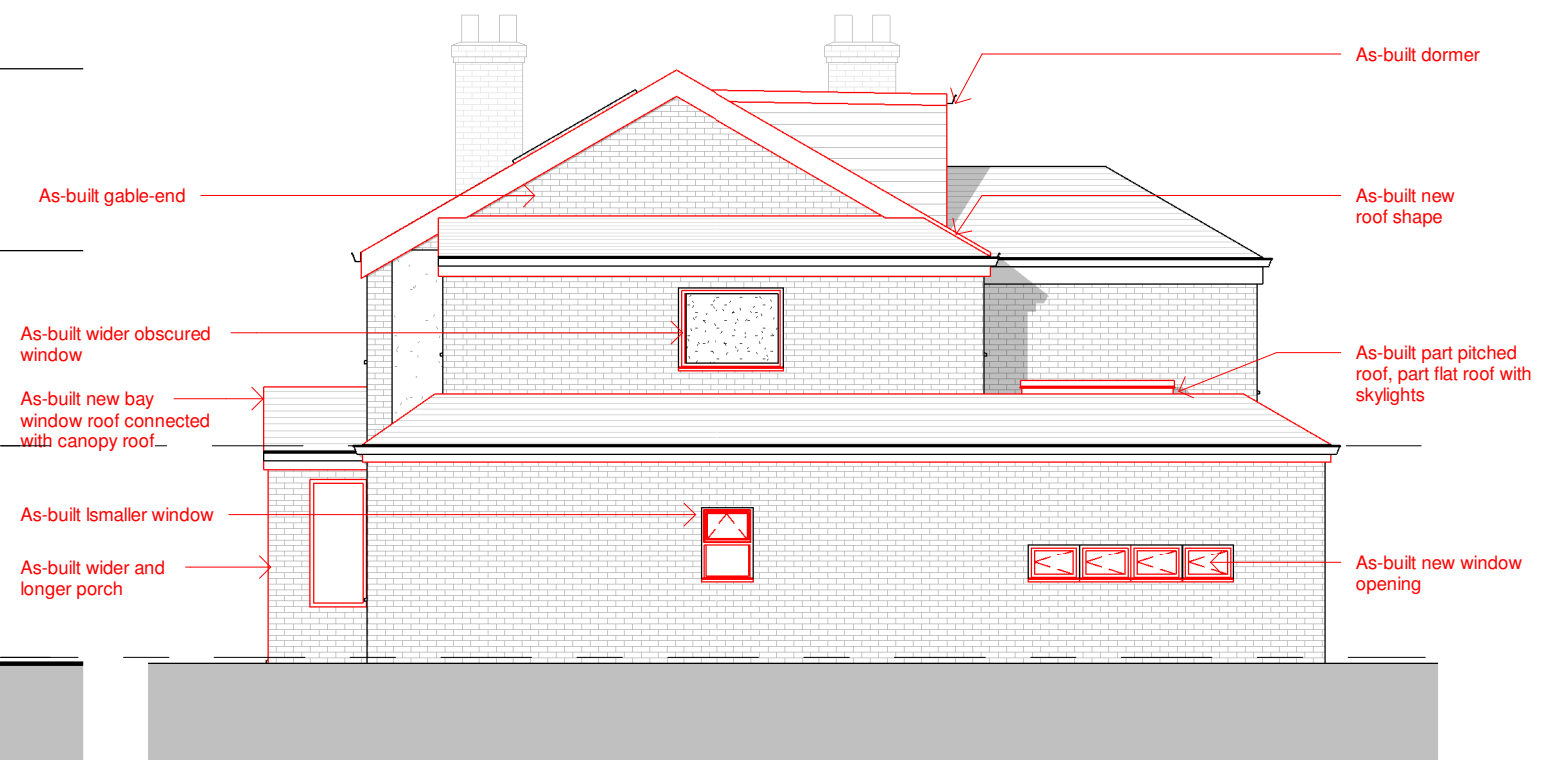

4

As-Built East Elevation

1 : 100

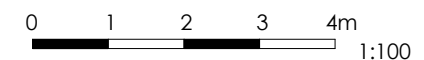

No. Date Dwn Chk App Revision or reason for issue

Client

Qais Ahmed

create **it** studios
Architects & Designers

Create It Studios (NW) Ltd
Universal Square
Devonshire Street North
Manchester M12 6JH
0161 974 6165
www.createitstudios.co.uk
info@createitstudios.co.uk

Project Title

270 Kings Rd, Manchester M21 0XQ

Scale / North Point

1 : 100

Drawing Title

As-Built Elevation

Drawing Number

A1311(03)004

Drawing Status

Preliminary

Revision

-