



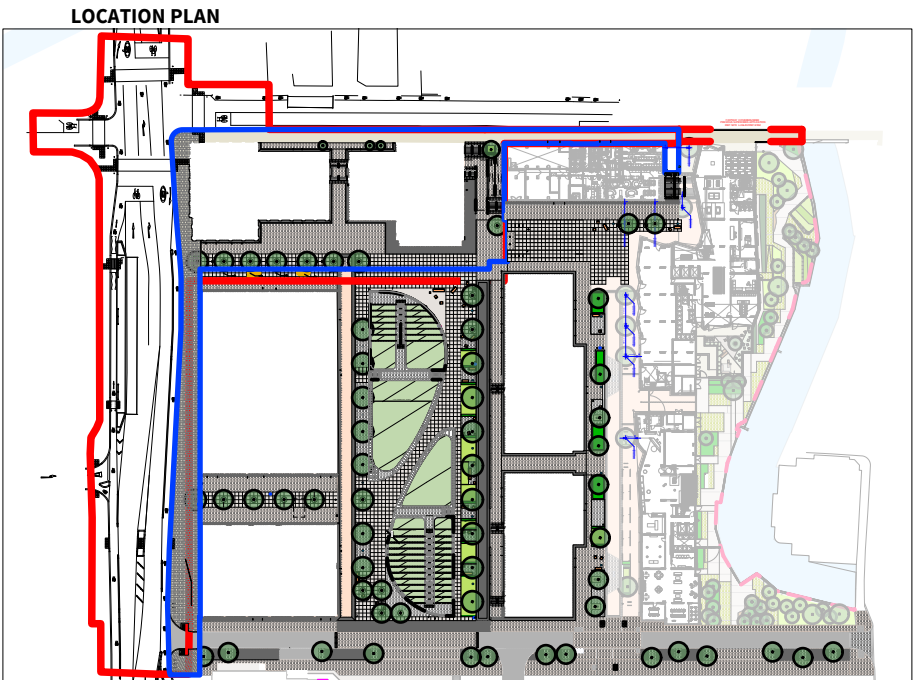


CR-C06	05-07-21	Updated step & ramp arrangement to north.	FF	FF
CR-C05	04-05-21	Final Construction	FF	RM
S3-C04	01-12-20	Seating design updated in line with access officer comments.	FF	RM
S3-C03	11-11-20	1 no tree repositioned on Charles Street to avoid service clash	FF	RM
S3-C02	12-08-20	Feature seat layout updated to reflect latest design & shop drawings.	FF	RM
S3-C01	15-01-20	Drawing updated to show both contract boundary and red line planning application boundary. Drawing scale revised.	FF	RM
S3-P02	26-02-19	STAGE 05 UPDATE 1. Building footprint updated and Door Protection Hoops amended	EG	RM
S3-P01	09-10-18	STAGE 05	EG	RM
S4-P02	26-09-18	Status Update	VE	RM
S4-P01	25-09-18	ISSUED FOR PLANNING UPDATE	FF	RM

Issue	Date	Status	Drawn	Apprvd.
-------	------	--------	-------	---------

Client	John Sisk & Son Ltd		
Project	Circle Square Plots 5 & 6		
Drg Title	Softworks - Trees		
Created on	20-08-18	Created by	VE
Approved by	RM		
Scale	1:250	Size	A1
Workstage	Final Construction		
Prev Drg No.	PL1502-56-T-201		
Drg No.	CSAL-PLA-ZT-XX-DR-L-0201	Suitability	CR
Revision	C06		

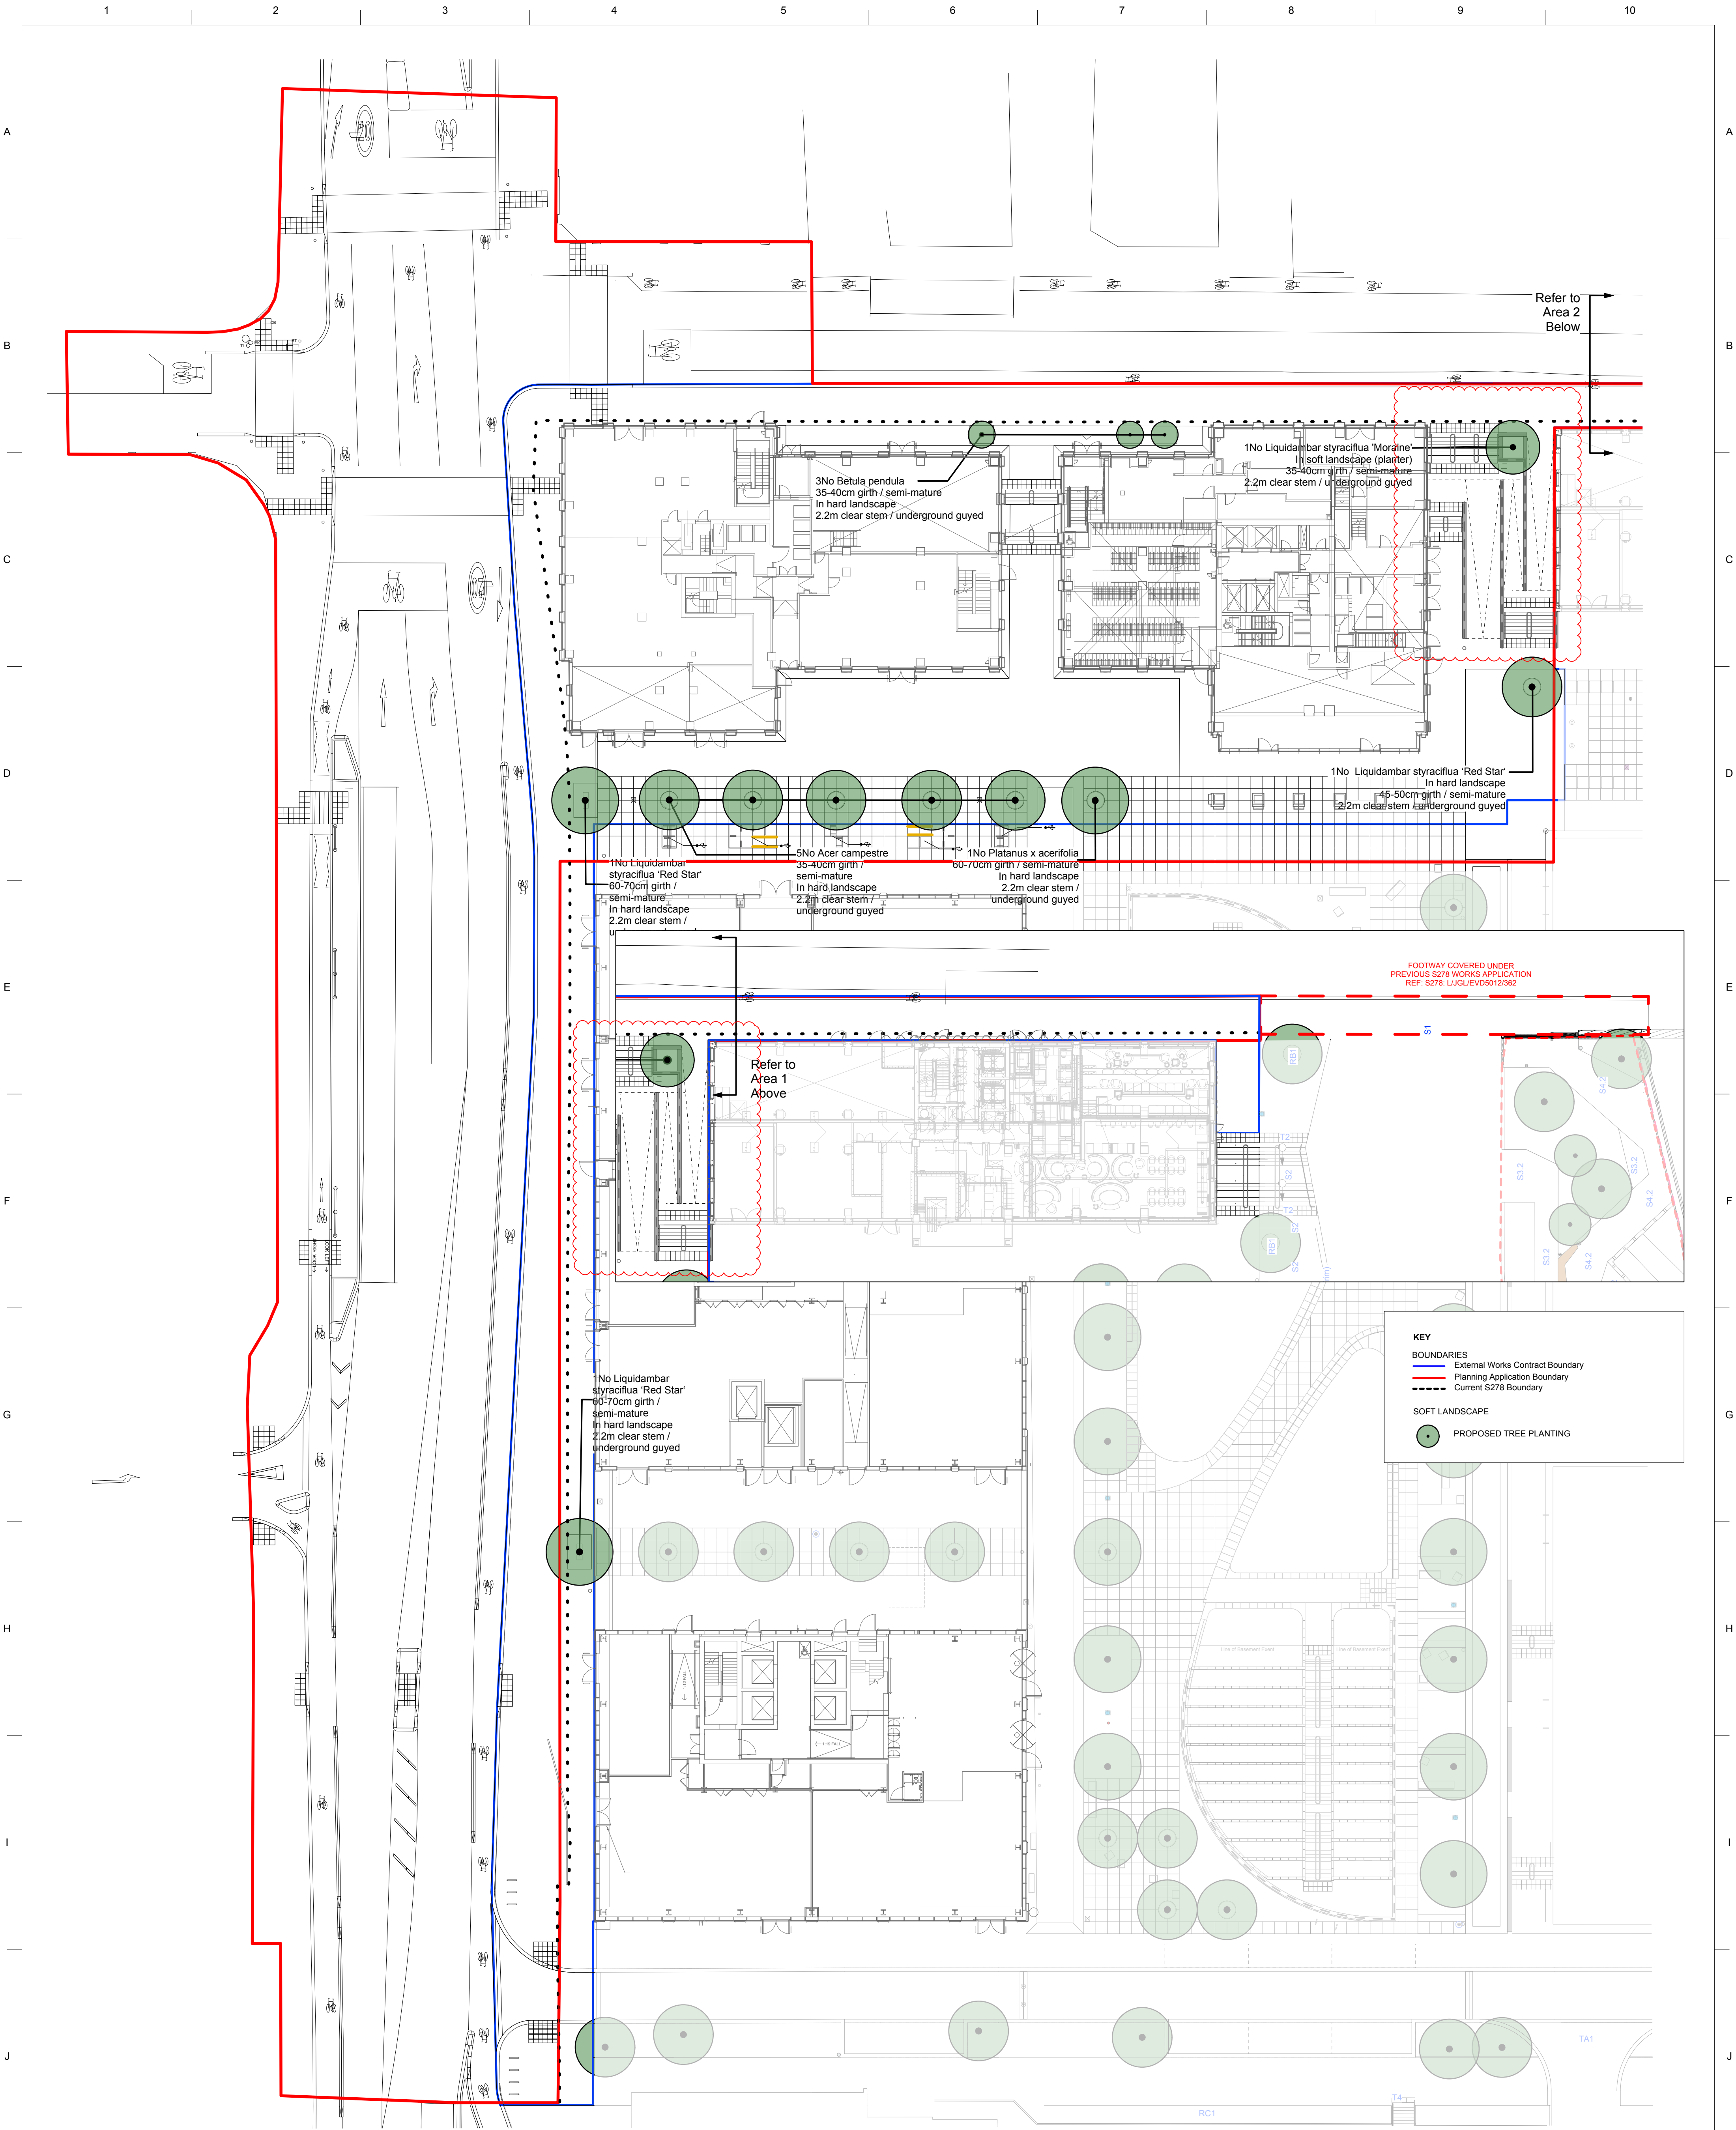

Planit I.E. Limited
E: info@planit-ie.com W: planit-ie.com
MANCHESTER
2 Back Grafton St
Altrincham
WA14 1DY
T: 0161 928 9281

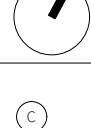

LONDON
Unit 6 Waterside
44-48 Wharf Road
London
N1 7UX
T: 0207 253 5678

THIS DRAWING IS COPYRIGHT PROTECTED AND MAY NOT BE REPRODUCED IN WHOLE OR PART WITHOUT WRITTEN AUTHORITY FROM THE OWNER.

NOTE:

- Do not scale from this drawing. Always work to noted dimensions.
- All dimensions are in millimetres unless otherwise stated.
- All setting out, levels and dimensions must be agreed on site before being laid out.
- The dimensions of all materials must be checked on site before being laid out.
- This drawing must be read with the relevant specification clauses and detail drawings.
- Order of construction and setting out to be agreed on site.