


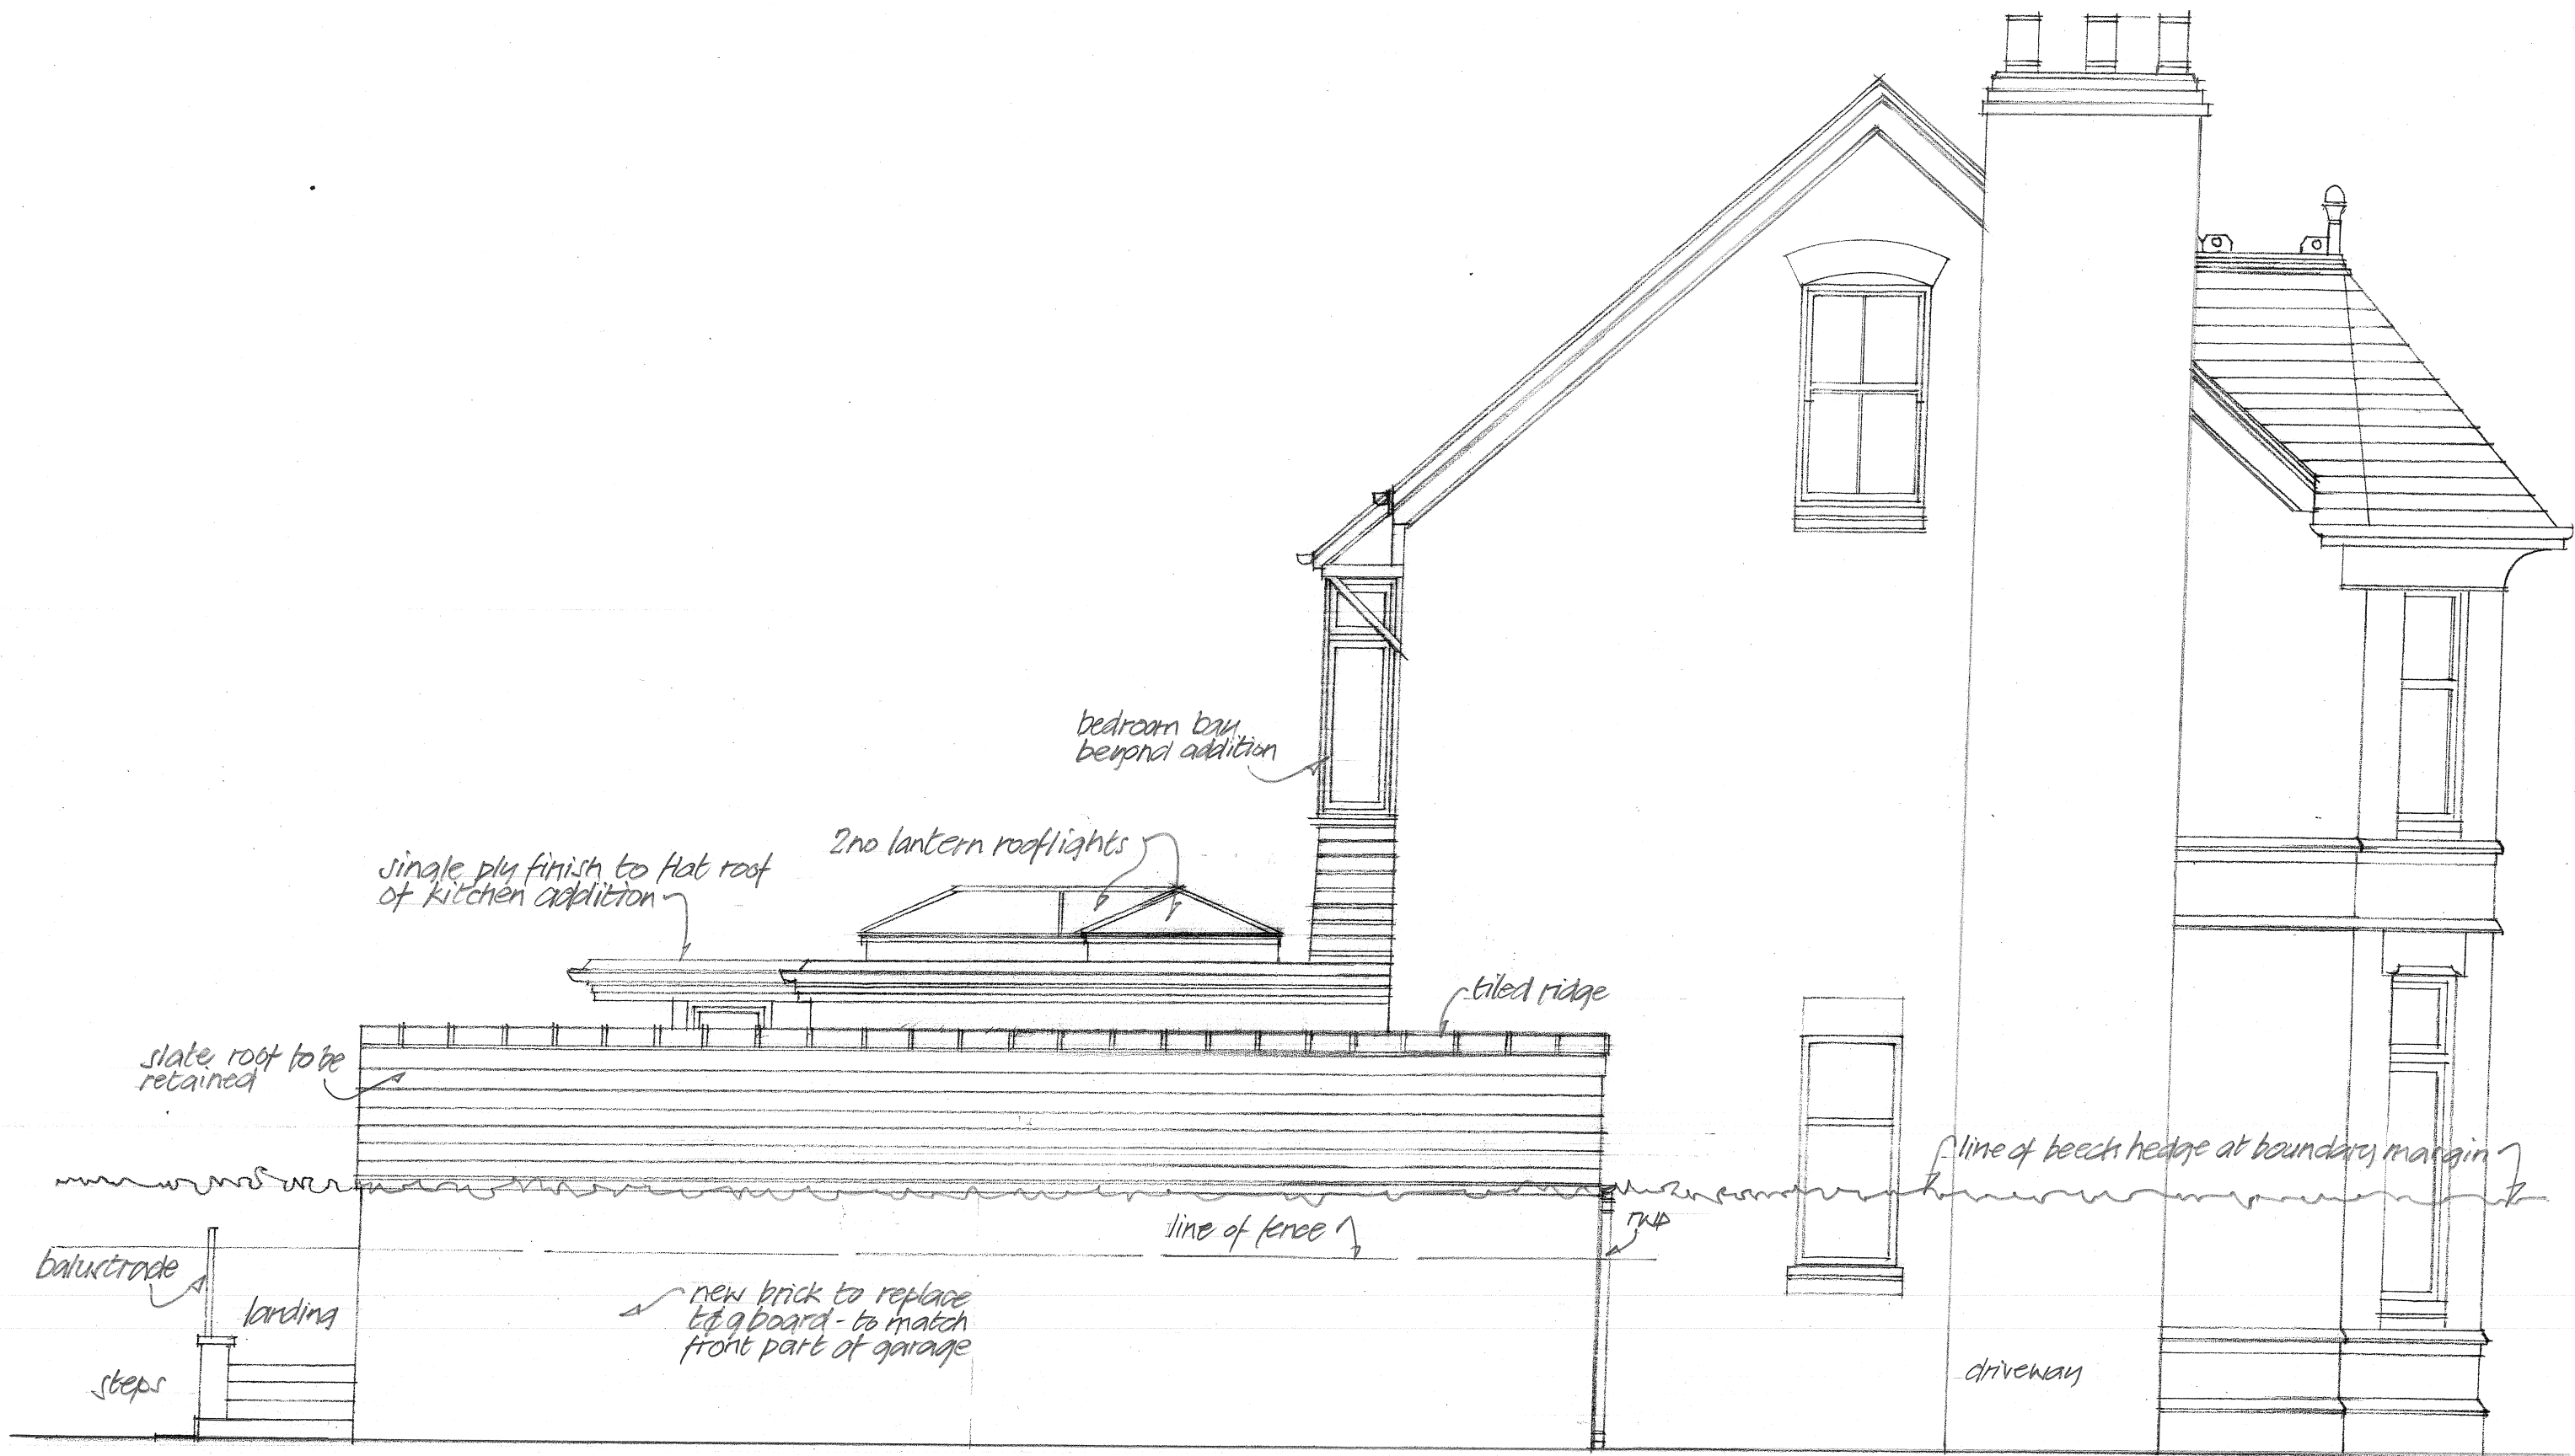

6 Caker Avenue, West Didsbury : for Drs Jean and Stephen Wells
 side elevation (south) to N°8 : as built

scale 1:50 @ A3

April 2022

JTHART ARB

metres 1:50

0 1 2 3 4 5 6 7 8 9 10