




Amendments bubbled

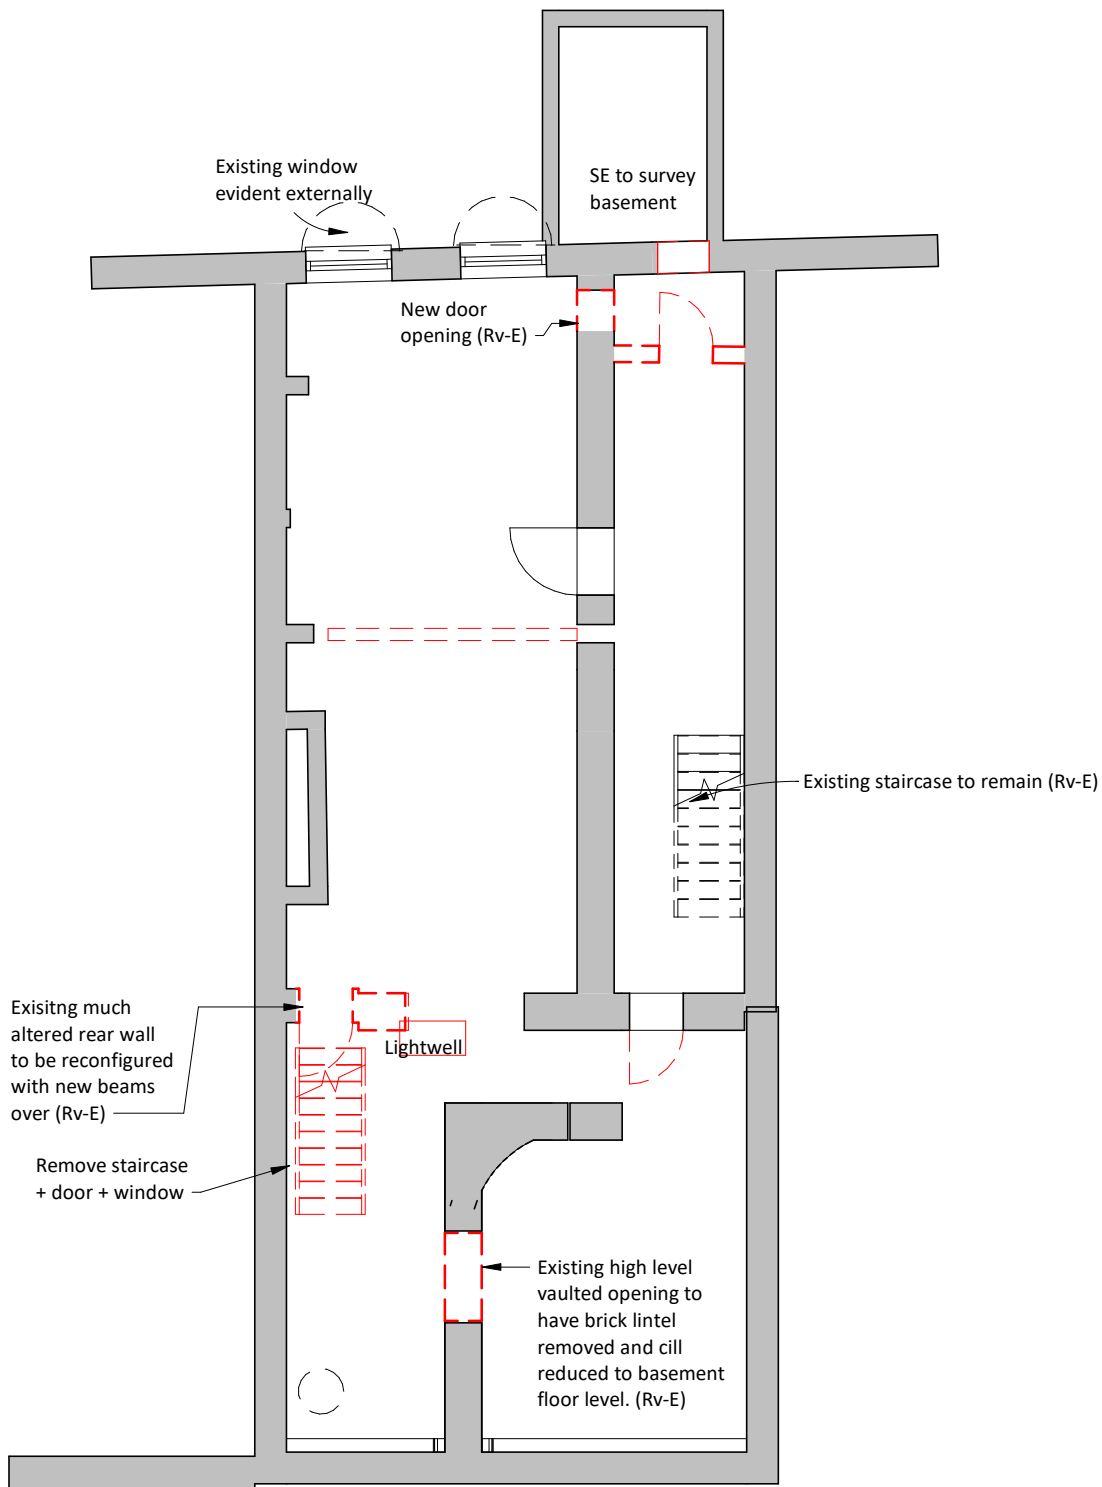


-01 Basement as Demo
1 : 100

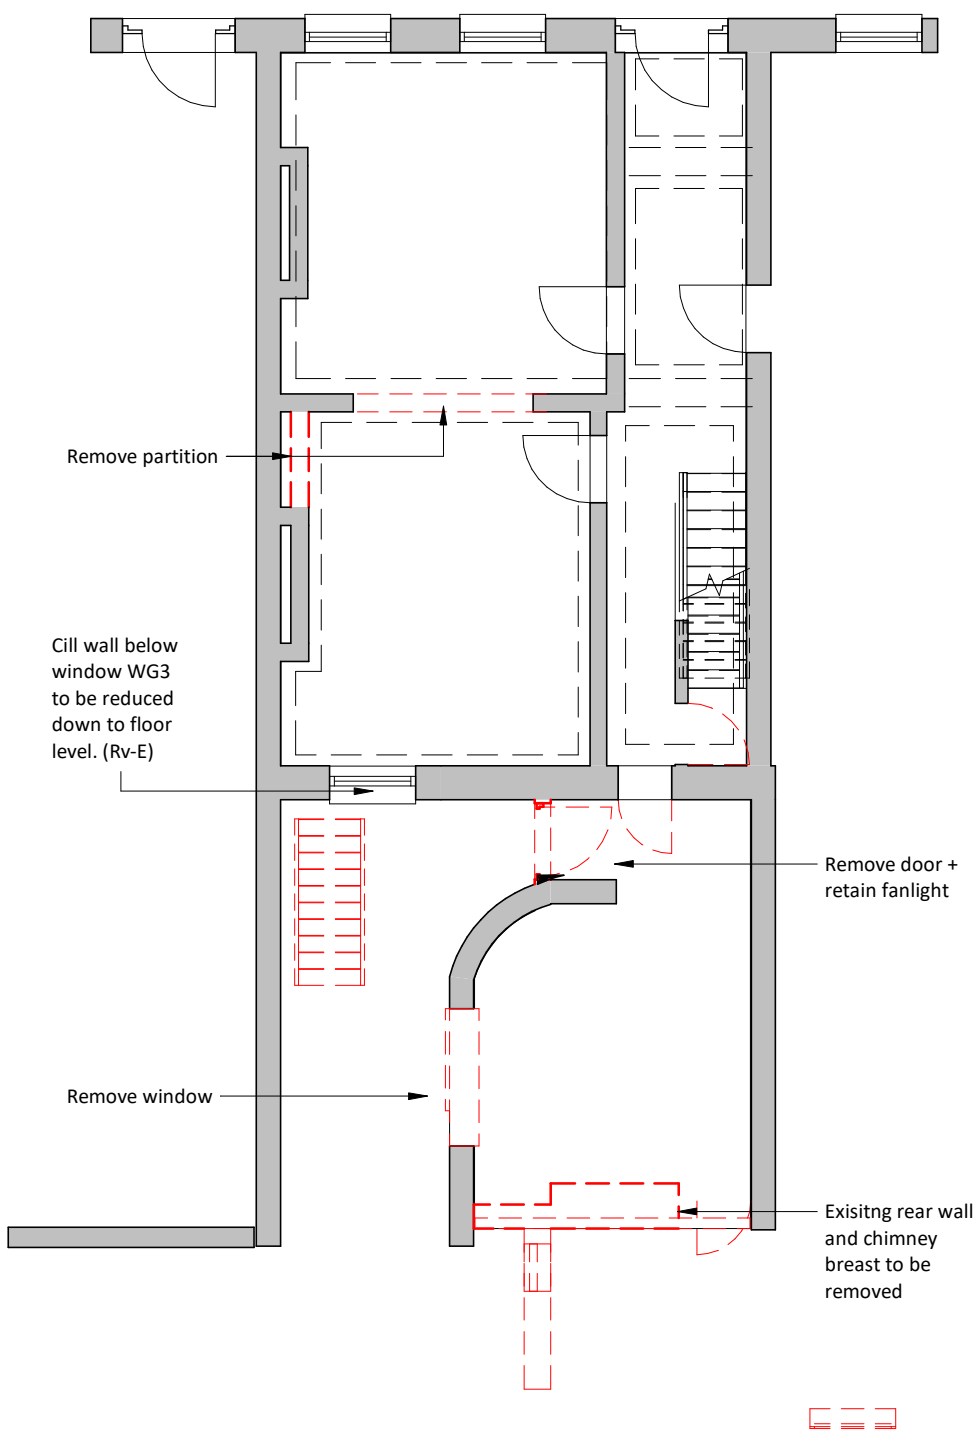

00 Ground Floor as Demo
1 : 100

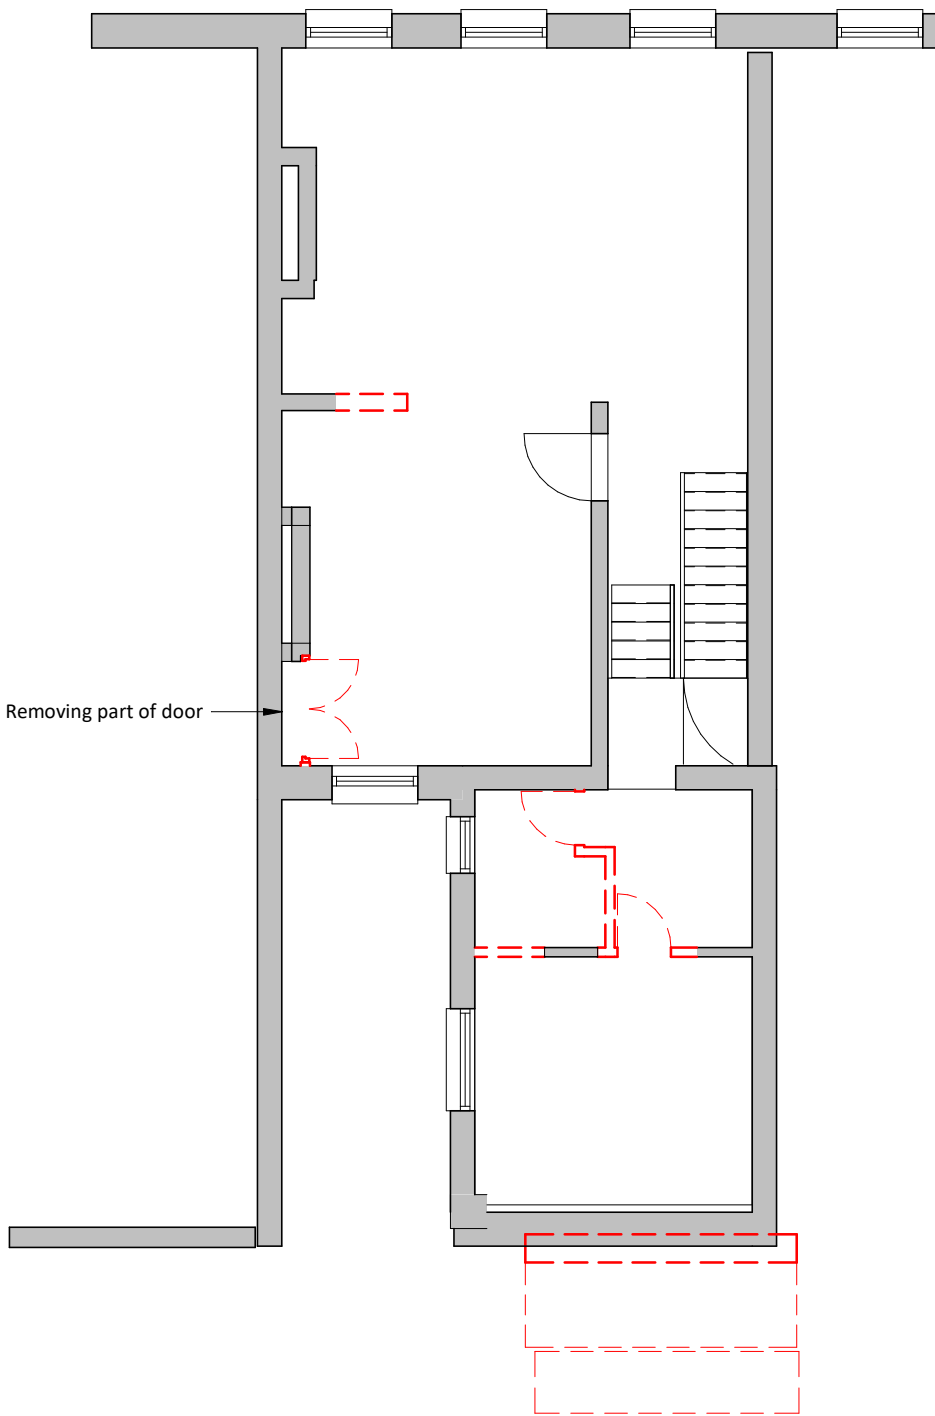

01 First Floor as Demo
1 : 100

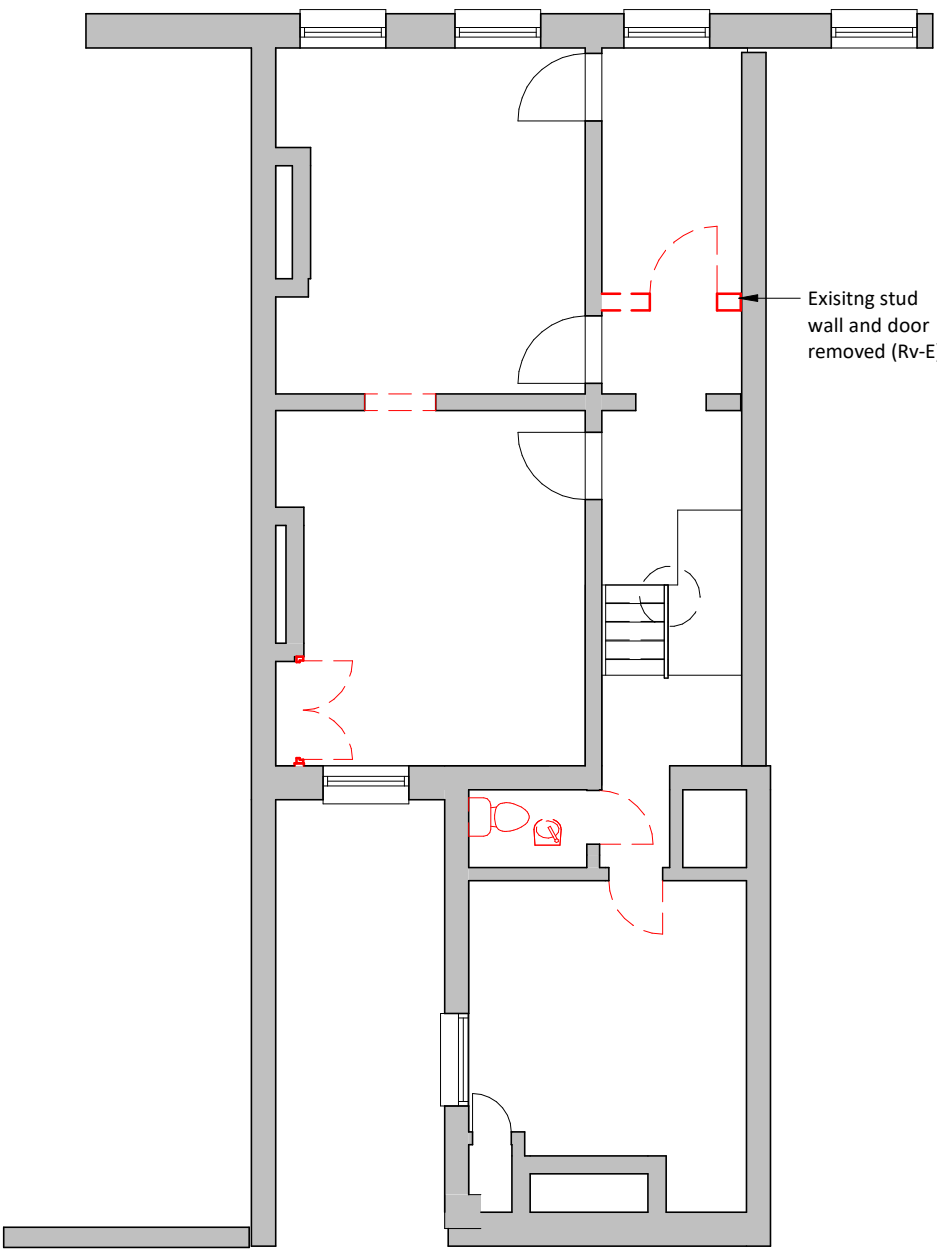

02 Second Floor as Demo
1 : 100

Existing Floor Plans with proposed removal indicated in red

----- Demolition

E	03.06.21	MP	Amended for revised planning application
D	09/01/20	HP	Amendmenst shown in blue
C	03/12/19	HP	Amendments following Interior Designer comments
B	30/09/19	HP	Amendment to show rear window second floor and front windows basement
A	29/07/19	VS	Scale bar added
Rev	Date	Int	Description



Client:
Nilesh Bhatt

Project:
**13 St John Street,
Manchester**

Description:
Demolition Plans

Purpose of Issue:			
Building Regulations			
Drawn By:	Checked By:	Date:	Scale @ A1:
HP	VS	30/09/19	1 : 100
Job No:	Status Code:	Drawing No:	Rev:
3521	S2	206	E
File Identifier: SJ-BTP-00-ZZ-DR-A-3521_206			