
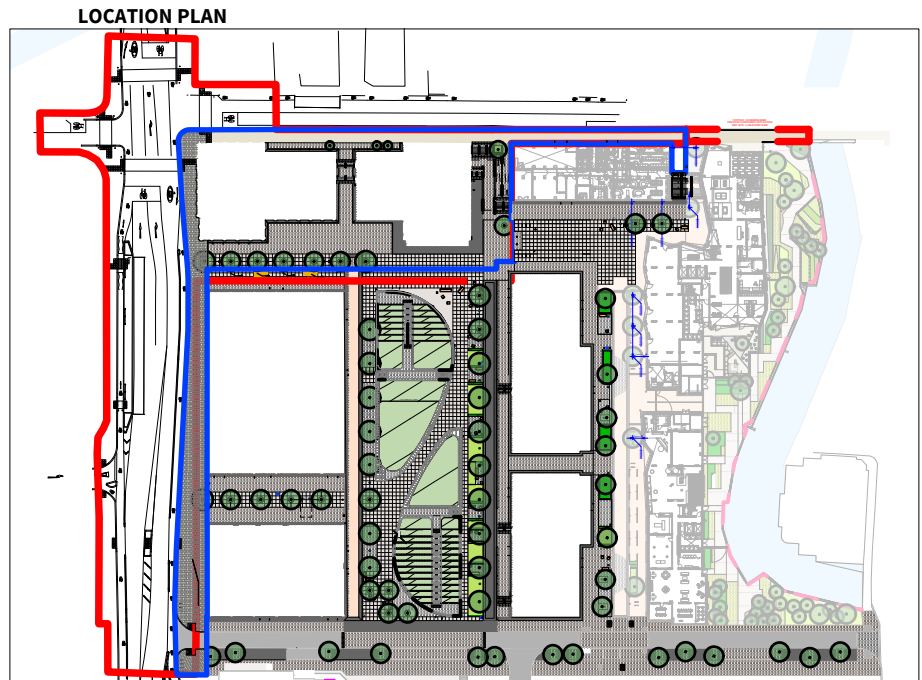


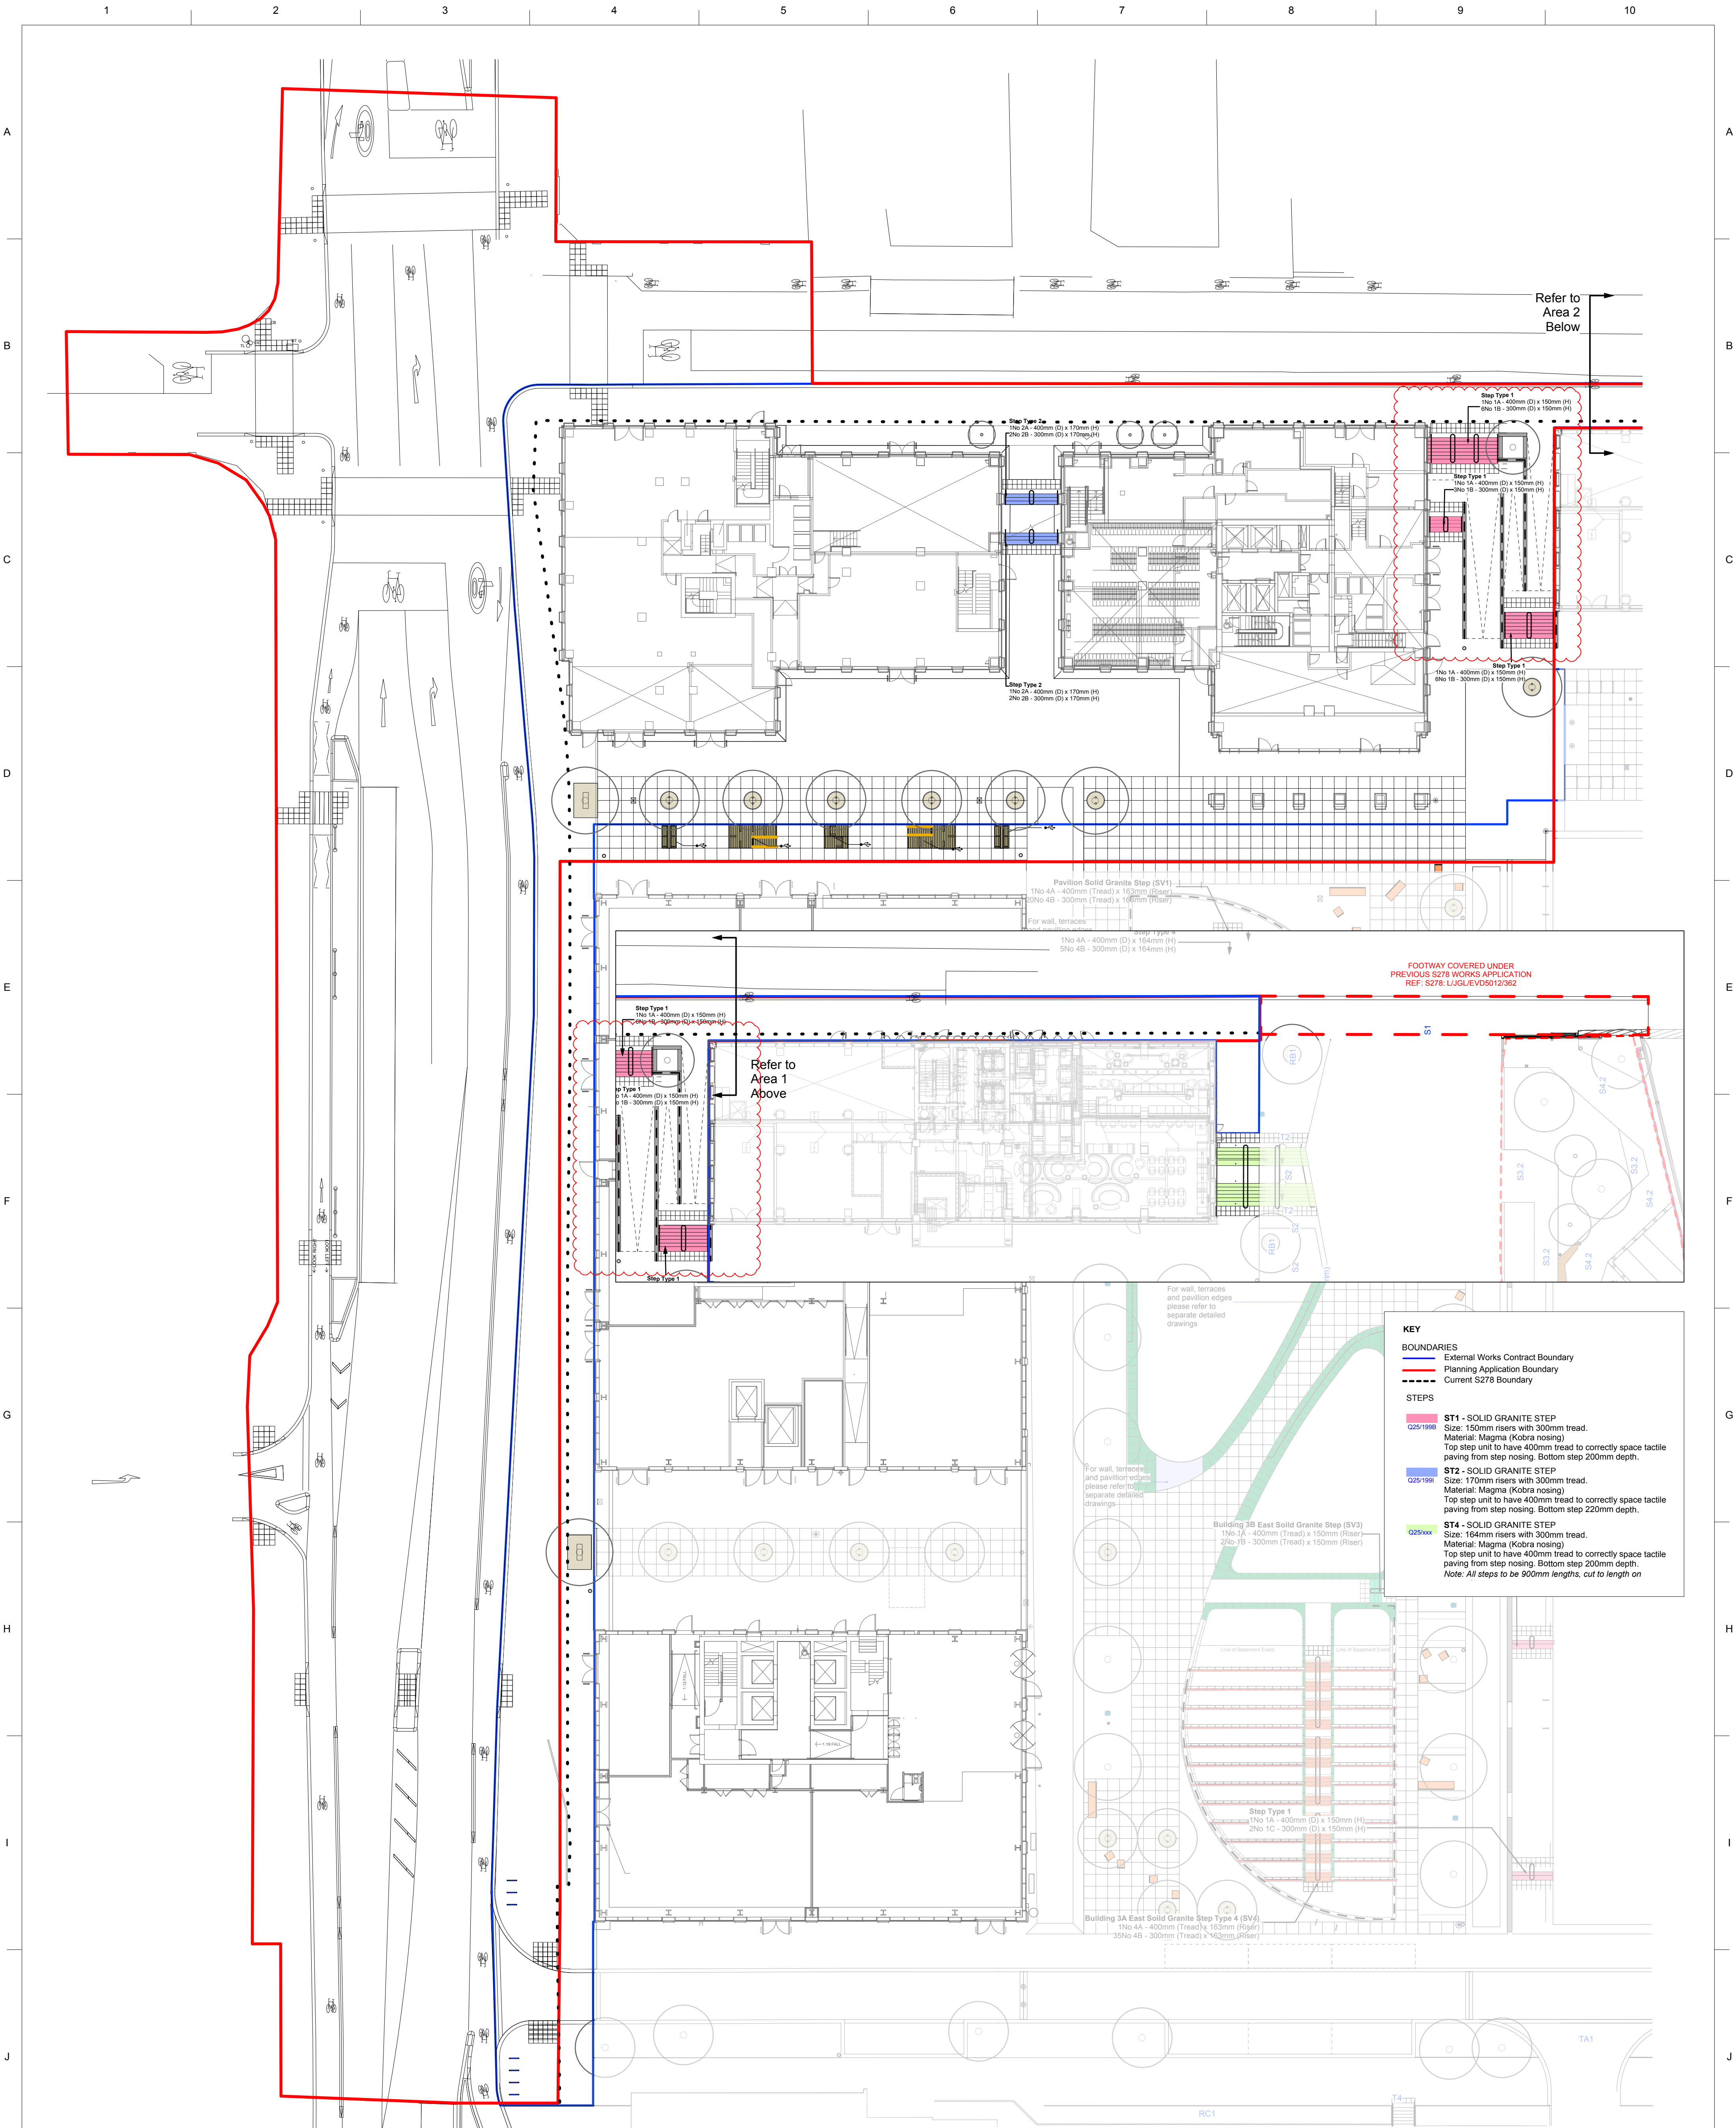

CR-C06	05-07-21	Updated step & ramp arrangement to north.	FF	FF
CR-C05	04-05-21	Final Construction	FF	RM
S3-C04	01-12-20	Seating design updated to line with access officer comments.	FF	RM
S3-C03	11-11-20	1. Ino tree repositioned on Charles Street to avoid service clash.	FF	RM
S3-C02	12-08-20	Feature seat layout updated to reflect latest design & shop drawings.	FF	RM
S3-C01	15-01-20	Drawing updated to show both contract boundary and red line planning application boundary. Drawing scale revised.	FF	RM
S3-P02	26-02-19	STAGE 05 UPDATE 1. Building Footprint updated and Door Protection hoops amended. 2. Spec clauses added.	EG	RM
S3-P01	09-10-18	STAGE 05	EG	RM
S4-P02	26-09-18	Status Update	VE	RM
S4-P01	25-09-18	ISSUED FOR PLANNING UPDATE	FF	RM

Issue	Date	Status	Drawn	Apprvd.
-------	------	--------	-------	---------

Client	John Sisk & Son Ltd		
Project	Circle Square Plots 5 & 6		
Drg Title	External Steps		
Created on	20-08-18	Created by	VE
Approved by	RM	Workstage	Final Construction
Scale	1:250	Size	A1
Prev Drg No.	PL1502-56-T-104-02		
Drg No.	CSAL-PLA-ZT-XX-DR-L-0104	Suitability	CR
Revision	C06		

Planit I.E. Limited
E: info@planit-ie.com W: planit-ie.com
MANCHESTER 2 Back Grafton St Altrincham WA14 1DY T: 0161 928 9281
LONDON Unit 6 Waterside 44-48 Wharf Road London N1 7UX T: 0207 253 5678

THIS DRAWING IS COPYRIGHT PROTECTED AND MAY NOT BE REPRODUCED IN WHOLE OR PART WITHOUT WRITTEN AUTHORITY FROM THE OWNER.

- NOTE:**
- Do not scale from this drawing. Always work to noted dimensions.
 - All dimensions are in millimetres unless otherwise stated.
 - All setting out, levels and dimensions to be agreed on site.
 - The dimensions of all materials must be checked on site before being laid out.
 - This drawing must be read with the relevant specification clauses and detail drawings.
 - Order of construction and setting out to be agreed on site.