

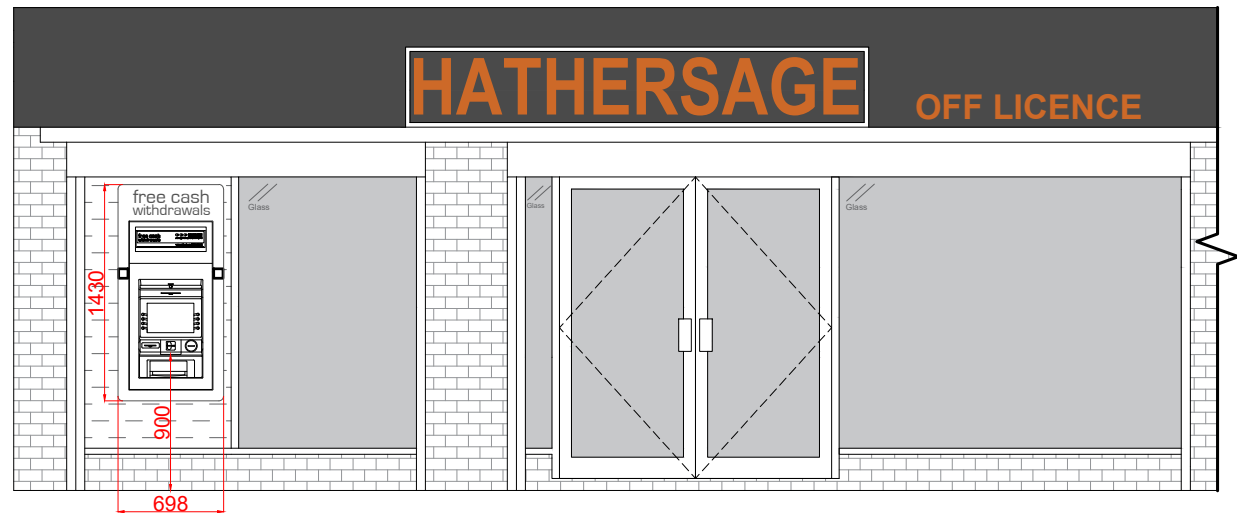
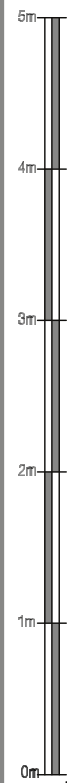


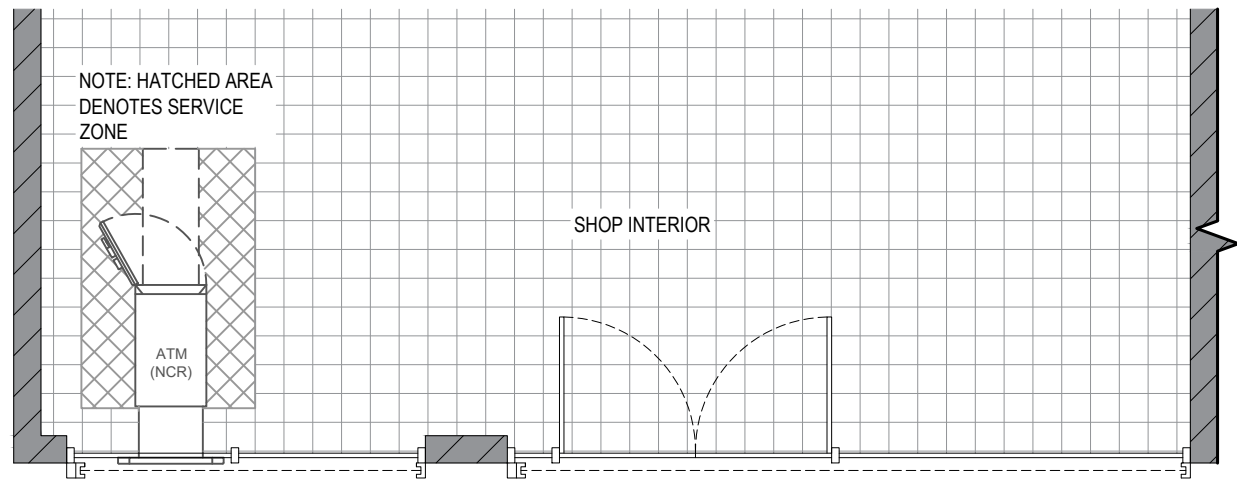

NEW ATM INSTALLED THROUGH
NEW SECURE PANEL

AS-INSTALLED FRONT ELEVATION

Scale 1:50

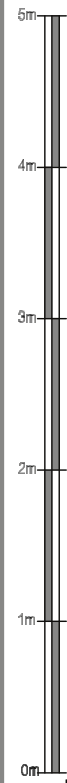

NOTE: HATCHED AREA
DENOTES SERVICE
ZONE

SHOP INTERIOR

ATM
(NCR)

AS-INSTALLED PART PLAN

Scale 1:50



Date: Comments: By:

GENERAL NOTES:
1) All dimensions in millimeters unless otherwise stated.

Site:
Hathersage Off Licence,
74 Hathersage Road,
Manchester,
M13 0FN

Drawing Title:
As-Installed Plan and Elevation

Ref: T020743_AI	Date: 30/12/2021	Rev:
Scale: 1:50	Paper: A3	Date Rev: