




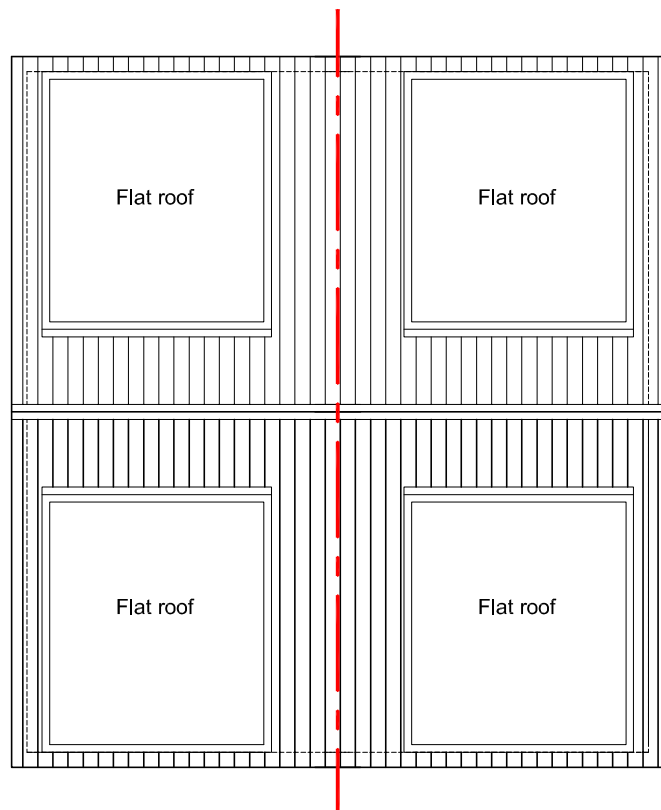


As-built Roof Plan 1:100

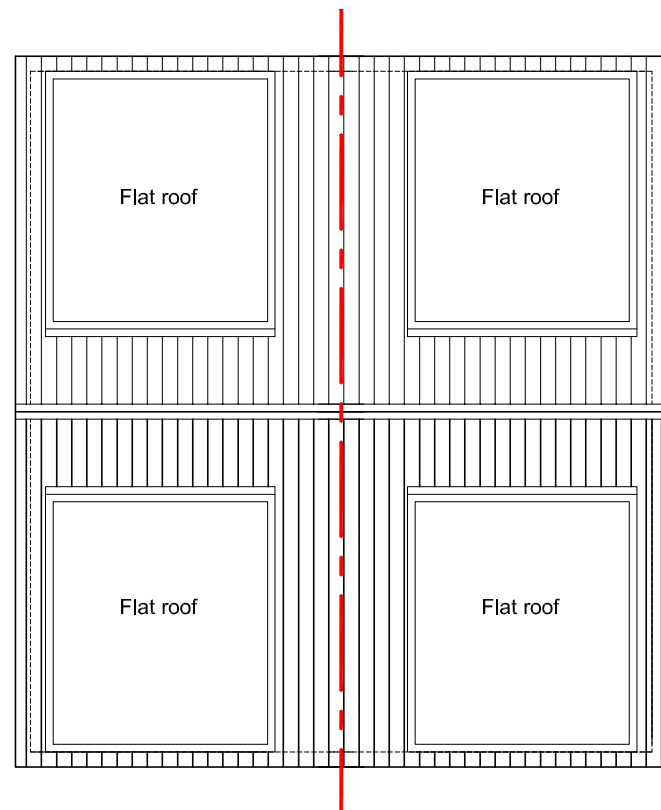


Proposed Roof Plan 1:100
(Unchanged)

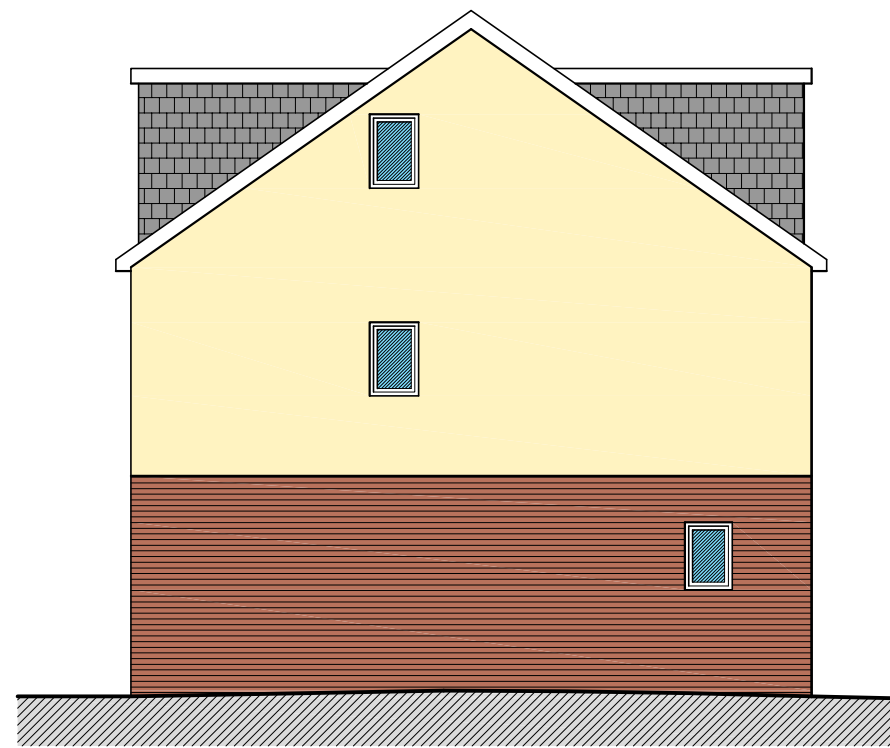


As-built West Elevation 1:100

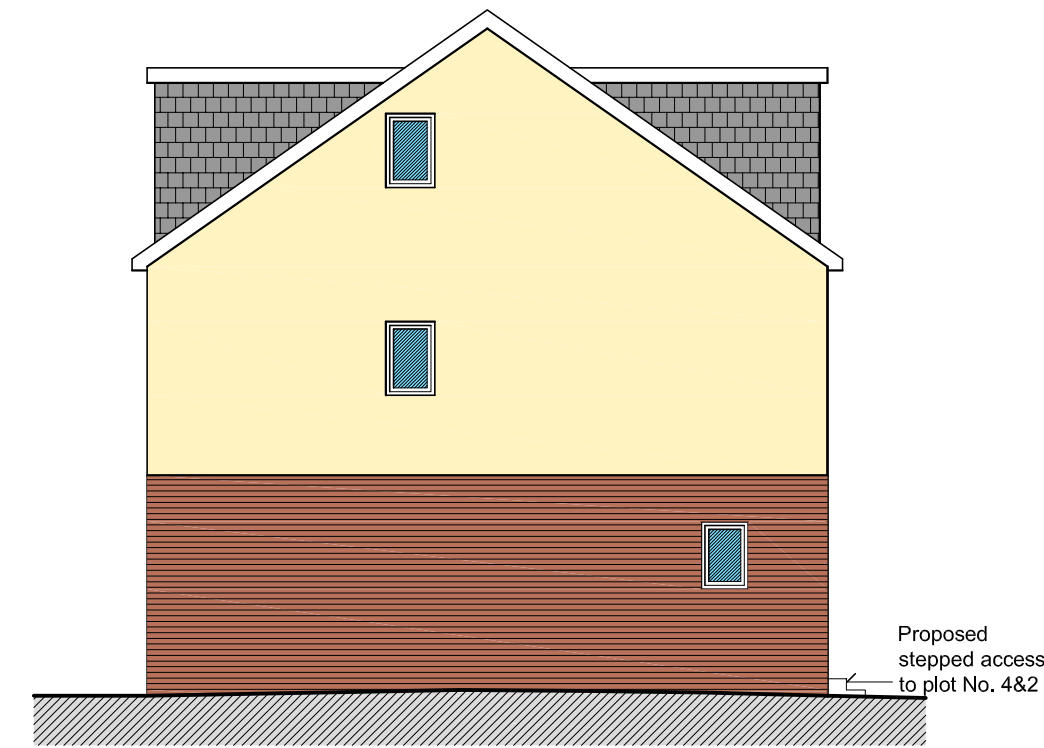


Proposed West Elevation 1:100

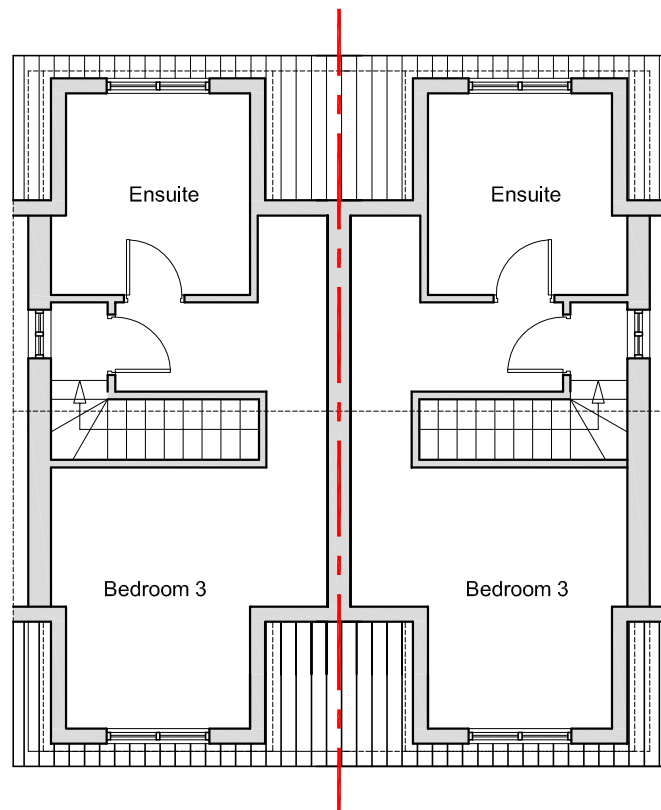


As-built 2F Plan 1:100

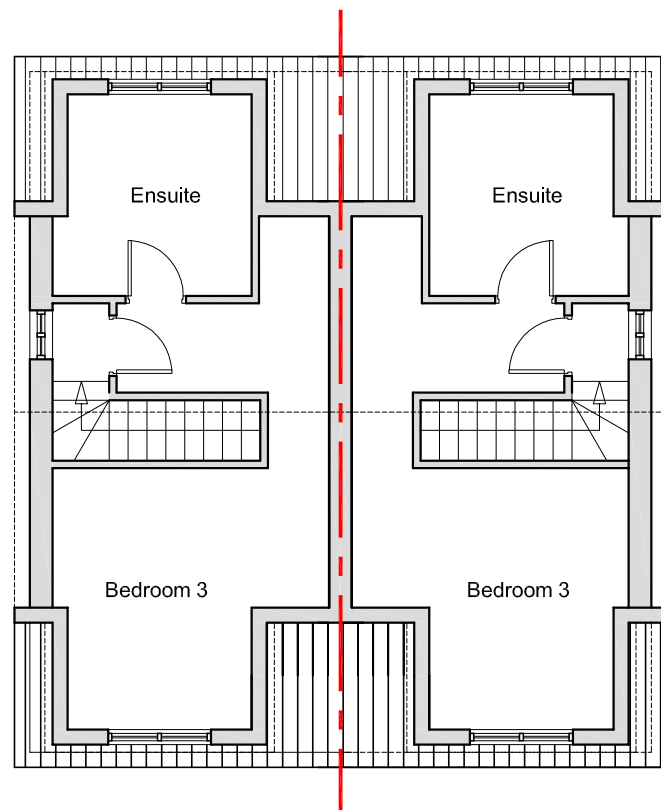


Proposed 2F Plan 1:100
(Unchanged)

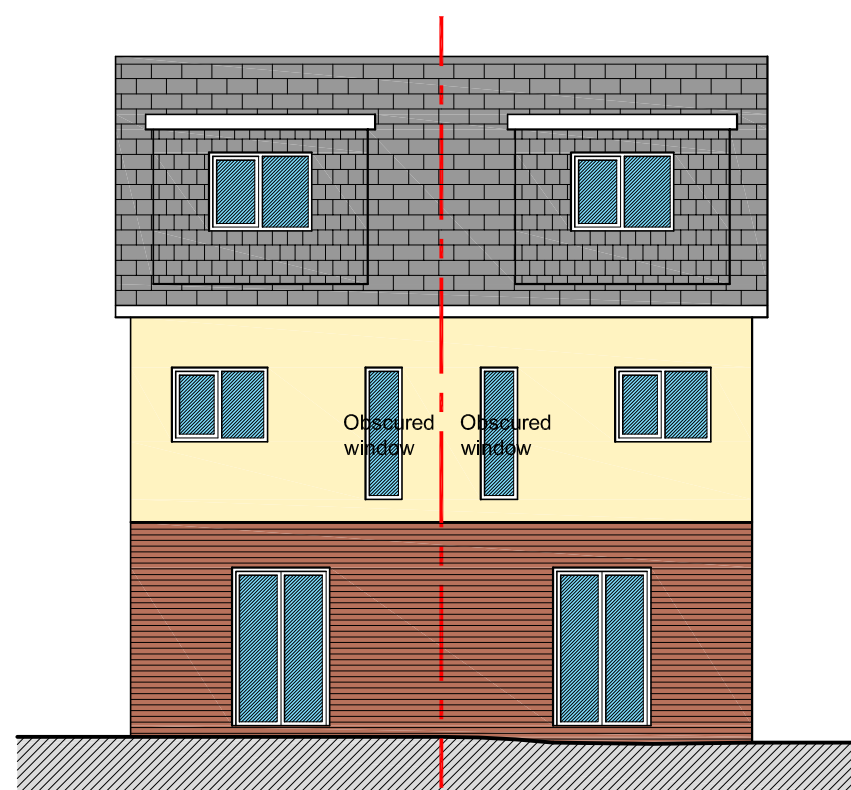


As-built Rear Elevation 1:100

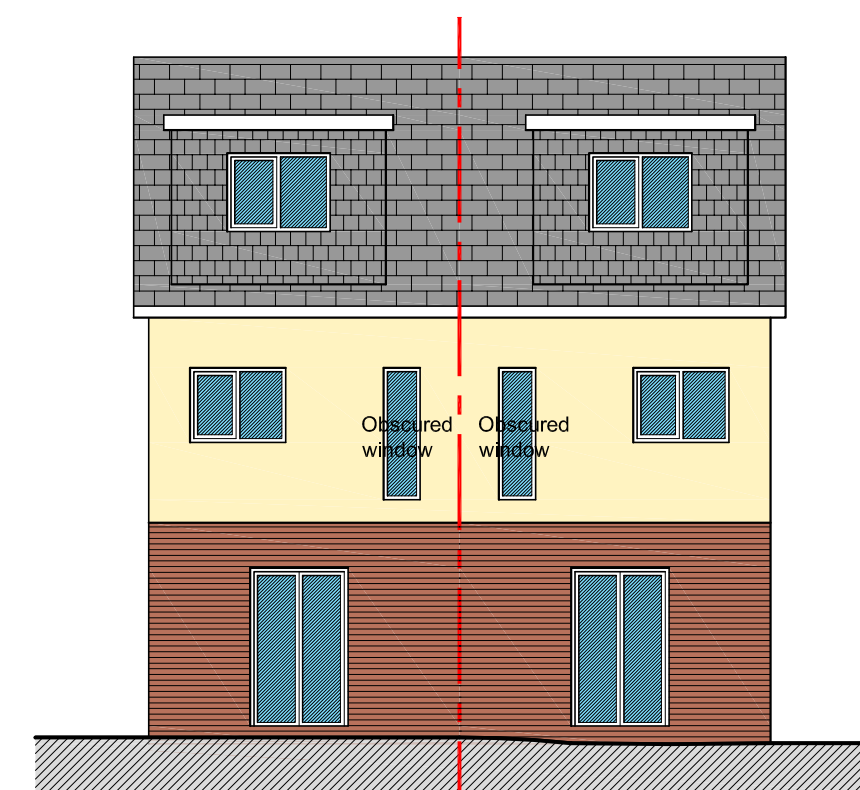


Proposed Rear Elevation 1:100
(Unchanged)

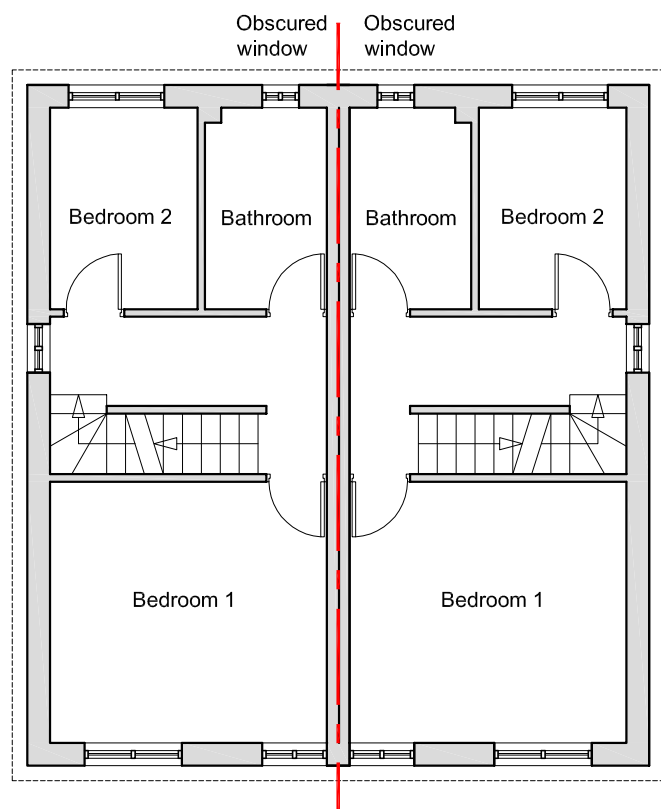


As-built 1F Plan 1:100

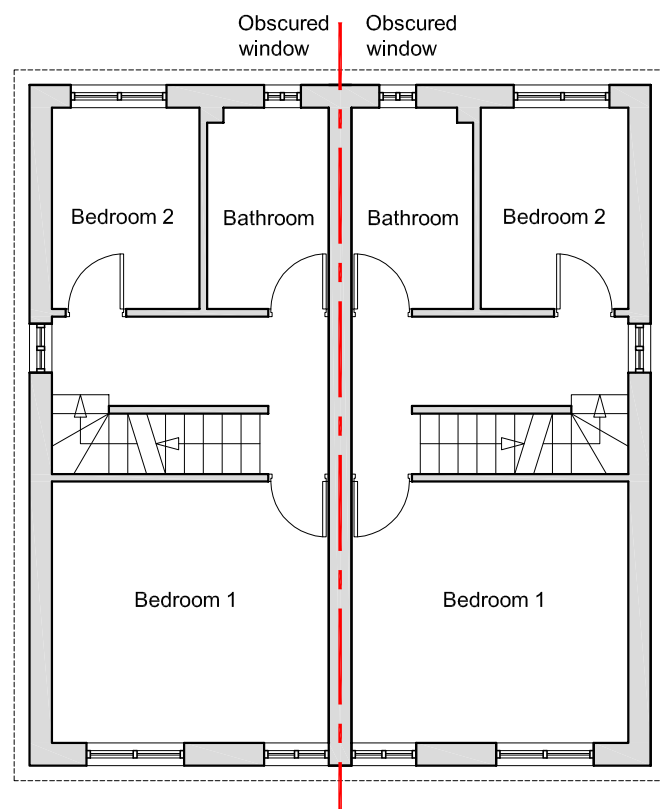


Proposed 1F Plan 1:100
(Unchanged)

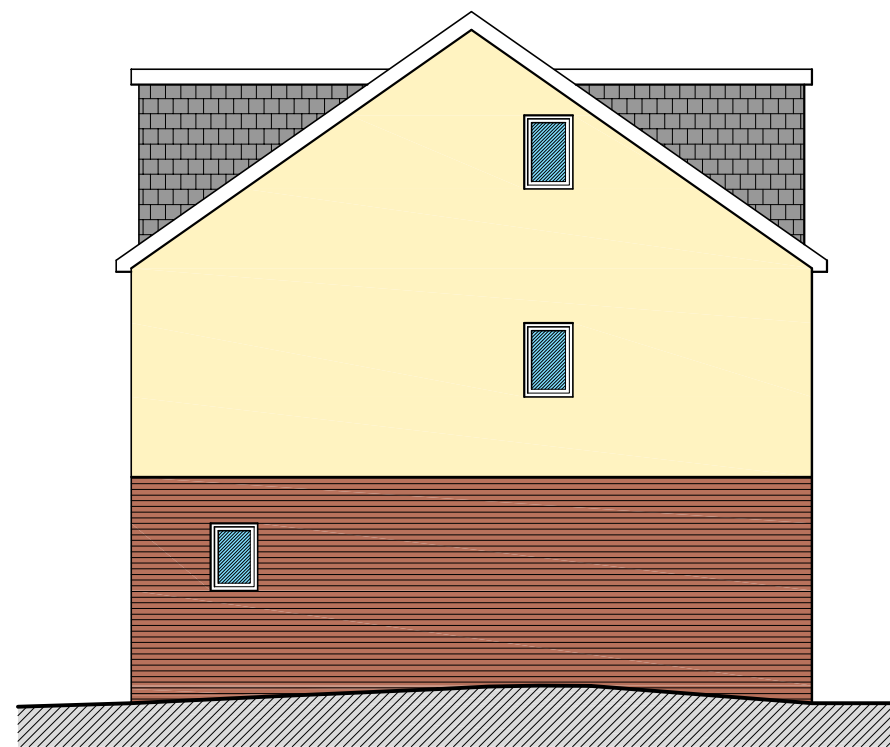


As-built East Elevation 1:100

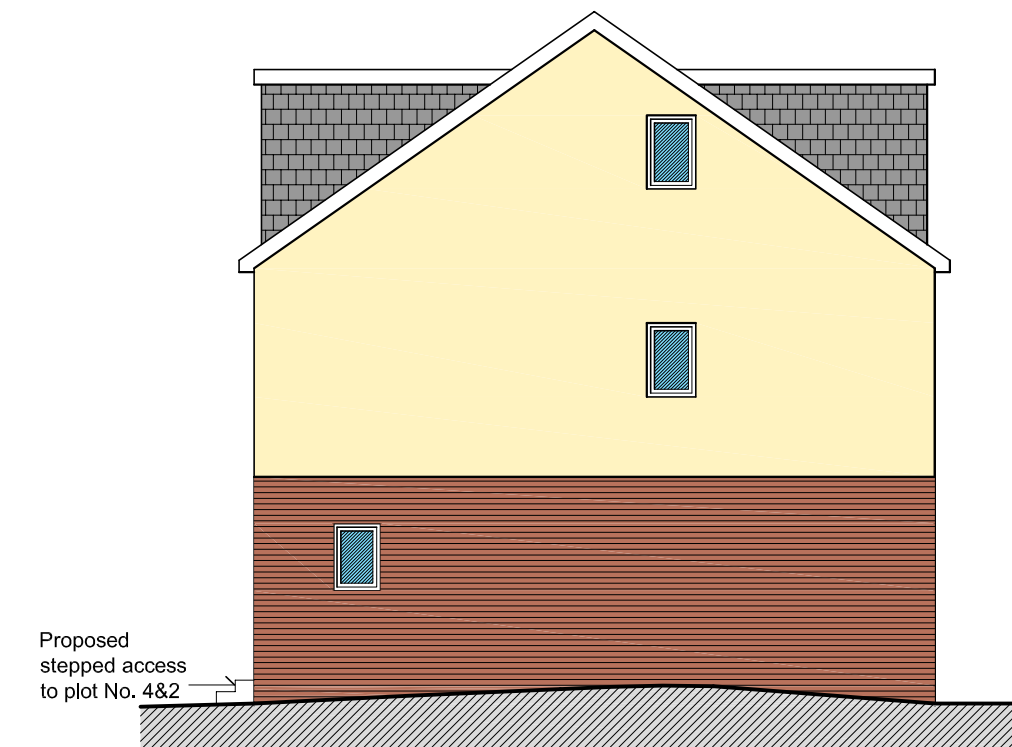


Proposed East Elevation 1:100

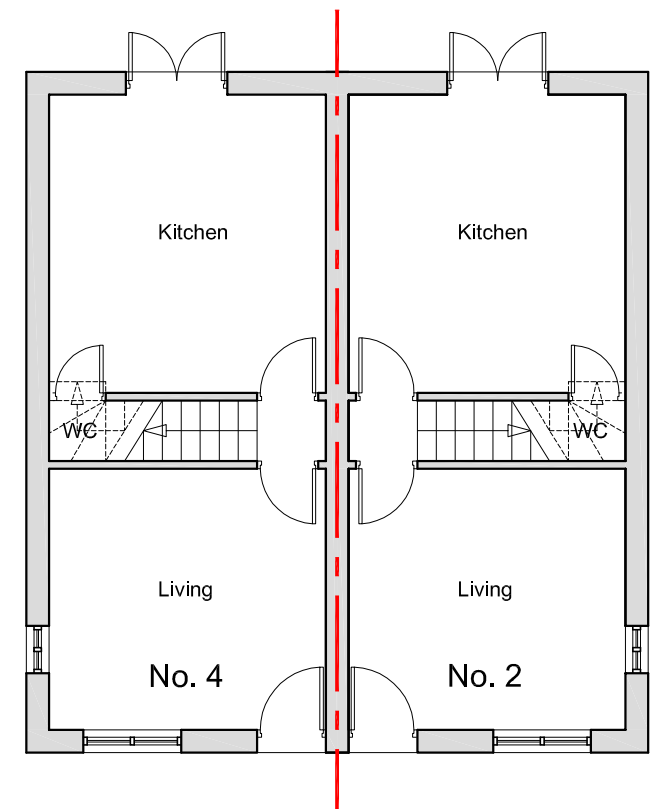


As-built GF Plan 1:100

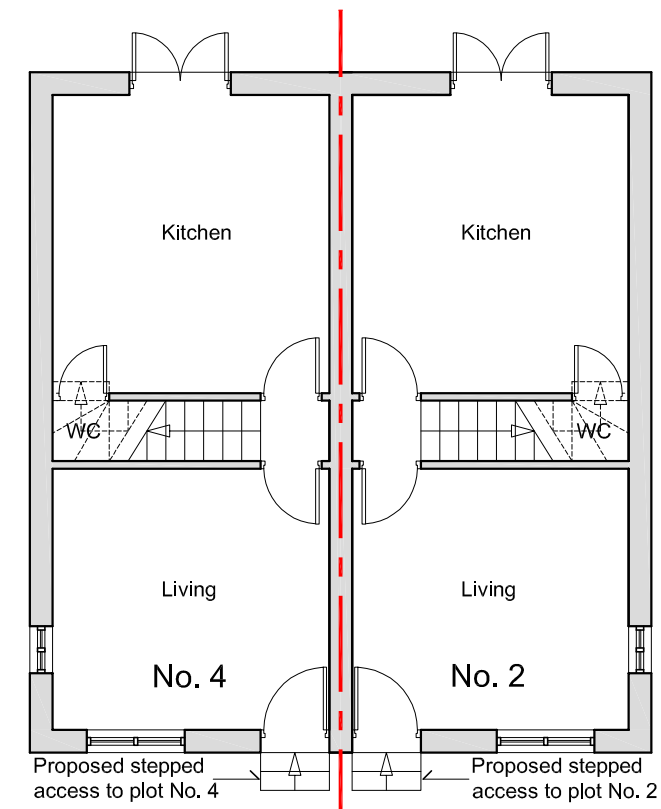

Proposed GF Plan 1:100

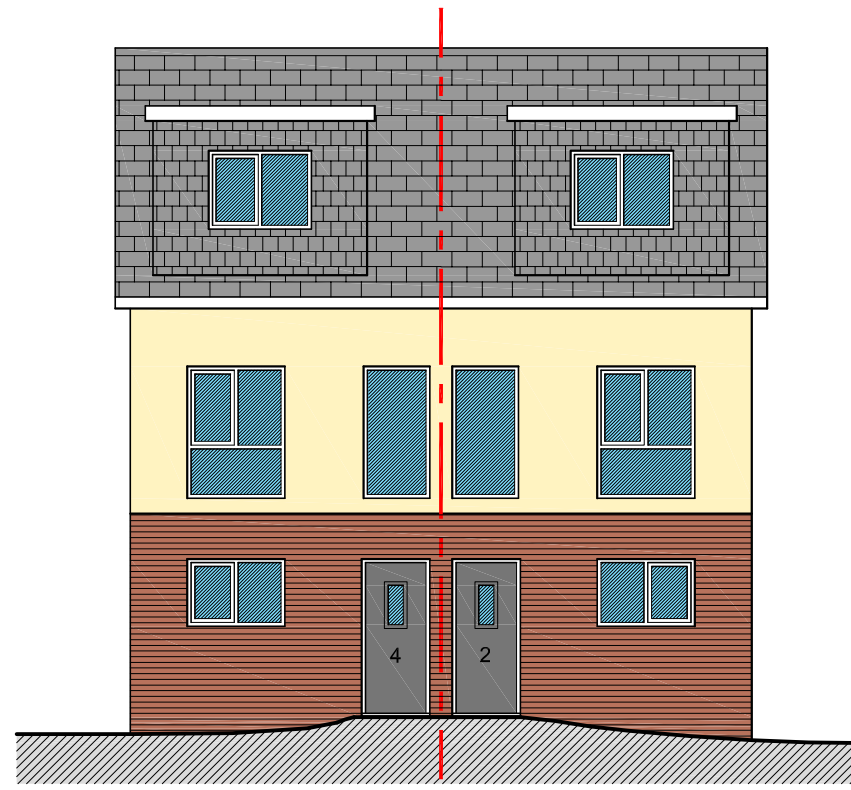

As-built 4 & 2 Tandlewood Mews Elevation 1:100

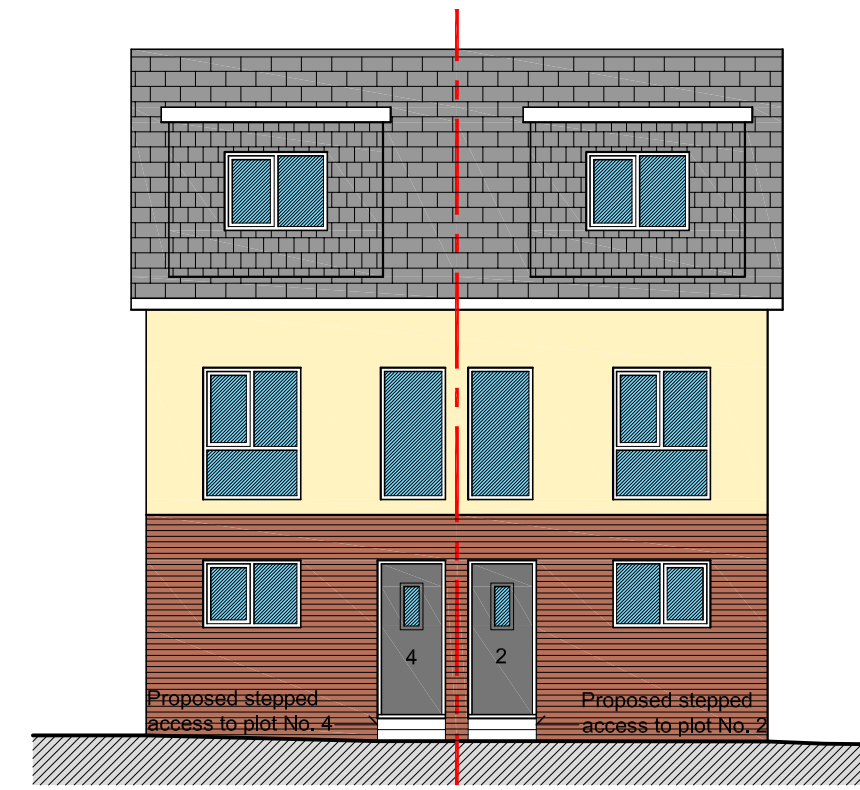

Proposed 4 & 2 Tandlewood Mews Elevation 1:100

