


All dimensions are to be checked on site, any discrepancies are to be reported to the Architect before work commences. Do not scale from this drawing.

This drawing is to be read in conjunction with all relevant consultants and specialists drawings / documents, any discrepancies are to be reported to the Architect before the affected work commences.


All structural components shown are indicative only. Details / calculations of structural members are to be provided by the Structural Engineer.

This drawing is copyright.


A	First Issue	20/05/2021
B	Amendment following request from planner	03/06/2021

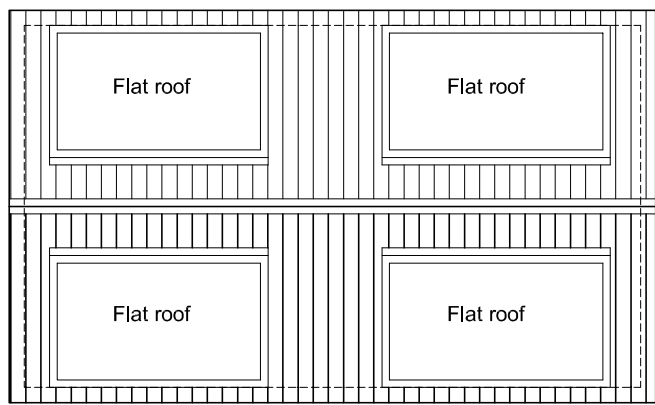


As-built Roof Plan 1:100

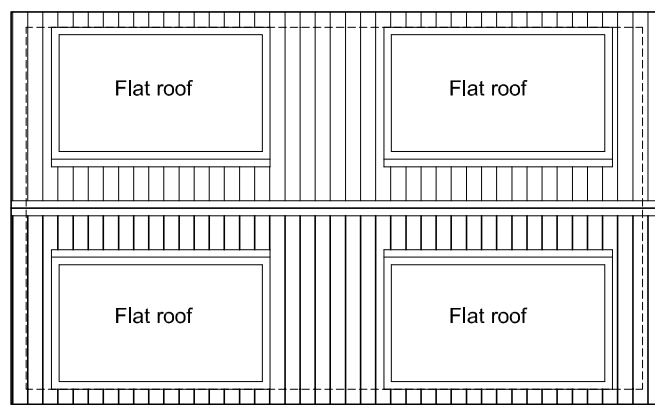


Proposed Roof Plan 1:100

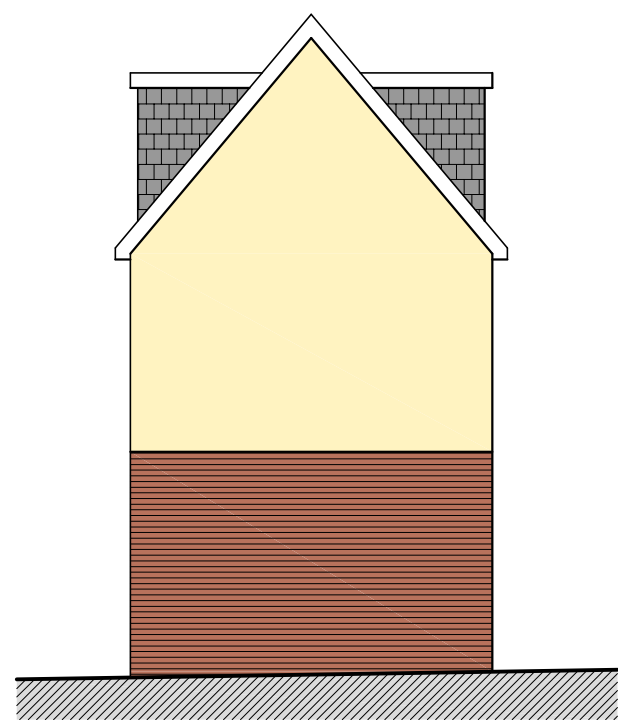


As-built West Elevation 1:100

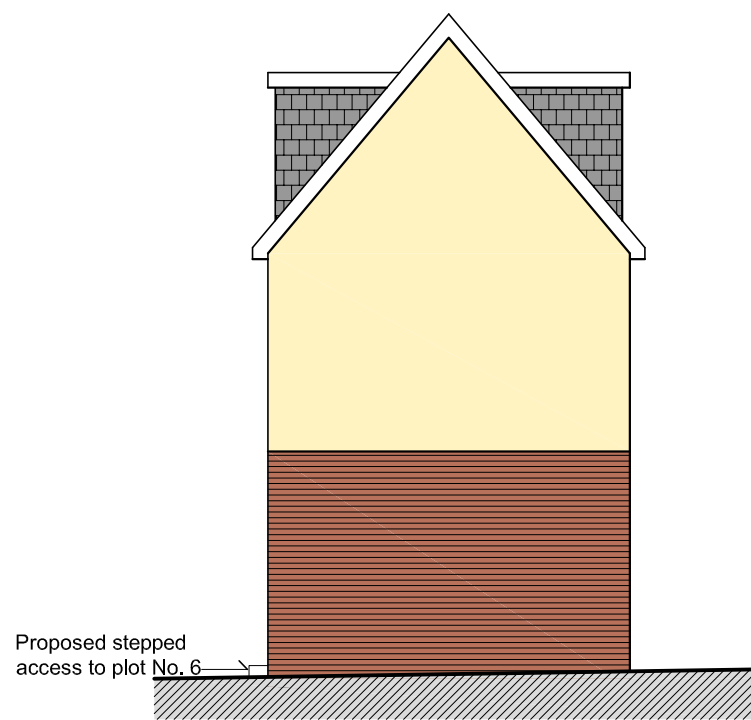


Proposed West Elevation 1:100

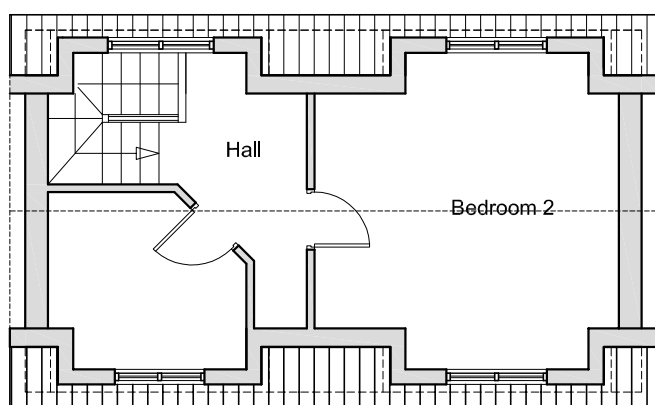


As-built 2F Plan 1:100

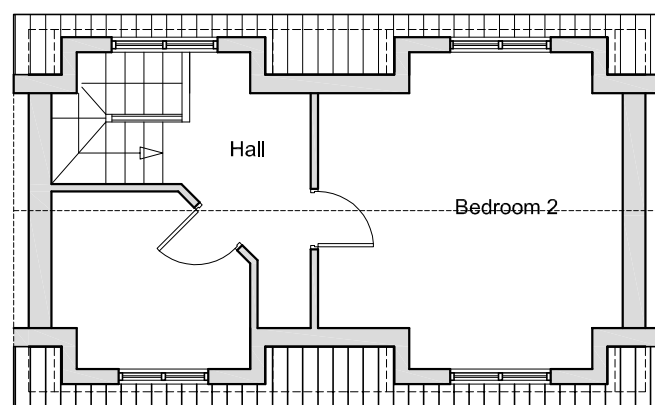


Proposed 2F Plan 1:100

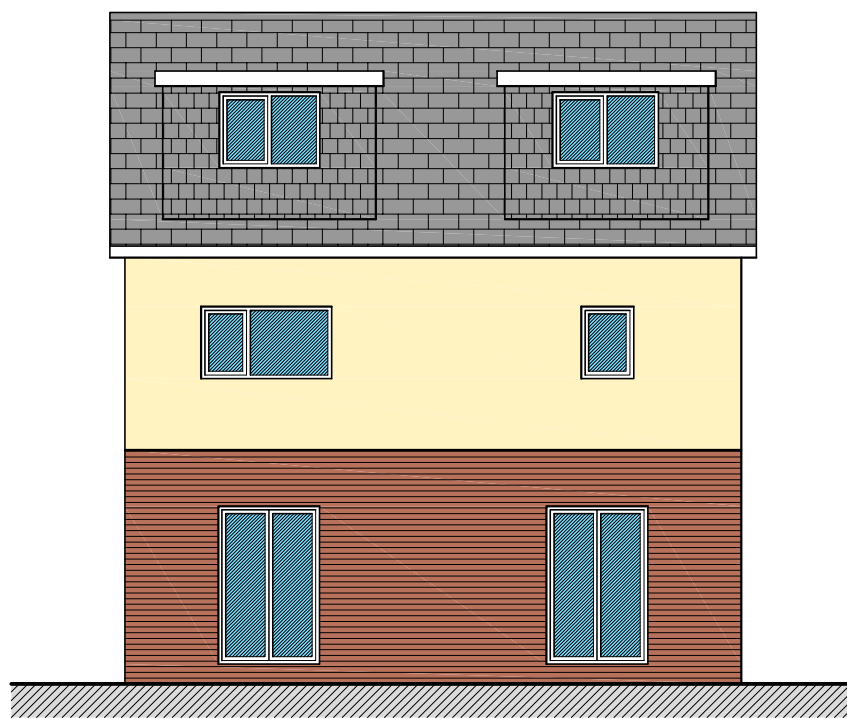


As-built Rear Elevation 1:100

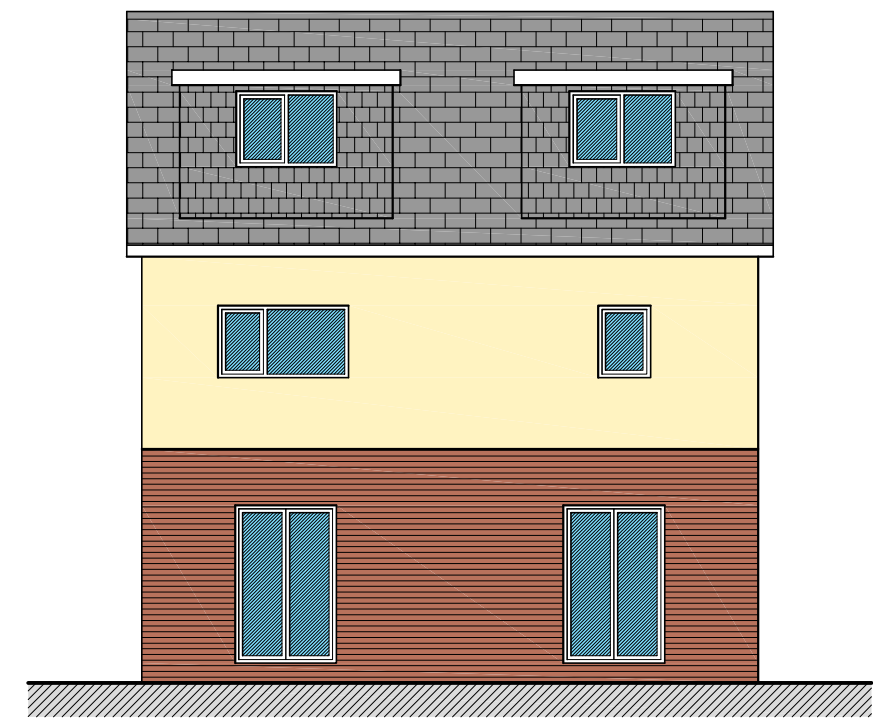


Proposed Rear Elevation 1:100
(Unchanged)

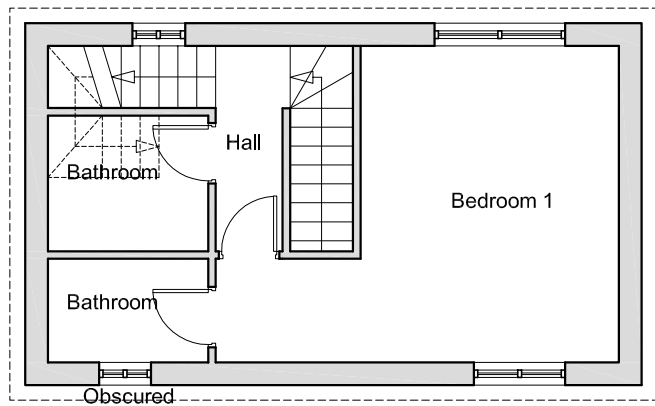


As-built 1F Plan 1:100

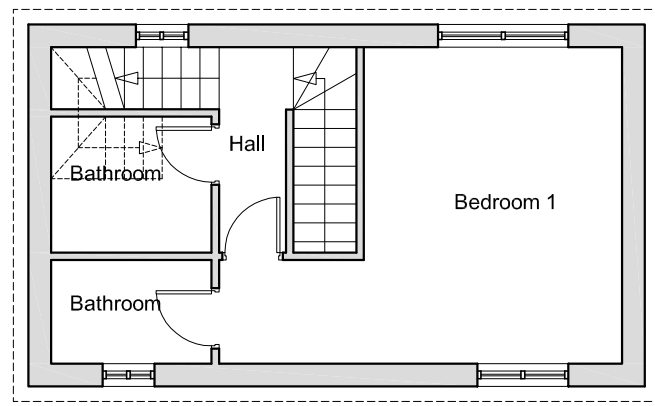


Proposed 1F Plan 1:100

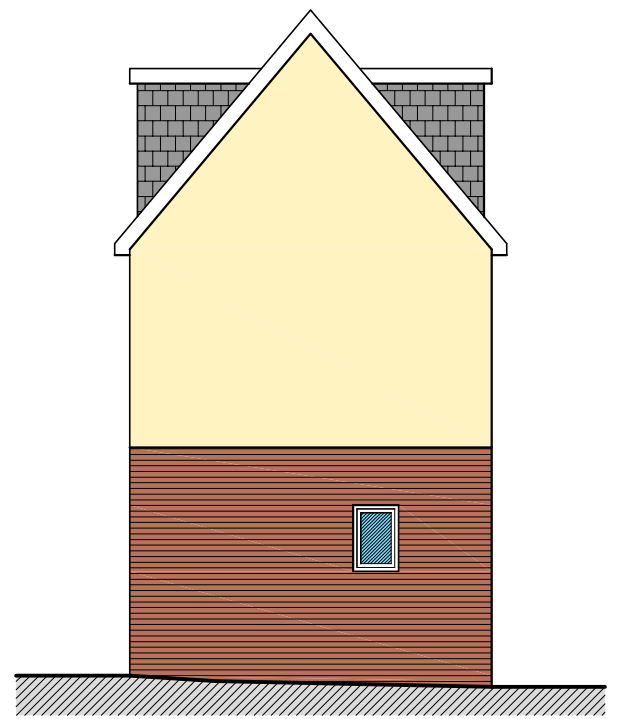


As-built East Elevation 1:100

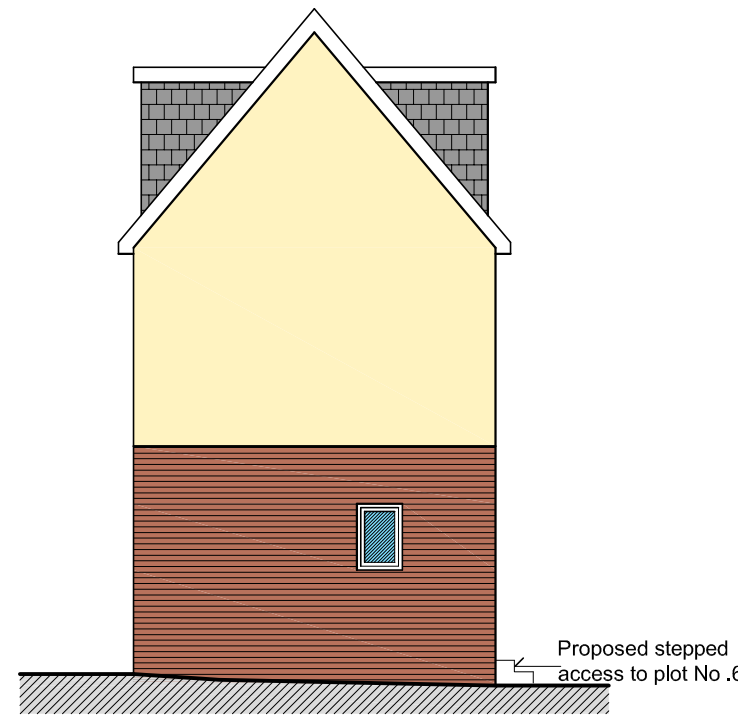


Proposed East Elevation 1:100

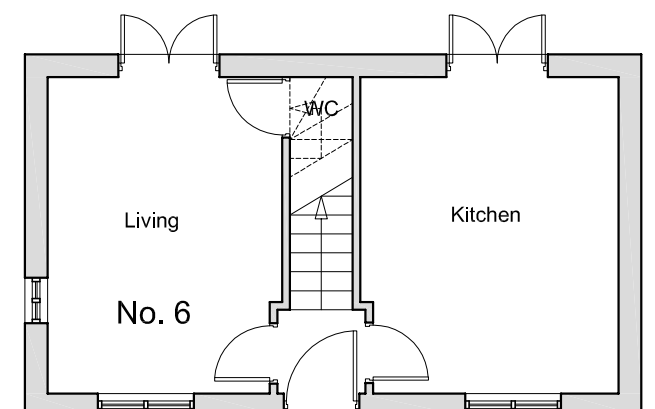


As-built GF Plan 1:100

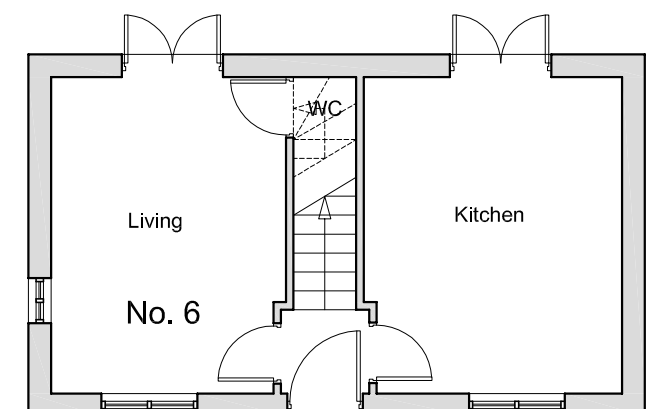


Proposed GF Plan 1:100

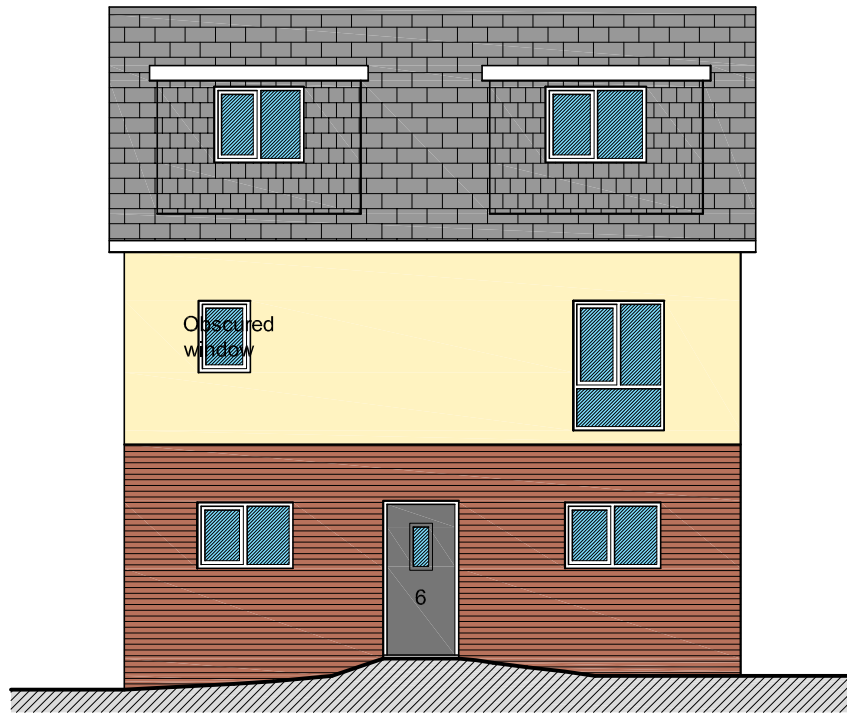

As-built 6 Tandlewood Mews Elevation 1:100

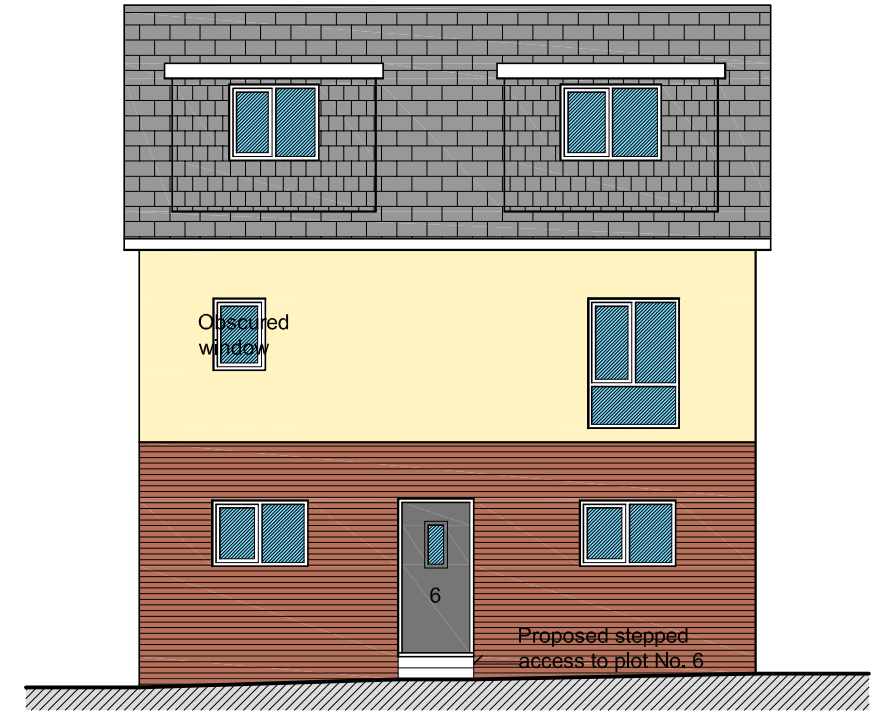

Proposed 6 Tandlewood Mews Elevation 1:100

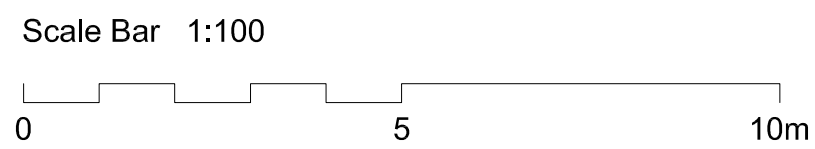

T+A Tang & Associates Ltd
Chartered Architects

Tel : 0161 877 9587
e-mail: barrytang@tangassociates.co.uk

Entrance W1, 1/F, Westwood House,
Greenwood Business Centre,
Manchester, M5 4QH, UK

Client:

MKenney Properties Ltd

Project:

26 Culcheth Lane, Manchester M40 1LU

Drawing Title:

As-built and Proposed Floor Plans and
Elevations for 6 Tandlewood Mews

Scale:

1:100@ A1

Date:

October 2020

Drawing No:

9580/012

Revision:

B