


NOTE:
THE SMOKE SHAFT IS A BUILDERS WORK RISER (BY OTHERS). IT MUST BE TO THE AGREED DIMENSIONS, WITH A SMOOTH INTERNAL FINISH & SUFFICIENTLY SEALED TO LIMIT THE LEAKAGE RATE TO 3.8m³/h/m² AT 50 Pa. NO OTHER BUILDING SERVICES SHOULD BE CONTAINED WITHIN THE SMOKE SHAFT.

ALL DIMENSIONS ARE IN MILLIMETERS

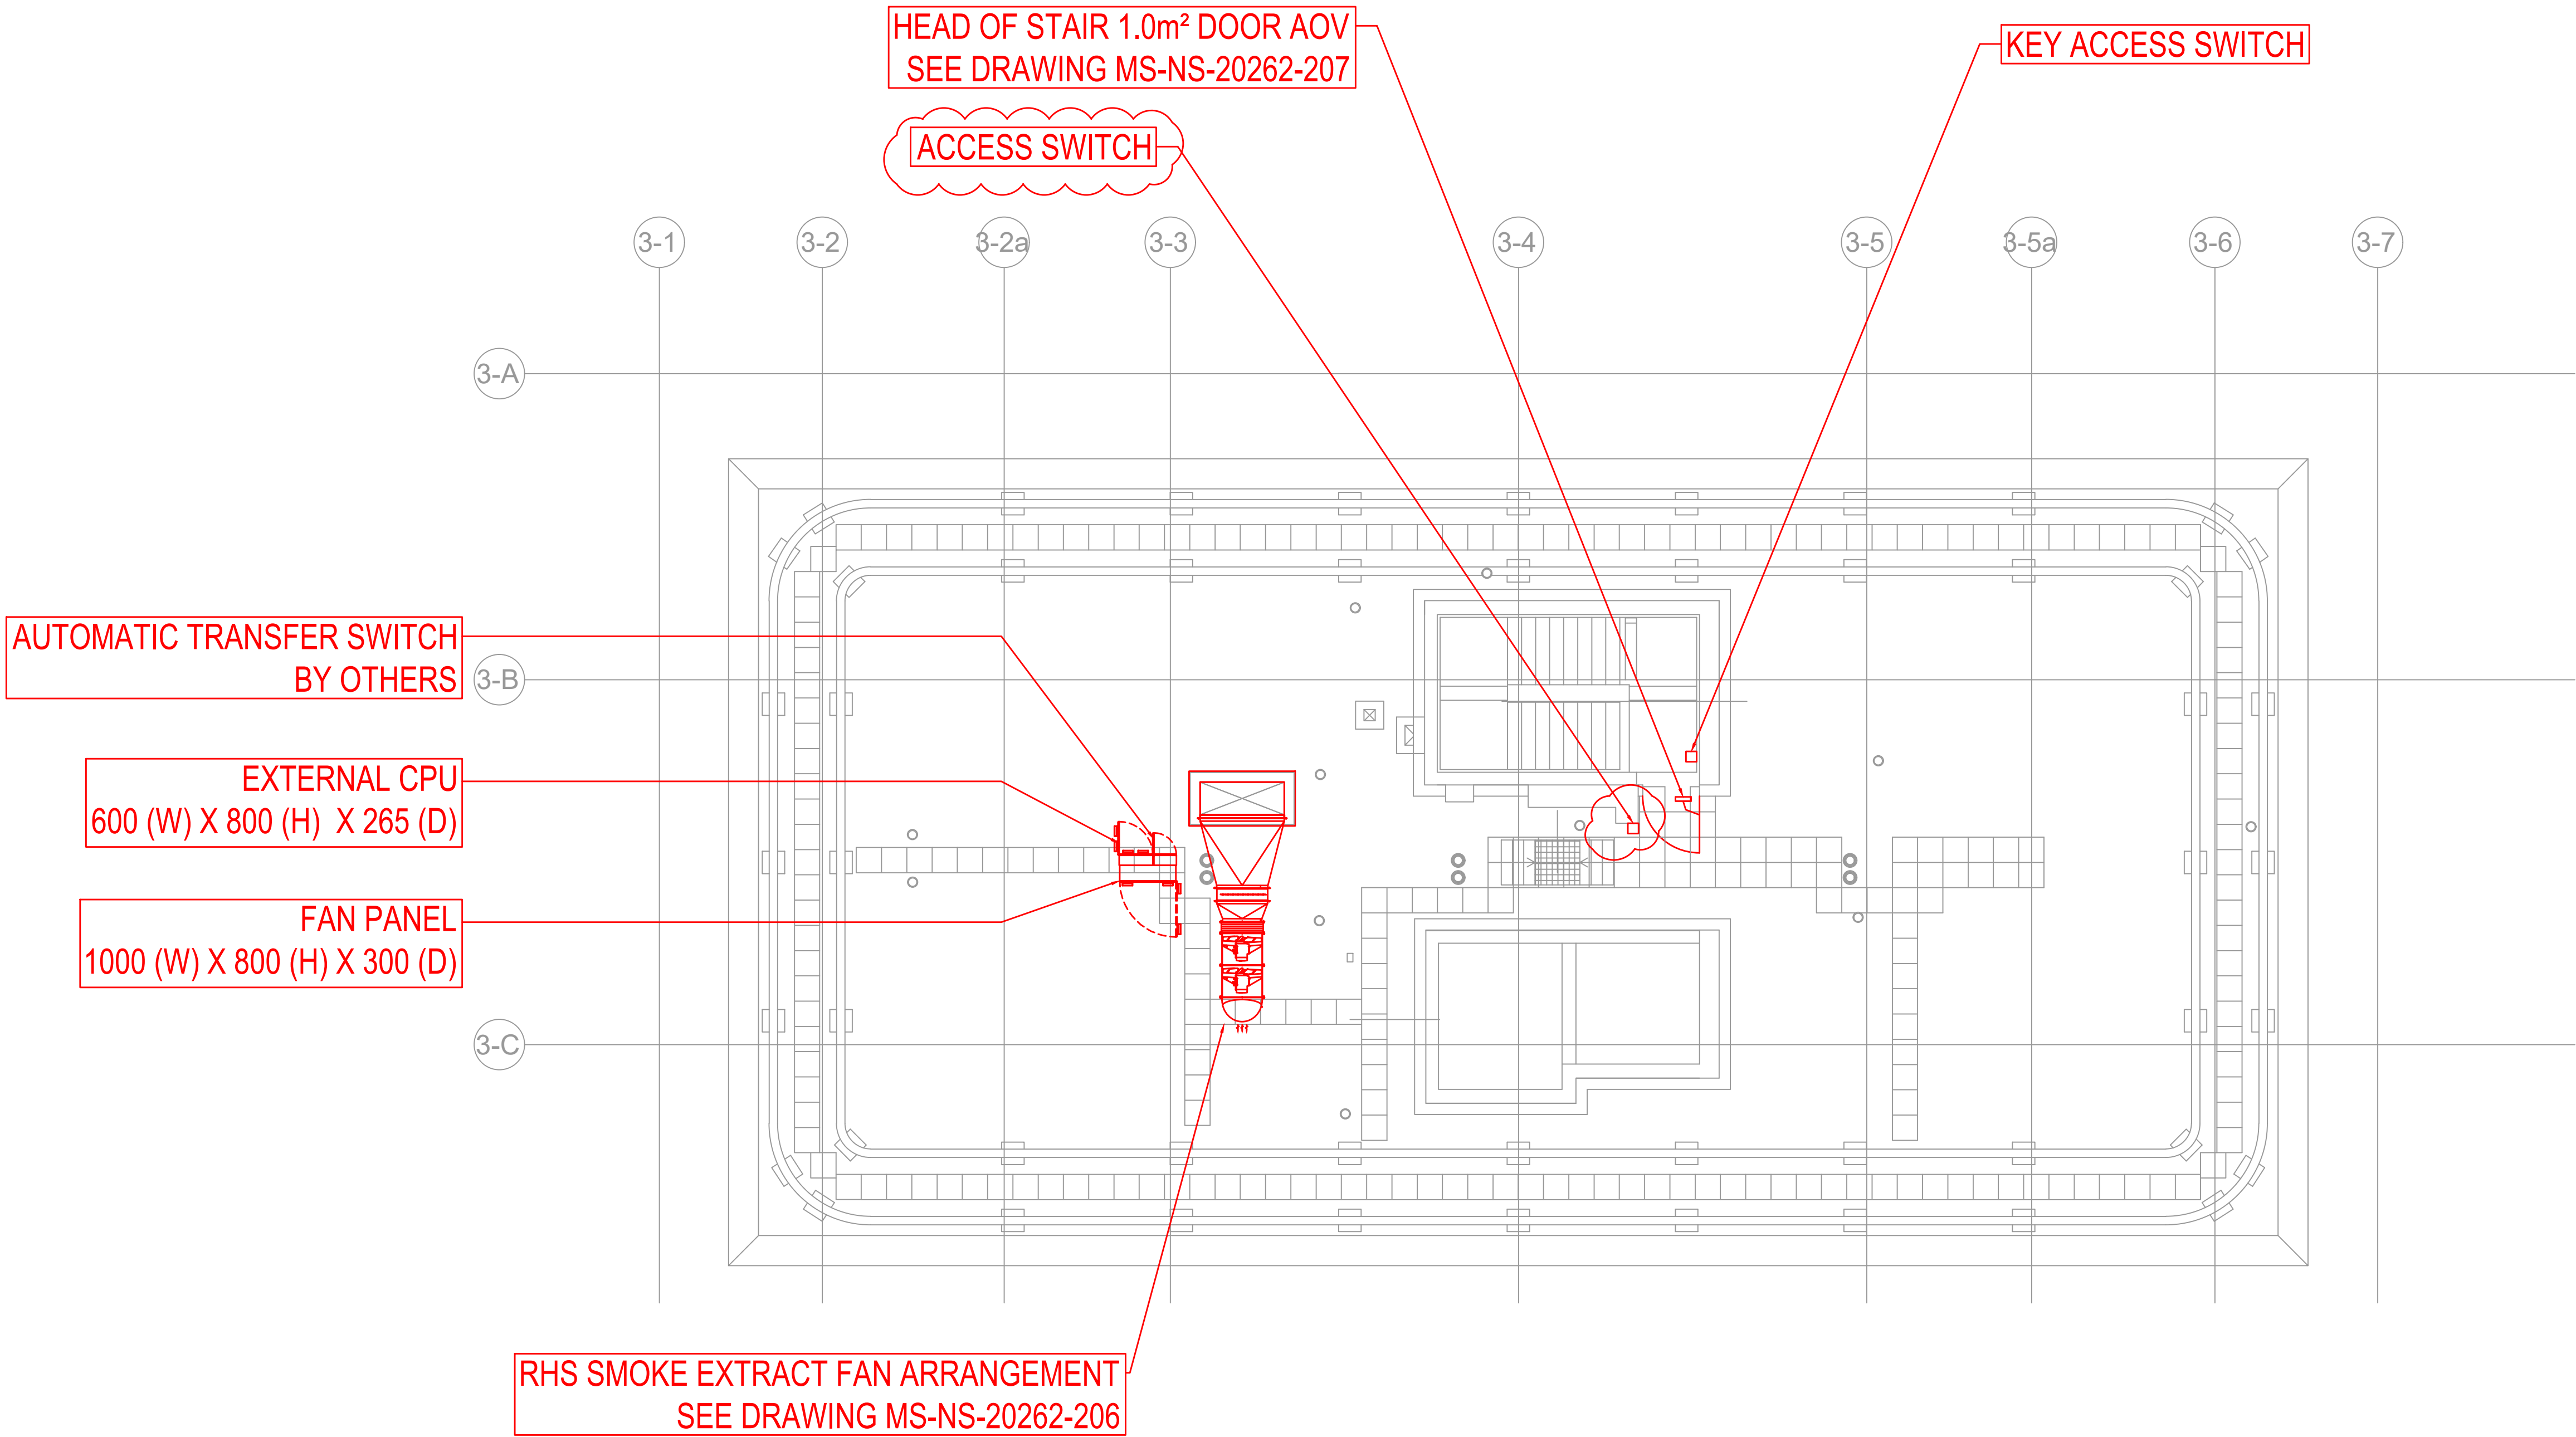

PLOT 3 ROOF

LAYOUT DETAIL TAKEN FROM:
1002-A-CTA-DRG-47-17-3017-T01

E	26.02.21	EXTERNAL ACCESS SWITCH ADDED	AJM	--
D	01.02.21	ADJUSTED FAN ARRANGEMENT & ADDED FAN CONTROLS	CP	RA
C	2020/01/01	HEAD OF STAIR VENT CHANGED TO DOOR AOV WITH ACCESS SWITCH	XM	AJM
B	20.01.20	P/S REMOVED	XM	AJM
A	22.10.19	FIRST ISSUE FOR APPROVAL	CIP	AJM
REV.	DATE	DETAILS	DRWCHK BY	BY

DRAWING REVISION DETAILS



VENT ENGINEERING
UNITS 16C & 16F,
CHALWYN INDUSTRIAL ESTATE
POOLE, BH12 4PE
TEL: +44(0)1202 744958 FAX: +44(0)1202 733026 www.vent.co.uk

ALL RIGHTS RESERVED. NO PART OF THIS DOCUMENT MAY BE REPRODUCED, STORED IN A RETRIEVAL SYSTEM OR TRANSMITTED IN ANY FORM OR BY ANY MEANS, ELECTRONIC, MECHANICAL, PHOTOCOPY, RECORDING OR OTHERWISE WITHOUT THE PRIOR WRITTEN PERMISSION OF VENT ENGINEERING.
© VENT ENGINEERING 2019

CLIENT
AMEON

PROJECT
ANGEL MEADOWS
PLOTS 2&3

SALES ORDER No.
TBC

DRAWING TITLE
PLOT 3
ROOF LAYOUT

DRAWING STATUS
☐ PRELIMINARY ☒ APPROVAL
☐ CONSTRUCTION ☐ AS BUILT
☐ INFORMATION ONLY

DRAWN BY DATE SCALE SHEET SIZE
CIP 22.10.19 1:75 A1

DRAWING No. REV
MS-NS-20262-153 E