


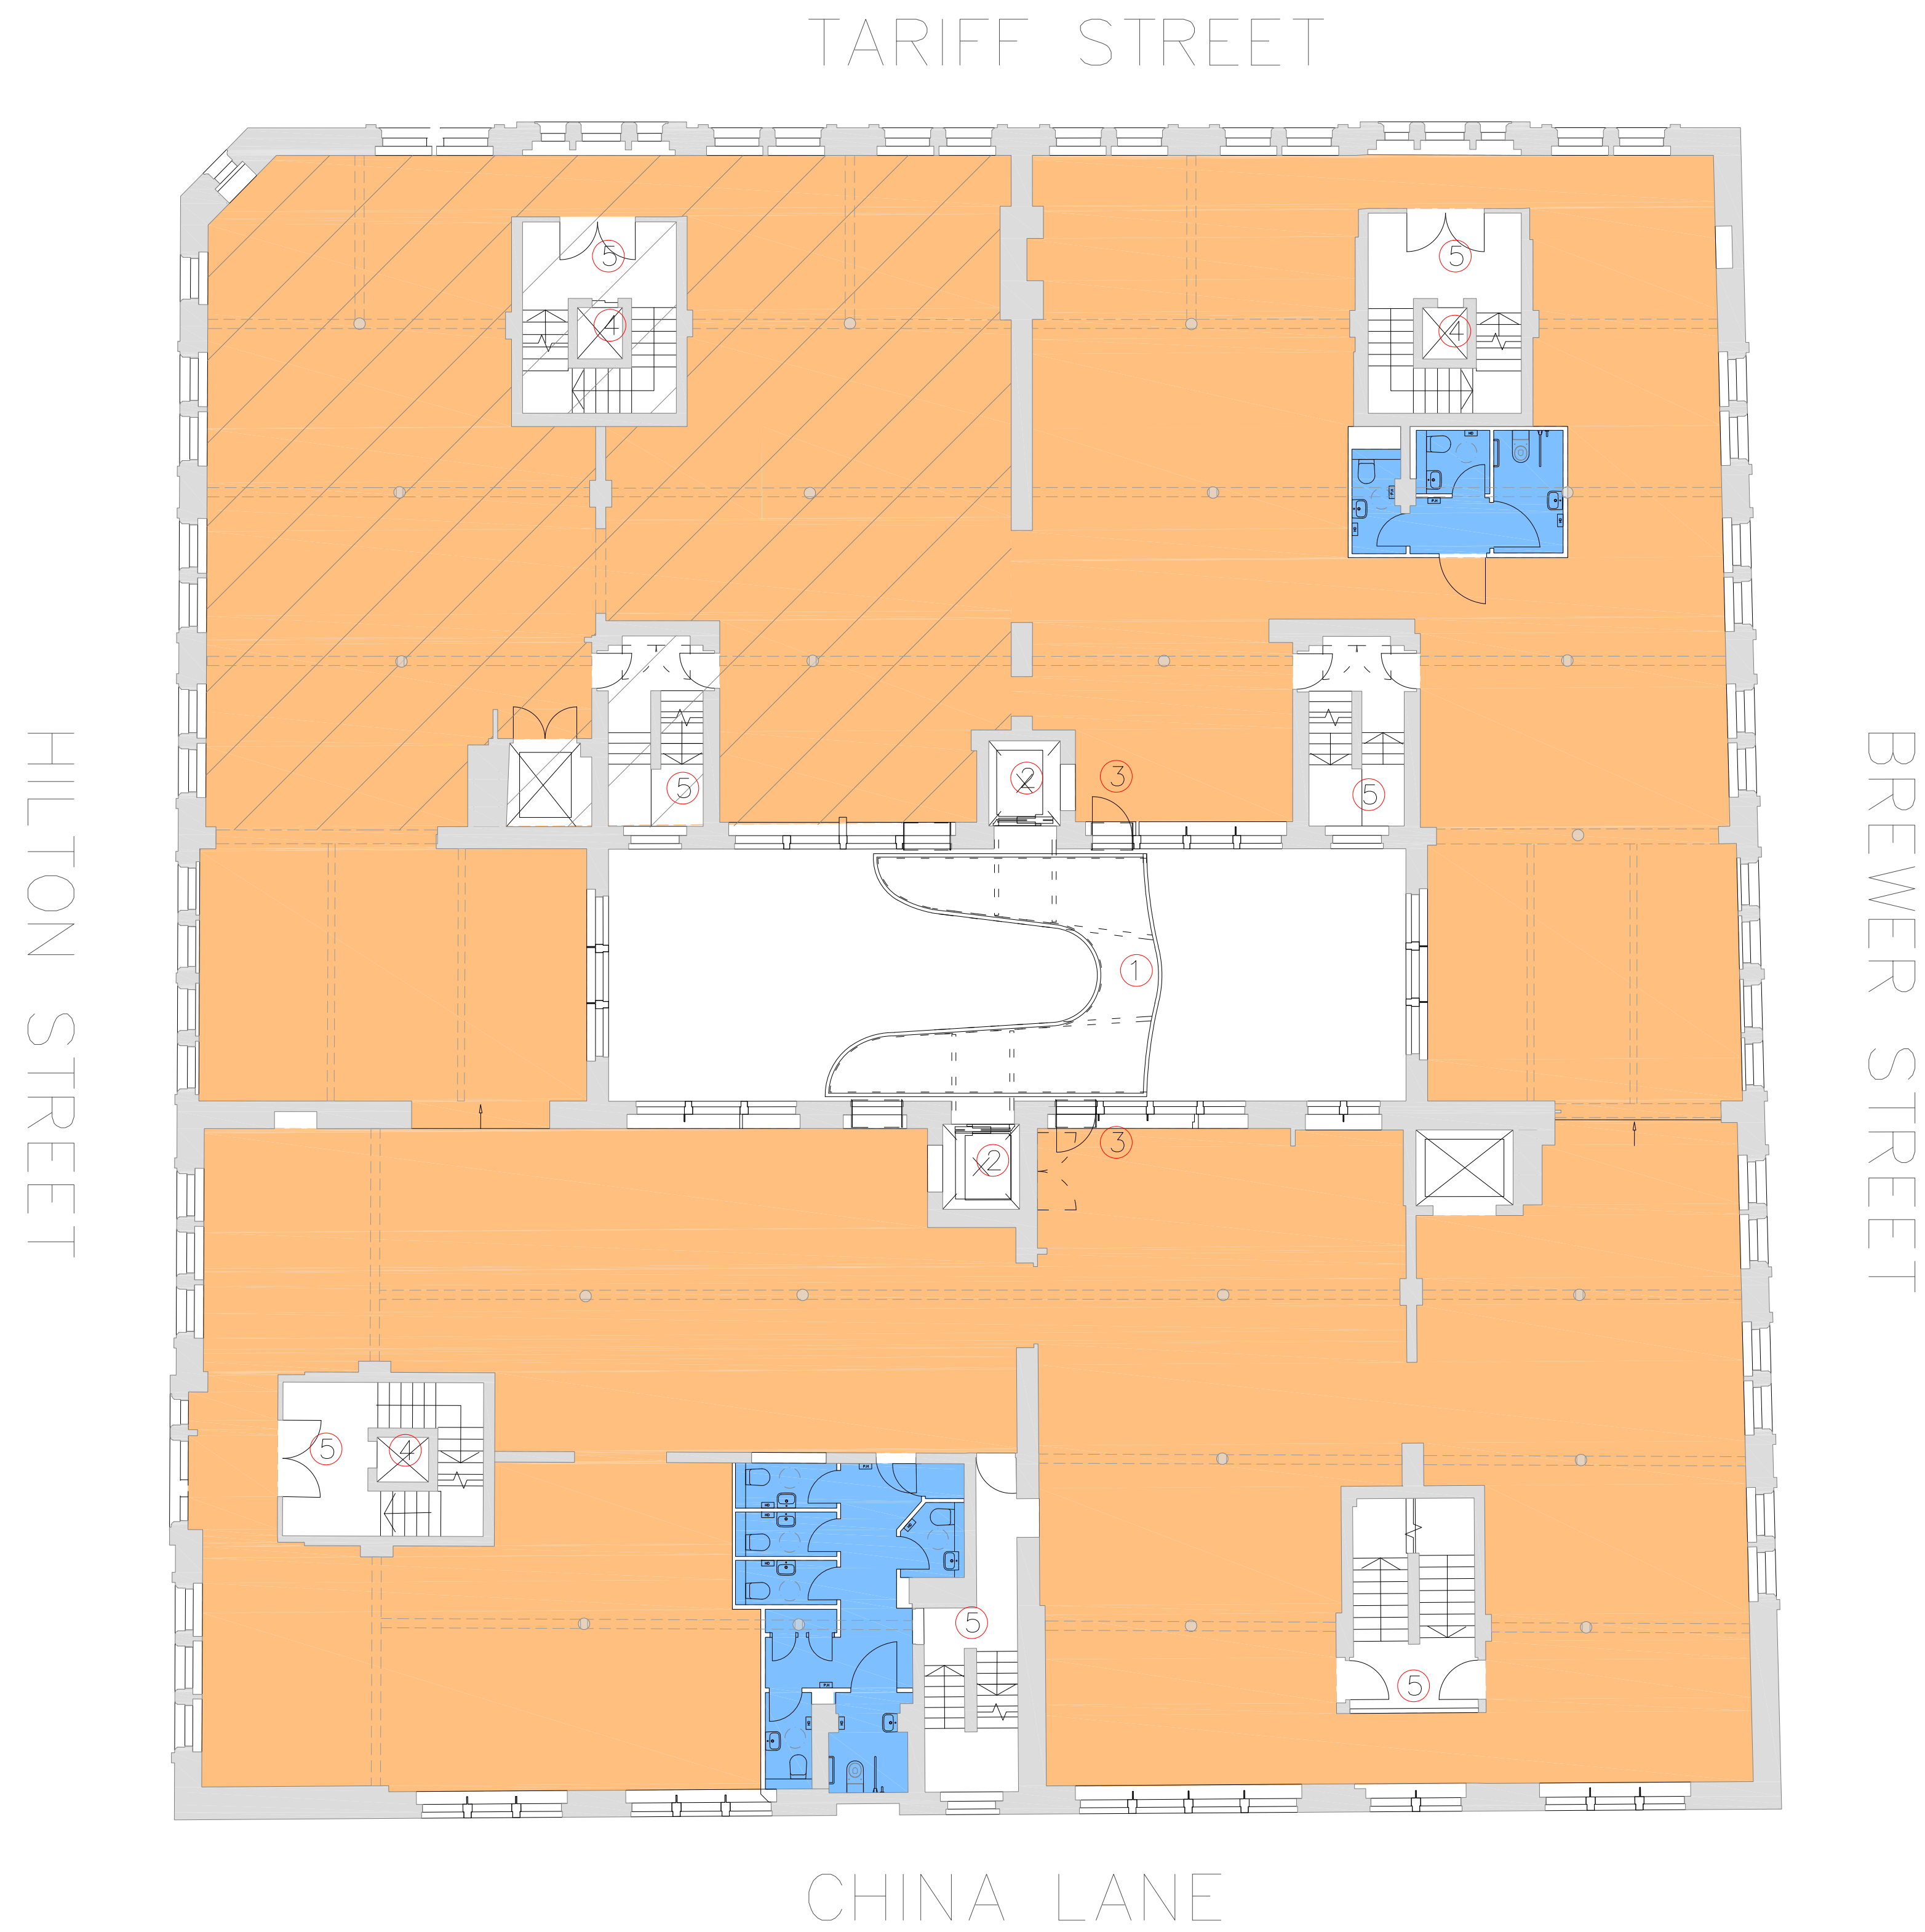

01 GENERAL ARRANGEMENT PLAN
Scale 1:100

NOTES: © TMT 2019

Copyright of this drawing is vested in the Contractor and it must not be copied or reproduced without consent.

All dimensions are in Millimeters (mm) unless indicated. Contractor to check all dimensions prior to commencing work onsite & adopt responsibility for dimensional accuracy prior to works.

Drawing to be read in conjunction with all relevant information. Any discrepancies found between information on this drawing, given elsewhere or recorded onsite shall be reported to the Contractor immediately.

DO NOT SCALE FROM THIS DRAWING...
If unsure ask!

PLAN NOTES

OFFICE SPACE

TOILETS

1 BRIDGE LINK

2 NEW LIFT

3 NEW ENTRANCE DOORS FROM BRIDGE.
(WITHIN EXISTING WINDOW FRAME)

4 RISER (IN REDUNDANT GOODS LIFT SHAFT)

5 ESCAPE STAIR

rev.	description.	by.	checked.	date.
------	--------------	-----	----------	-------

client logo:

client
Savills

project
Fourways First Floor

stage
6 - As Built

drawing title
General Arrangement Plan

drawing no.	date	scale	rev.
ID-GA-1F-00-01	19-Mar-2020	1:100 @ A1	-

