





Proposed Elevations - North
1 : 50



Proposed Elevations - South
1 : 50

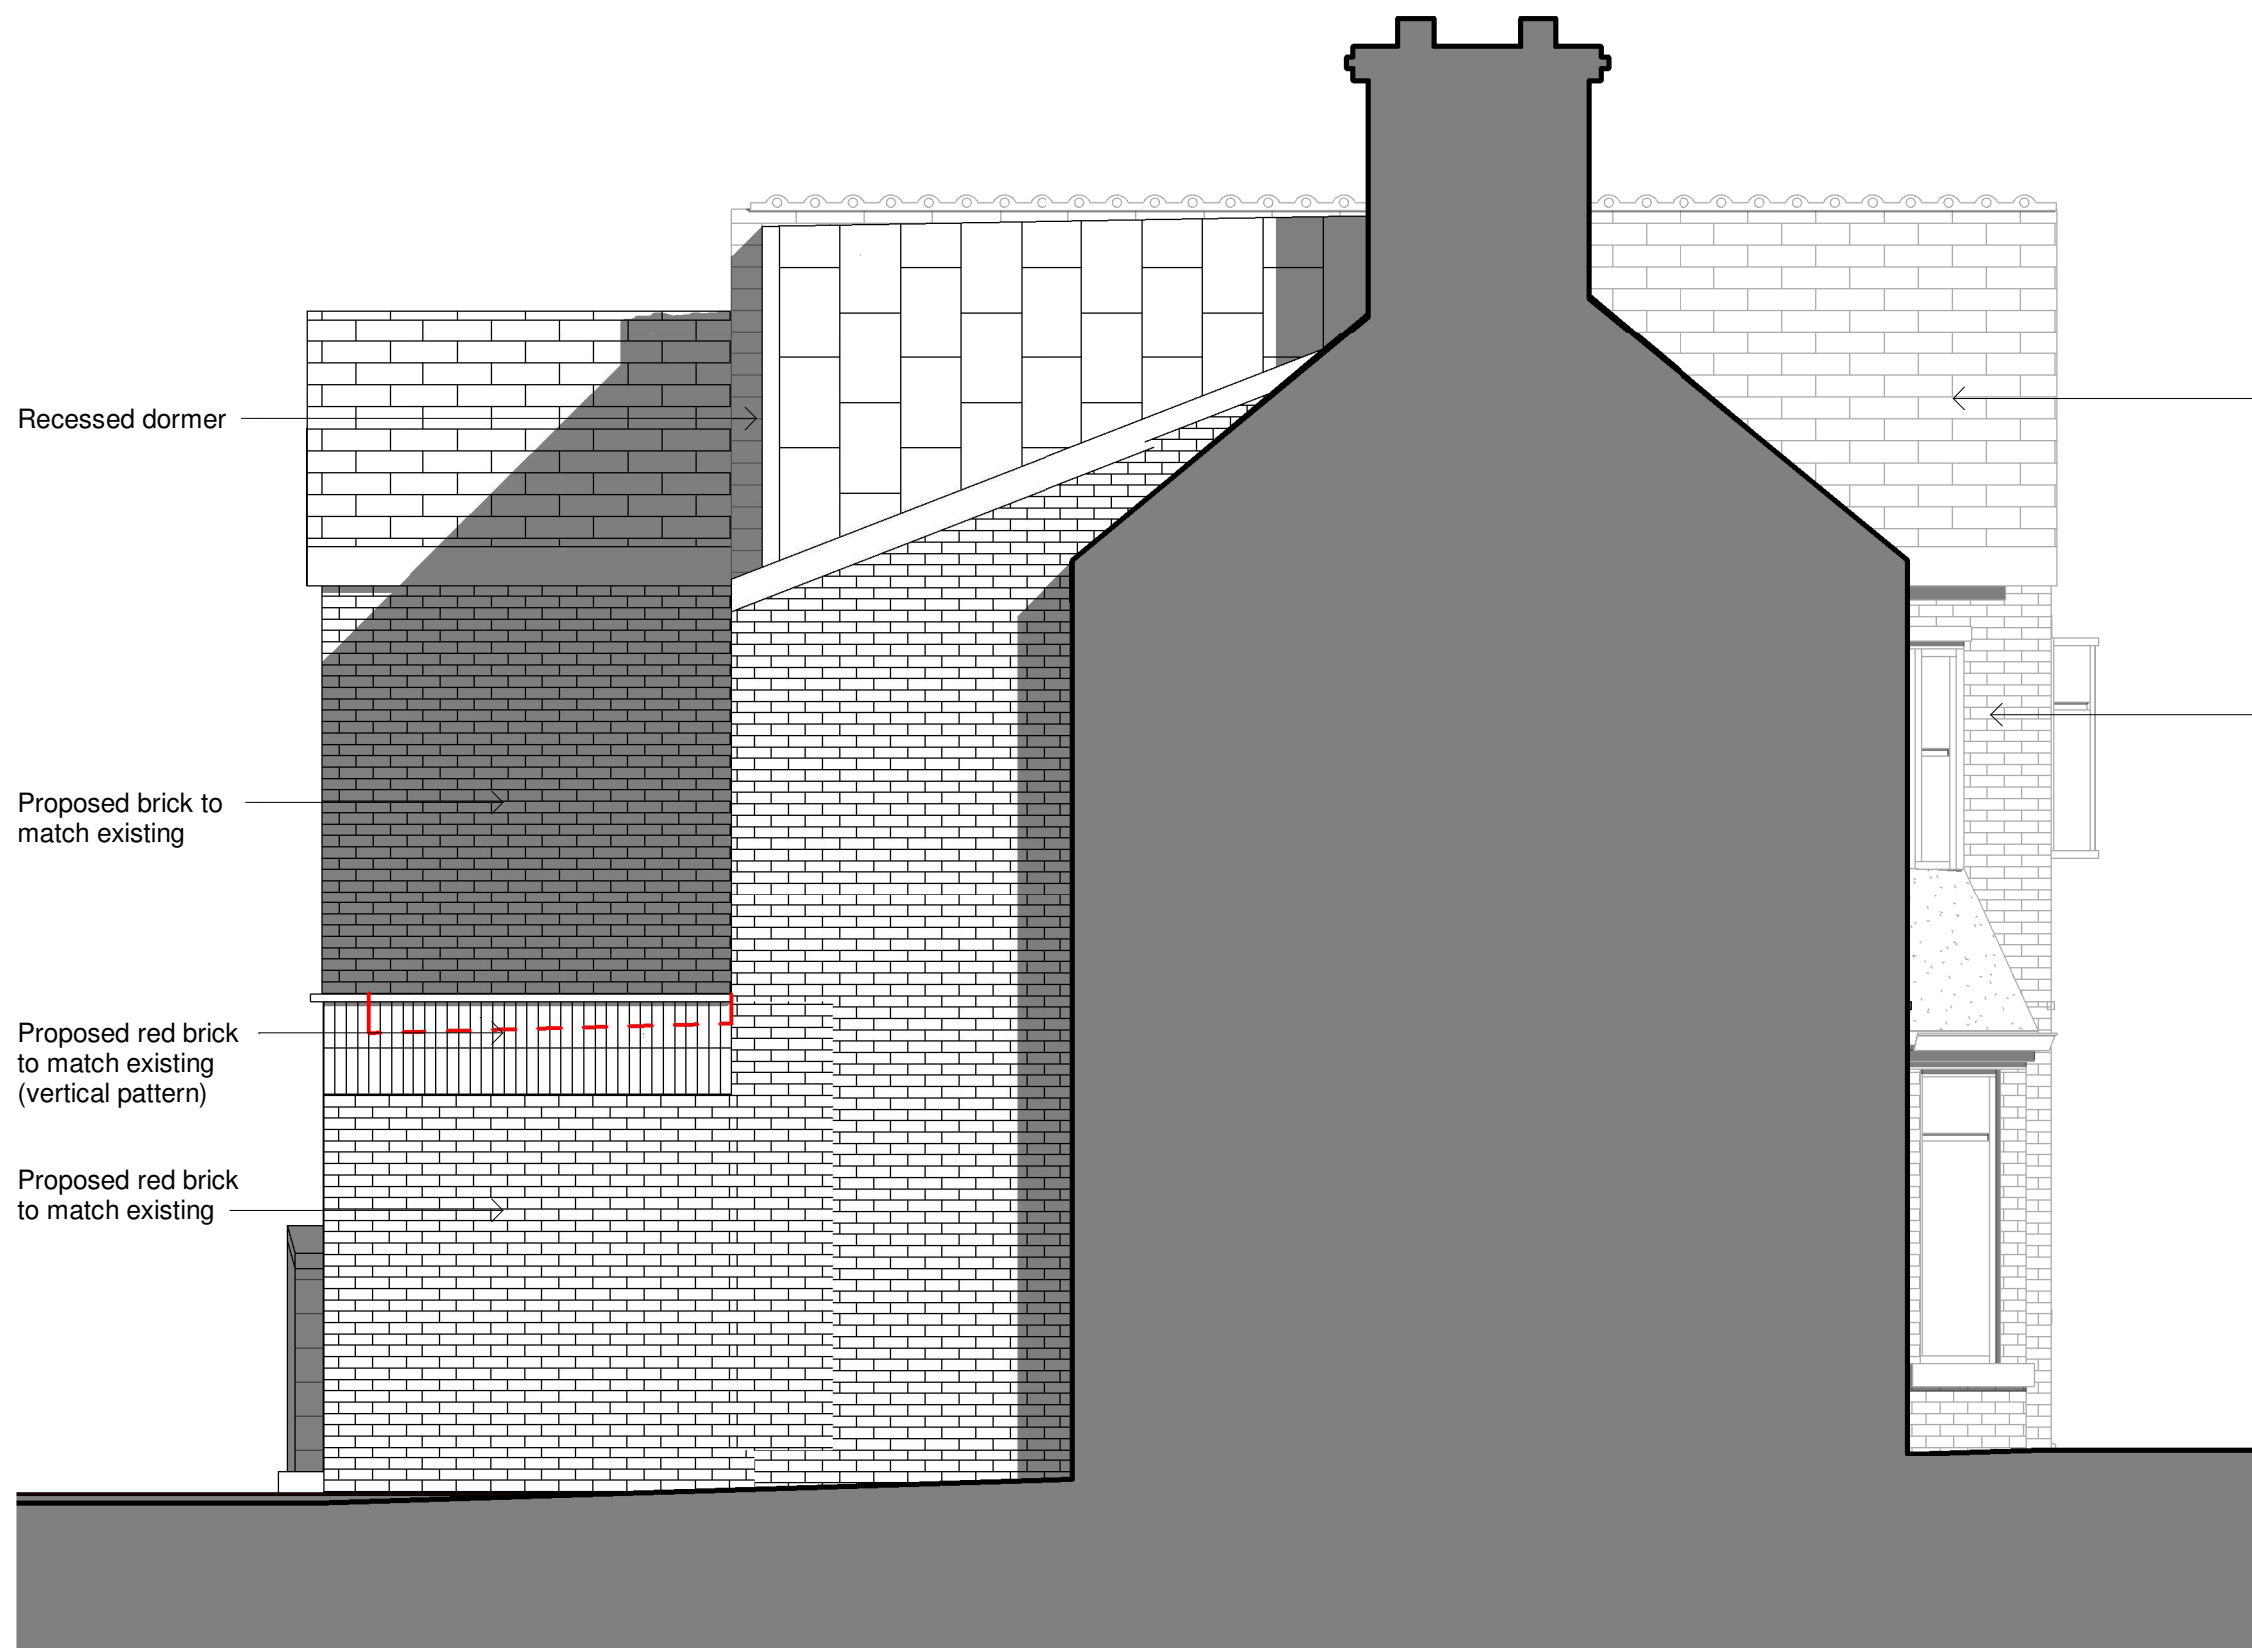

Proposed Elevations - West
1 : 50

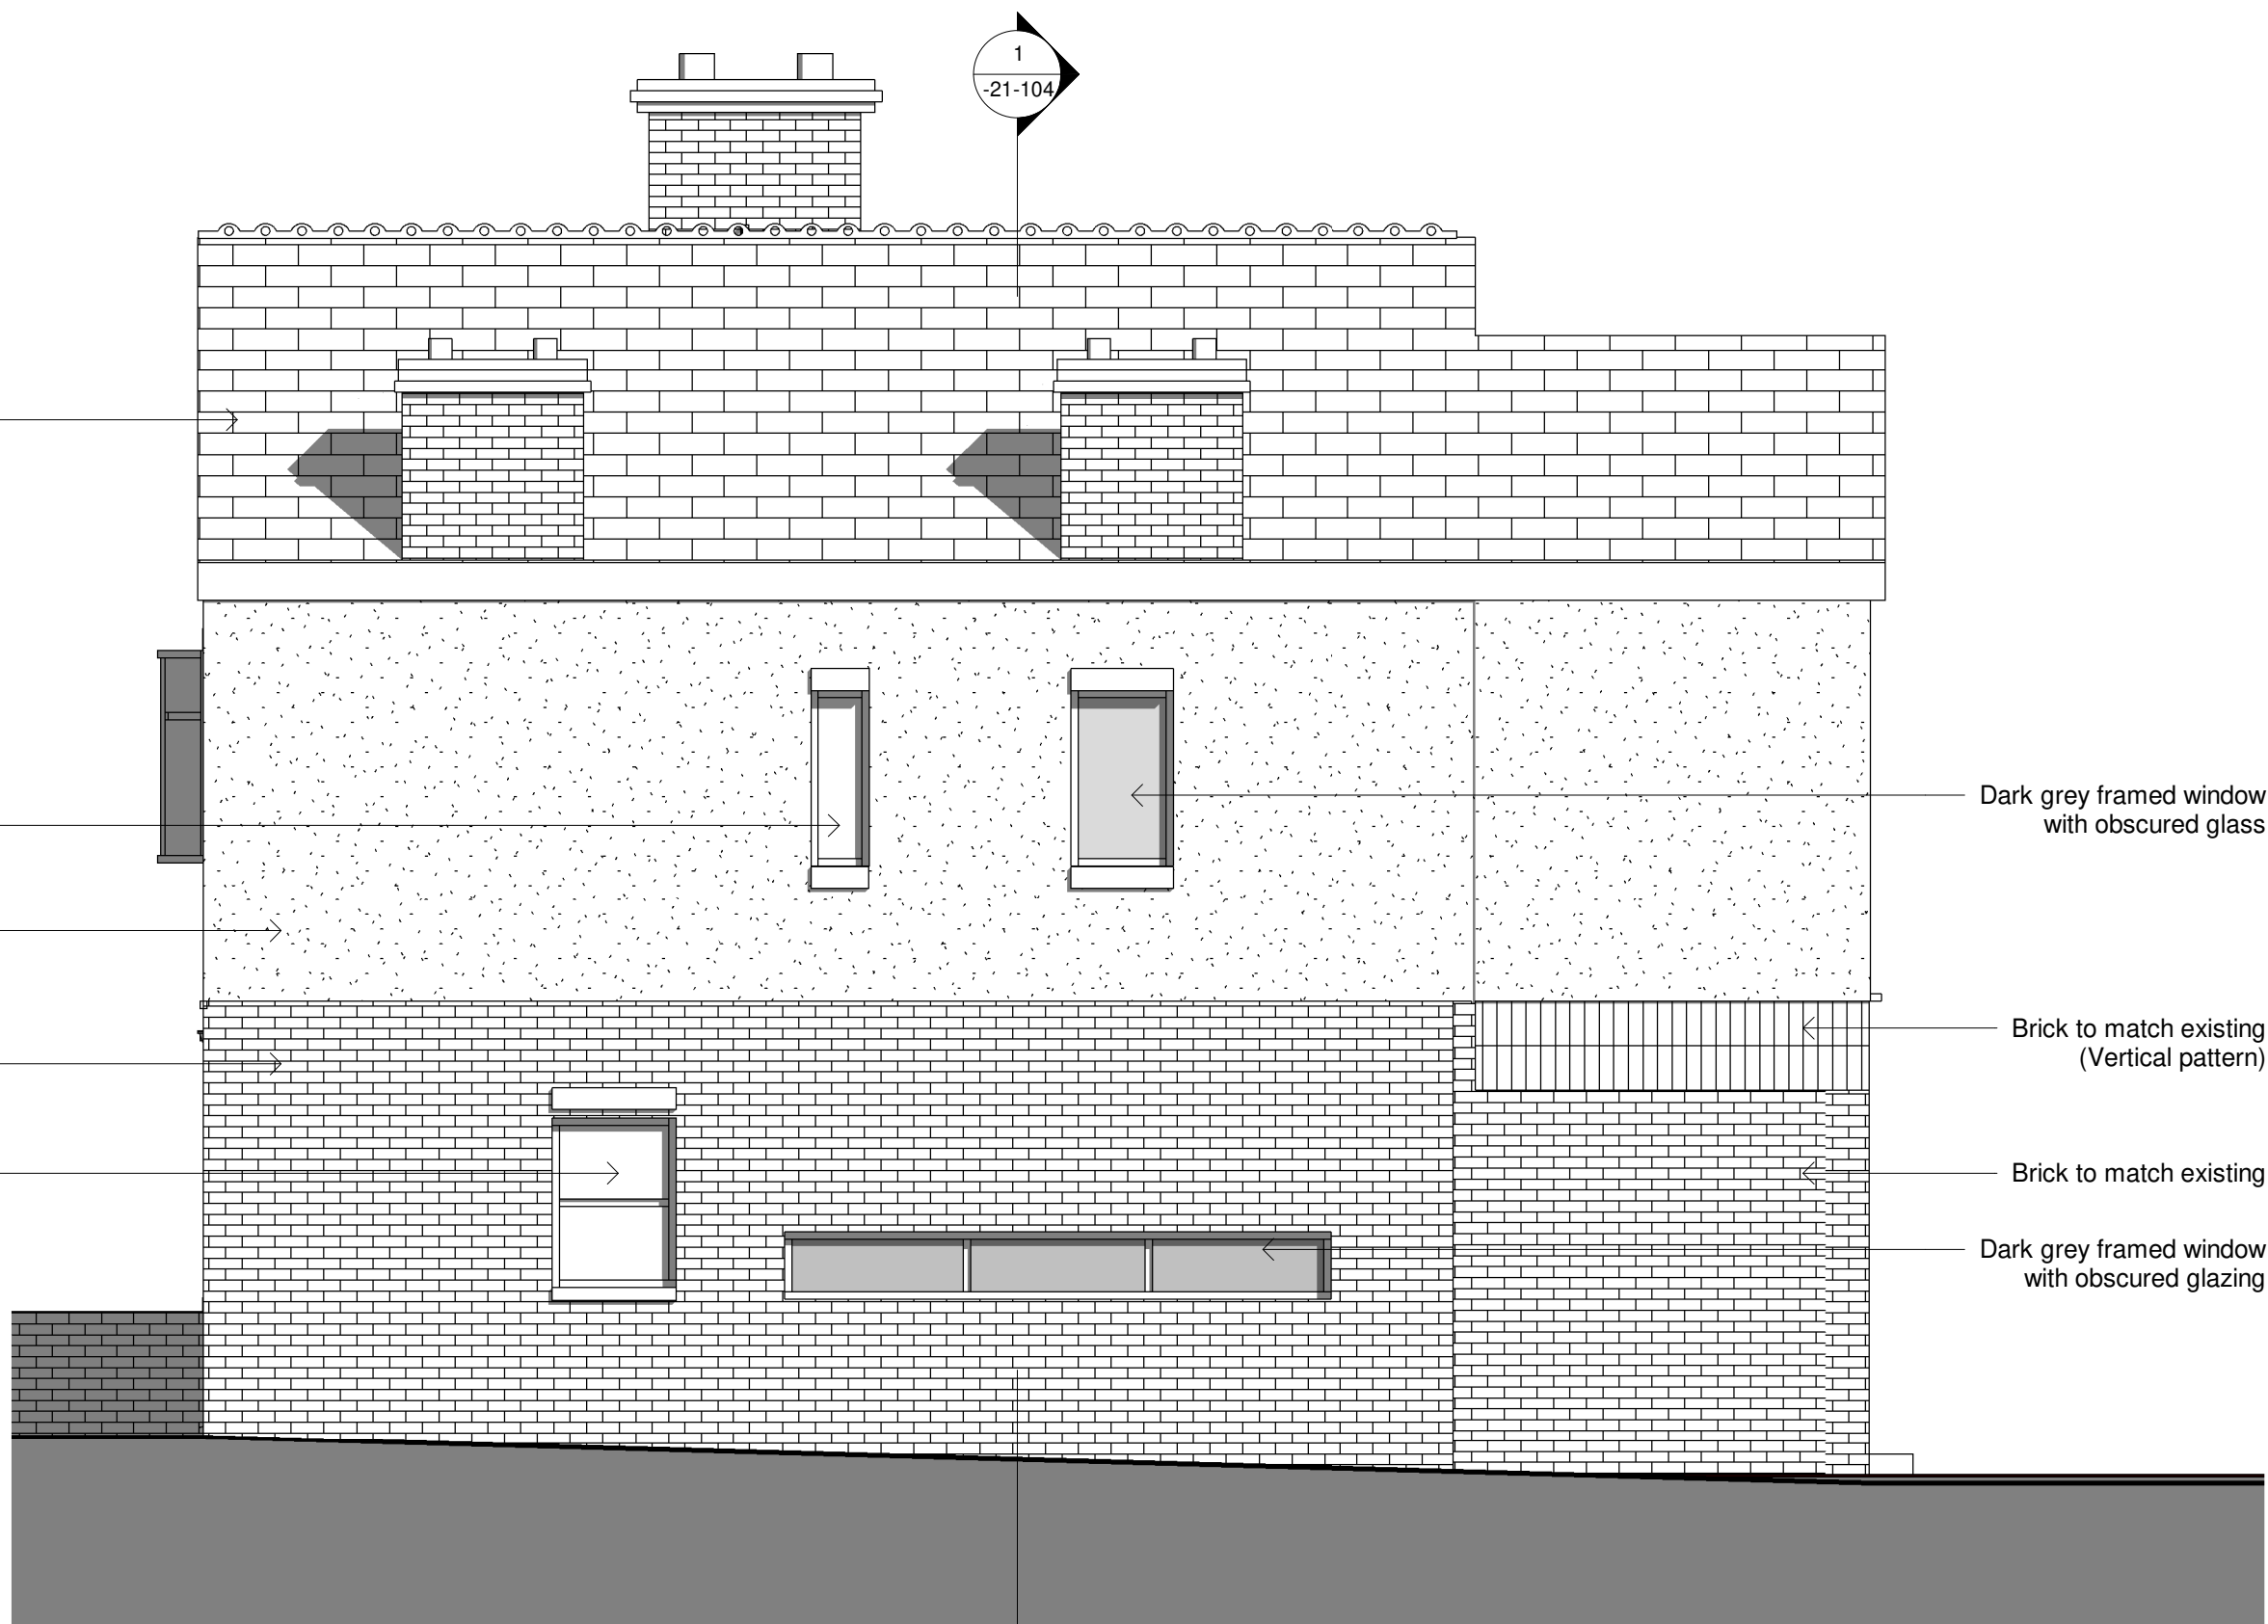

Proposed Elevations - East
1 : 50



The contractor must verify all dimensions on site before commencing any work or fabrication drawings. If this drawing exceeds the quantities taken in any way GTA North are to be informed before the work is initiated. Only figured dimensions are to be taken from this drawing. Do not scale off this drawing. Drawings are based on Ordnance Survey and / or existing record drawings - design and drawing content is subject to detailed Site Survey, Structural Survey, Site Investigations, Planning and Statutory Requirements and Approvals. Authorised reproduction from Ordnance Survey Map with permission of the Controller of Her Majesty's Stationary Office. Crown Copyright reserved. GTA North Limited Copyright. Guy Taylor Associates is a trading name of GTA North Limited.

Drawing Notes:

PLANNING REF.: 128984 - 7 OF 8 - (REV 03)

Rev	Description:	Revised By:	Issue Date:
P1	Planning Issue	VK	21/12/20
P2	Planning Issue	AM	18/01/21
P3	Planning Issue	AM	13/05/21

Project:
2 GLENCROSS AV,
CHORLTON,
M21 9NF

Drawing Title:
PROPOSED ELEVATIONS

Scale: 1 : 50@A1	Original Issue Date:
Original Drawn By: VK	Original Checked by: CR

Drawing Number:	Revision:
20-0010-128984 - 7 OF 8	P3

Reason For Issue:
PLANNING

Trafalgar House
5-7 High Lane, Chorlton, Manchester M21 9DJ
T: 0161 826 1042 M:07914 402 101
manchester@guytaylorassociates.co.uk
www.guytaylorassociates.co.uk

GUY
TAYLOR
ASSOCIATES