
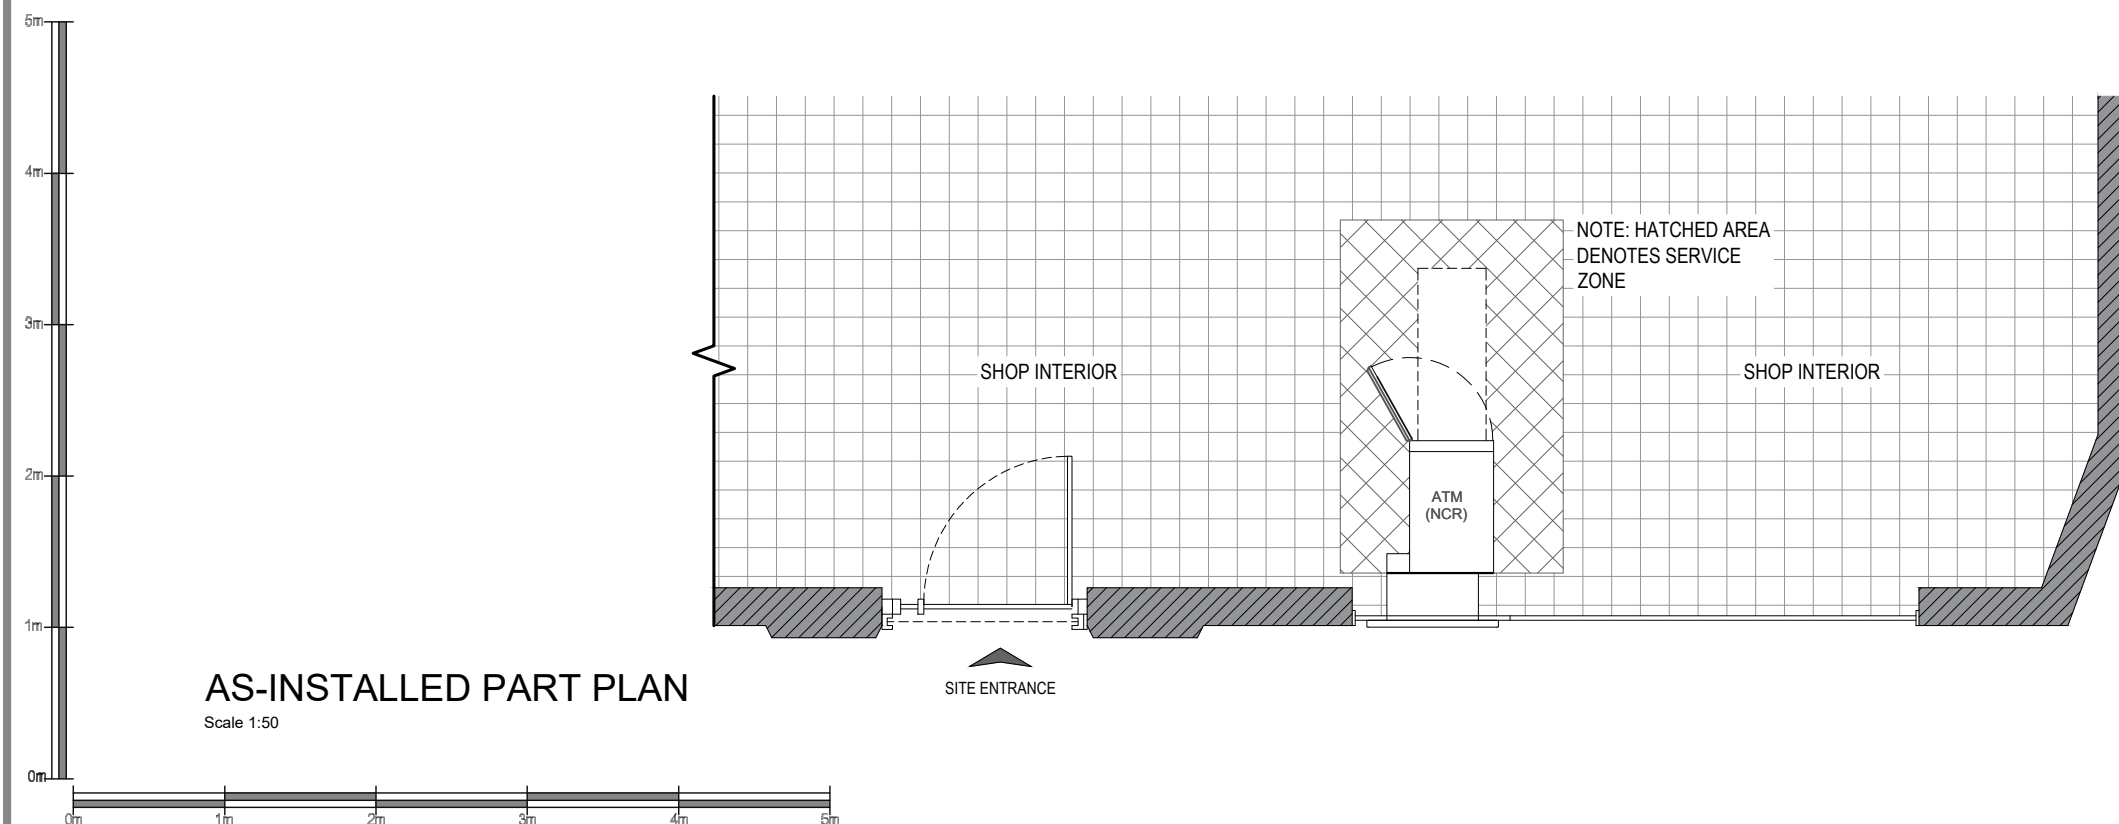


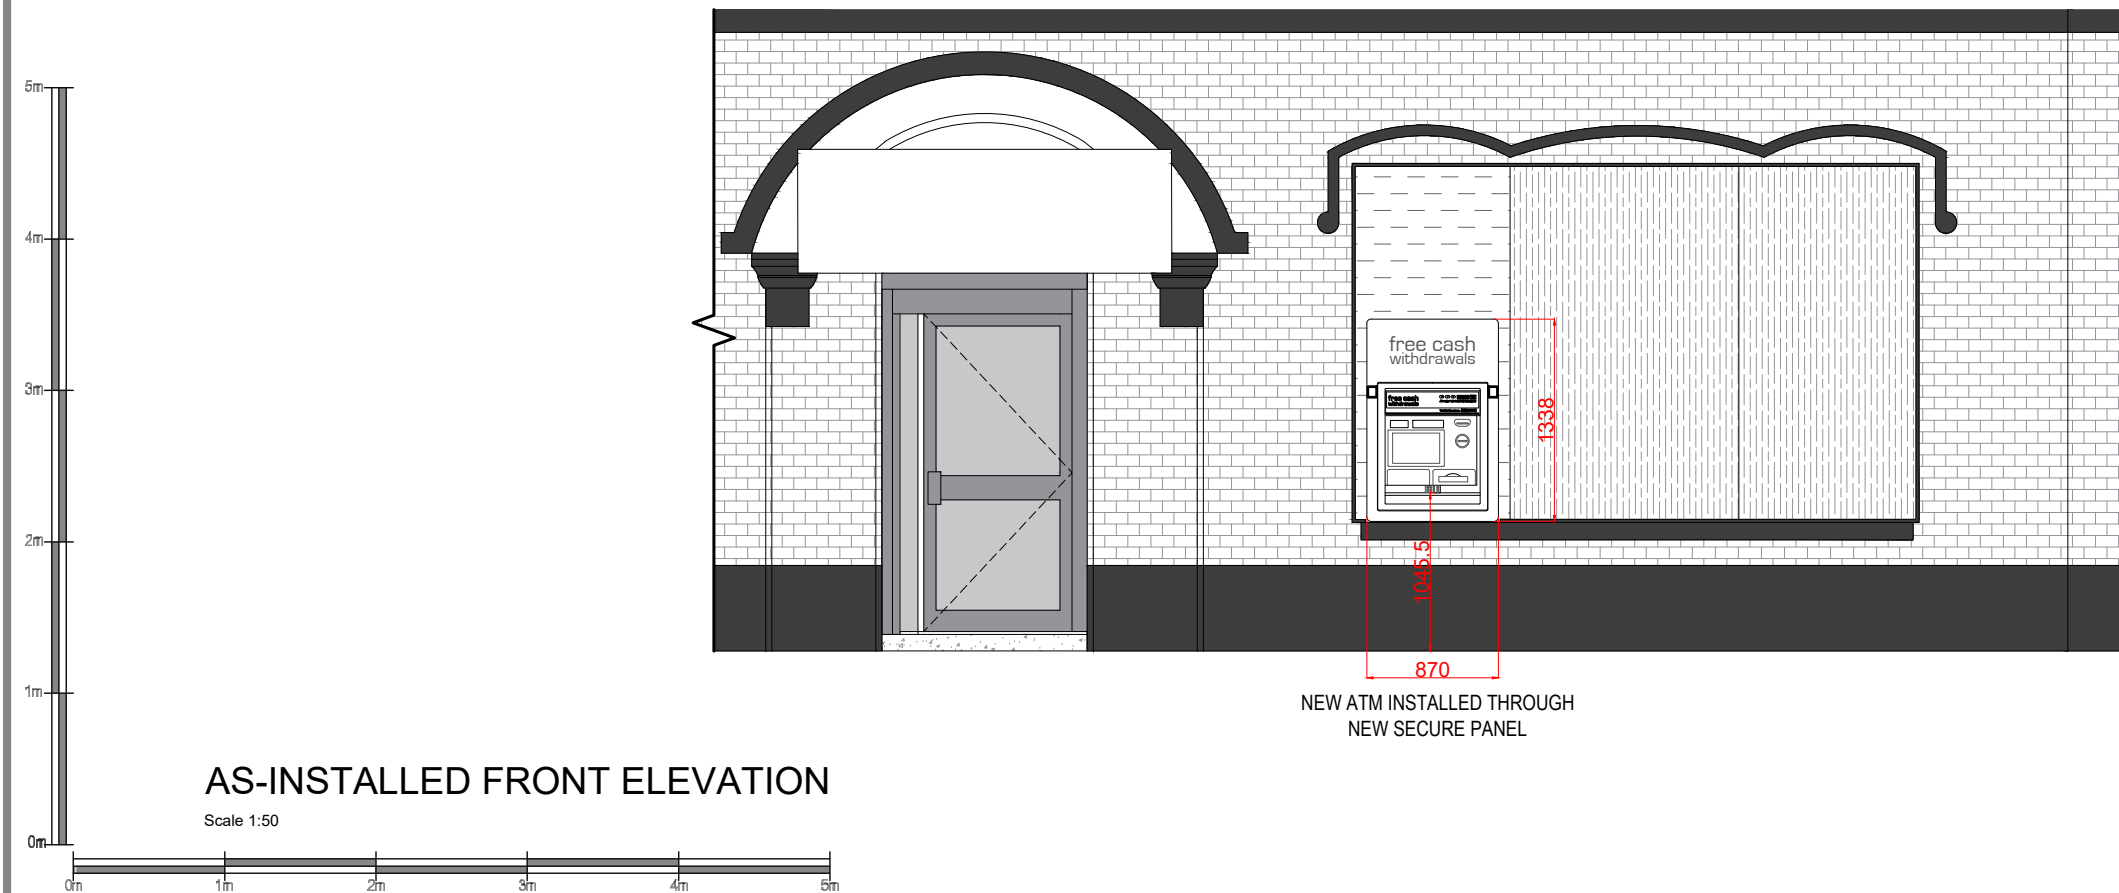

Date:	Comments:	By:
-------	-----------	-----

1) All dimensions in millimeters unless otherwise stated.

Site:
Premier Gorton Lane Express,
548 GORTON LANE,
MANCHESTER,
M18 8EH

Drawing Title:

As-Installed Plan and Elevation

Ref: T020894_AI	Date: 10/05/2022	Rev:
Scale: 1:50	Paper: A3	Date Rev: