


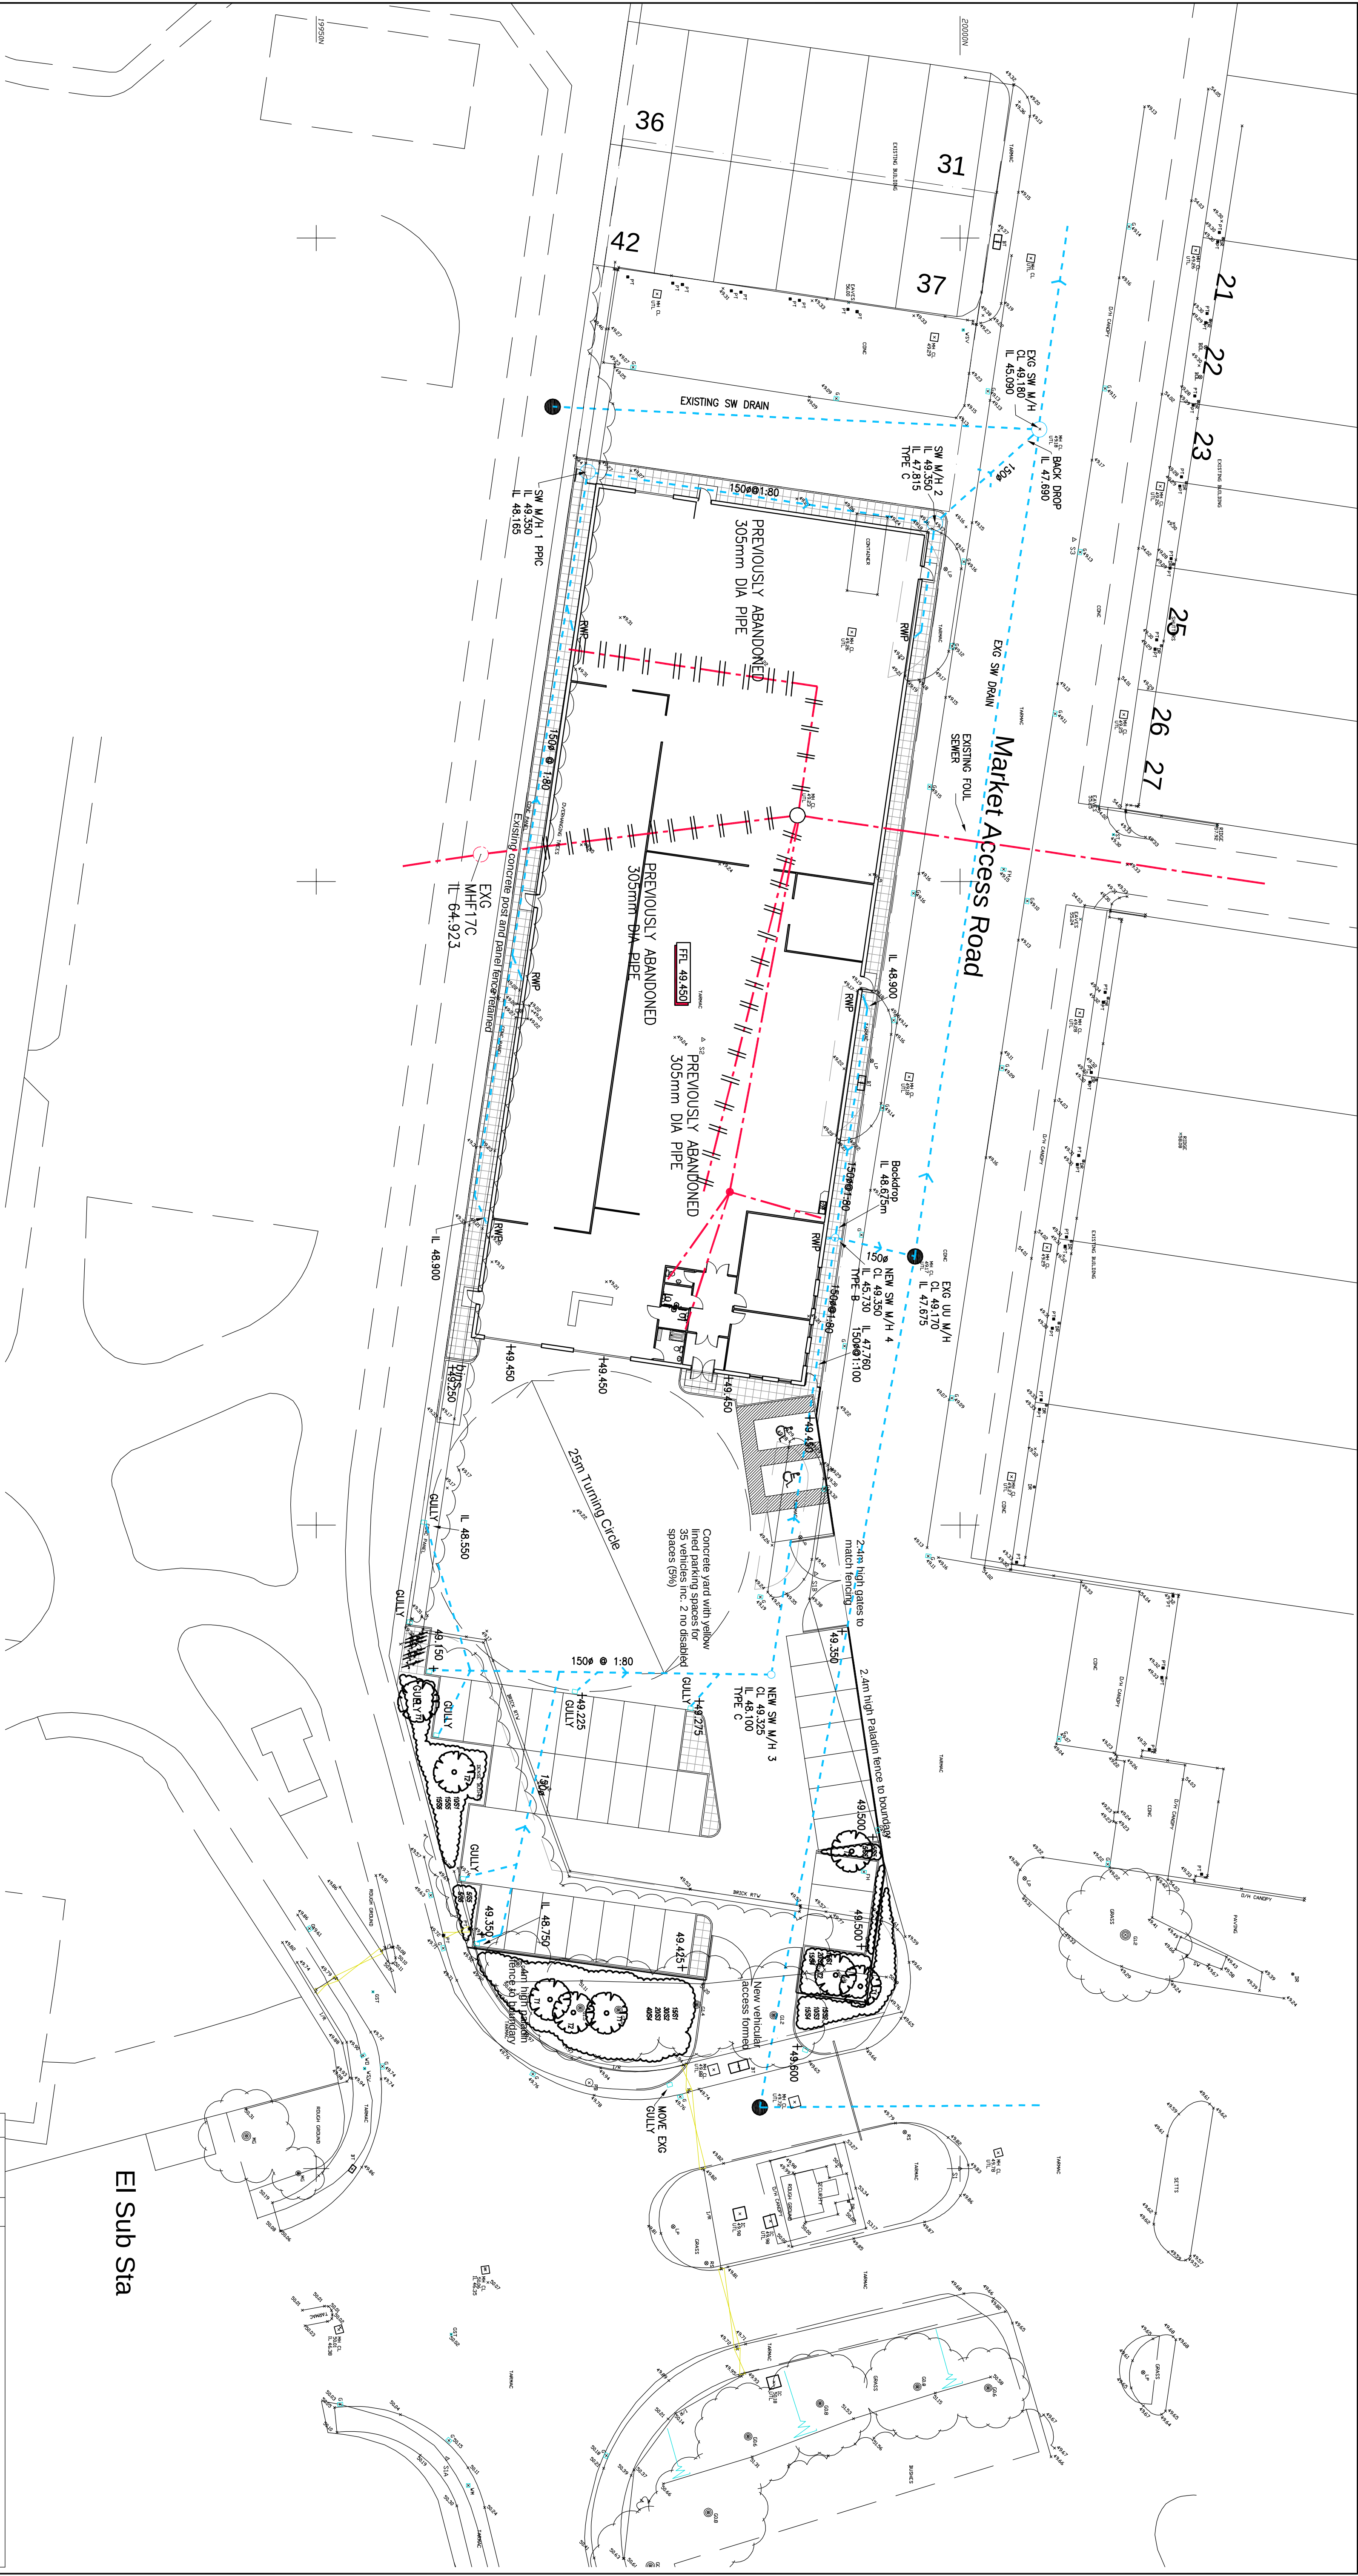

THIS DRAWING TO BE READ IN CONJUNCTION WITH HEALEY CONSULTING INTERNAL BUILDING DRAINAGE DRAWING 006

RECORD COPY
THIS DRAWING USED FOR CONSTRUCTION INCORPORATING AMENDMENTS AS KNOWN AMENDMENTS ARE LISTED IN THE REVISION BOX

C	10.01.08	P.L.	RECORD COPY
B	04.10.07	M.B.	Building internal drainage removed and shown on Dwg 006 instead
A	19.07.07	p.m.h.	Additional internal drainage added
REV	DATE	BY	DETAILS OF REVISION

ARCHITECT / CLIENT				PROJECT NO.			
RUSSELLS CONTRACTORS LTD				07271			
MANCHESTER WHOLESALE FLOWERS				DRAWING NO.			
NEW SMITHFIELD MARKET				D0001			
MANCHESTER				REVISION			
				C			
TITLE				DRAWN BY			
DRAINAGE				PMH			
G.A. PLAN				DATE			
				12.07.07			
				SCALE			
				1:200			

HEALEY CONSULTING
Brunel House
63 Dale Street
M1 1JH
Tel: 01706 343961
Fax: 01706 343961
email: office@healeydown.co.uk
copyright: Healey Consulting

