




REVISION	DATE	DESCRIPTION
-	28.08.15	DRAFT STAGE 3 ISSUE
A	04.09.15	STAIR DETAIL ADJUSTMENTS STAGE 3 ISSUE
B	16.09.15	GROUND FLOOR INSULATION AMENDED
C	15.04.15	WALL BLD UP AMEND. ASHP, SPEC ADDED
D	20.05.16	CAPPINGS AMENDED & RAL COLOUR INDICATED
E	10.06.16	MINOR STEELWORK & LANDING ADJUSTMENTS
F	01.02.17	STEELWORK ADJUSTED
G	03.09.18	AS BUILT ISSUE

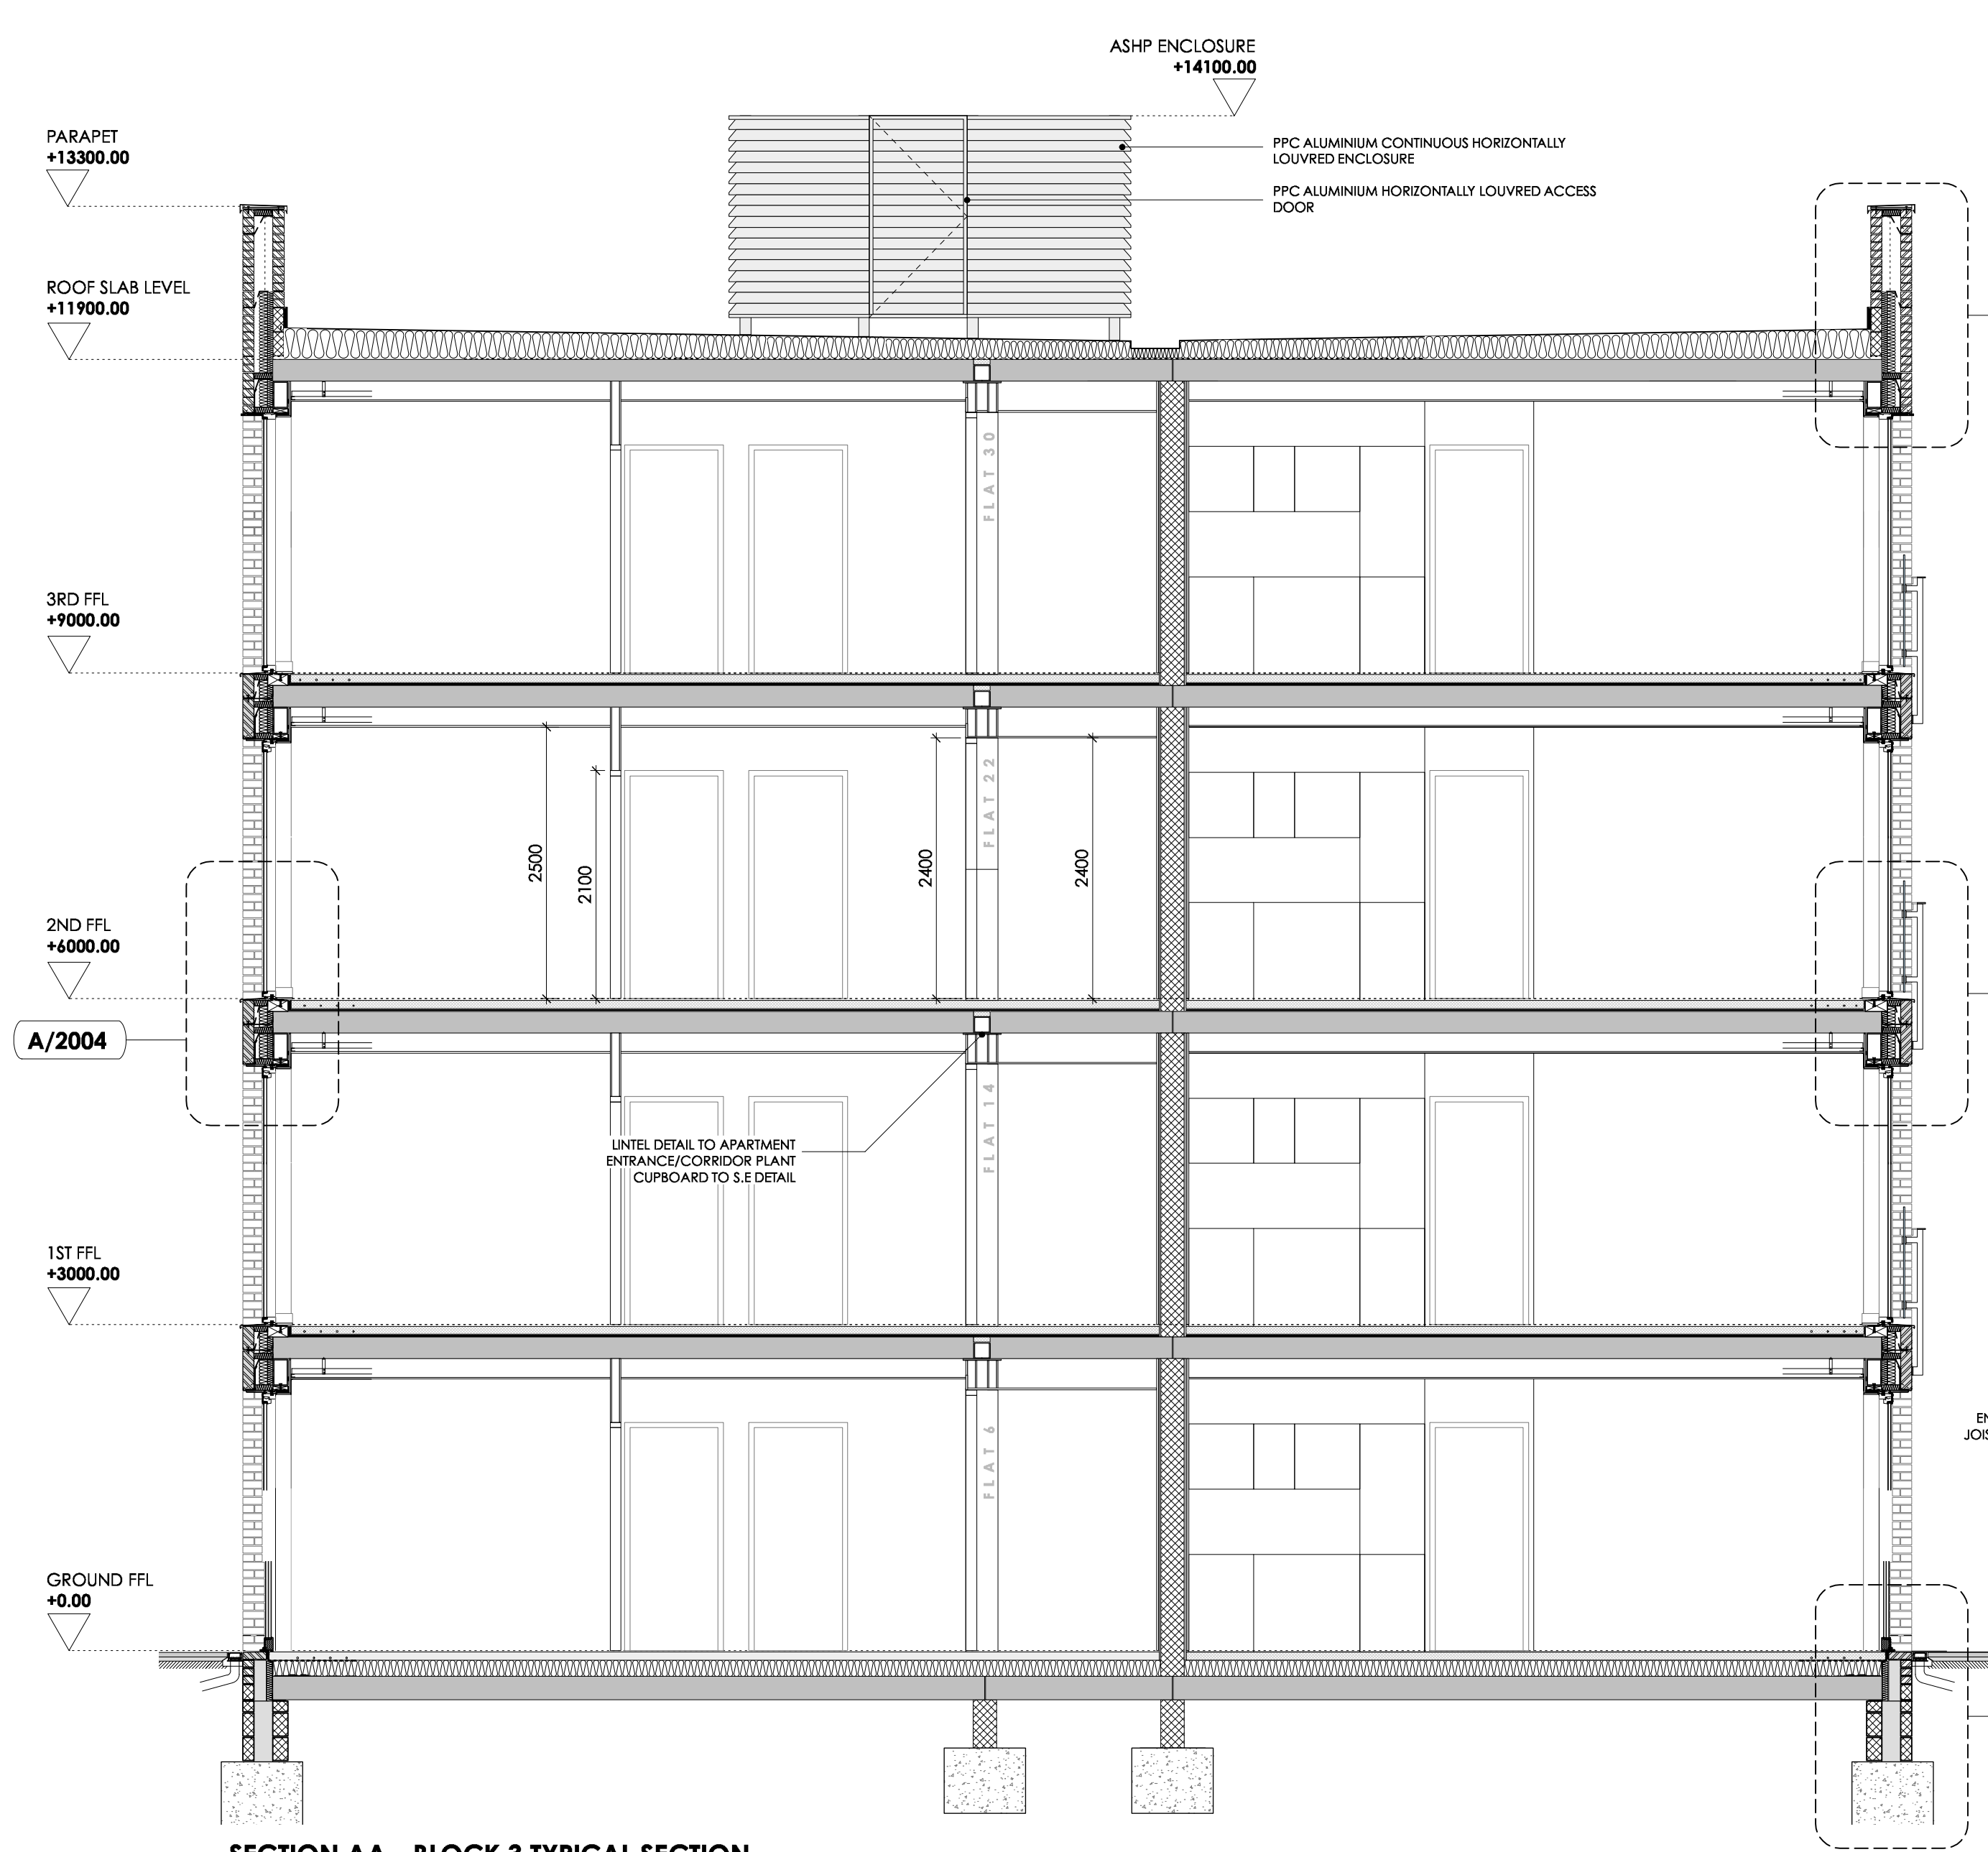

SECTION AA - BLOCK 3 TYPICAL SECTION

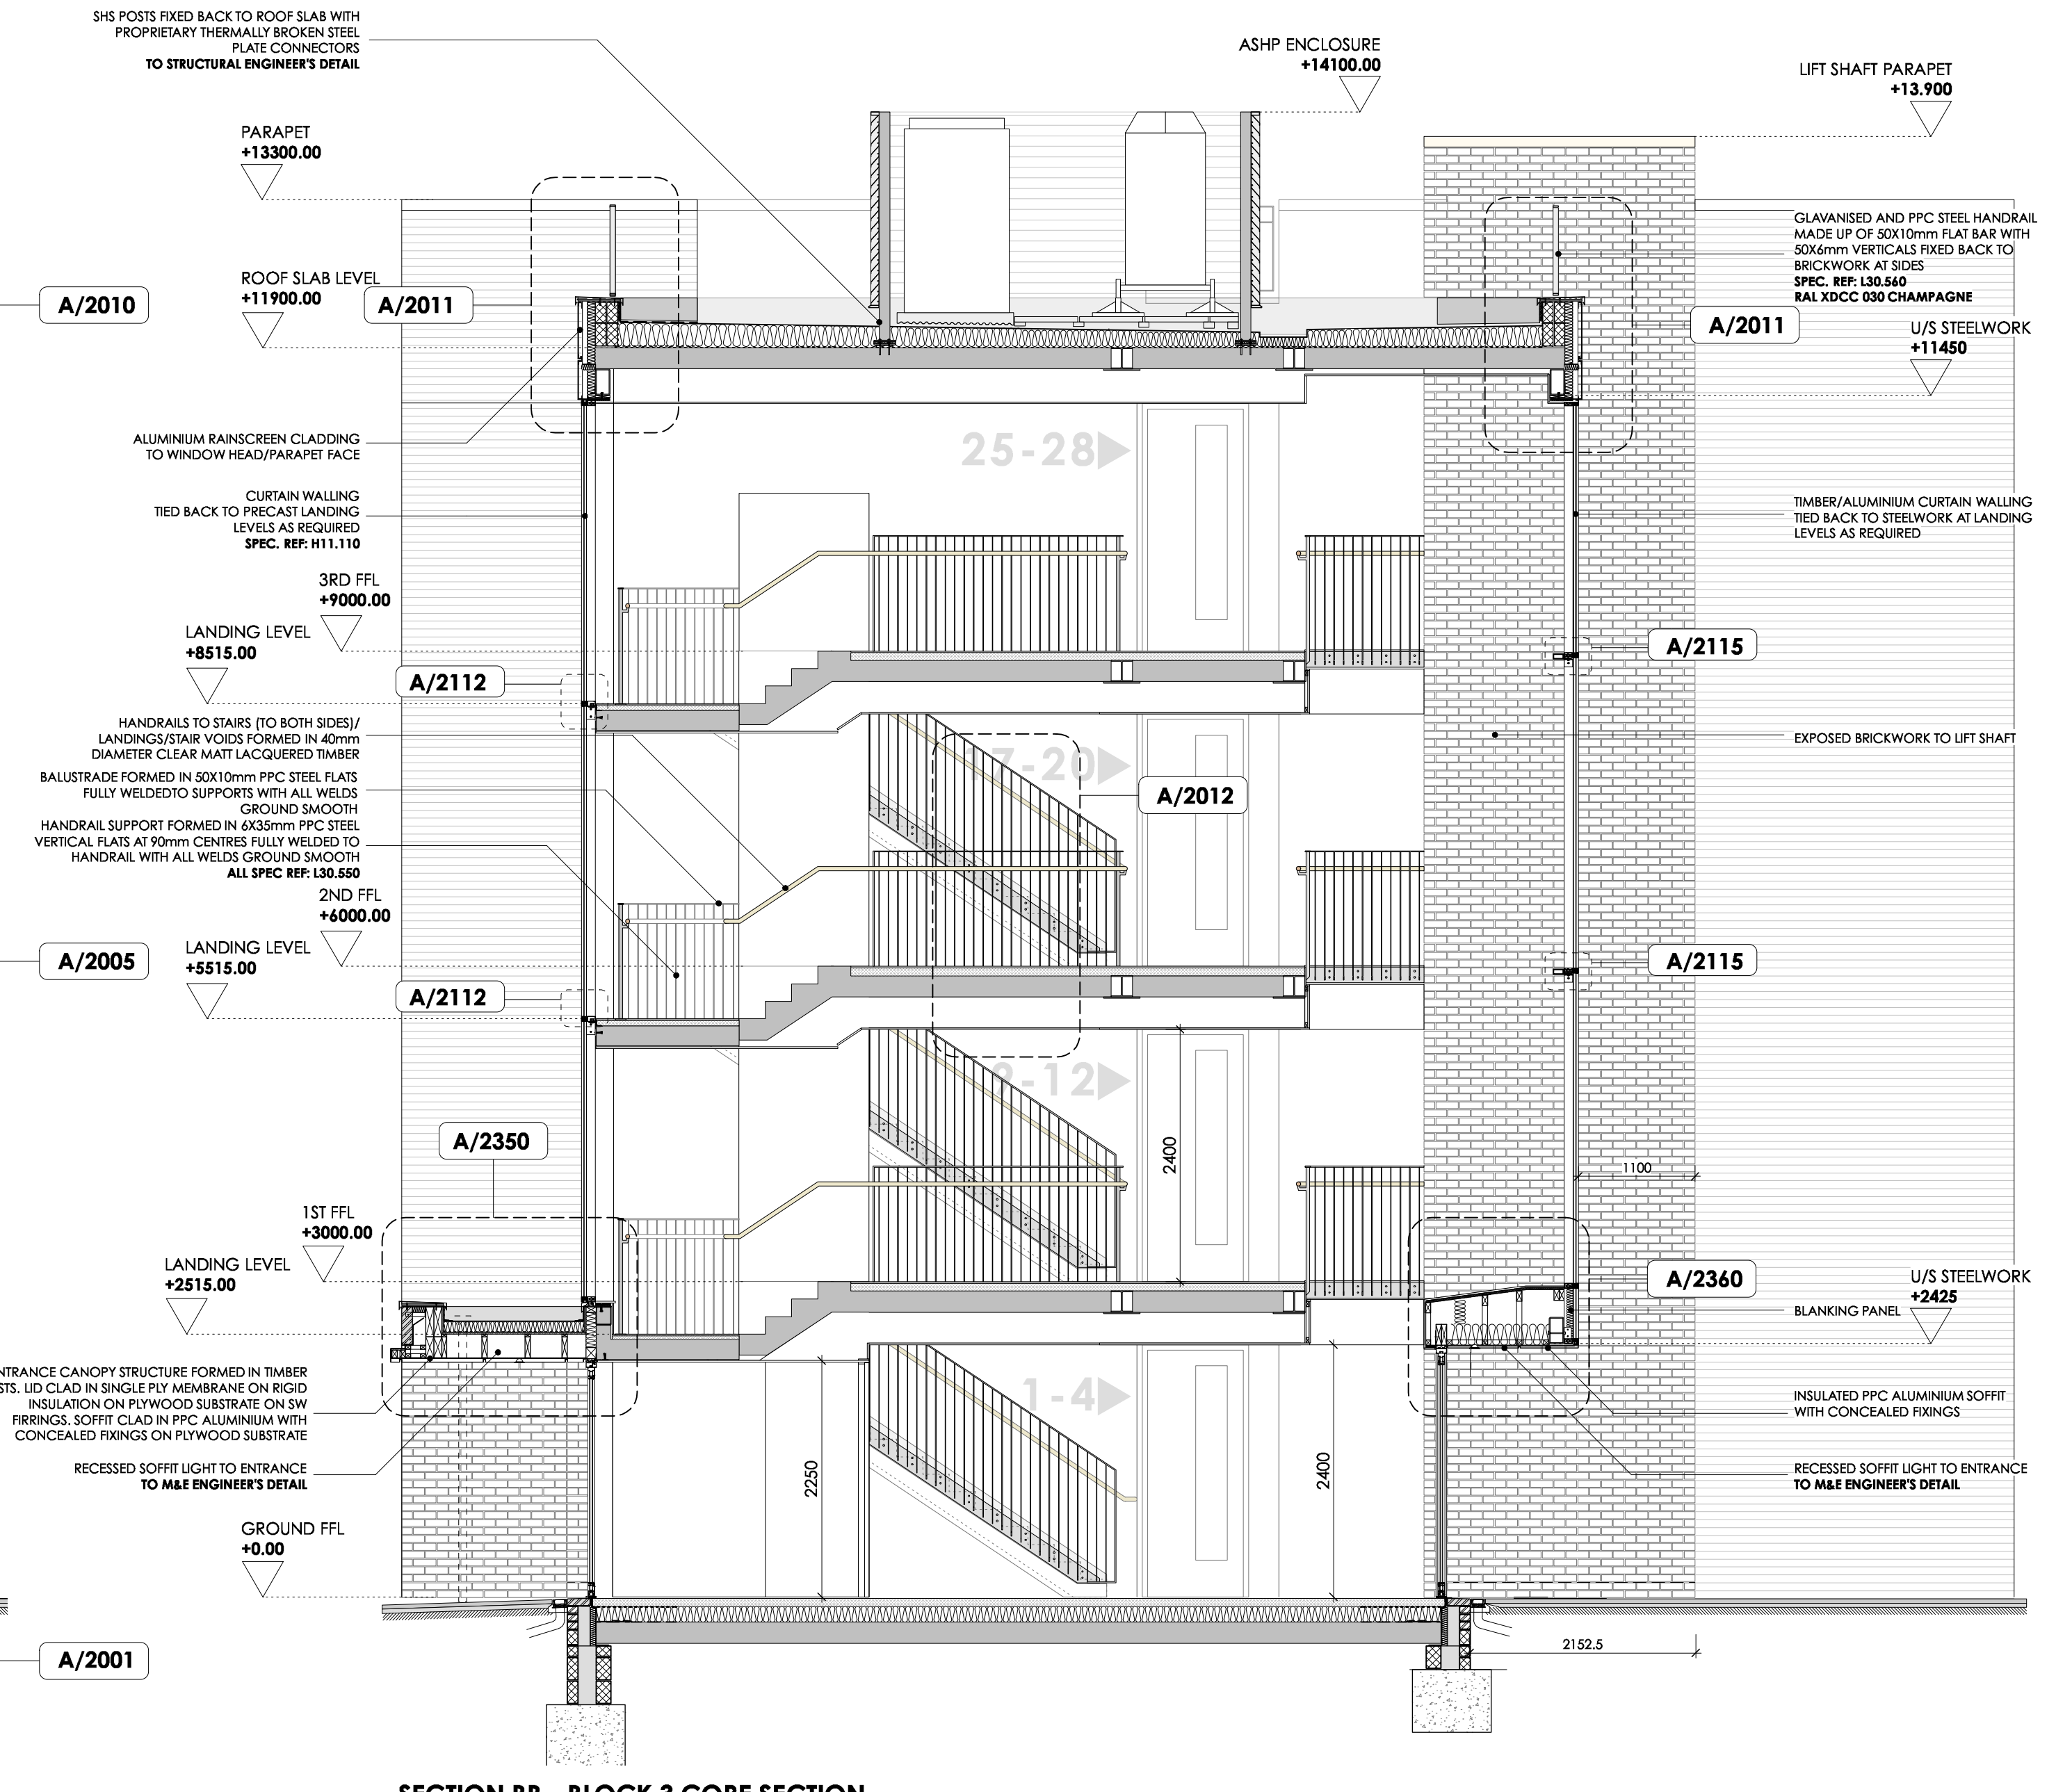

SECTION BB - BLOCK 3 CORE SECTION

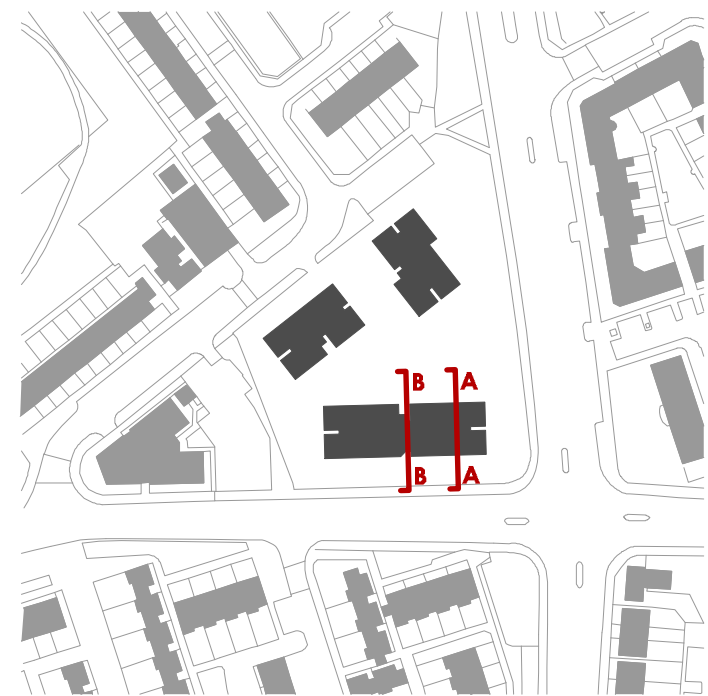

AS BUILT

OMI ARCHITECTS

31, Blackfriars Road, Salford, Manchester M3 7AQ
t 44(0)161 832 3242
f 44(0)161 832 3623
e info@omiarchitects.com
w www.omiarchitects.com

PROJECT	ROYCE ROAD, HULME				
DRAWING	TYPICAL GA SECTIONS (BLOCK 3)				
DATE	AUG '15	DRAWN BY	SMC	SCALE	1:50@A1
JOB NO.	1344	DWG NO.	L1500G		