
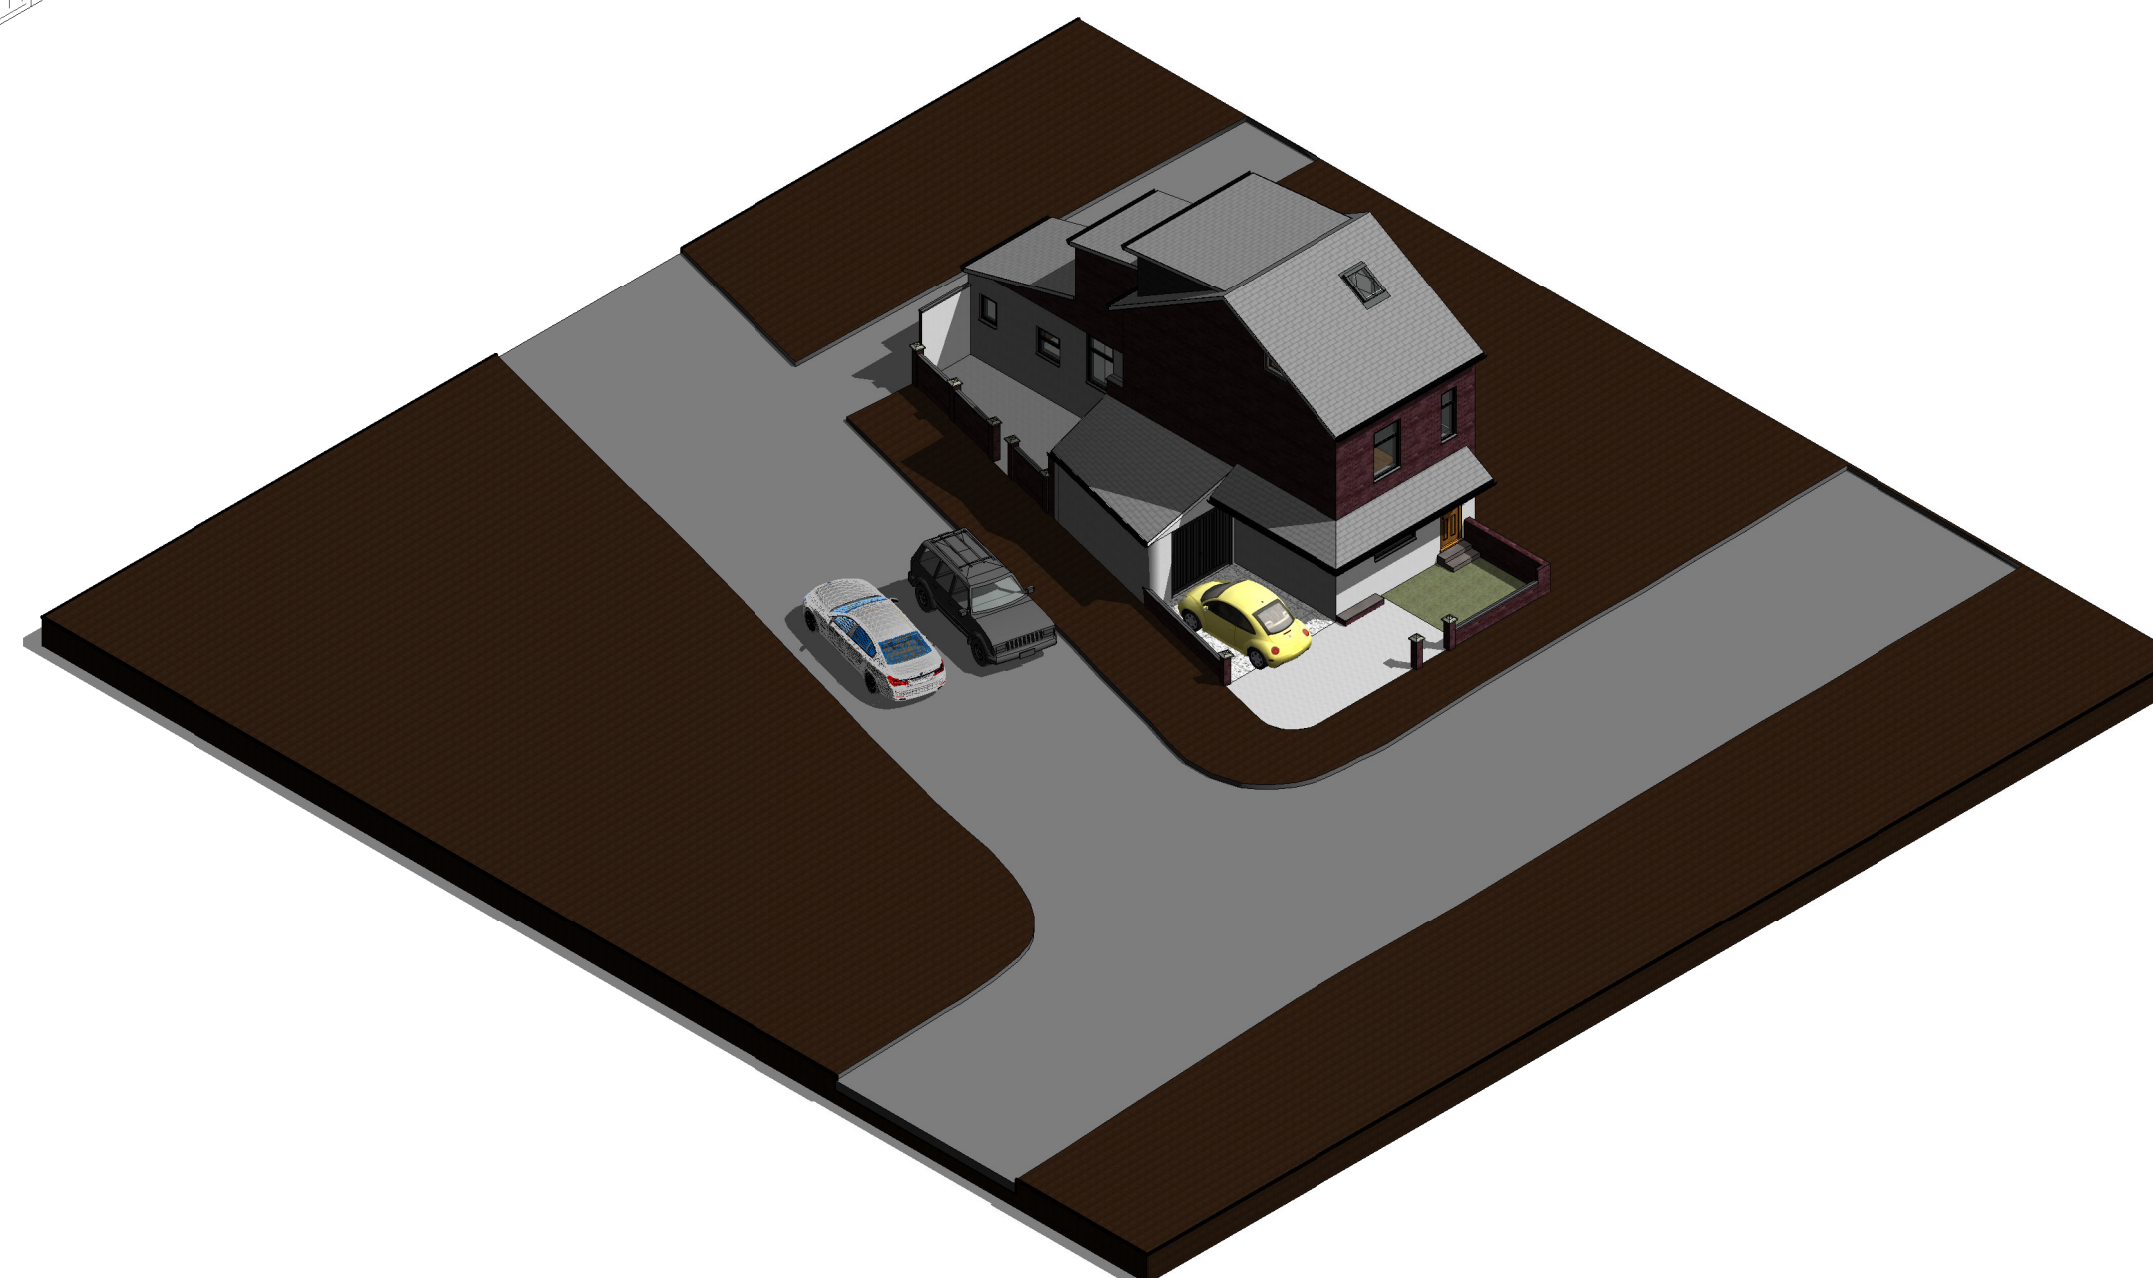
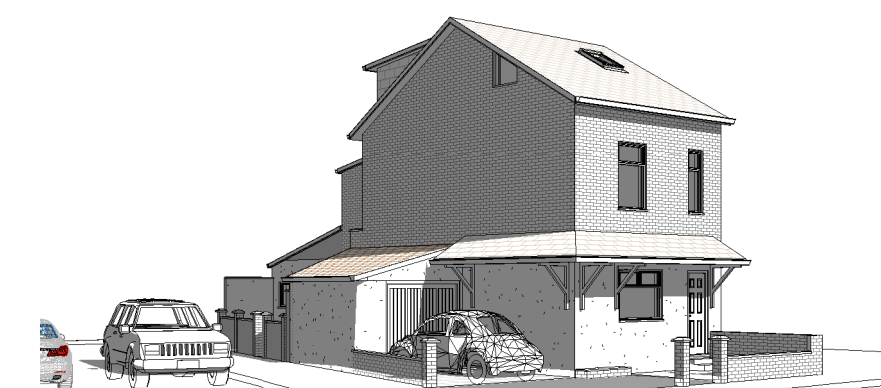


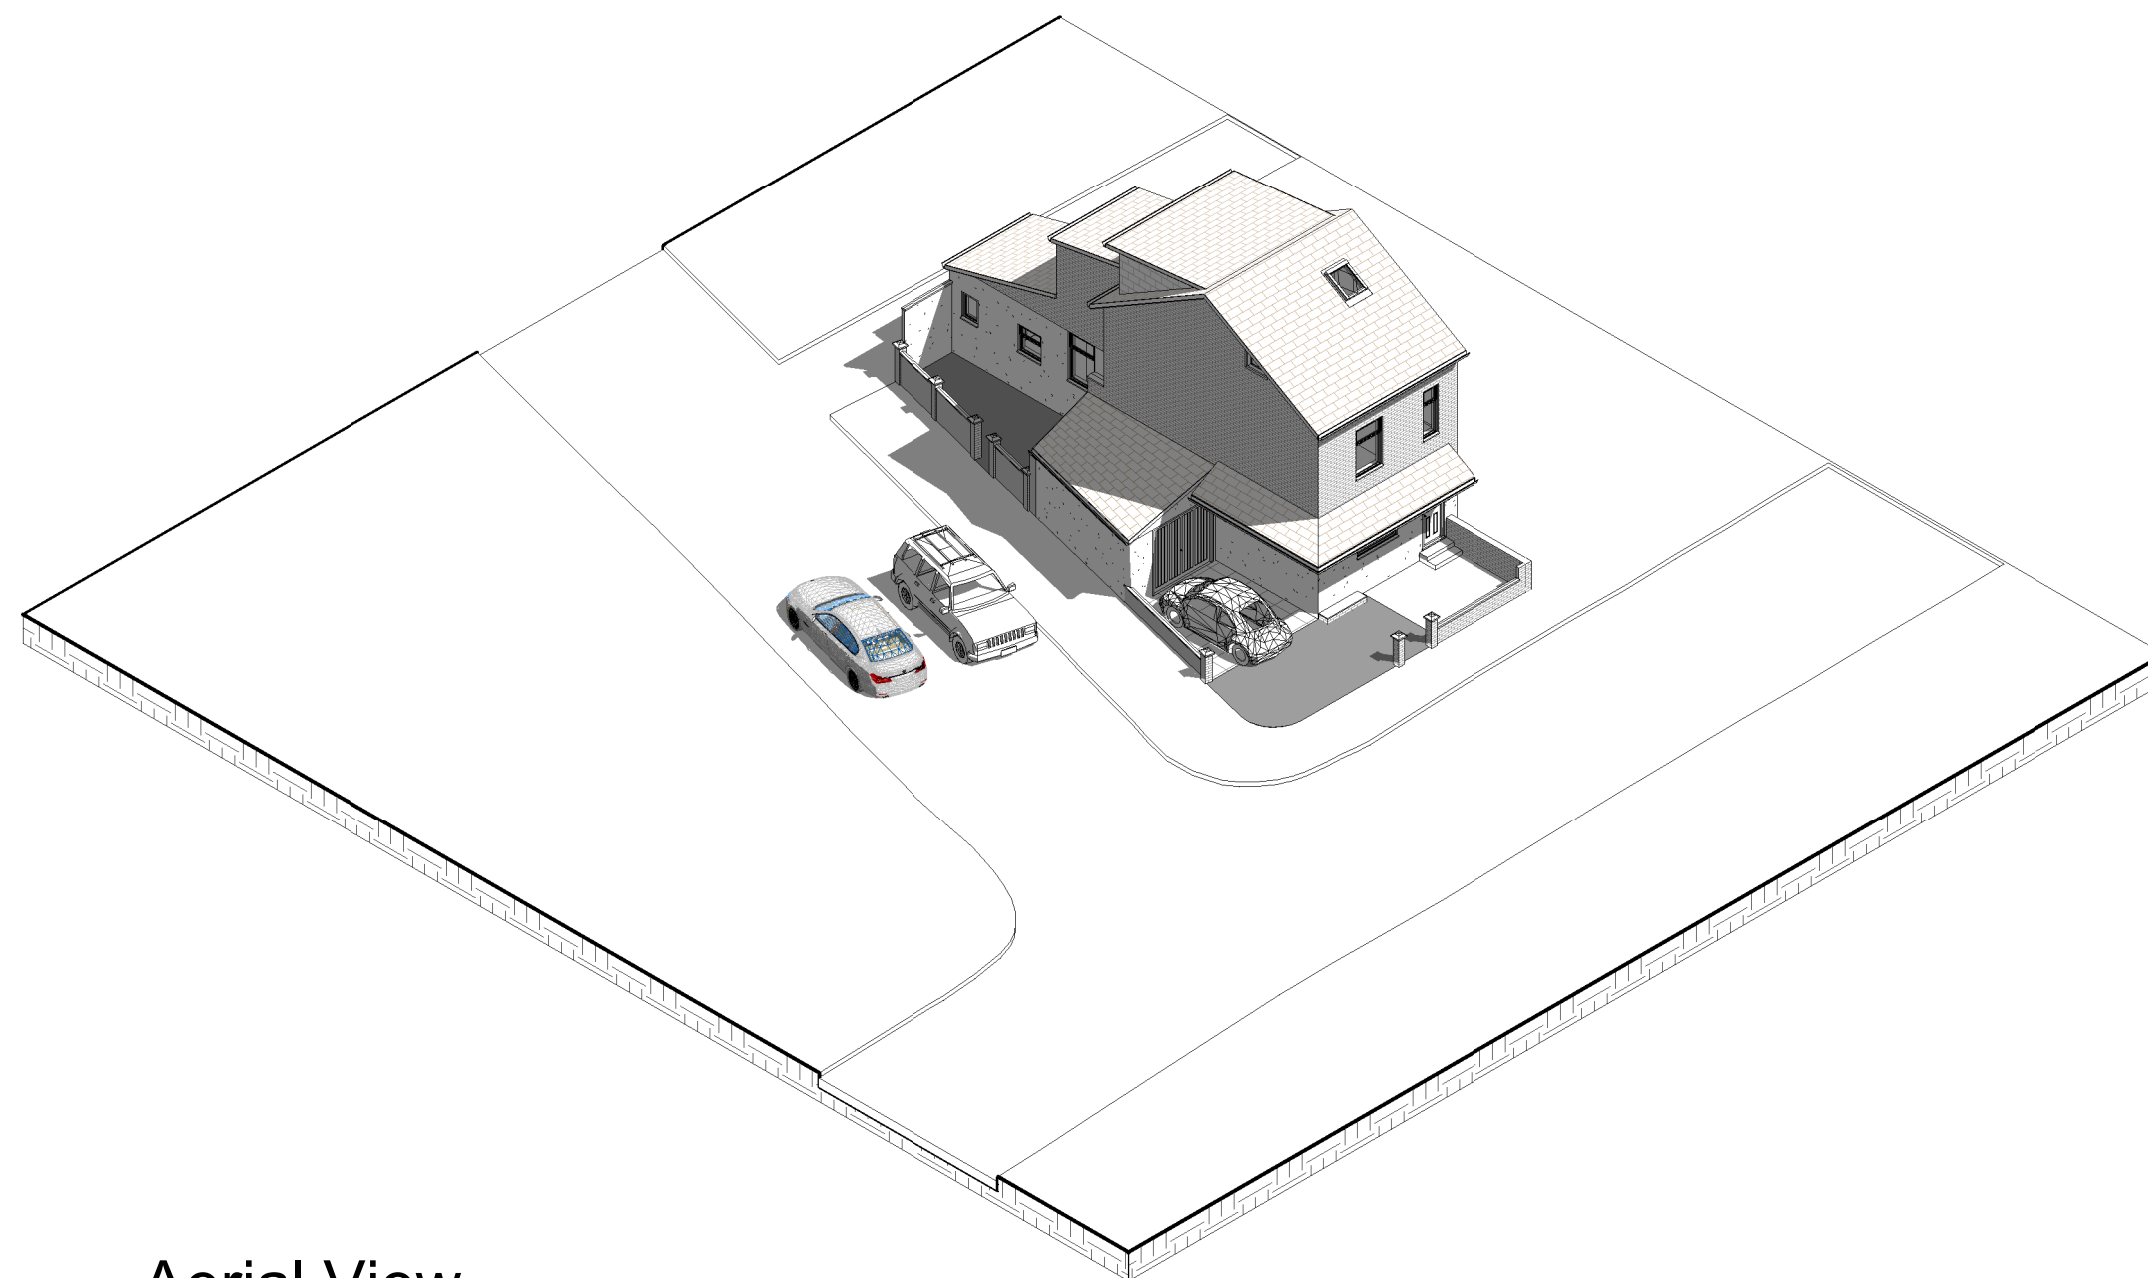


NOTES

Copyright in this drawing remains with AECDesign. Do not scale from this drawing, work to figured dimensions. Check all dimensions on-site. In the event of any discrepancy, please refer query to AECDesign.

[illegible]

Revision

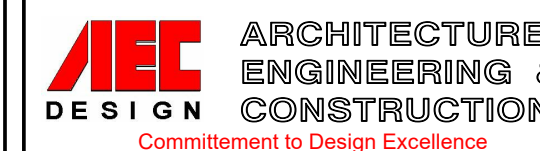

Contact:

Tel: 07985306082
Email: aecdsgn.co.uk@outlook.com
www.aecdsgn.co.uk

Project Name

**House Conversion to GF & FF
Flats with Loft Conversion**

Project No.	M192TG 2021 0001
-------------	-------------------------

Drawing No.	M192TG 2021 P111
-------------	------------------

Date	06/04/2021	Drawn-by	AECDesign
------	------------	----------	-----------

Status	Existing	Checked by	AECDesign
--------	----------	------------	-----------

Sheet Size	A2	Approved by	AECDesign
------------	-----------	-------------	------------------

Sheet Name **3D Views (Proposed)**


Scale	1 : 1
-------	-------

Client Name	Mr Abid Miah
-------------	--------------

Project Address
**64 Broom Lane,
Manchester
M19 2TG**

Sheet No.

P111

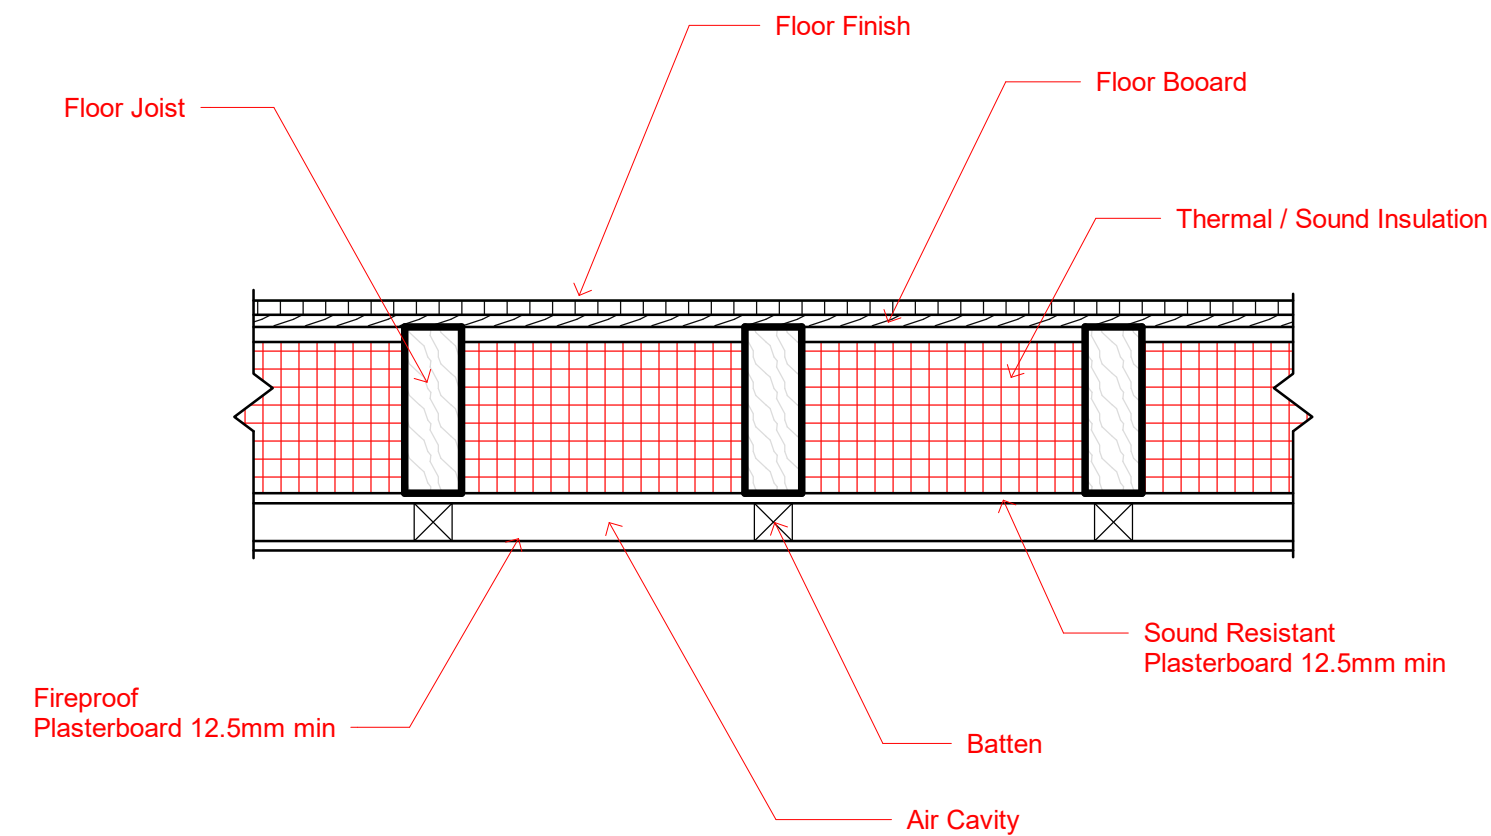

1 Ceiling Detail
1 : 10
Ceiling & floor Detail Above
Takeaway shop Areas as built
(See Images)



1. Acoustic assessment: the matter is to be addressed directly with the client not the agent.
2. Ceiling Detail shown above illustrates how the construction of ceiling has been done. Further confirmations can be obtained from the client directly, such as photos, and material specifications used in the construction of the ceiling.
3. All MEP (Mechanical, Electrical and Plumbing) specifications are to be obtained directly from the client.
4. All structural calculations and specifications are to be obtained directly from the client.

NOTES
Copyright in this drawing remains with AECDesign. Do not scale from this drawing, work to figured dimensions. Check all dimensions on-site. In the event of any discrepancy, please refer query to AECDesign.

No.	Description	Date

Revision

AEC ARCHITECTURE
DESIGN ENGINEERING &
CONSTRUCTION
Commitment to Design Excellence

Contact:
Tel: 07985306082
Email: aecdesign.co.uk@outlook.com
www.aecdesign.co.uk

Project Name
**House Conversion to GF & FF
Flats with Loft Conversion**

Project No. **M192TG_2021_0001**

Drawing No. **M192TG_2021_P112**

Date	06/04/2021	Drawn-by	Author
------	------------	----------	--------

Status	Existing	Checked by	Checker
--------	----------	------------	---------

Sheet Size	A2	Approved by	AECDesign
------------	----	-------------	-----------

Sheet Name
**Construction Details
(Proposed)**

Scale 1 : 10

Client Name **Mr Abid Miah**

Project Address 64 Broom Lane, Manchester M19 2TG	Sheet No. P112
---	--------------------------