




Note:
Do note scale from this drawing.
Dimensions are to be checked on site.
If in doubt please ask

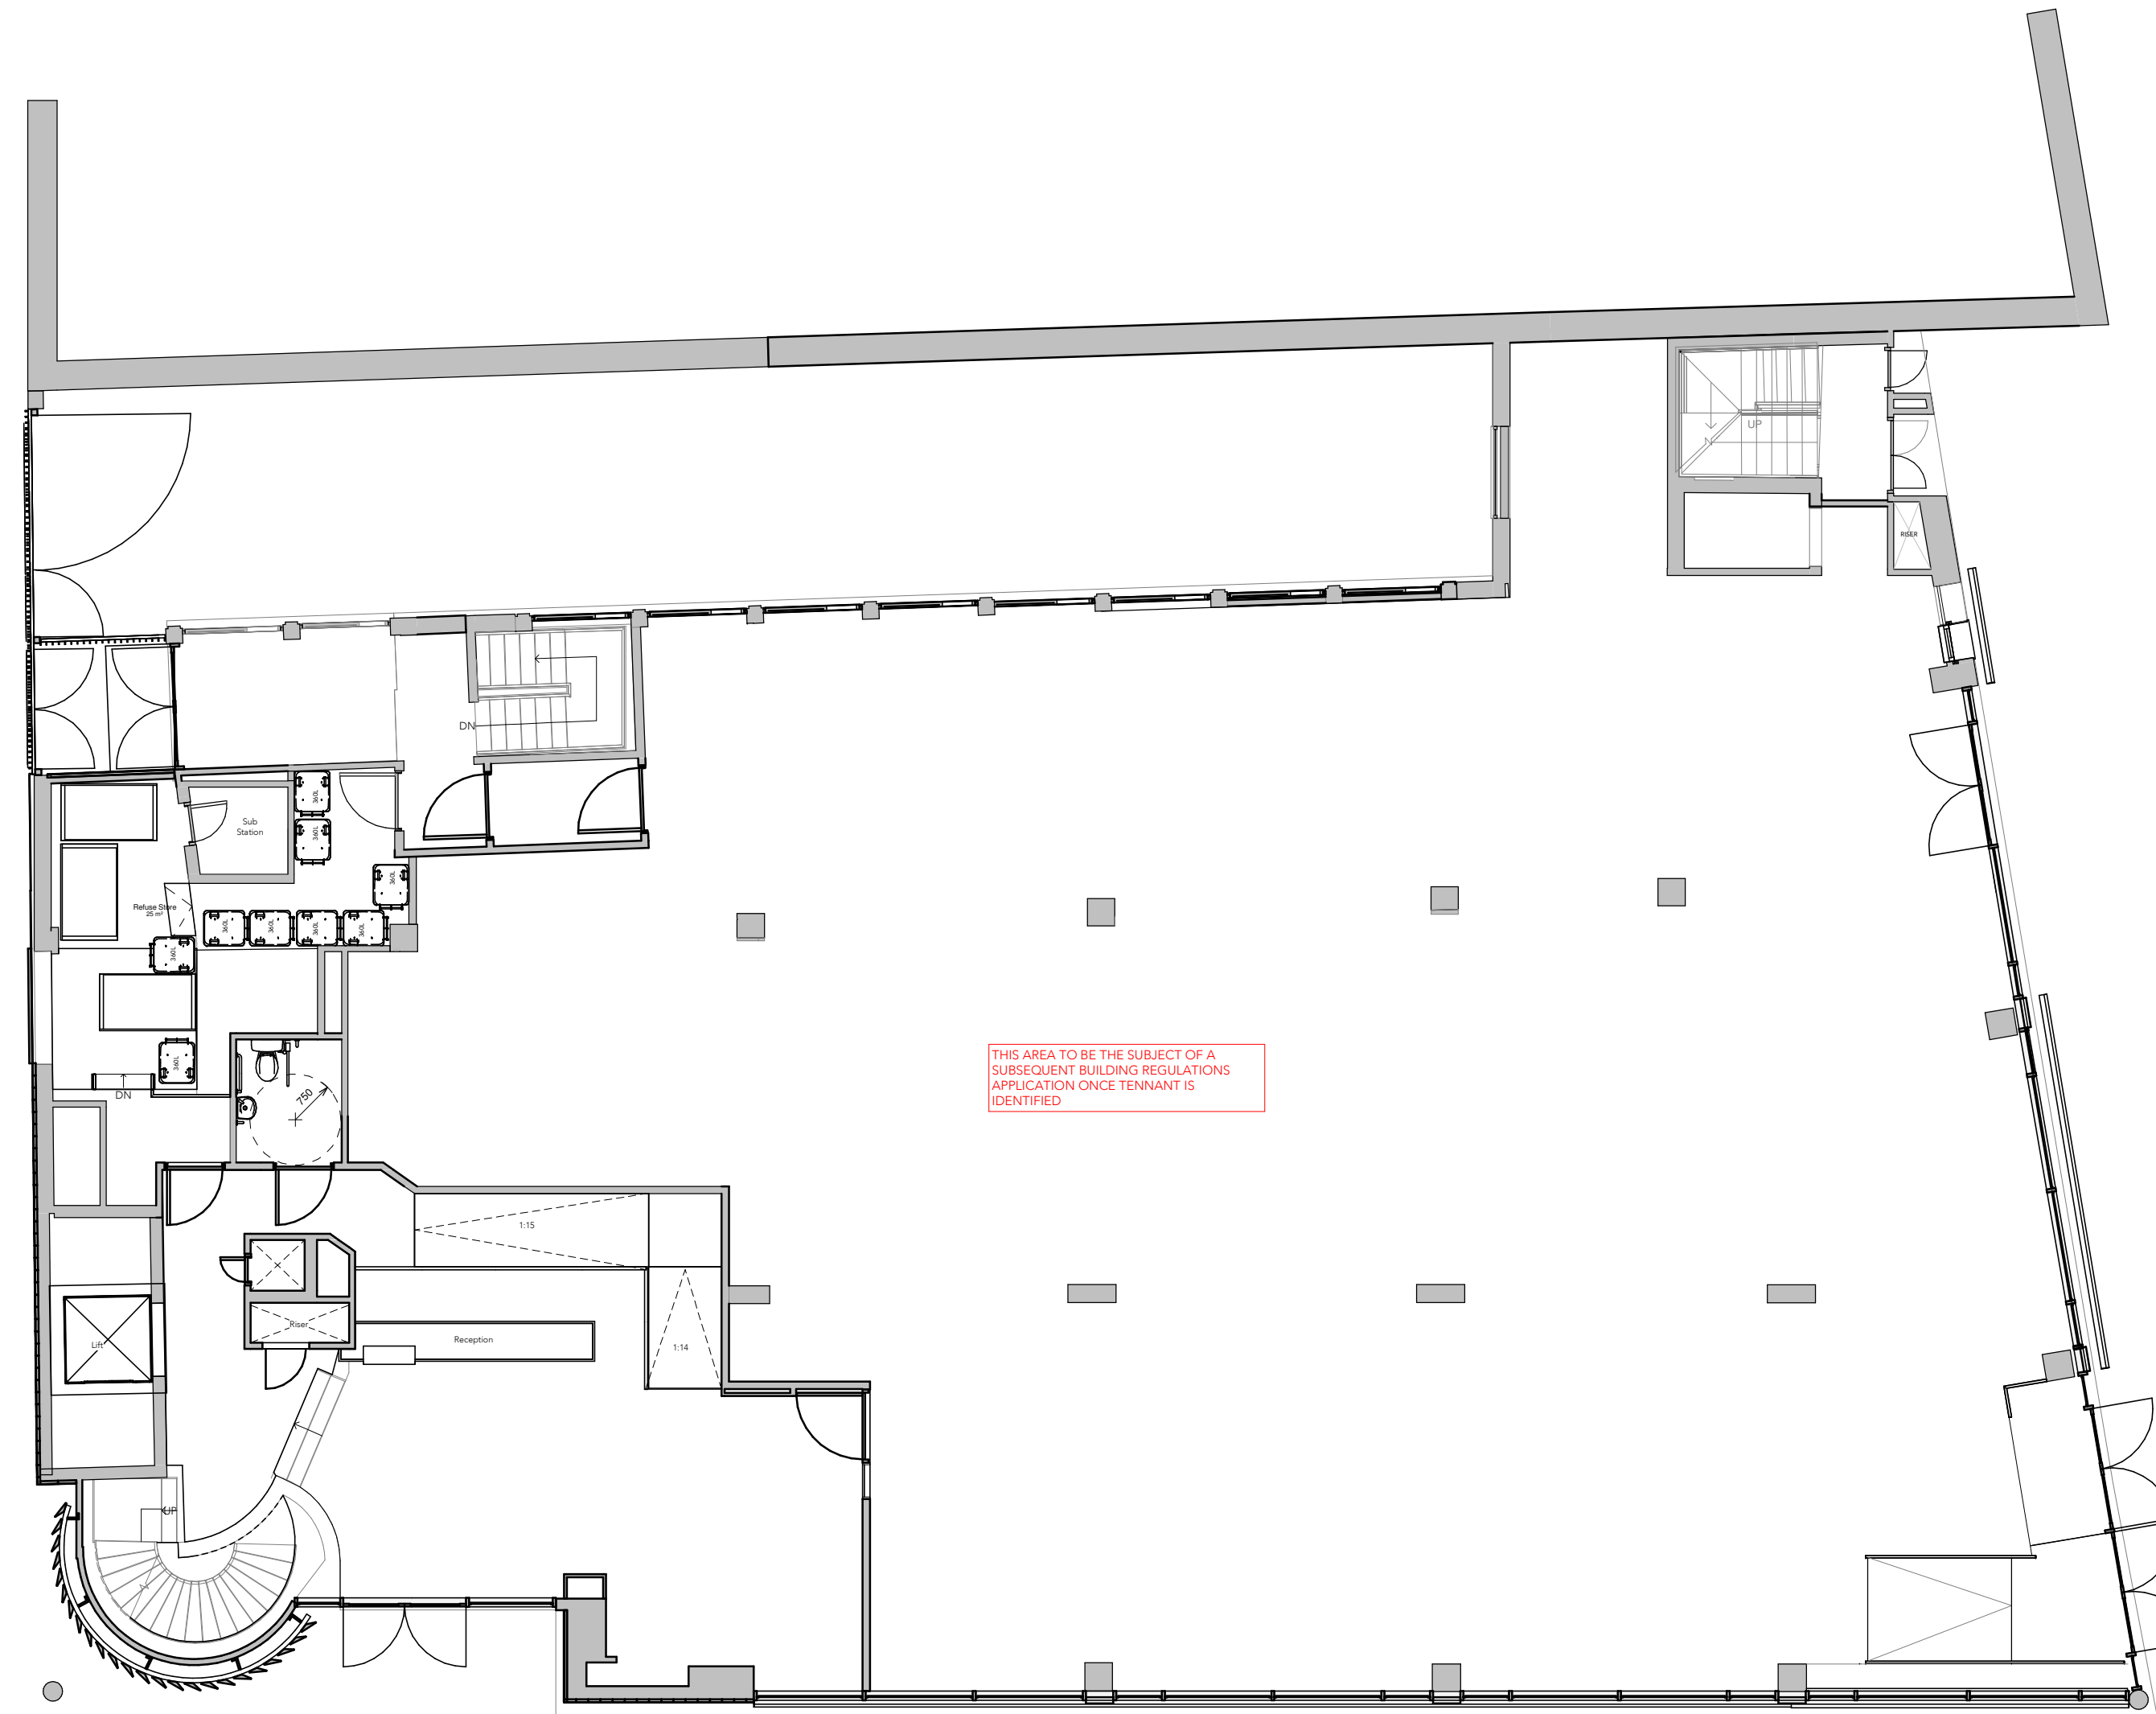

Rev	Date	Ints	Details
-----	------	------	---------

© The moral rights of the author are hereby asserted.
This drawing and design is the sole property of Buttress Ltd and must not be reproduced without permission.
Buttress Ltd is Registered in England and Wales: 5363573

Buttress

41 Bengal Street
Manchester
M4 6AF

T 0161 236 3303
E contact@buttress.net
W www.buttress.net

Project Title	26-28 Hilton House
Client	CERT Properties
Location	Manchester

Drawing ref	HTH-BA-XX-GF-DR-A-Ground_Floor_As Built_Plan
-------------	--

Date	03/01/20	Scale	1 : 50
Checker	-	Orig Paper Size	A1

Status **AS BUILT**

Drawing ref	Job No	Drawing No	Revision
-------------	--------	------------	----------

8608	(07) 001		
------	----------	--	--