
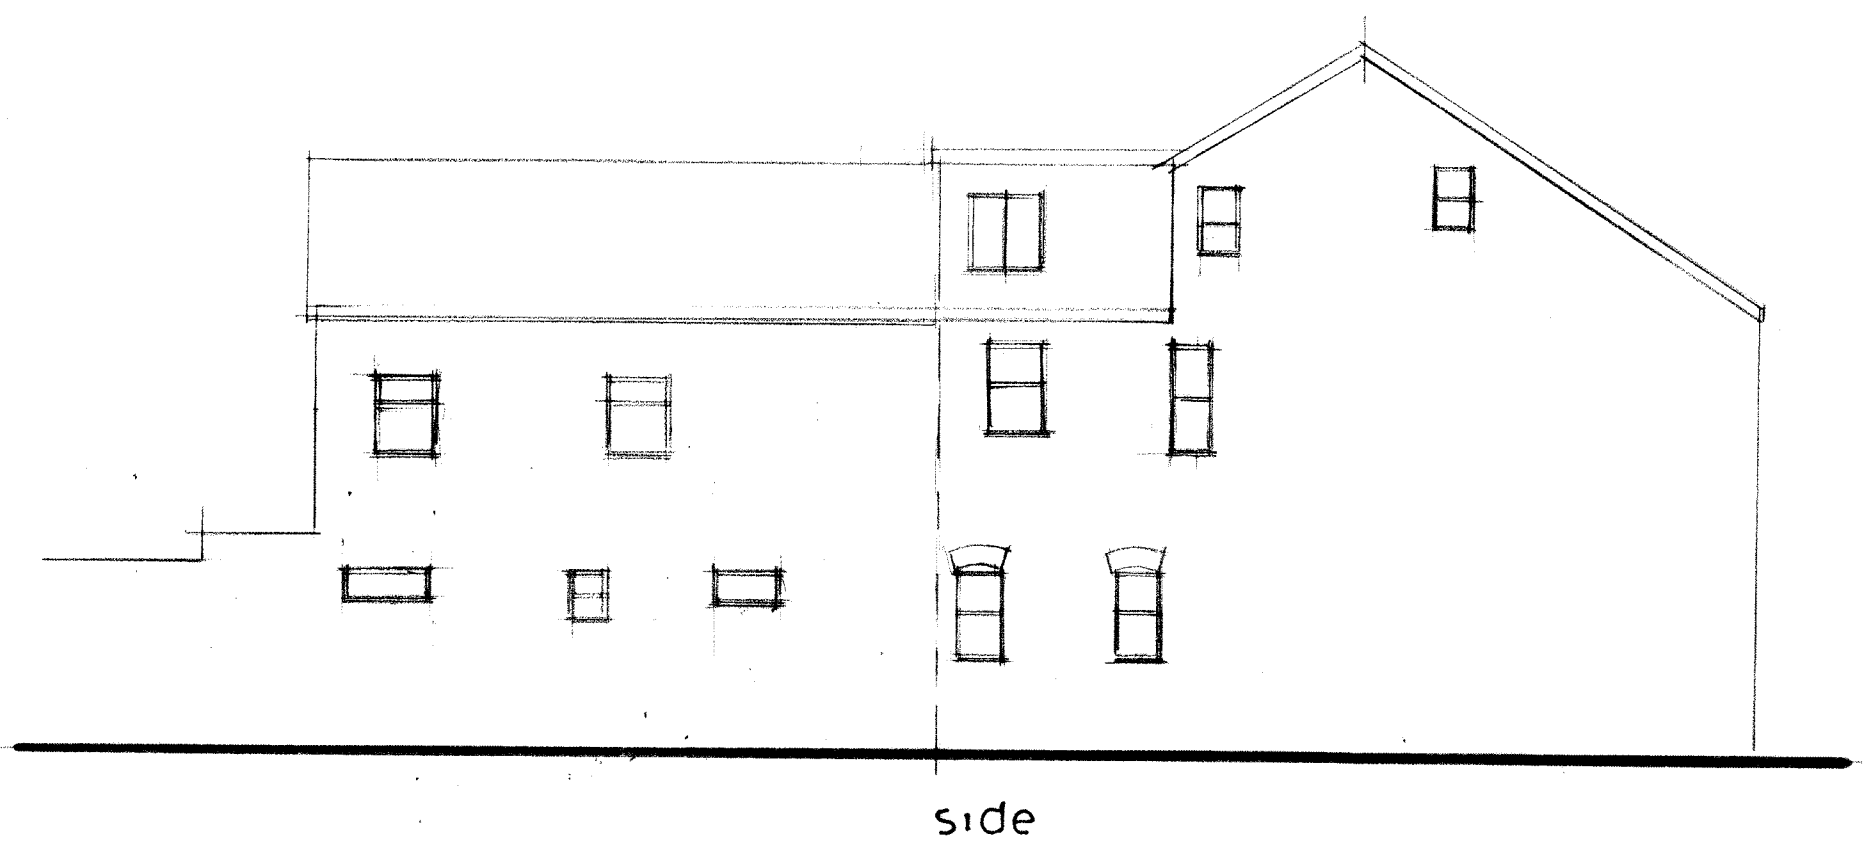


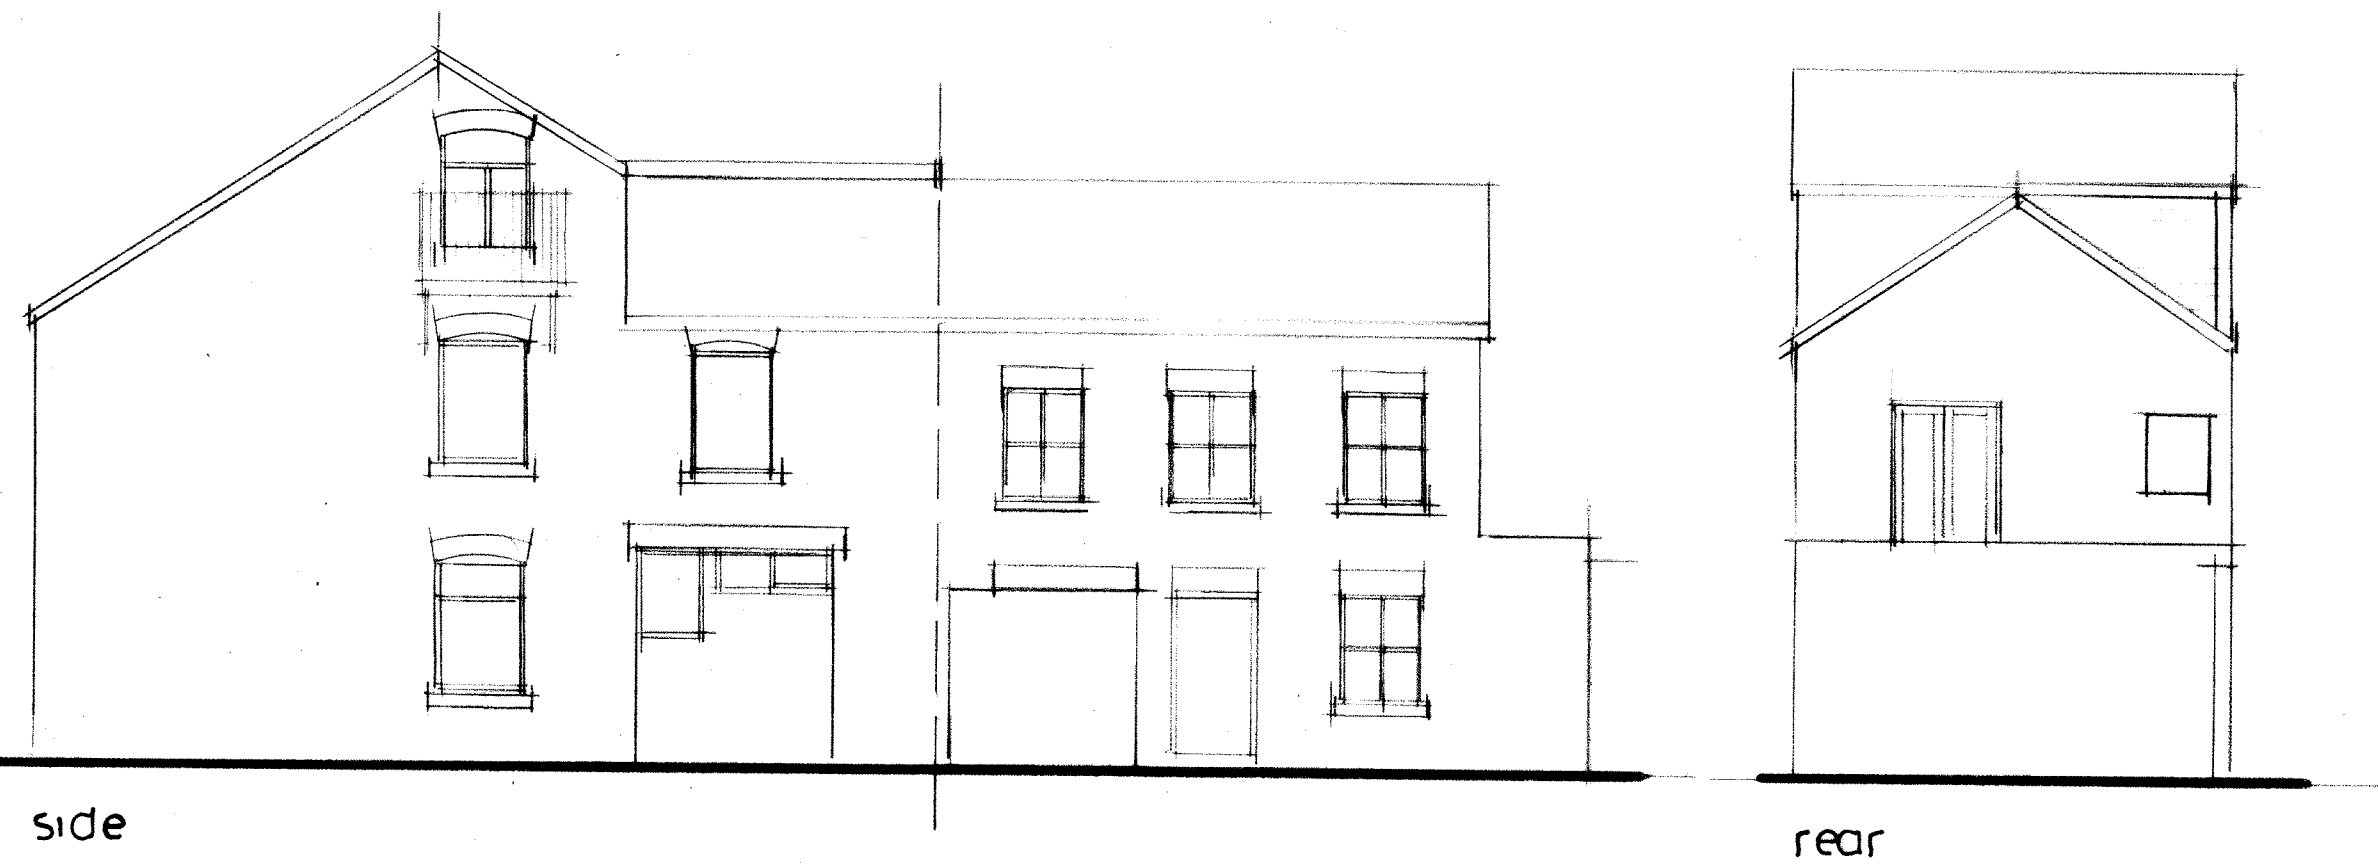

CLIENT
MR J HENRY
1 CAPE STREET
WITHINGTON M20 3WA

JOB TITLE
DORMER WINDOW

DRG. TITLE
AS CONSTRUCTED

**HOLBOROW +
ORMESHER**
Limited
architectural &
interior design

Station House
Adams Hill
Knutsford
Cheshire WA16 6DN
telephone : 01565 652275
fax : 01565 750501

ISSUE	ORIGINAL	1	2	3	4	5	6	7
REVISION								
DATE								
DRAWN								
CHECKED								
APPROVED								

SCALE 1:100 at A2

DRAWING
NUMBER 2150/21/01