
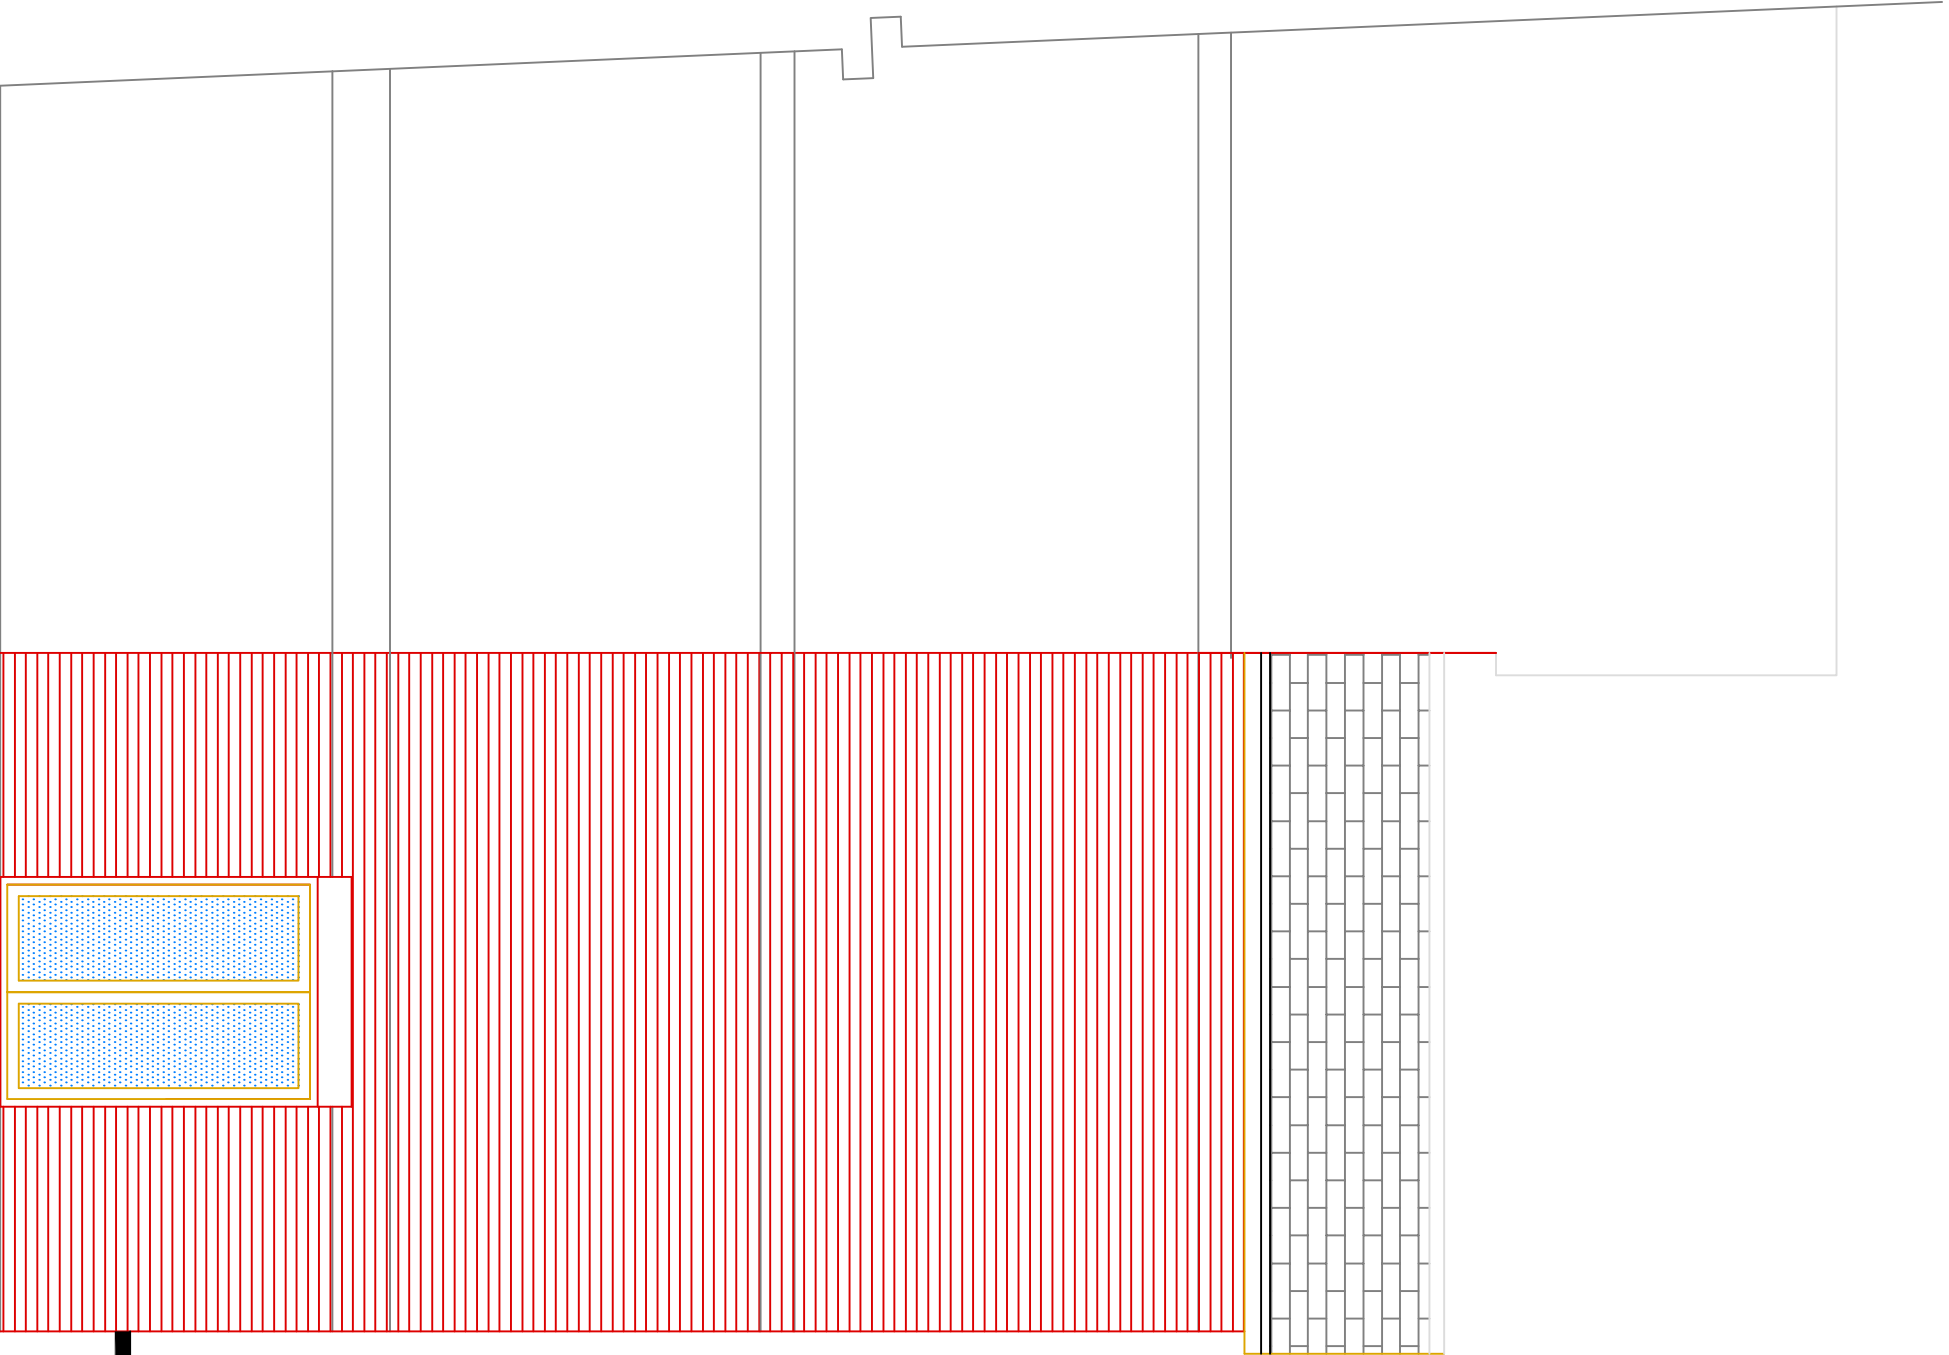
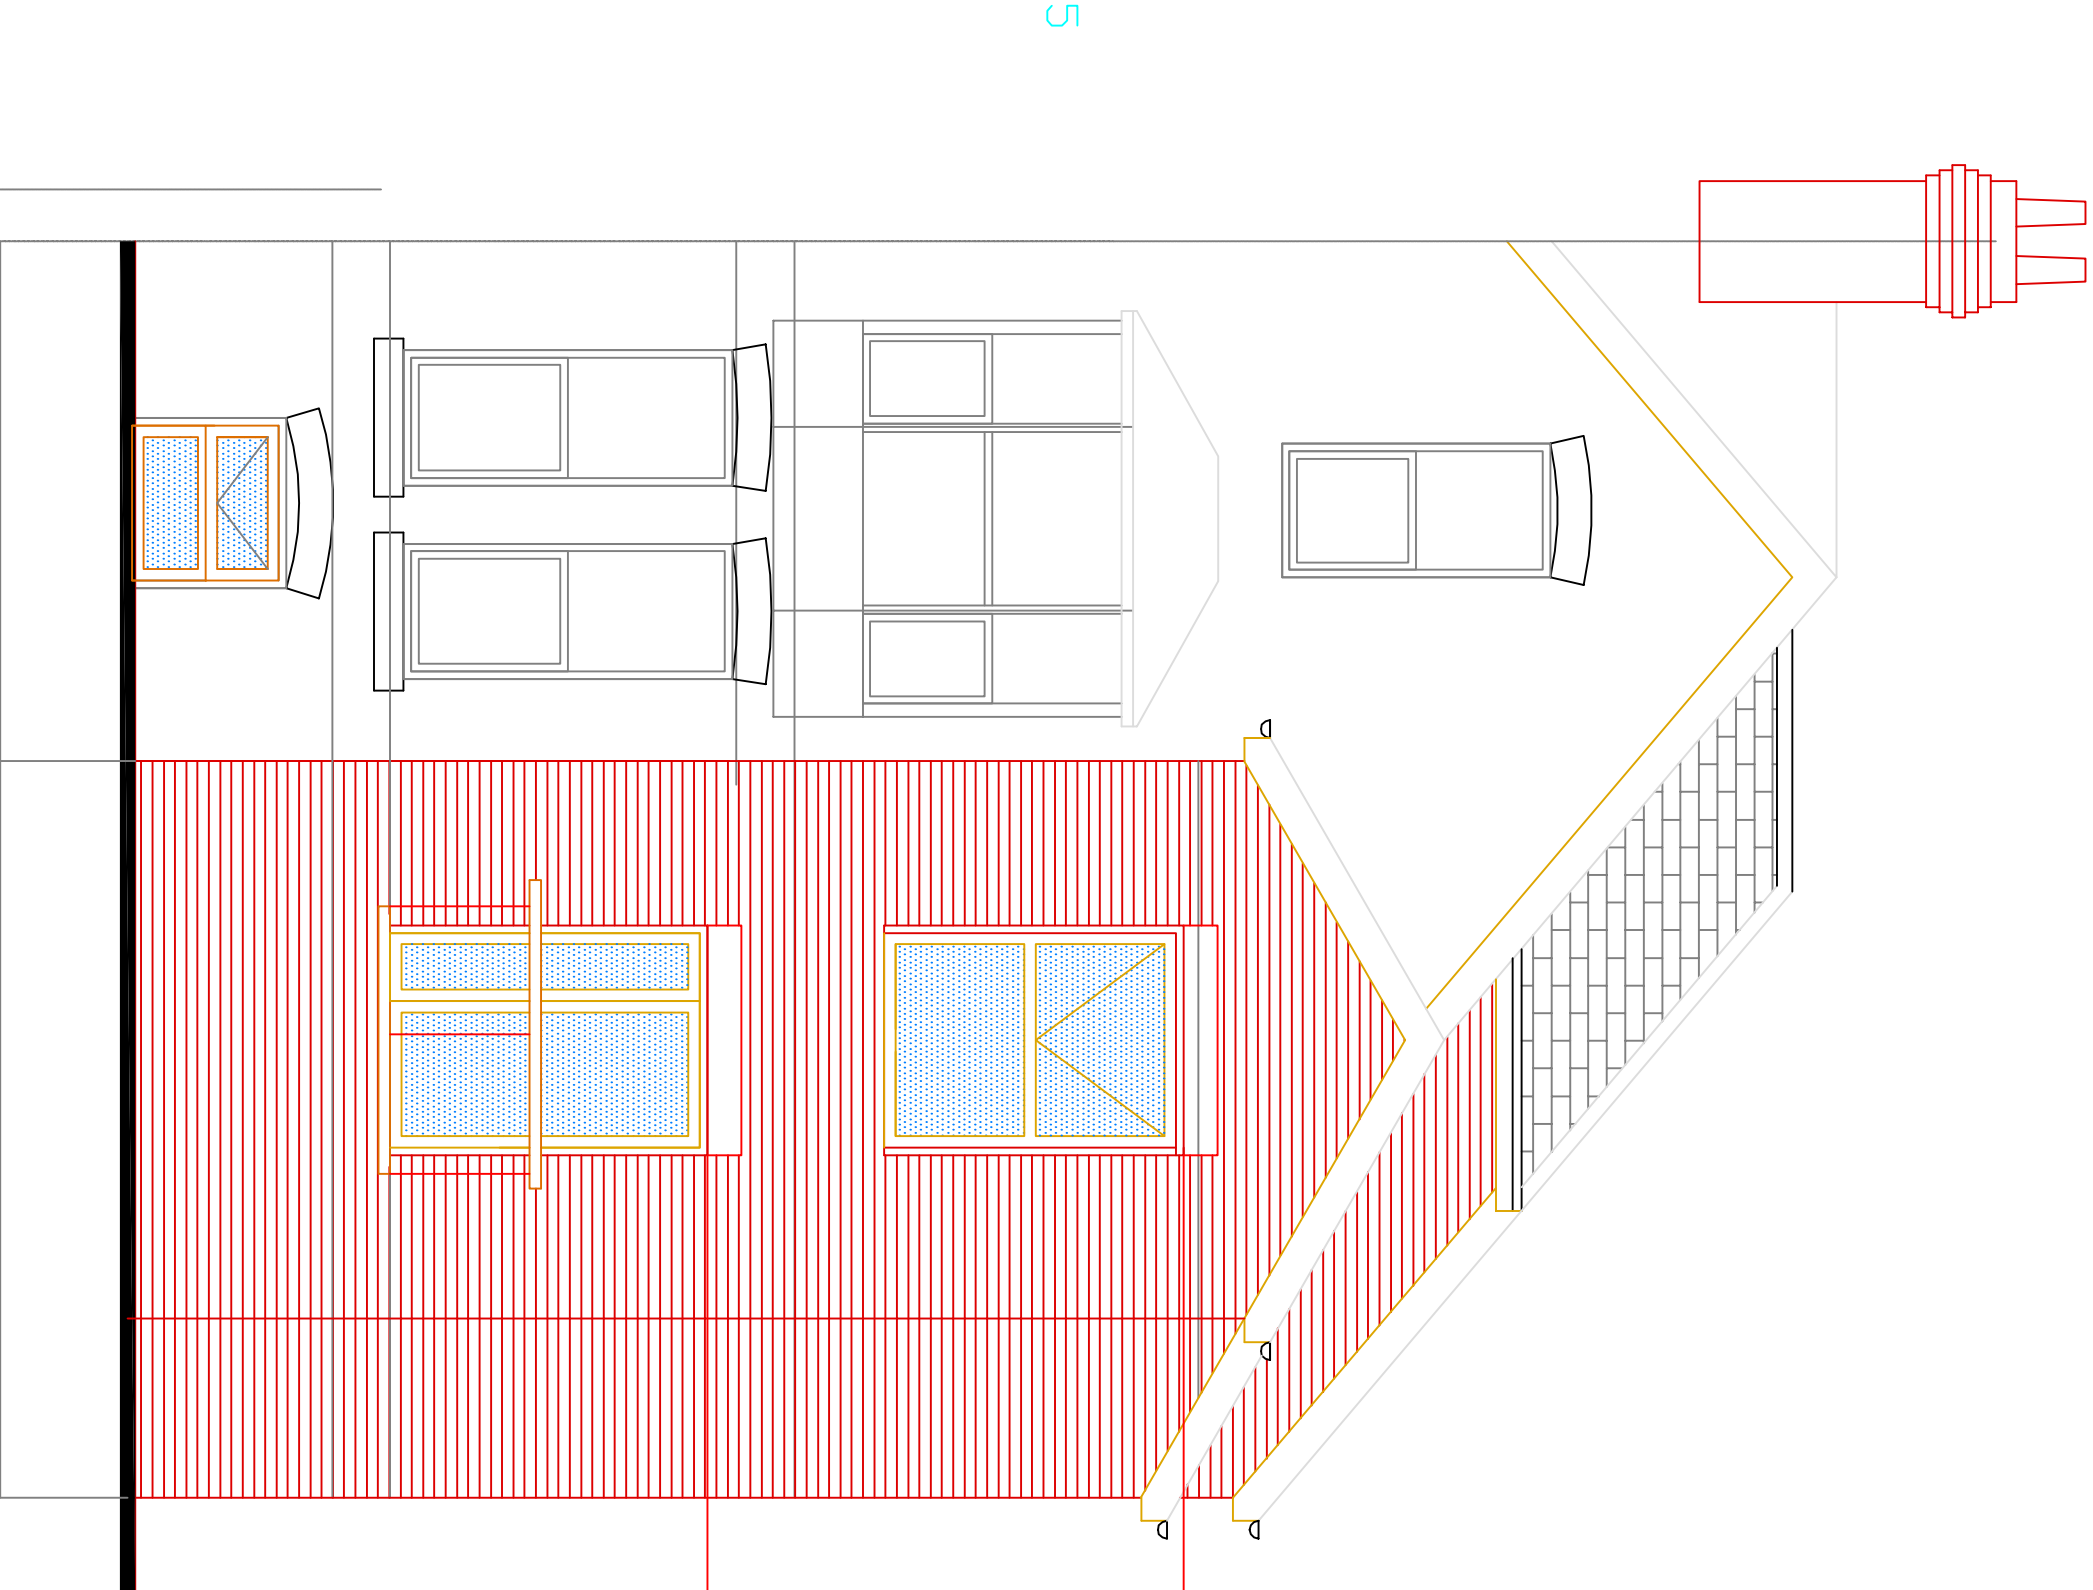
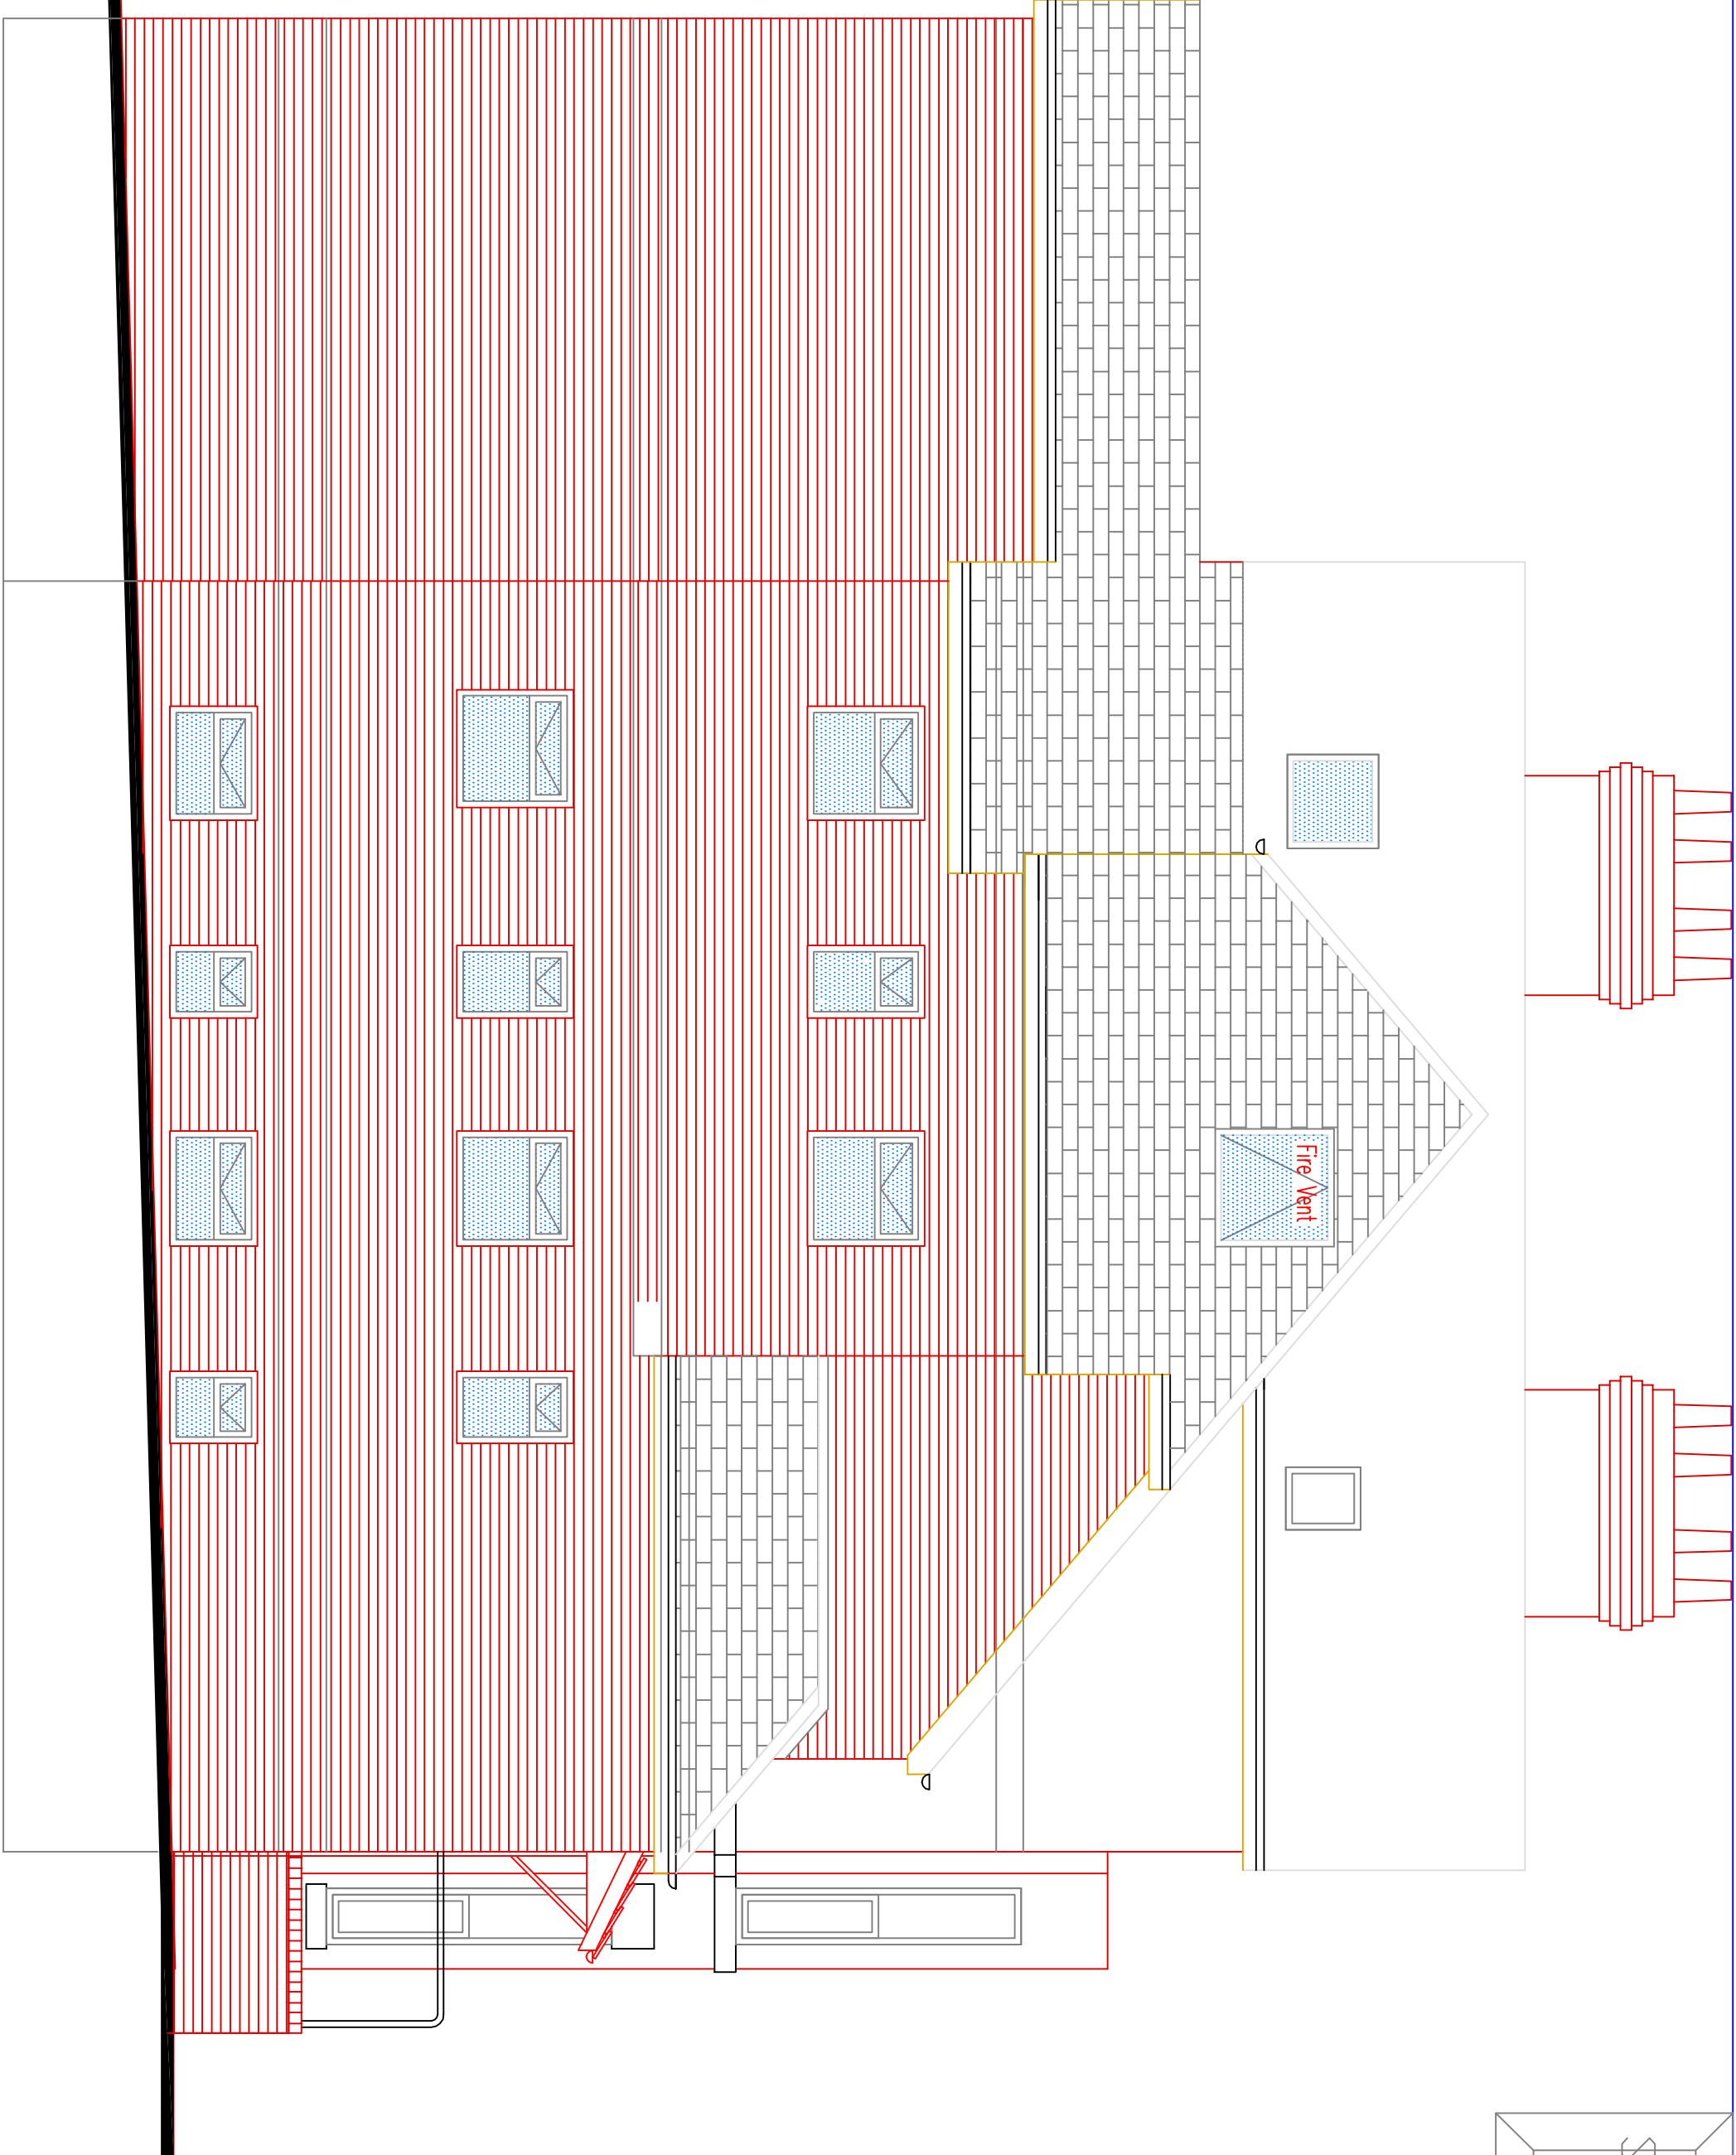
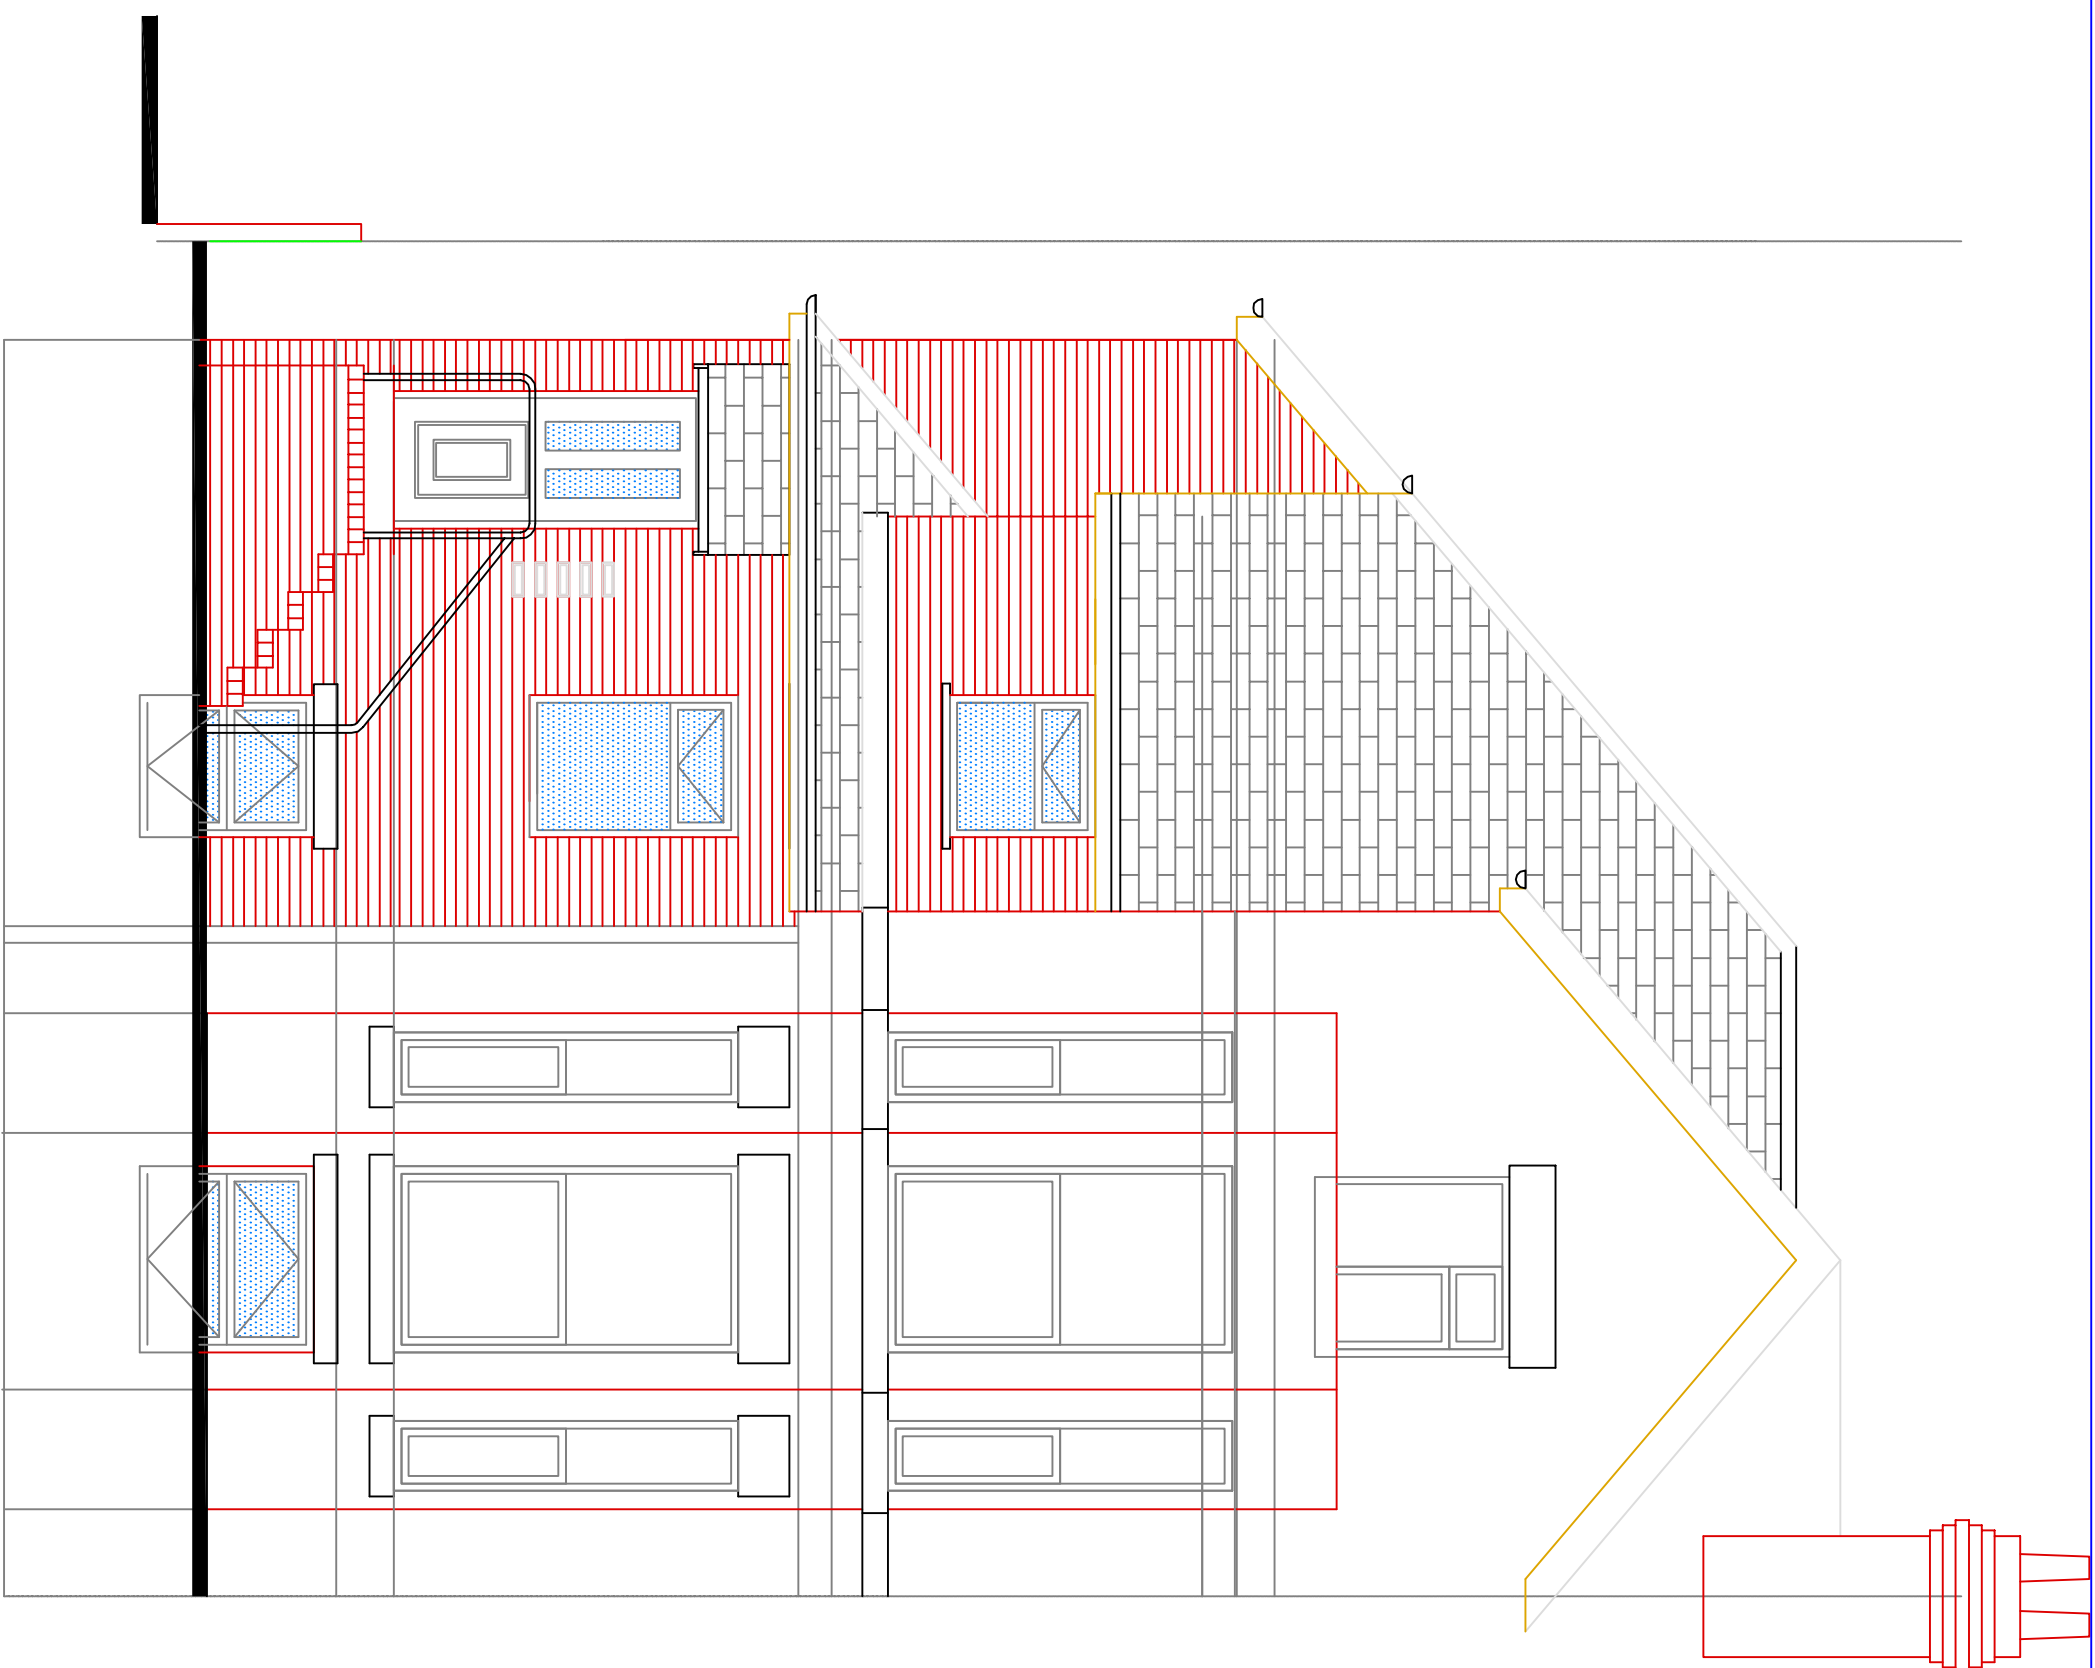


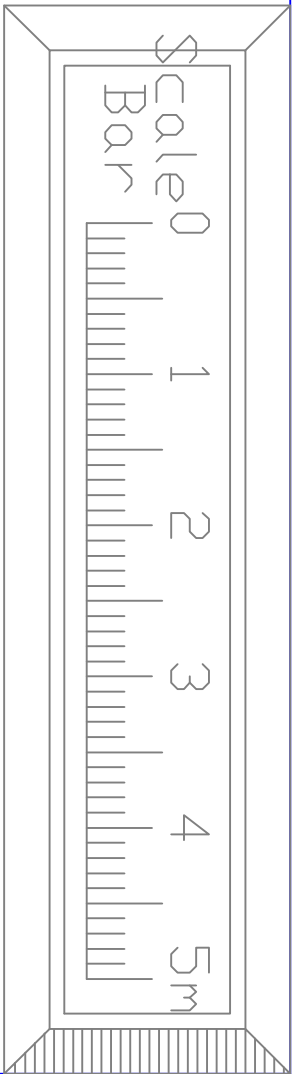

A		AMENDMENTS TO AS BUILT ON SITE		JAN 20	SA
Rev.	Mod. Notes		Date	By	
Client					
Mr Ikram Akram Chaudhry					
Location					
7 York Road					
Chorton					
Job Title					
Internal Alterations and Extensions					
To Modify 5 Apartments					
Drawing Title					
Proposed Elevations					
Scale 1:50			Sheet A1		
Date Feb 15			Drawn by DAP		
Dwg. No. 03 / 15 - 04			Rev. A		