
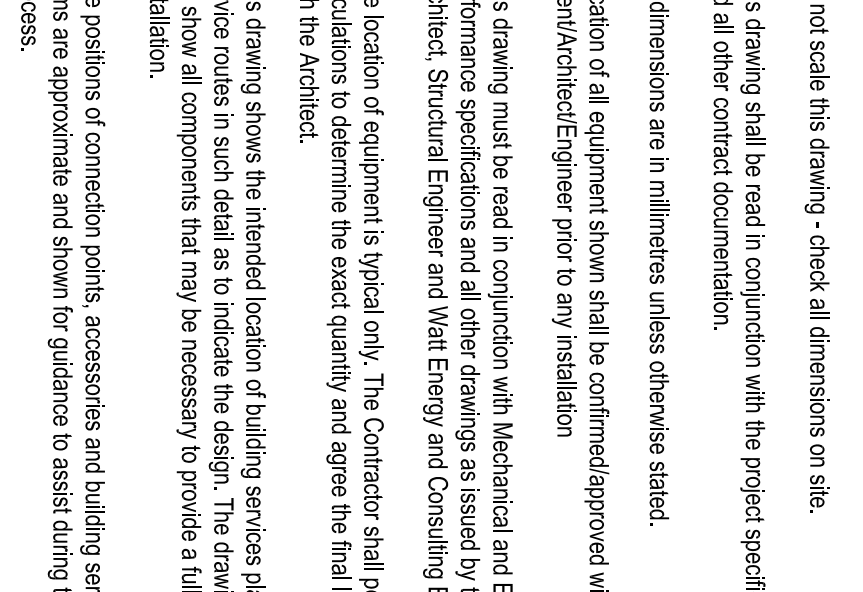


- | | |
|---|---|
| <p>Notes:</p> <ol style="list-style-type: none"> 1. This drawing is subject to copyright and is not to be reproduced in part or whole without approval. 2. Do not scale this drawing - check all dimensions on site. 3. This drawing shall be read in conjunction with the project specifications and all other contract documentation. 4. All dimensions are in millimeters unless otherwise stated. 5. Location of all equipment shown shall be confirmed/approved with the Client/Architect/Engineer prior to any installation. 6. The drawing must be read in conjunction with Mechanical and Electrical performance specifications and all other drawings as issued by the Architect, Structural Engineer and Water Energy and Consulting Engineers. 7. The location of equipment is typical only. The Contractor shall perform all calculations to determine the exact quantity and agree the final locations with the Architect. 8. This drawing shows the intended location of building services plant and service units in situ (seen as to indicate the design). The drawing does not show the location of equipment and services in the building as installed. 9. The positions of connection points, accessories and building services items are approximate and shown for guidance to assist during the tender process. 10. Fully co-ordinated drawings. Construction drawings and Bill-of-Materials drawings shall be produced by the contractor. Under no circumstances shall the tender drawings be used as installation drawings. |  |
|---|---|

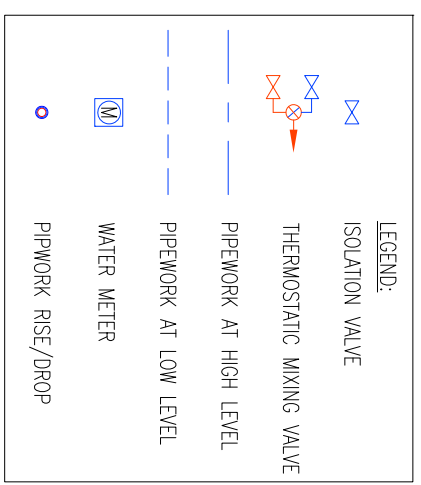

T1	29.01.21	TENDER ISSUE	BS
Rev:	Date:	Status/Amendments:	By:


40 KING STREET, MANCHESTER, M2 6BA
TEL: 0161 434 3103 EMAIL: office@wece.co.uk

Client: **ARTISAN**

Project:
CABLE STREET
ANCOATS
MANCHESTER

Drawing Title:
**MECHANICAL SERVICES
DOMESTIC SERVICES LAYOUT
THIRD FLOOR**

Drawn By:	BS	Checked By:	DW	Cad By:	SB
Scale:	1:50	Paper Size:	A1	Date Created:	08 / 04 / 2019
Drawing Number:	WECE / 286 / M / 111			Drawing Revision:	T1

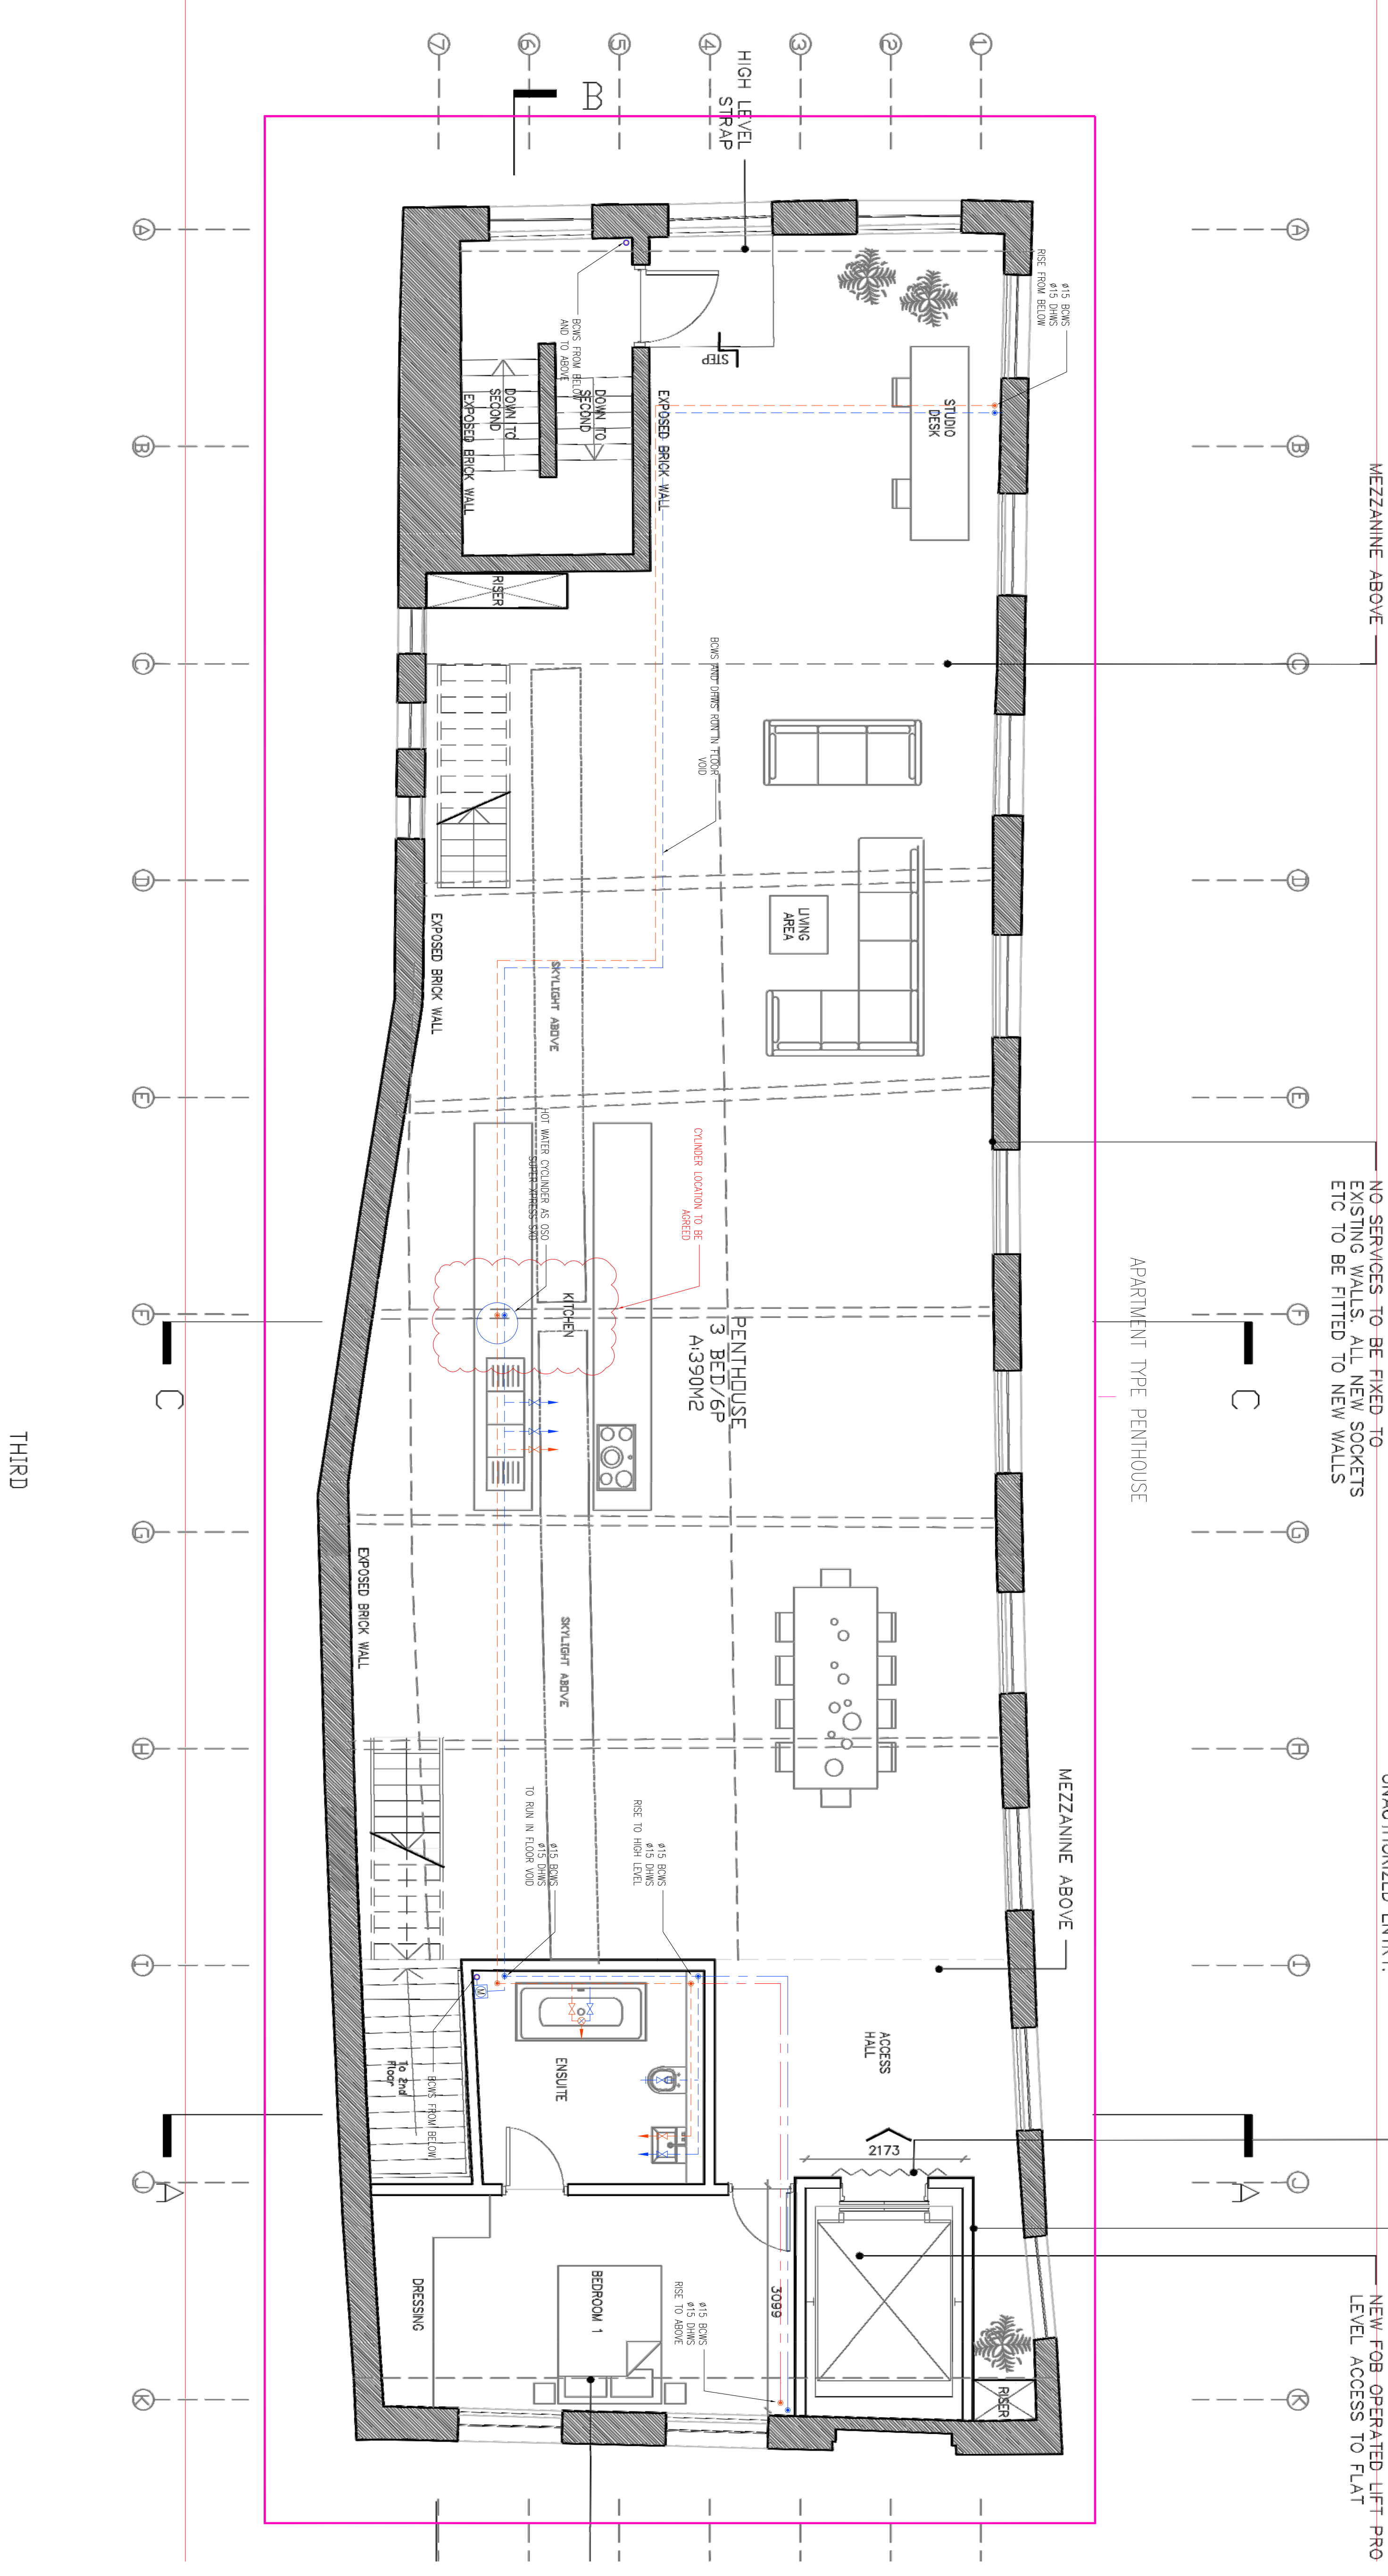

EXISTING LIFT SHUTTERS RETAINED.
LIFT ACCESS TO FLATS TO HAVE
SECURE SECONDARY DOOR TO AVOID
UNAUTHORIZED ENTRY.

NO SERVICES TO BE FIXED TO
EXISTING WALLS. ALL NEW SOCKETS
ETC TO BE FITTED TO NEW WALLS

NEW LIFT CORE BUILT UP FOR FIVE
COMPARTMENTALISATION AND
ACOUSTIC SEPARATION. EXISTING
MEMBER PANELLING ON SITE TO BE
RETAINED AND USED TO CLAD NEW
LIFT SHAFT

APARTMENT TYPE PENTHOUSE

PENTHOUSE
3 BED/6P
A:390M2


SH LEVEL
STRAP

THIRD

NEW LIFT CORE BUILT UP FOR FILL
COMPARTMENTALISATION AND

Notes:

1. This drawing is subject to copyright and is not to be reproduced in part or whole without approval.
2. Do not scale this drawing - check all dimensions on site.
3. This drawing shall be read in conjunction with the project specifications and all other contract documentation.
4. All dimensions are in millimeters unless otherwise stated.
5. Location of all equipment shown shall be confirmed/approved with the Client/Architect/Engineer prior to any installation
6. This drawing must be read in conjunction with Mechanical and Electrical performance specifications and all other drawings as issued by the Architect, Structural Engineer and Water/Energy and Consulting Engineers
7. The location of equipment is typical only, The Contractor shall perform all calculations to determine the exact quantity and agree the final locations with the Architect.
8. This drawing shows the intended location of building services plant and service routes in such detail as to indicate the design. The drawing does not show all components that may be necessary to provide a full working installation.
9. The positions of connection points, accessories and building services items are approximate and shown for guidance to assist during the tender process.
10. Fully co-ordinated drawings, Construction drawings and Builderswork drawings shall be produced by the contractor. Under no circumstances shall the tender drawings be used as installation drawings.

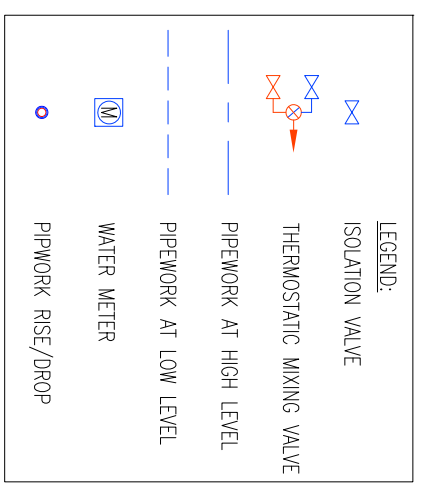

T1	29.01.21	TENDER ISSUE	BS
Rev:	Date:	Status/Amendments:	By:

40 KING STREET, MANCHESTER, M2 6BA
TEL: 0161 434 3103 EMAIL: office@wece.co.uk

Client: **ARTISAN**

Project:
CABLE STREET
ANCOATS
MANCHESTER

Drawing Title:
**MECHANICAL SERVICES
DOMESTIC SERVICES LAYOUT
THIRD FLOOR**

Drawn By: BS	Checked By: DW	Cad By: SB
Scale: 1:50	Paper Size: A1	Date Created: 08 / 04 / 2019
Drawing Number: WECE / 286 / M / 111		Drawing Revision: T1