



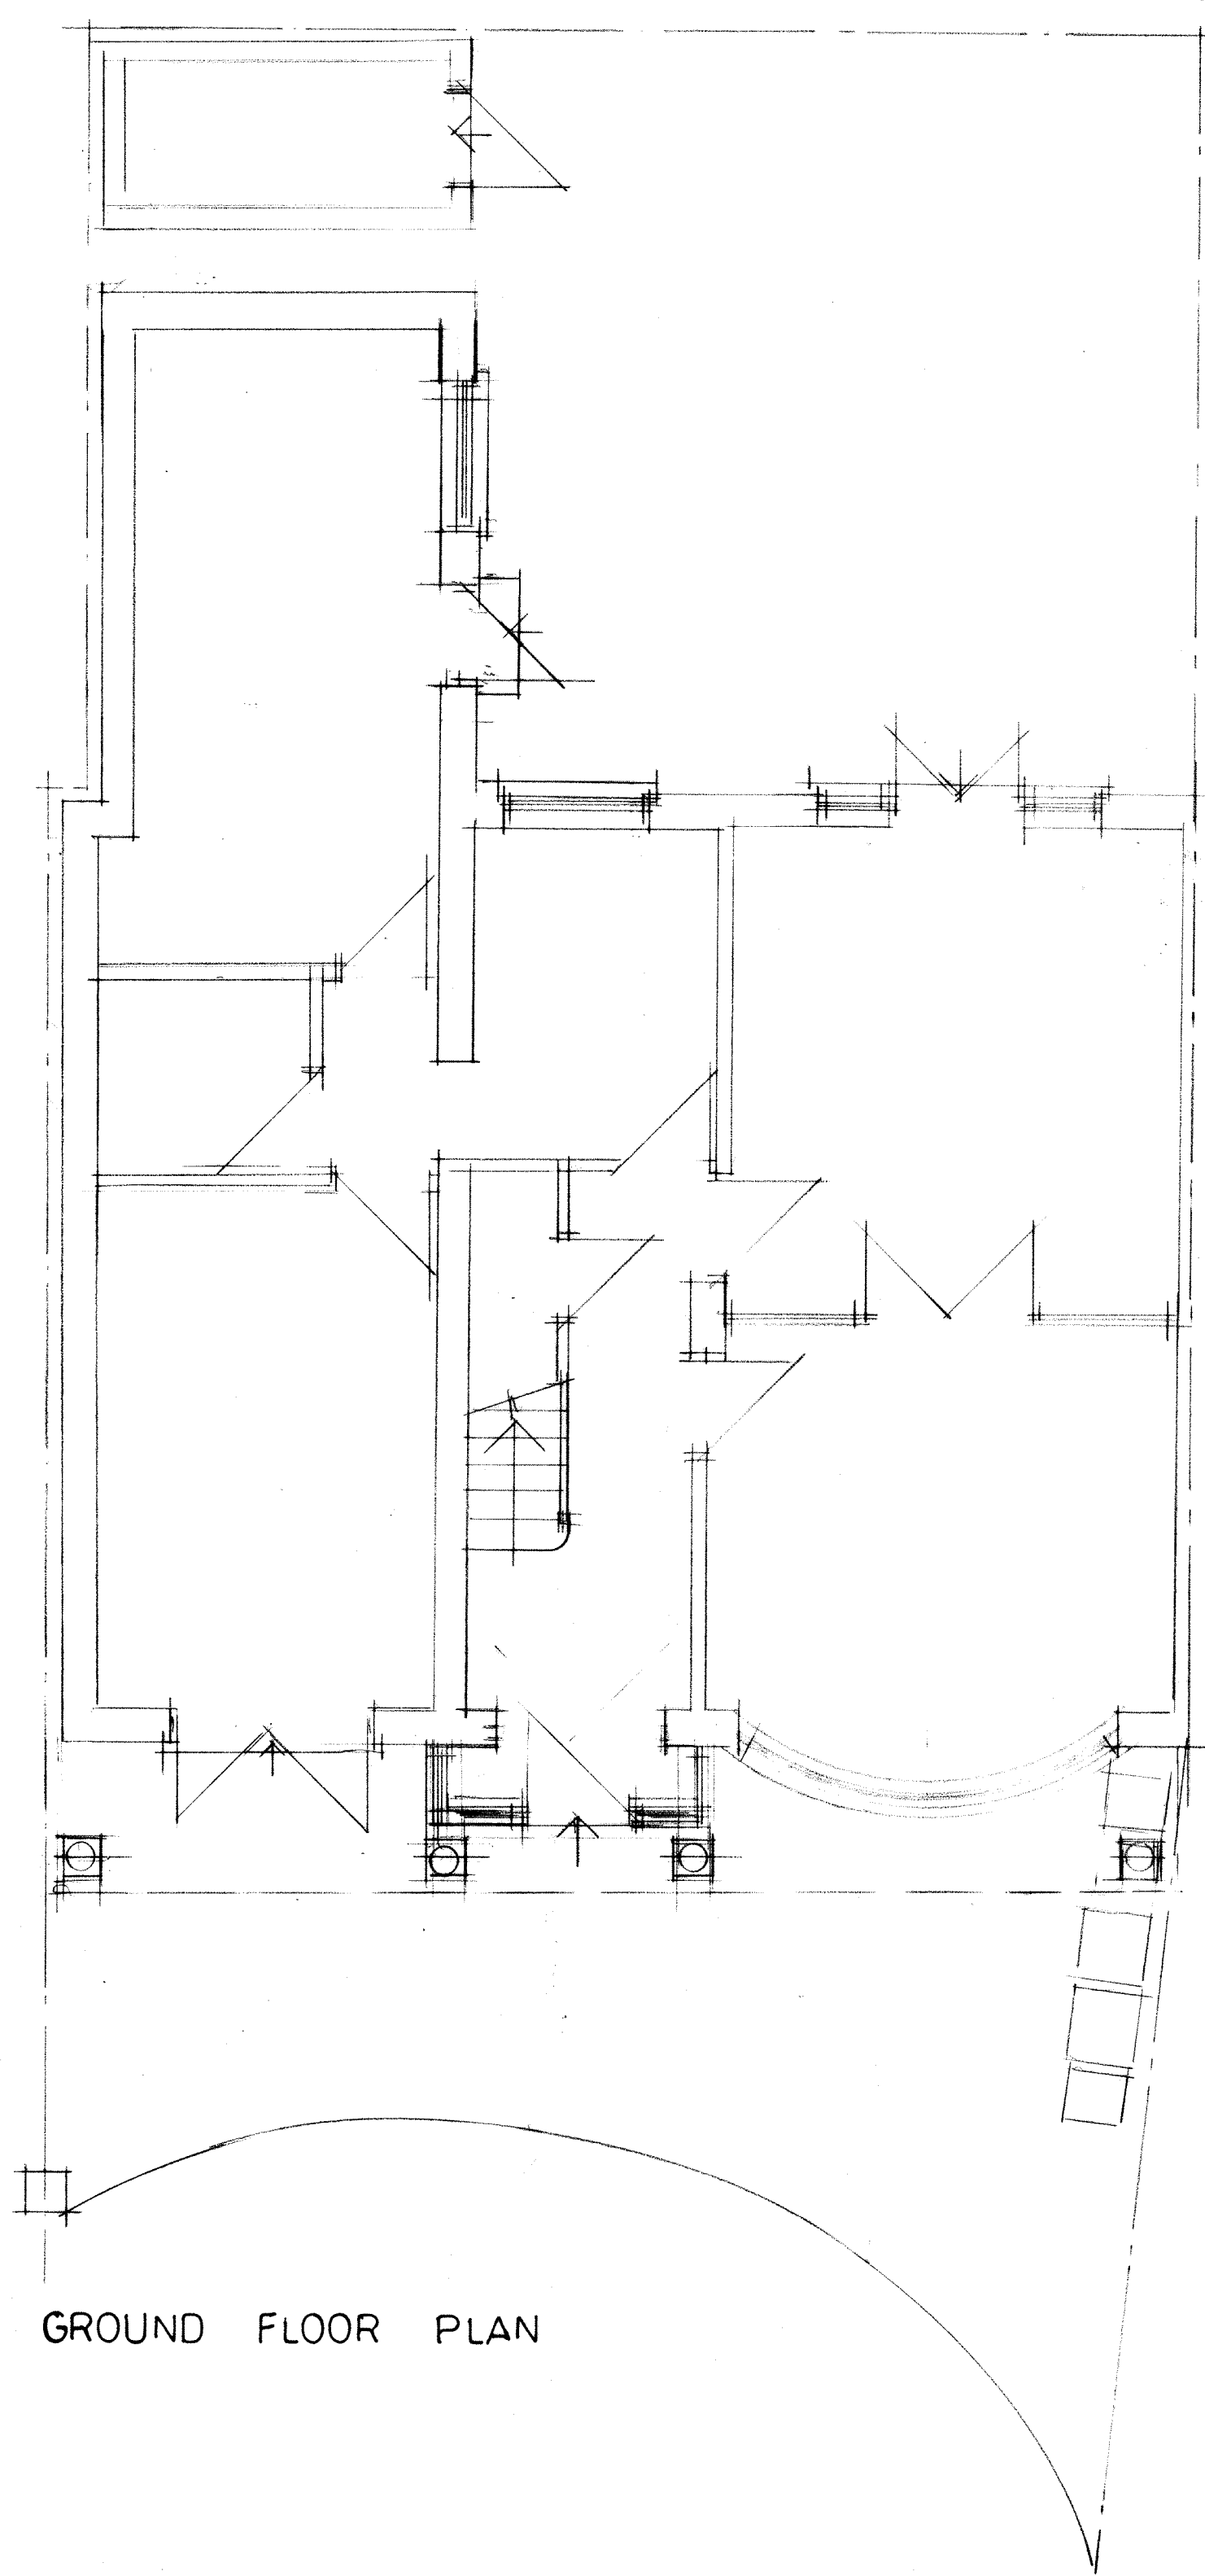

GROUND FLOOR PLAN

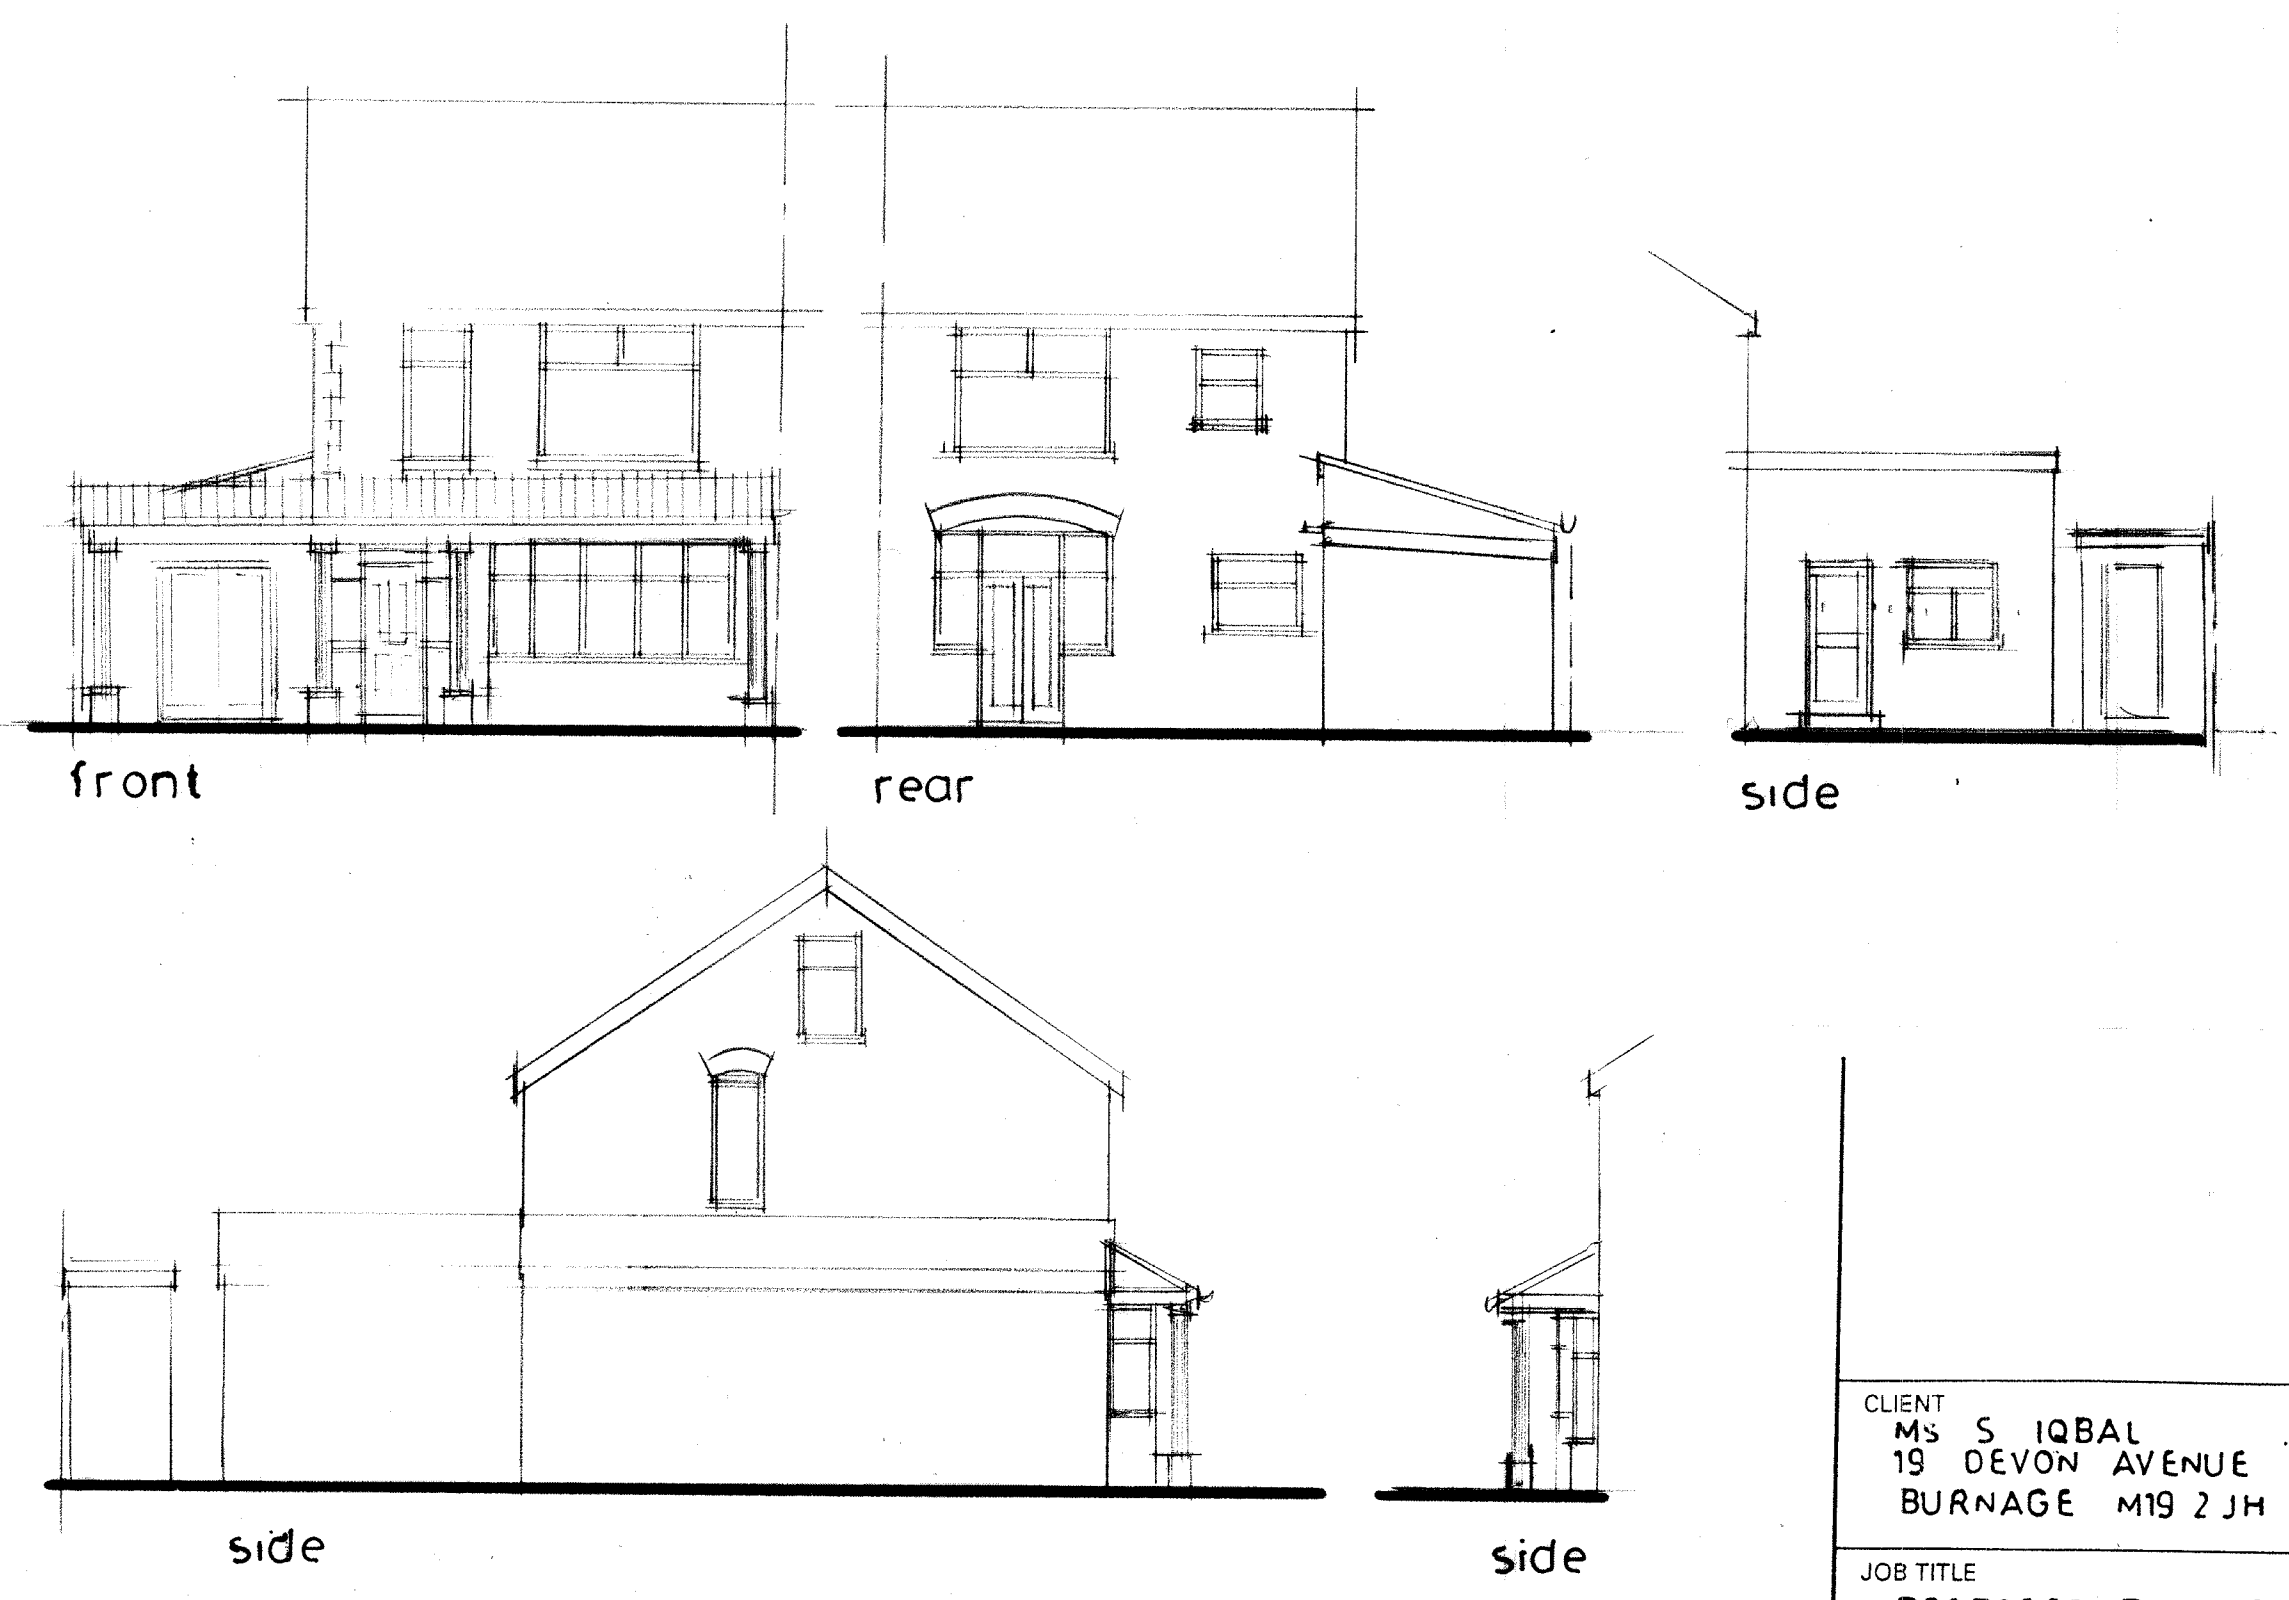

CLIENT
MS S IQBAL
 19 DEVON AVENUE
 BURNAGE M19 2 JH

JOB TITLE
**PROPOSED PLANNING
 EXTENSIONS & PORCH**

DRG. TITLE
**PLANS AND ELEVATIONS
 AS CONSTRUCTED**

**HOLBOROW +
 ORMESHER +
 Limited**
**architectural &
 interior design**

Station House
 Adams Hill
 Knutsford
 Cheshire WA16 6DN
 telephone : 01565 652275
 fax : 01565 750501

ISSUE	ORIGINAL	1	2	3	4	5	6	7
REVISION		A						
DATE		12/10/03						
DRAWN		AO						
CHECKED								
APPROVED								
SCALE		1:50 & 1:100 at A2						
DRAWING NUMBER		1974/20/03 ^A						