
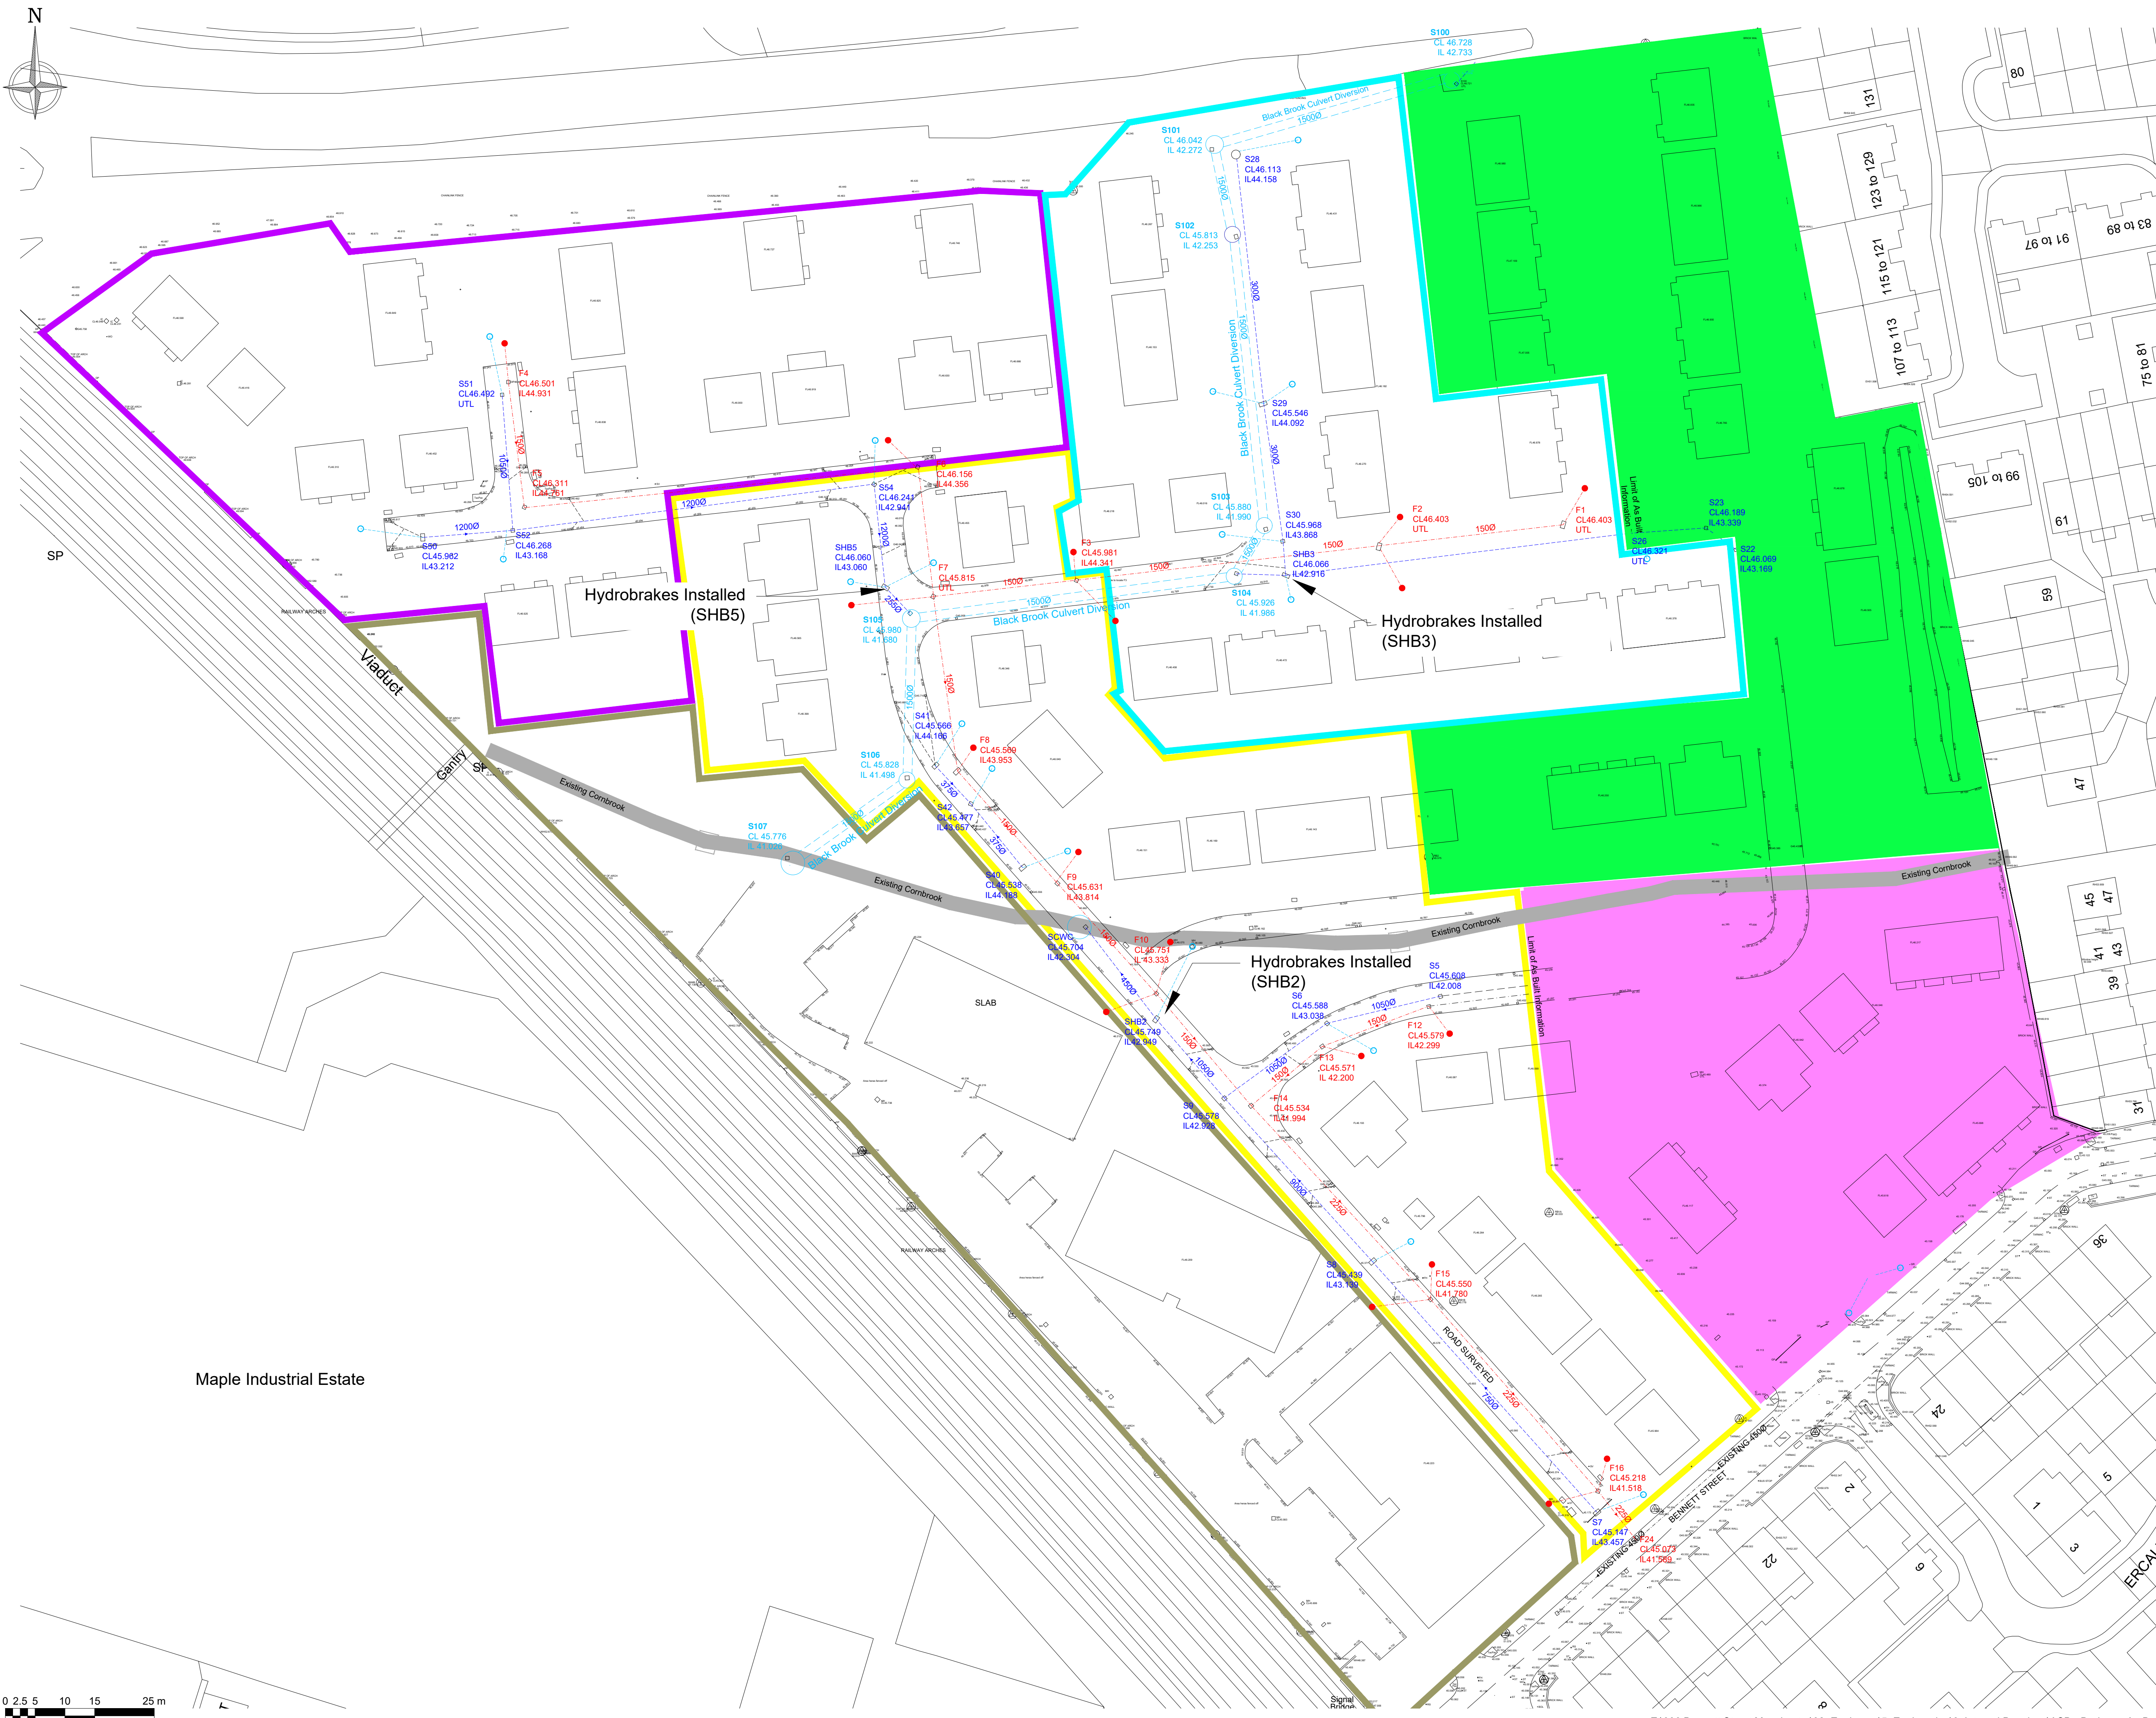


Legend

- Phase 1
- Phase 2
- Phase 3
- Phase 4 (Under Construction)
- Phase 5 (Under Construction)
- Phase 6

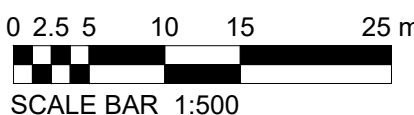

Development			
Bennett Street			
Location			
Manchester			
Marketing Name			
-			
Drawing Title			
Drainage As-Built			
Job No.		Drawing No.	
006		77	
Revision		Scale @ A1	
-		-	
Drawn By		Date	
SE		7/7/2025	
Checked by		Date Checked	
-		-	