



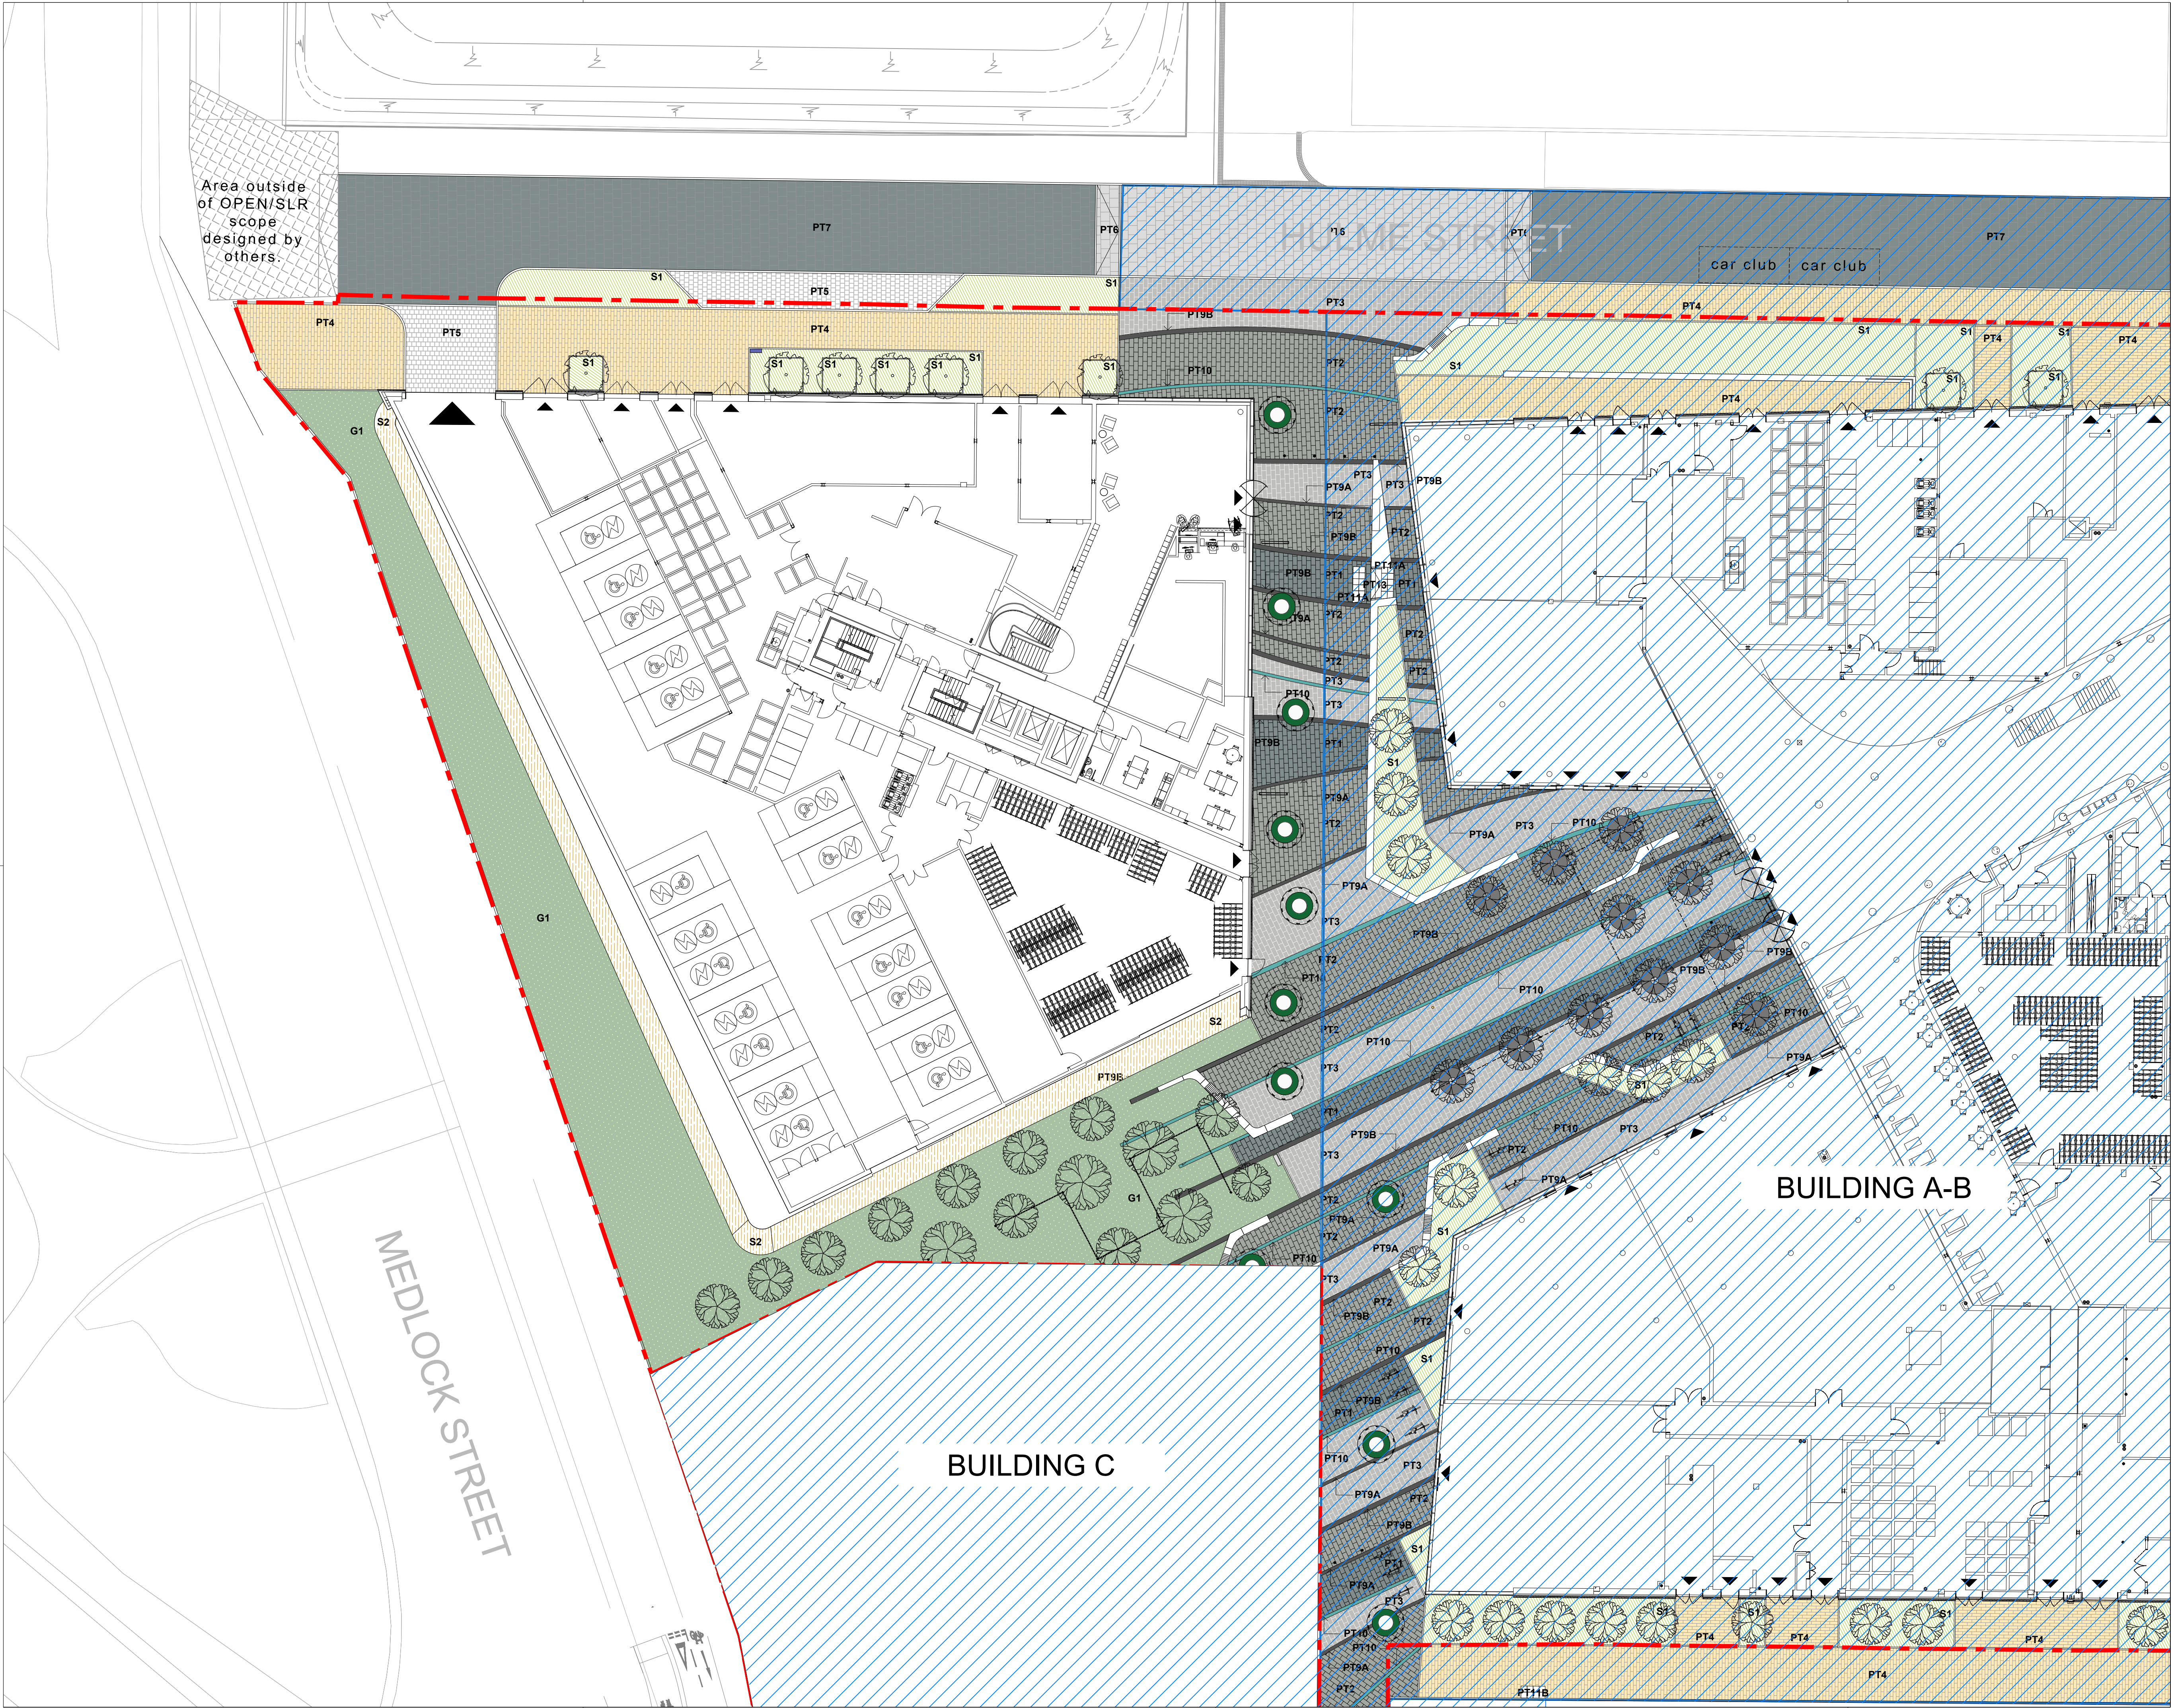

- NOTES
1. This drawing is to be read in conjunction with all other drawings and specifications.
 2. Do not scale off this drawing. Written dimensions to be taken only.
 3. Any discrepancies found between this drawing and other drawings and specifications in the construction documents must be referred to the Landscape Architect prior to work commencing.
 4. This drawing must not be copied in whole or in part without prior written consent of Optimised Environments Ltd.
 5. Survey information is based upon aspect surveyors Topographical as Survey.

CDM INFORMATION

KEY PLAN

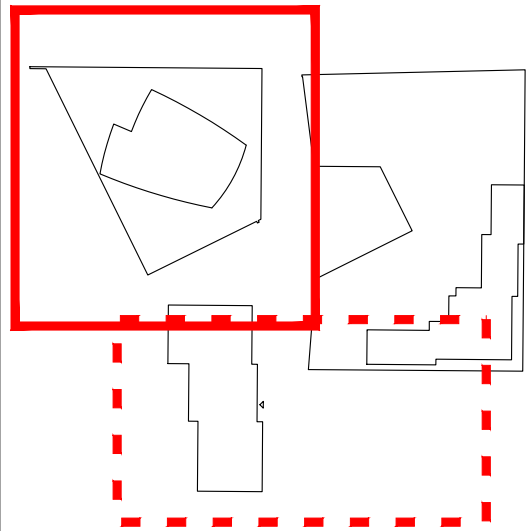

15	AS BUILT	CO	23.08.25
14	Extent of Green Slope Reduced	CO	10.02.25
13	HATCHES UPDATED AS PER ADJACENT	SB	15.11.24
12	DEV		
11	GF UPDATES	AH	14.08.24
10	BOLLARDS ADDED	SB	17.05.24
09	REVISED TREES	SB	19.09.23
08	TREES REINSTATED	SB	23.08.23
07	Architectural Update	CO	03.08.23
06	Architectural Update	CO	19.06.23
05	Architectural Update	CO	27.04.23
04	Furniture Labels Removed	CO	22.02.23
03	Printing Issue	CO	04.01.23
02	STAGE 4 UPDATE	CO	15.12.22
01	STAGE 4	CO	31.10.22
A	Additional streetscape planting. Coordination with building.	AW	11.02.22


Issue	Revision	Initial	Date
-------	----------	---------	------

open
optimised environments
optimised environments ltd
2nd Floor | Quarterline Two | 2 Lister Square | Edinburgh | EH3 9GL
t: 0131 221 9830 | e: optimisedenvironments.com
LONDON | Wanford Court | 23 Throgmorton Street | London | EC2N 2AT
t: 020 79474562 | e: optimisedenvironments.com
MANCHESTER | 13 Swan Street | Manchester | M4 5JZ
t: 0161 696 7550 | e: optimisedenvironments.com

Client
Downing Living (Manchester) Ltd

Project
PLOT 11 FIRST STREET SOUTH
Manchester

Drawing Title
**BUILDING D GENERAL
ARRANGEMENT PUBLIC REALM**
SHEET 1 OF 1

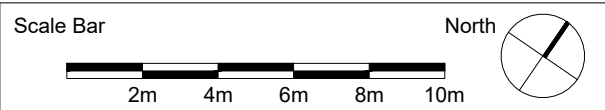

Scale: 1:200@A1 Date: Jan 2022

By: CO Status: AS BUILT

Checked: AW Approved: AW

Drawing Number
M90183_D_L200 Rev
15

Computer File: R:\Projects\2019\M90183_First\SCAD\AUTOCAD\SHEETS\PHASE 0