
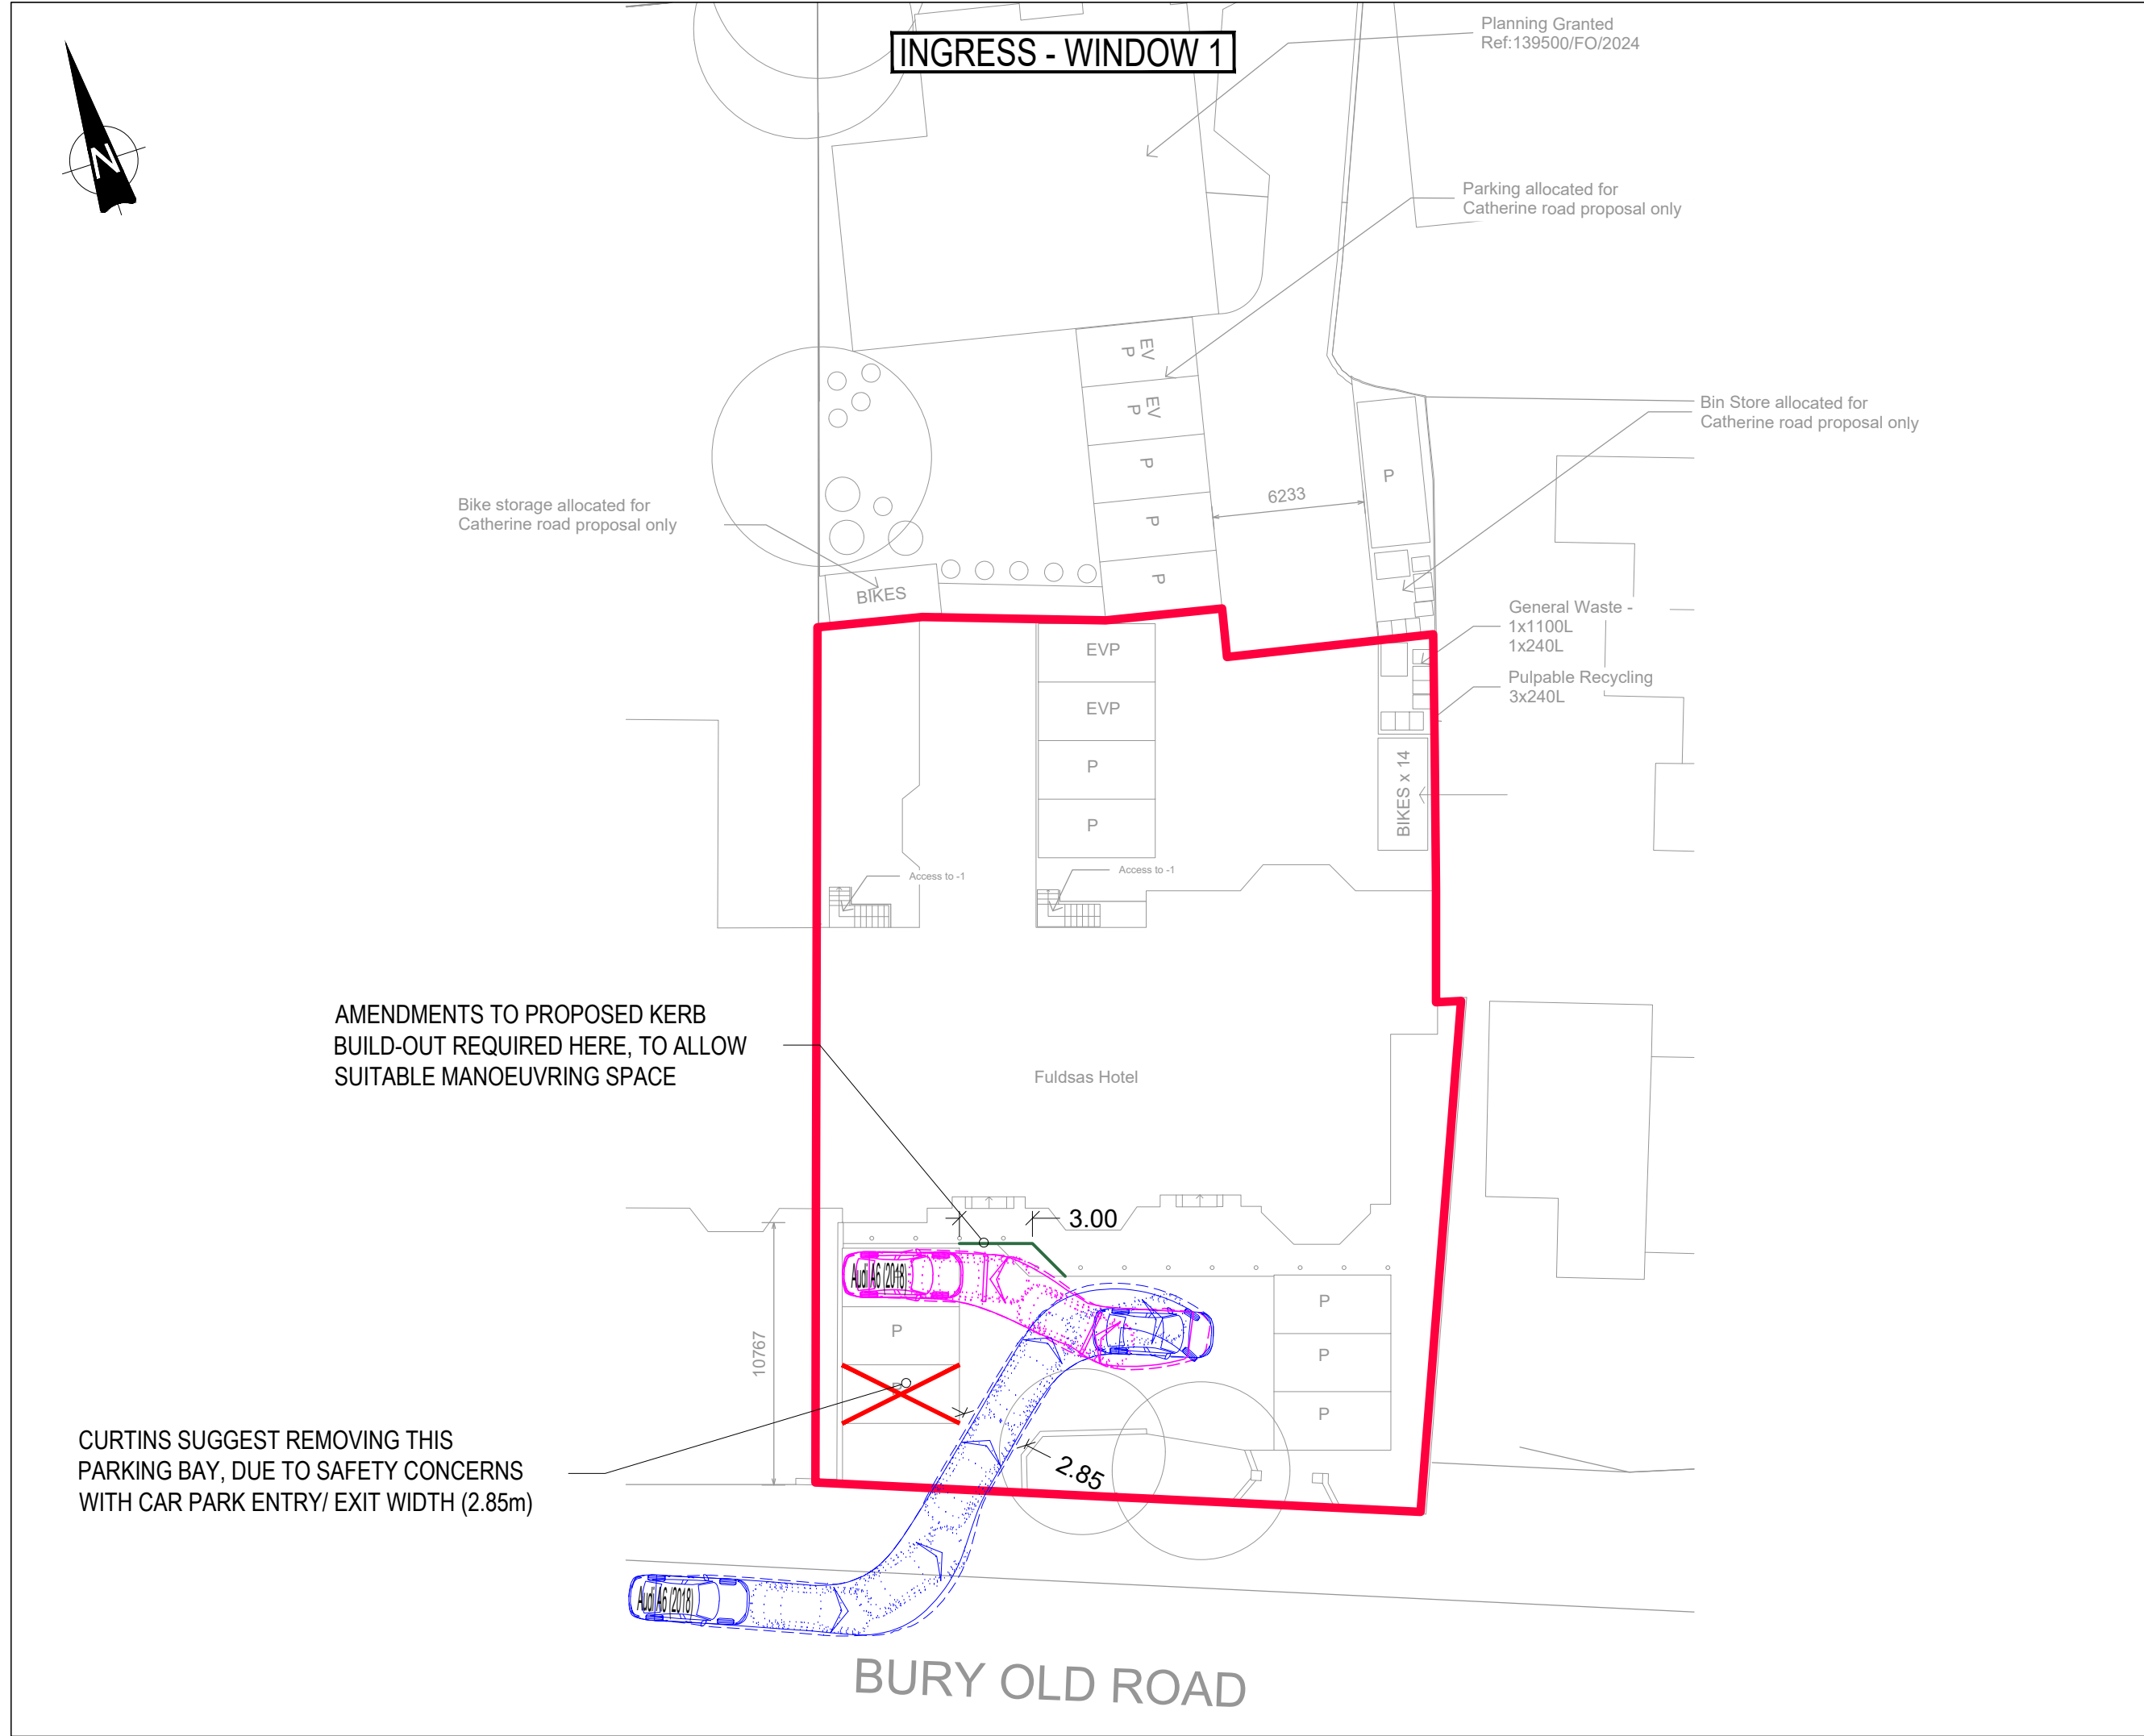
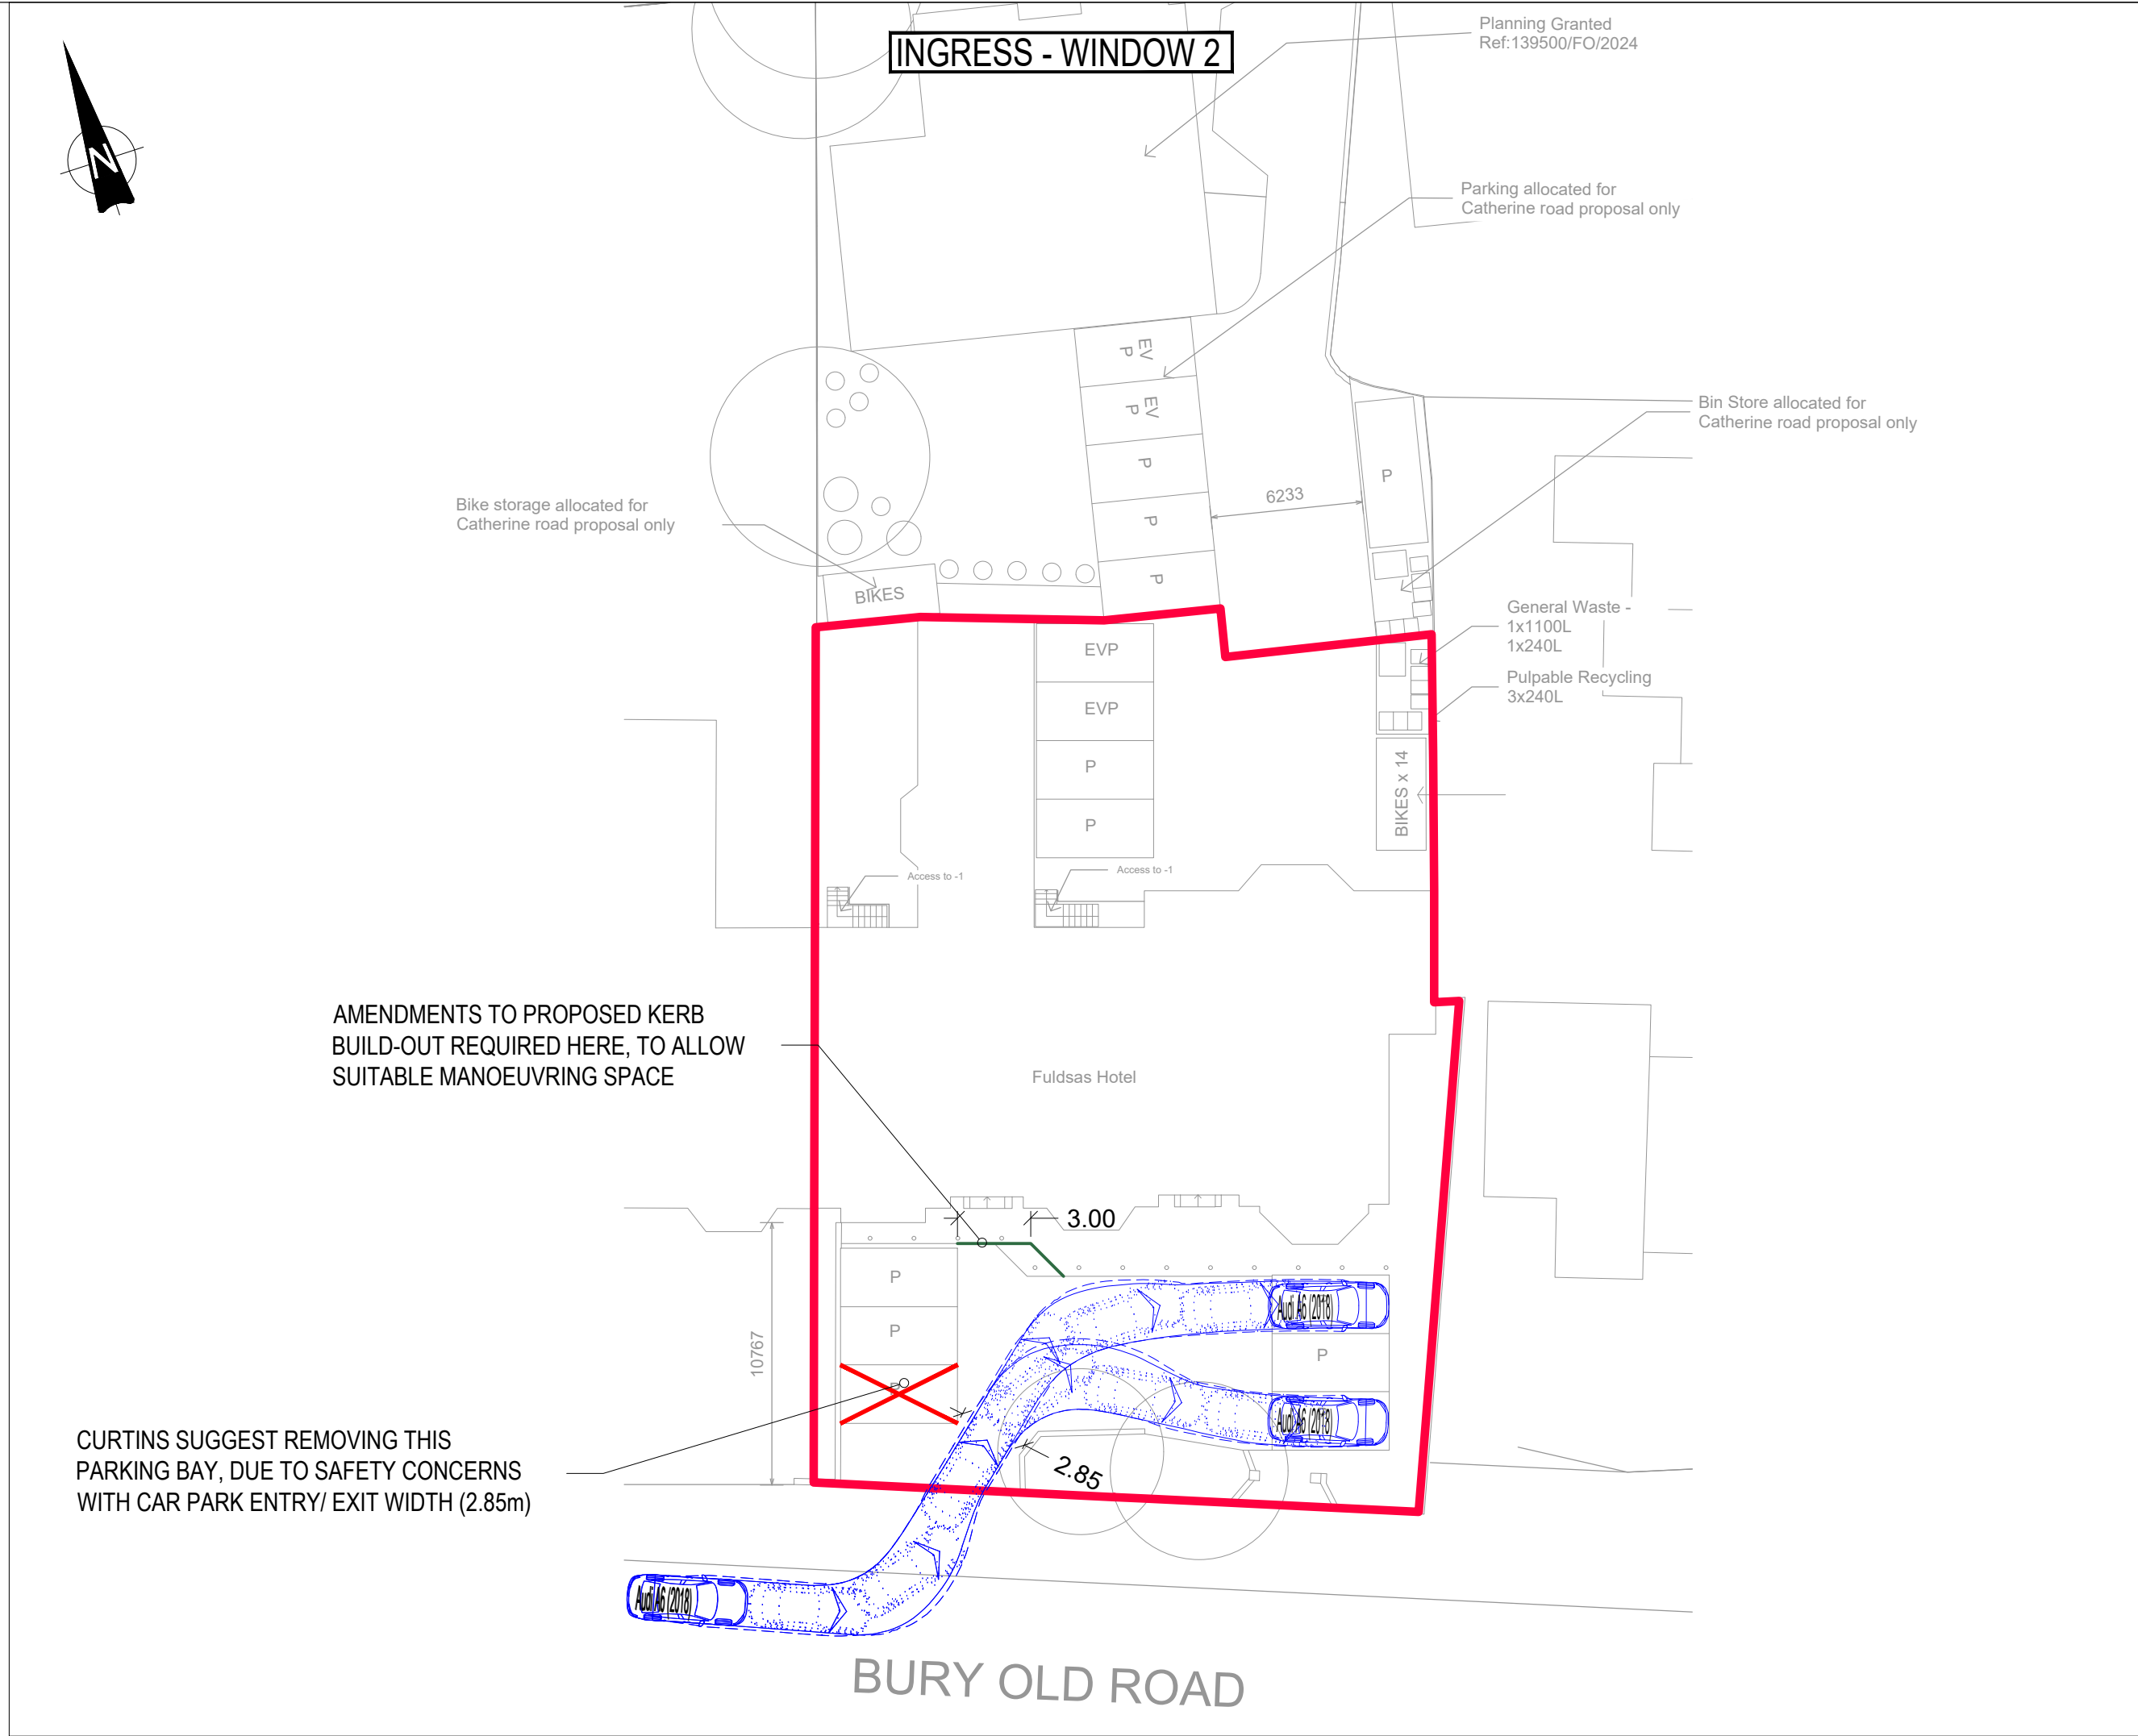
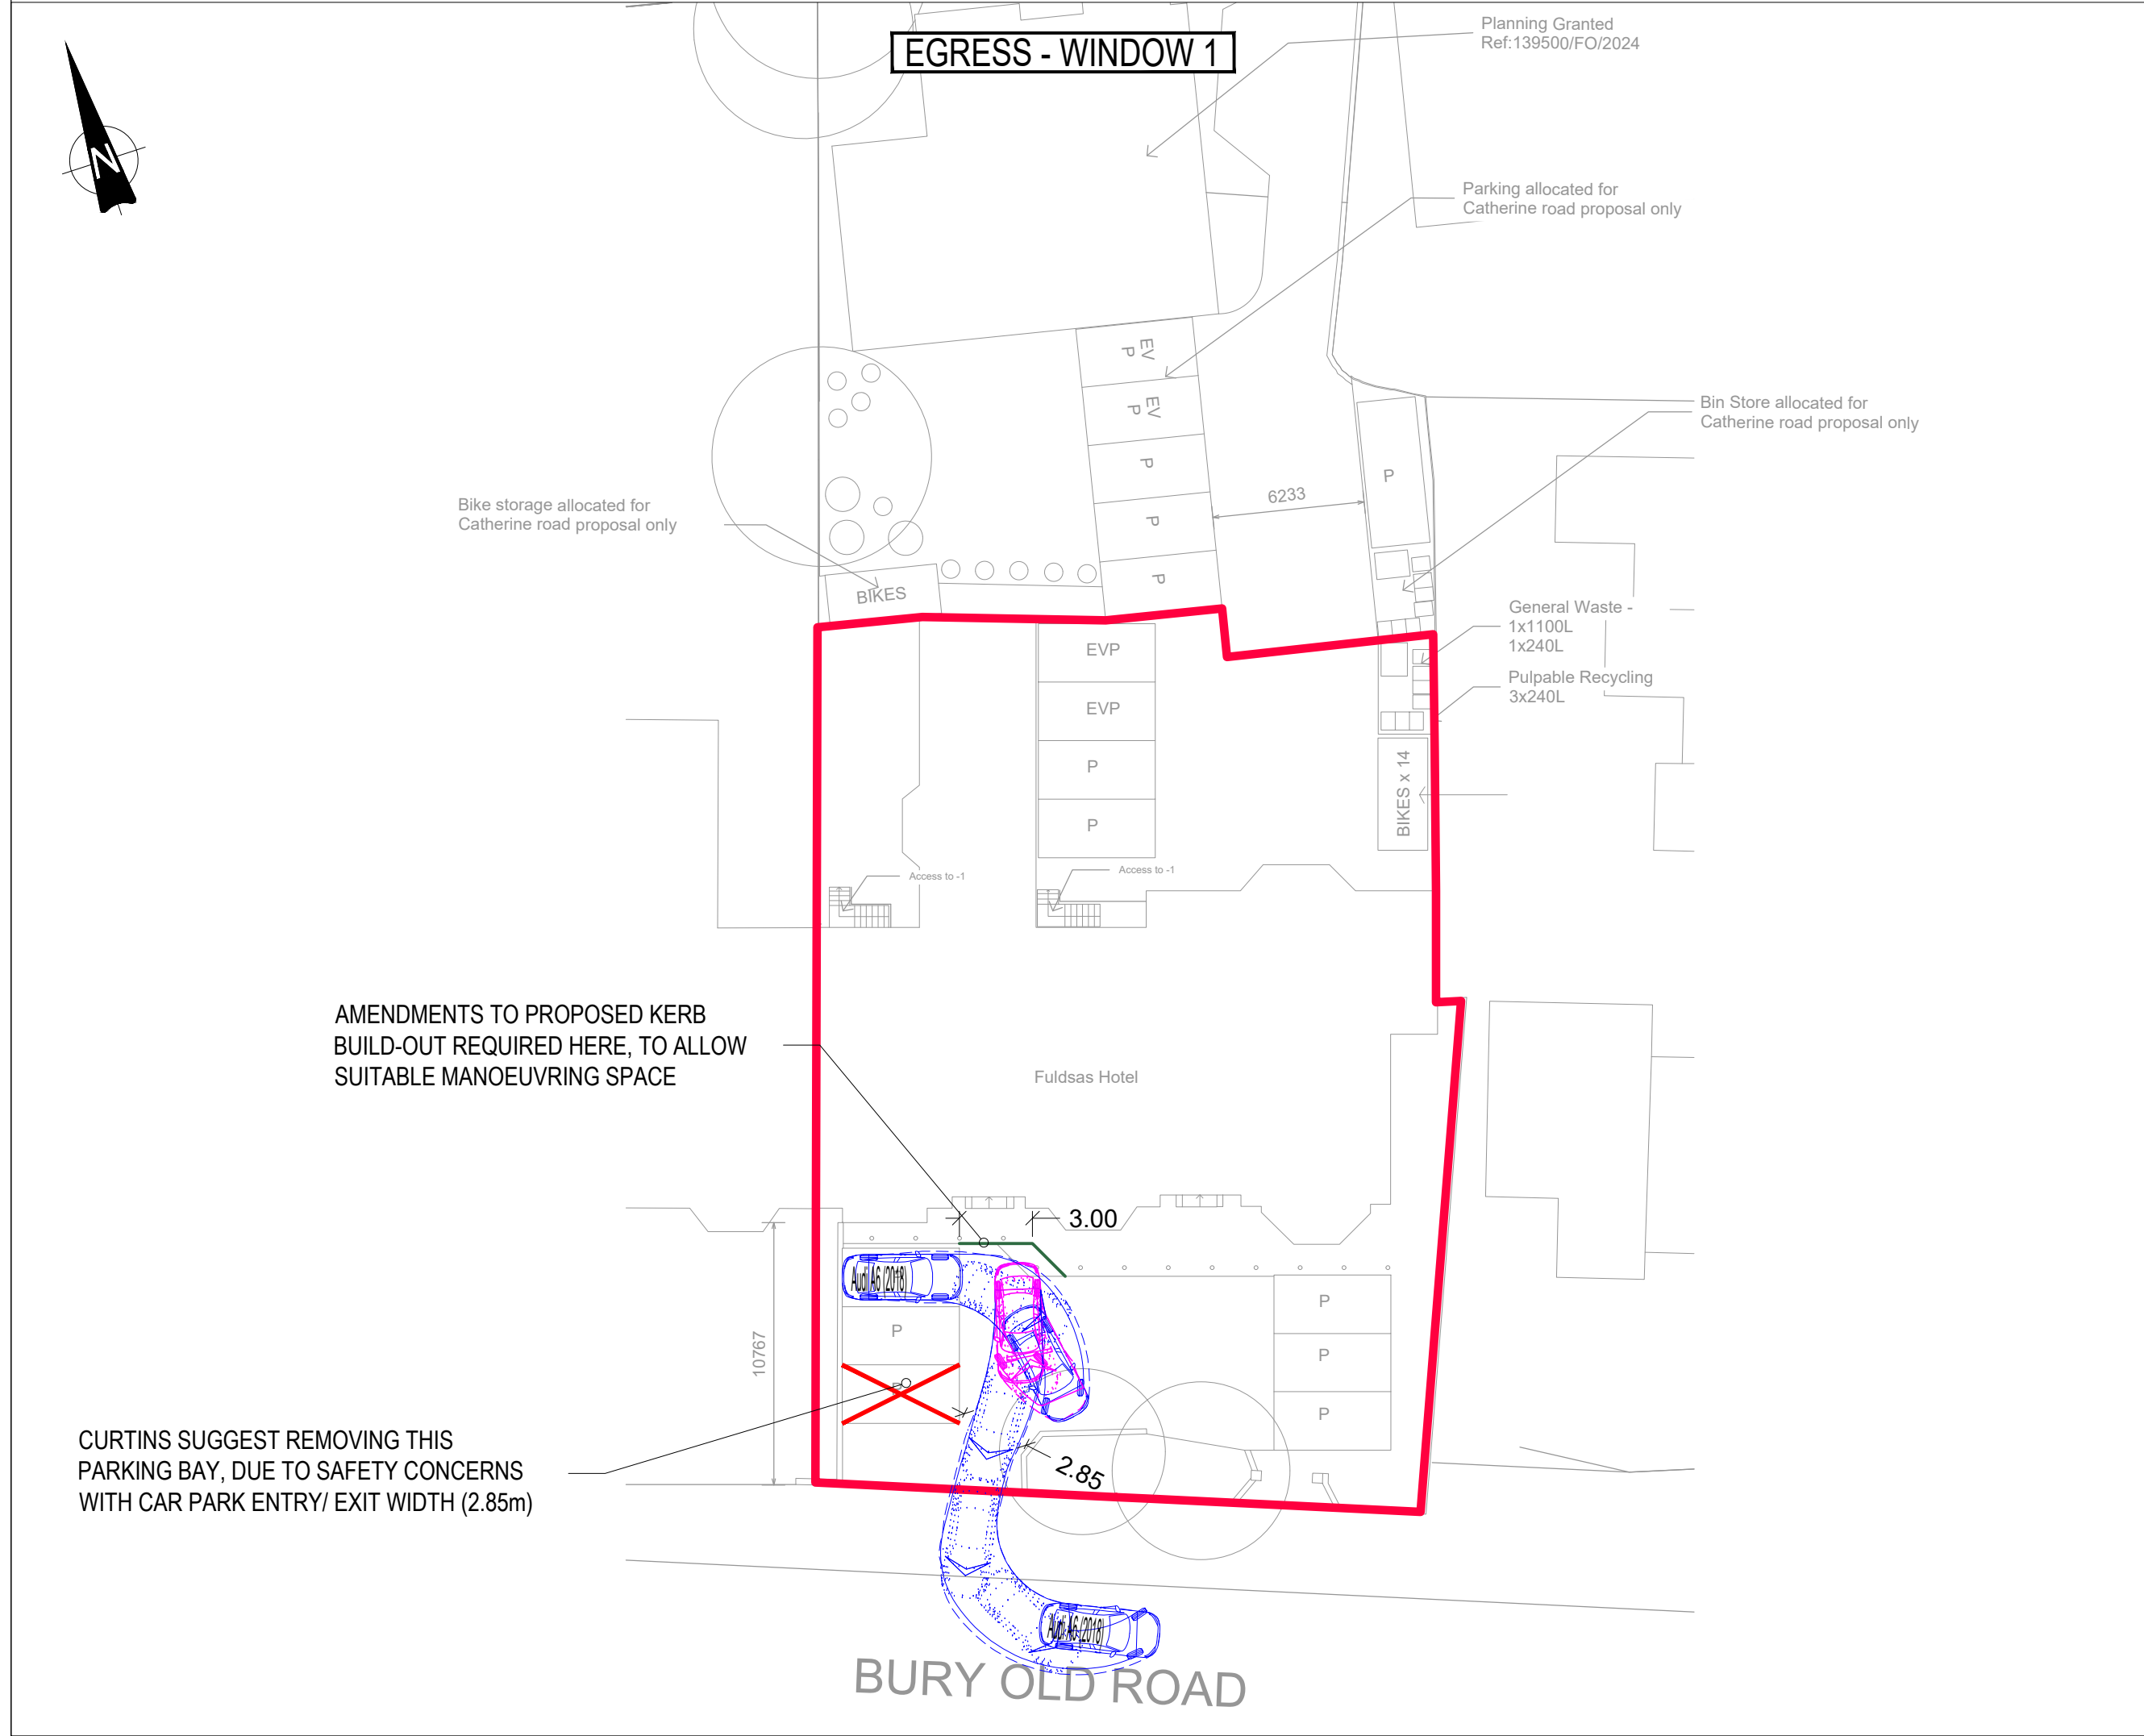


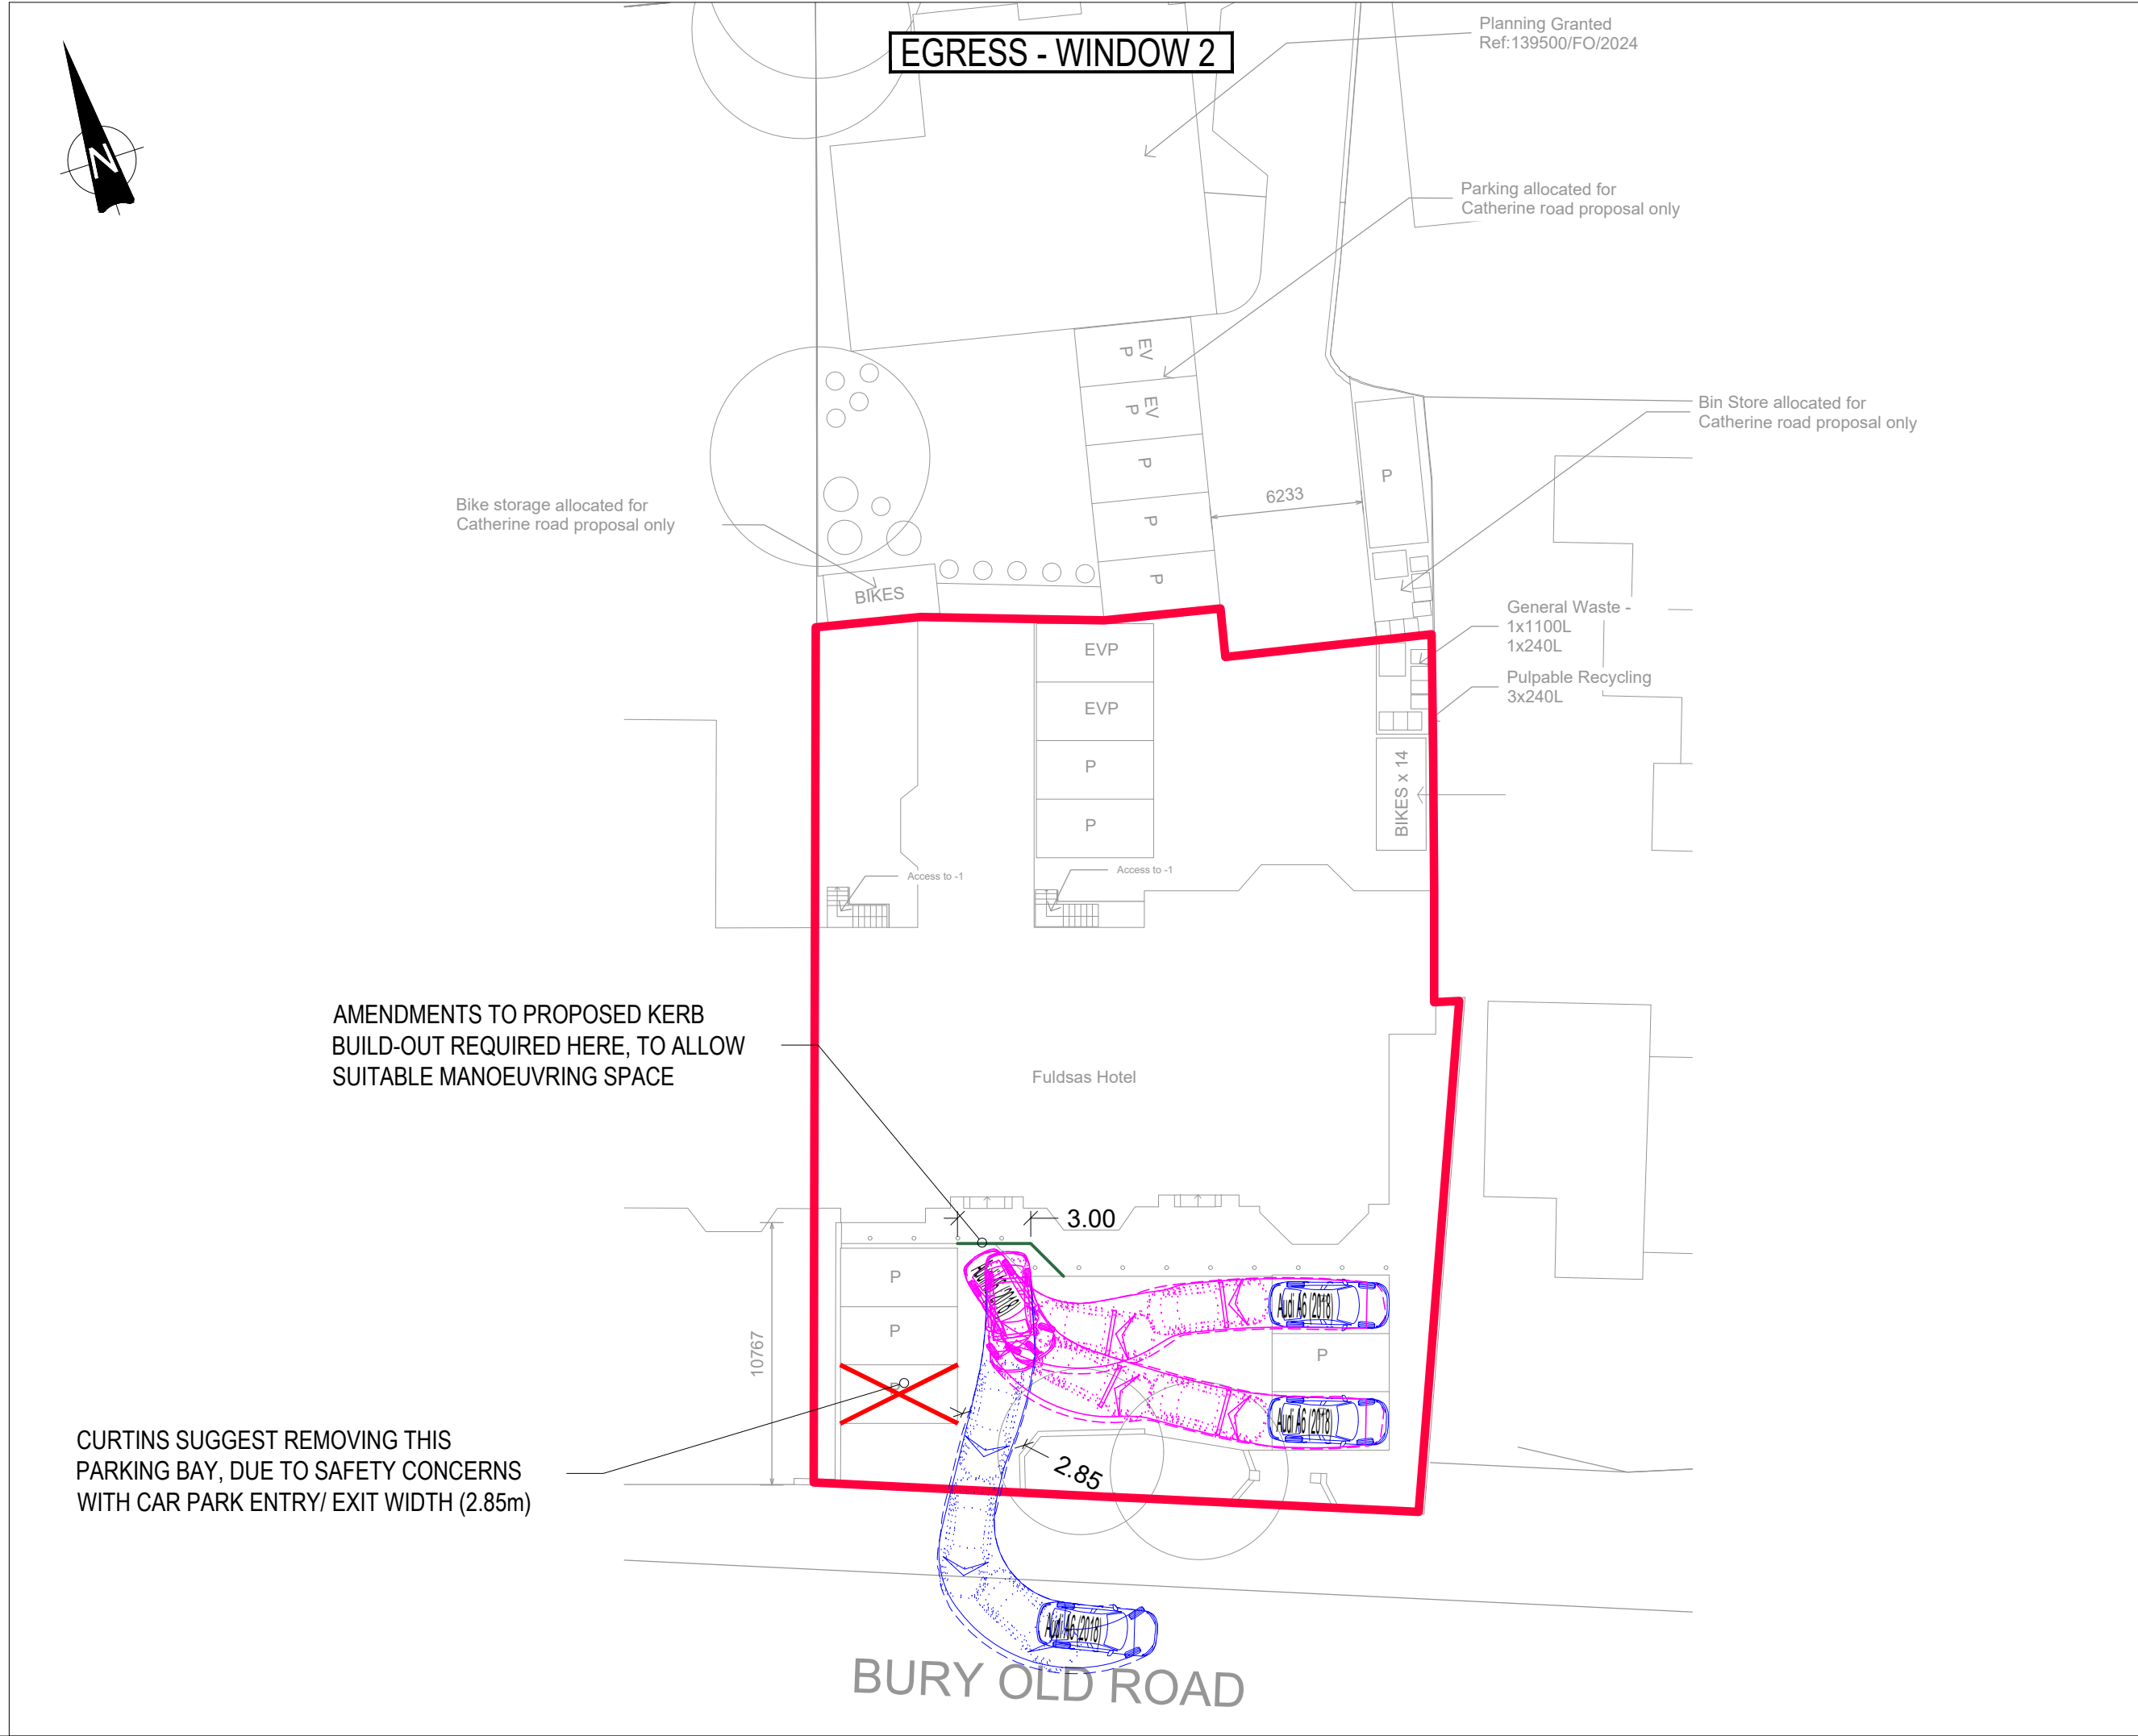

GENERAL NOTES:

- THIS DRAWING IS TO BE READ IN CONJUNCTION WITH ALL RELEVANT ARCHITECTS AND ENGINEERS DRAWINGS AND SPECIFICATIONS.
- DO NOT SCALE THIS DRAWING. ANY AMBIGUITIES, OMISSIONS AND ERRORS ON DRAWINGS SHALL BE BROUGHT TO THE ENGINEERS ATTENTION IMMEDIATELY. ALL DIMENSIONS MUST BE CHECKED / VERIFIED ON SITE.
- ALL DIMENSIONS ARE IN METRES UNLESS NOTED OTHERWISE.
- FOR GENERAL NOTES REFER TO DRAWING.
- THE CONTENT OF THIS DRAWING IS FOR INDICATIVE INFORMATION ONLY AND NOT SUITABLE FOR CONSTRUCTION PURPOSES
- BASED ON ARCHITECT'S LAYOUT. DRAWING REFERENCE: 'GSS23157-4 - Fuldas Hotel - Central Entrance-Sheet - 502.1'
- PARKING BAYS PROPOSED AT 2.4 x 4.8m THROUGHOUT.

KEY: — RED LINE BOUNDARY
— PROPOSED RAISED KERB

VEHICLE PROFILE:

Audi A6 (2018)
Overall Length 4.93m
Overall Width 2.11m
Overall Body Height 1.42m
Min Body Ground Clearance 0.14m
Max Track Width 1.82m
Lock to lock time 4.0m
Kerb to kerb turning Radius 5.90m

Rev:	Description:	Date:	By:	Chkd:	
<h1>Curtins</h1> <p>Merchant Exchange, 17-19 Whitworth Street West, Manchester, M1 5WG 0161 236 2394 manchester@curtins.com www.curtins.com</p> <p><small>Civils & Structures • Transport Planning • Environmental • Infrastructure • Geotechnical • Conservation & Heritage • Principal Designer Birmingham • Bristol • Cambridge • Cardiff • Douglas • Dublin • Edinburgh • Glasgow • Kendal • Leeds • Liverpool • London • Manchester • Nottingham</small></p>					
Status:	PRELIMINARY				
Project:	FULDAS HOTEL - MANCHESTER				
Orig Title:	SWEPT PATH ANALYSIS LARGE CAR SOUTHERN CAR PARK				
Drawn By	JM	Designed By	JM	Checked By	AT
		Date	16/12/24	Scales @ A1	1:250
Project No - Originator - Function - Spatial - Form - Discipline - Number					Revision
87040 - CUR - XX - 00 - D -TP- 05002					P01

\\msfs-11\Projects\87040 - 088000087040 - TP\MA Fuldas Hotel\04 Production\AA Models Drawings\TP CAD\05