



DESIGN INTENT DRAWING ONLY.
ANY CONSTRUCTION MUST COMPLY
WITH ALL APPLICABLE BUILDING
REGULATIONS.


ALL DIMENSIONS IN MM.

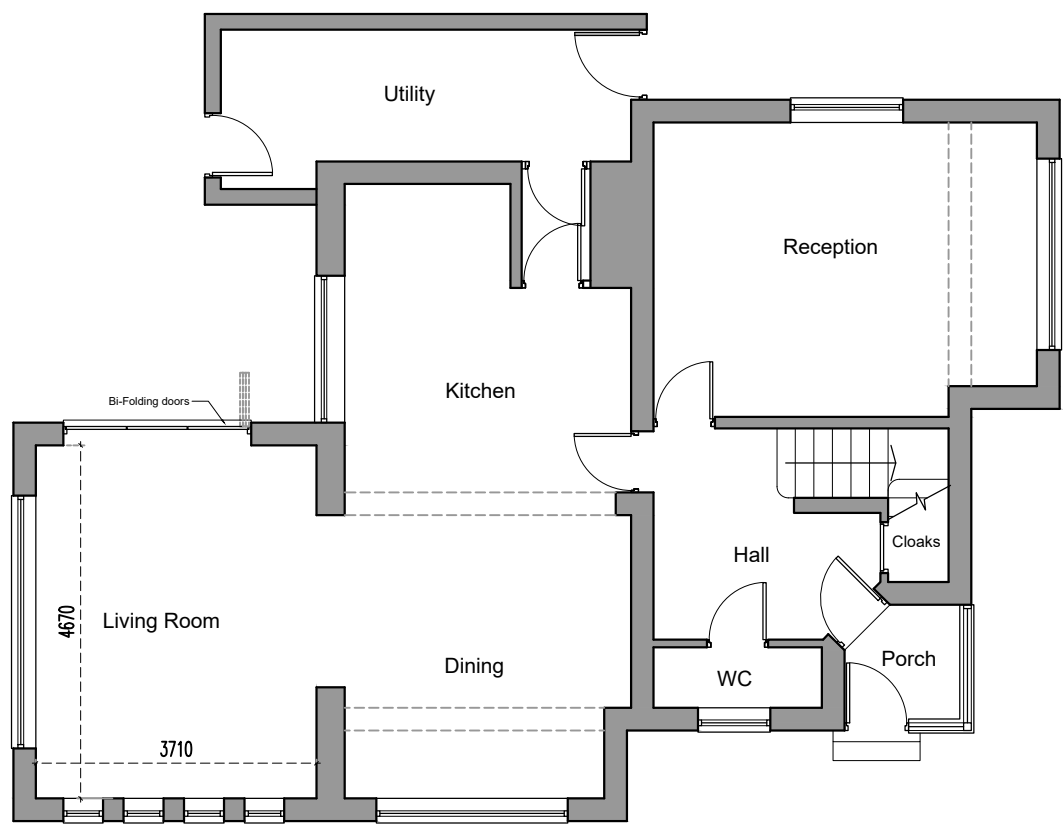

Existing Ground Floor Plan

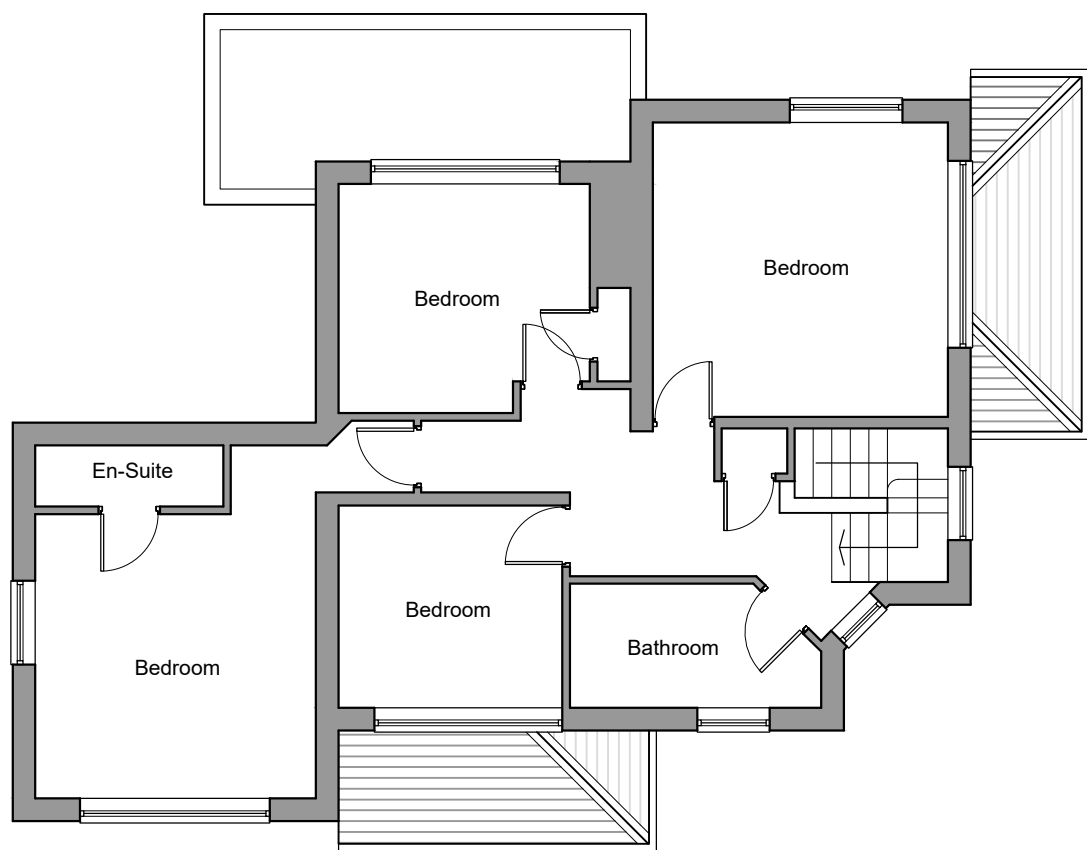


Existing First Floor Plan

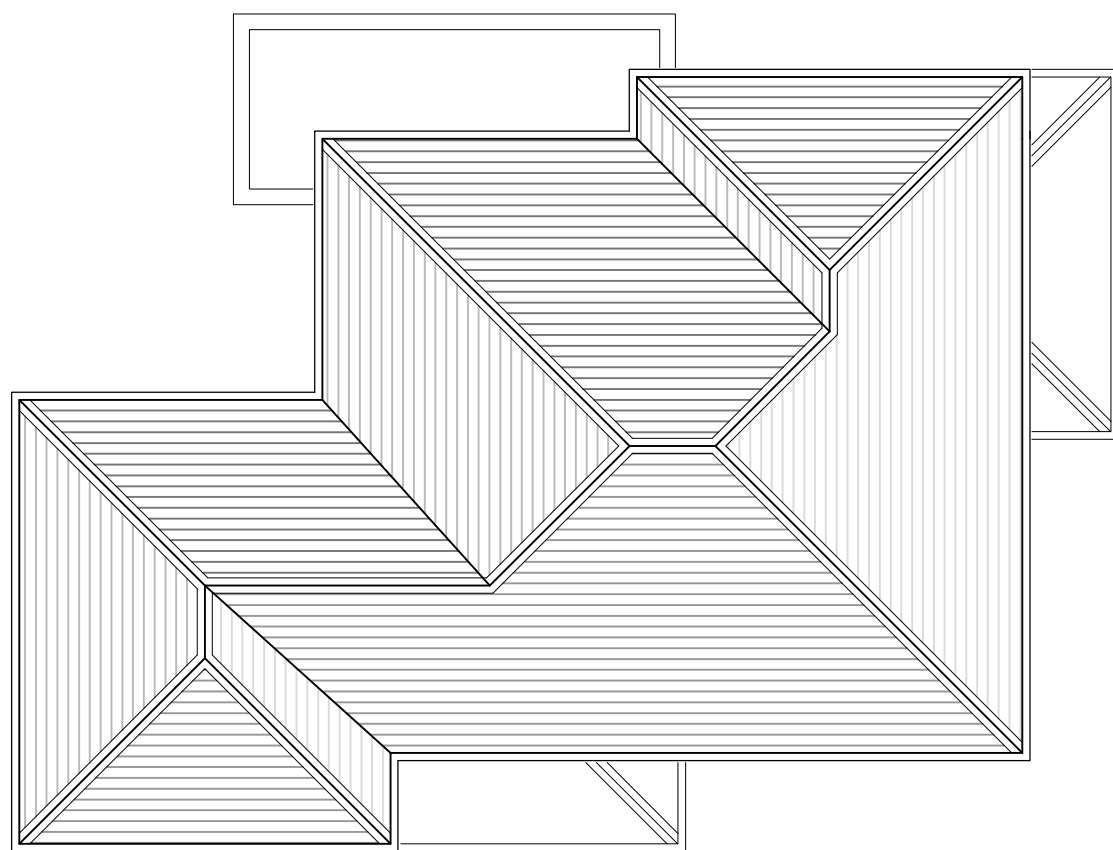


Existing Roof Plan




Existing Front Elevation

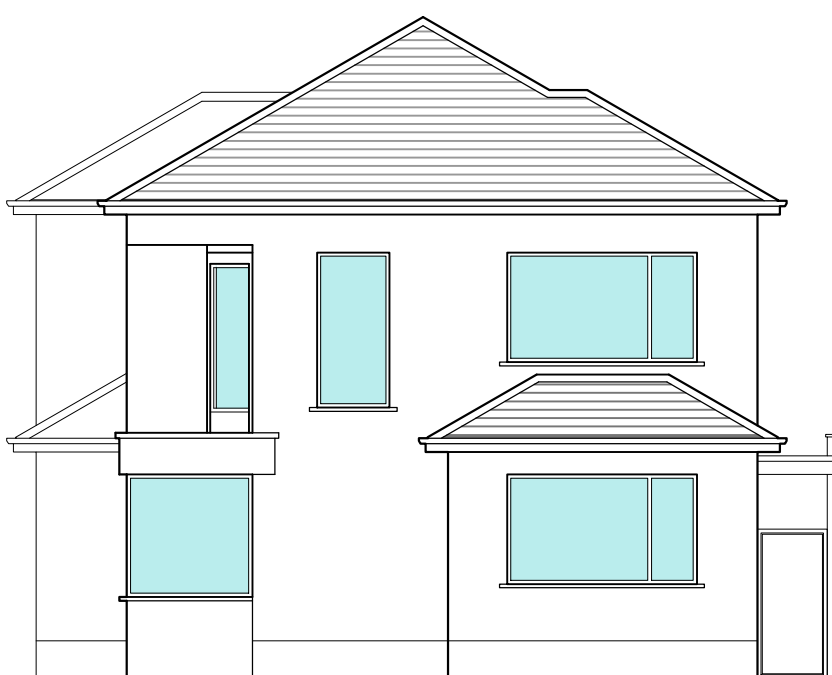


Existing Elevation Facing Spinney Road

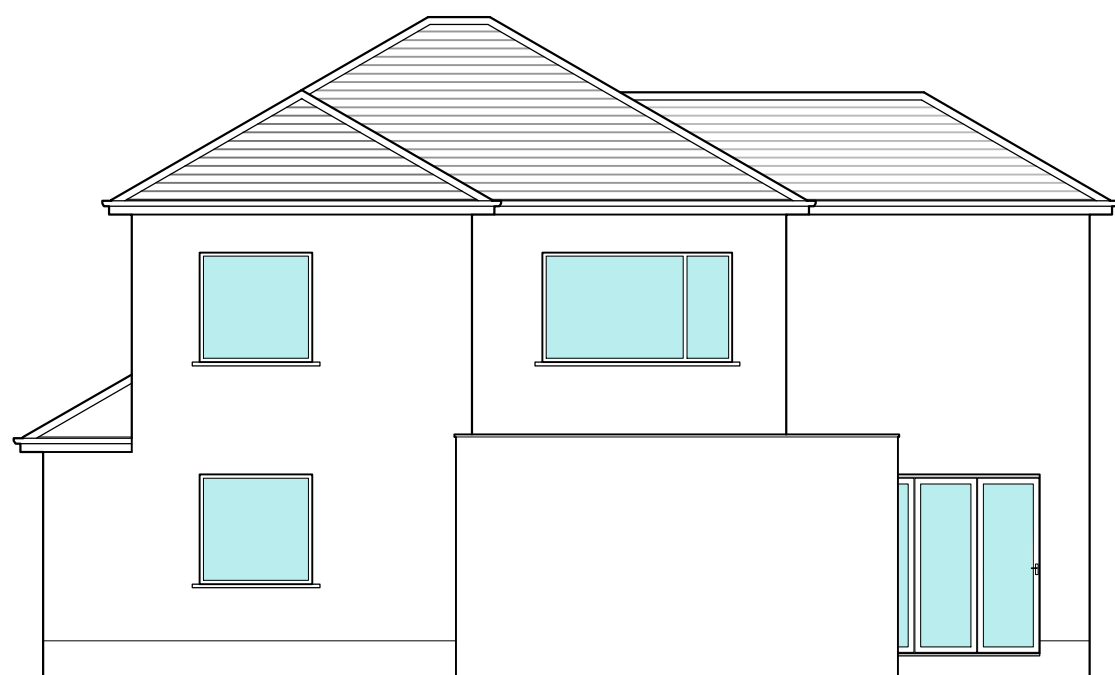


Existing Rear Elevation

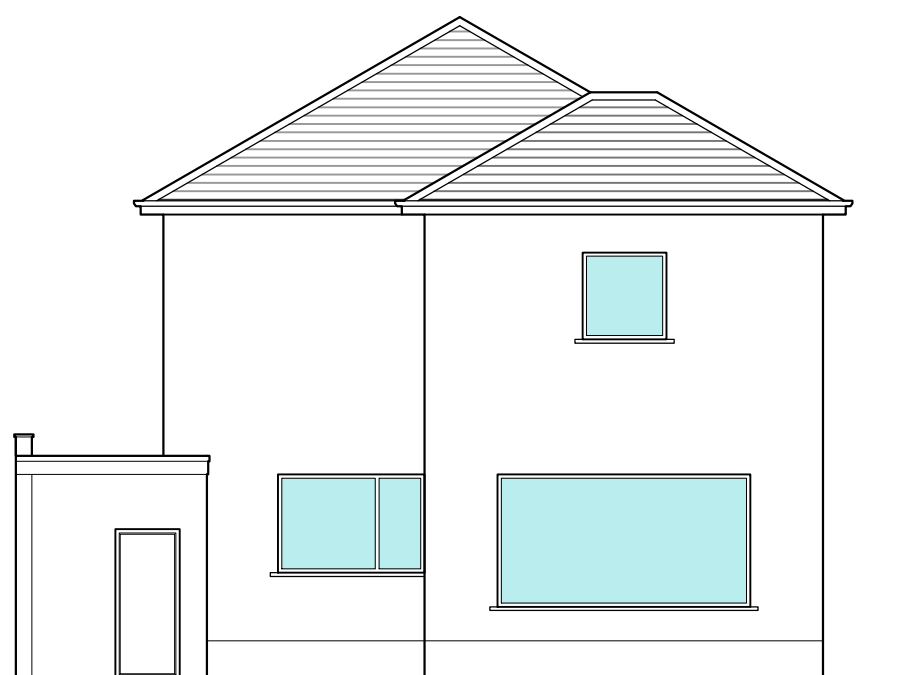


Existing Elevation Facing Garden

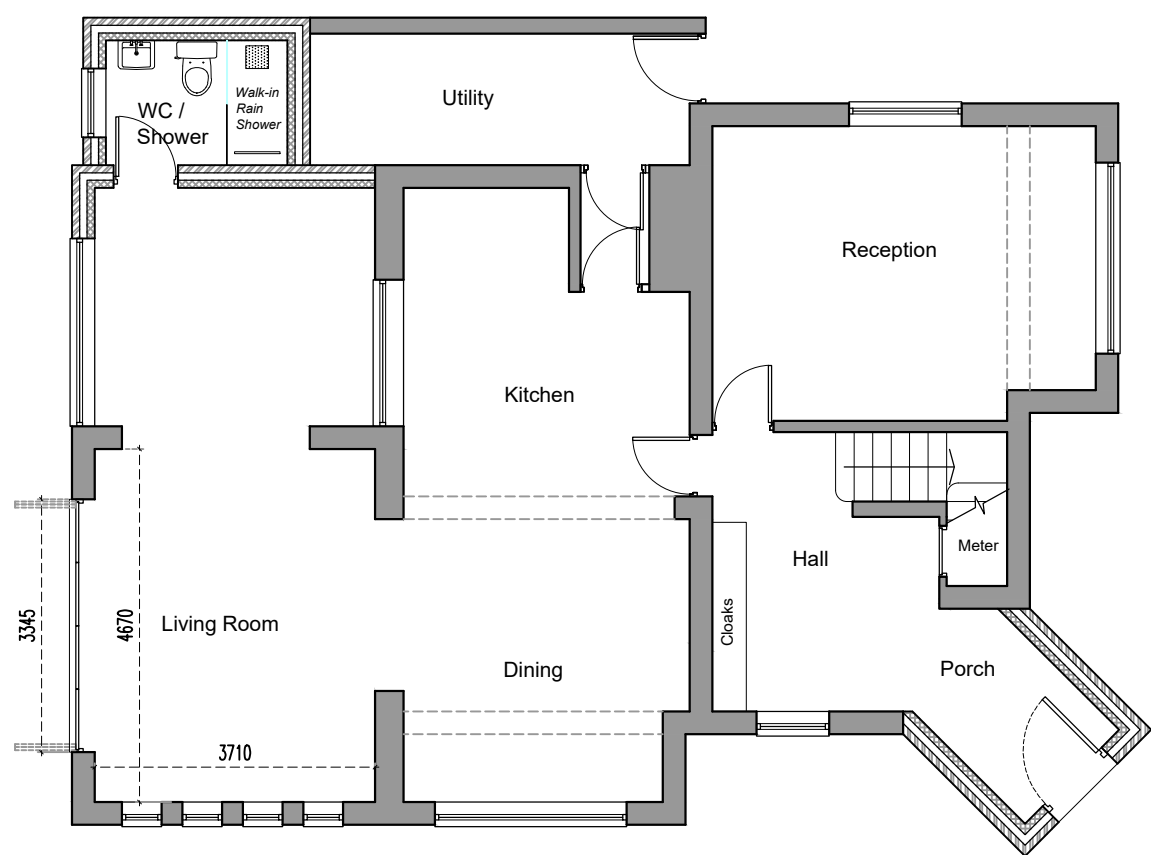


Proposed Ground Floor Plan

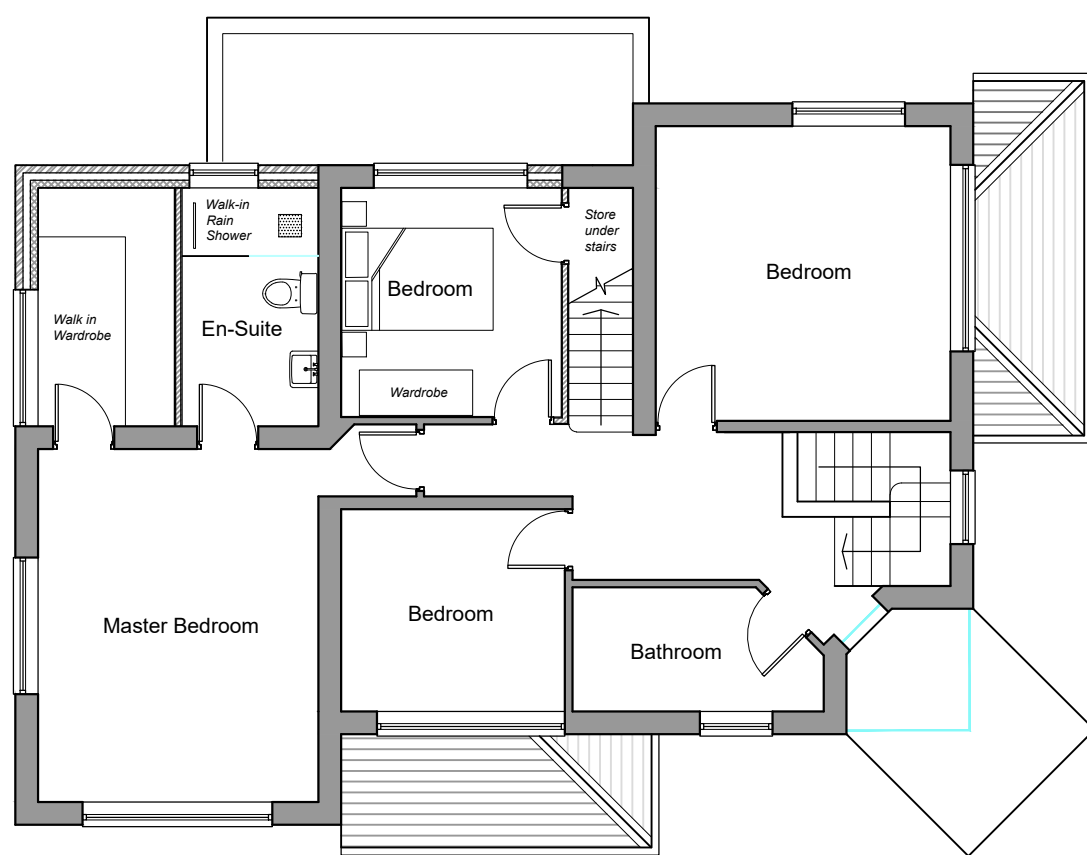

Proposed First Floor Plan

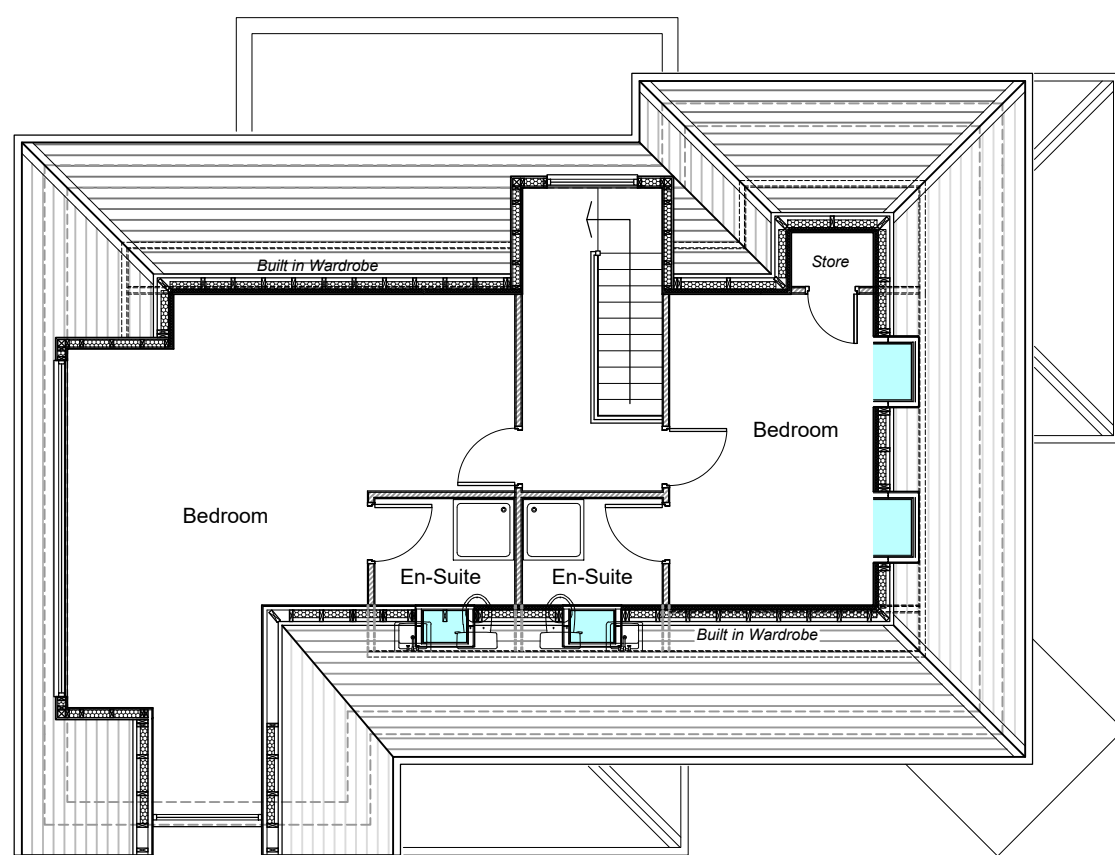

Proposed Loft Plan

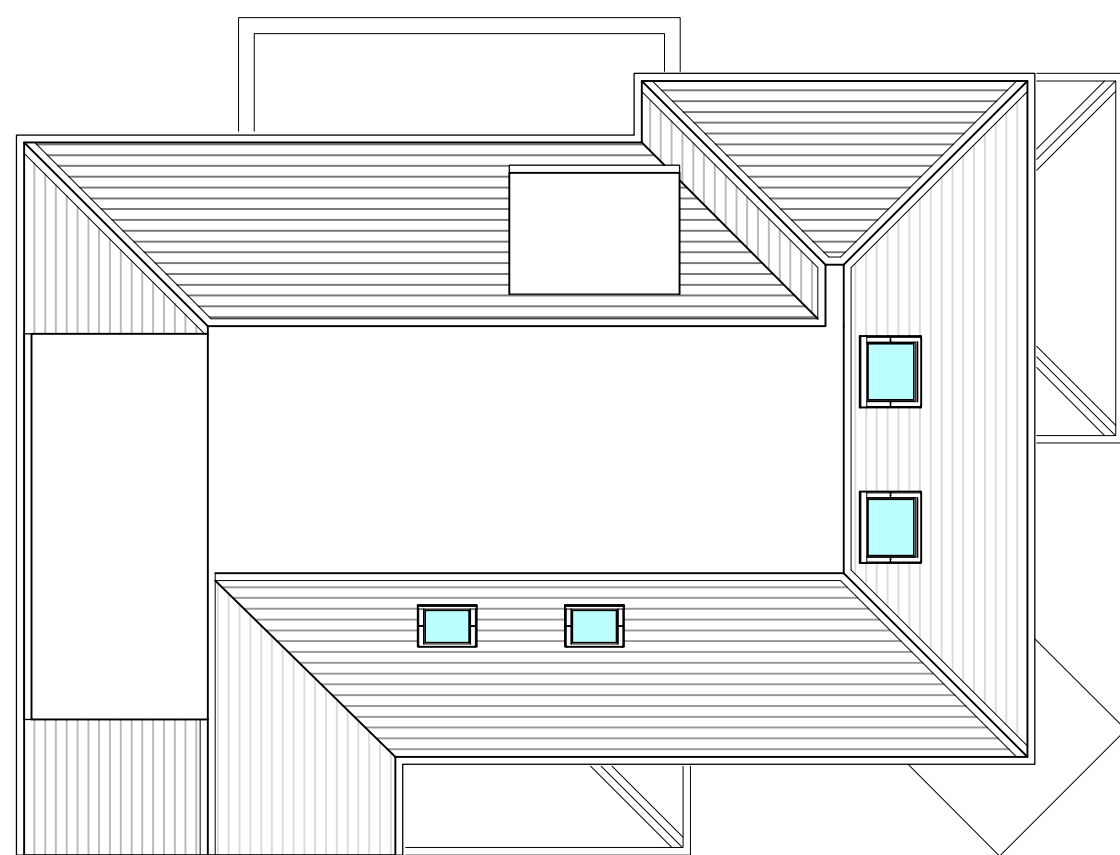


Proposed Roof Plan




Proposed Front Elevation




Proposed Elevation Facing Spinney Road

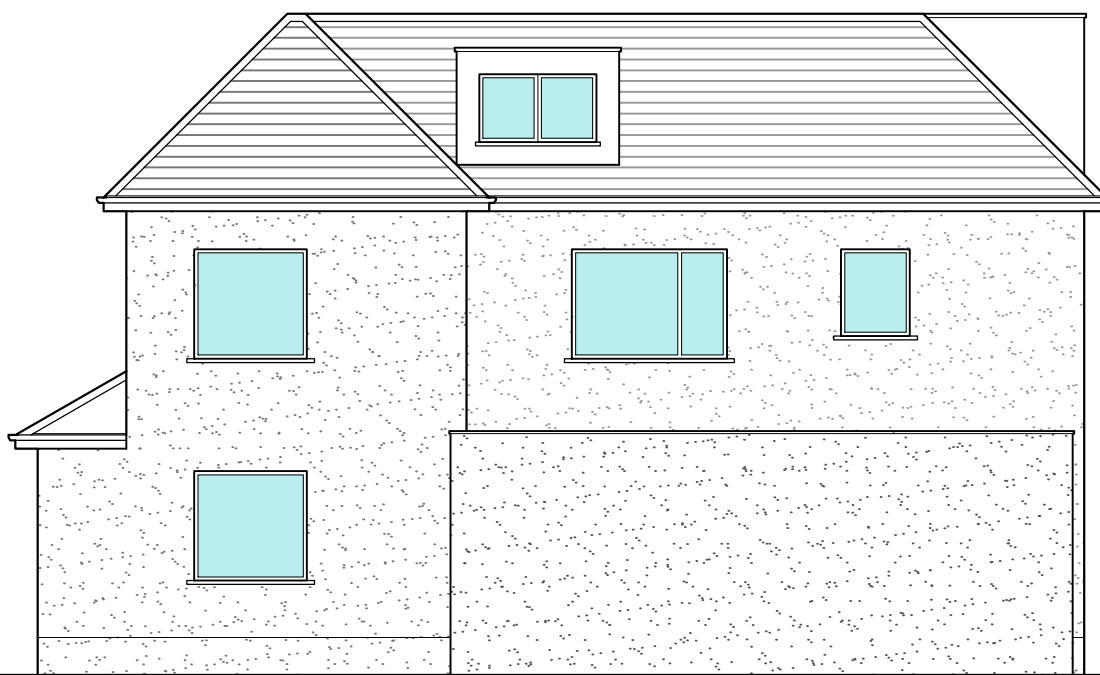

Proposed Rear Elevation

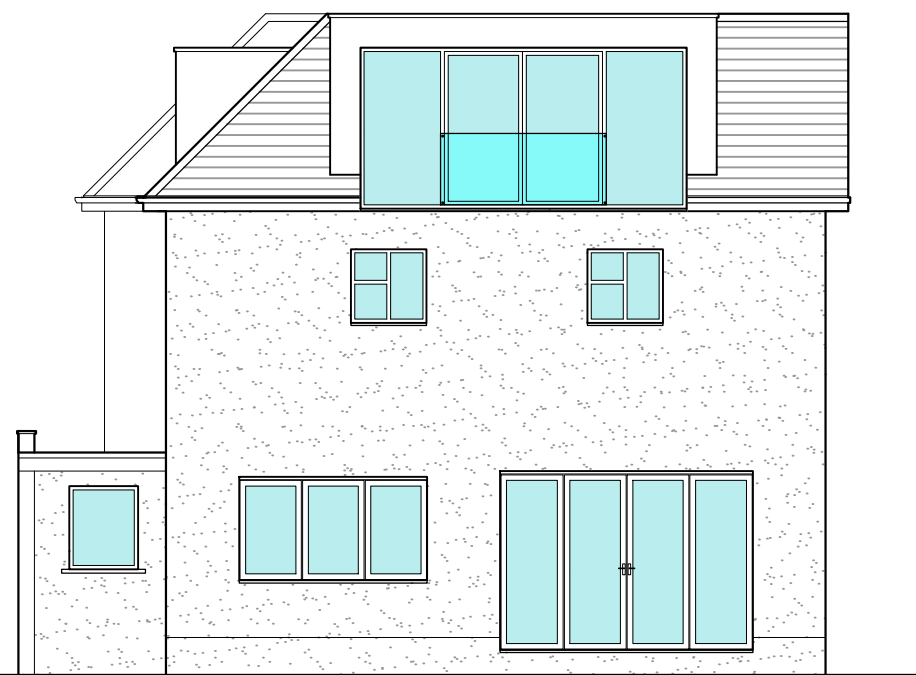

Proposed Elevation Facing Garden

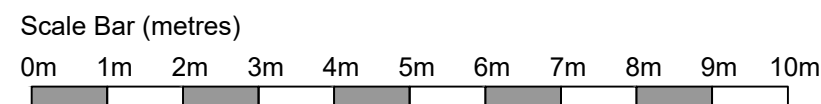

Rev	Amendment	Date
D	Proposed Loft Floor Plan added.	28.07.25
C	Original existing plans and elevations added.	29.05.25
B	As built drawing, for Minor Modification Application Submission.	24.04.25
A	Changes made to reflect comments made by client.	01.01.23

NK

ARCHITECTS

t 0161 8501045

m 07814 024033

e info@nk-architects.com

w www.nk-architects.com

PROJECT:

2 STOREY EXTENSION TO REAR, NEW DOUBLE HEIGHT FRONT ENTRANCE AND NEW ROOF TO ACCOMMODATE ADDITIONAL LIVING SPACE.

ADDRESS:

459 ALTRINCHAM ROAD,
WYTHENSHAW, MANCHESTER

DRG:

EXISTING AND PROPOSED PLANS AND ELEVATIONS

DRG STATUS:

PLANNING SUBMISSION

DATE: Dec 2022

SCALE: 1:100

SIZE: A1

DRAWN: ANK

CHECKED: ANK

DRG NO: 619.01D

COPYRIGHT © 2007 NK ARCHITECTS (MCN) LIMITED. ALL RIGHTS RESERVED. REFER TO DIMENSIONS AND DO NOT SCALE.