

LOCATION PLAN

QTH-PLA-EE-ES-DWG-L-1002

QTH-PLA-EE-ES-DWG-L-1005

QTH-PLA-EE-ES-DWG-L-1003

NOTES:

1. Do not scale from this drawing.
2. Always work to noted dimensions.
3. All dimensions are in millimetres unless otherwise stated.
4. All setting out, levels and dimensions to be agreed on site.
5. The dimensions of all materials must be checked on site before being laid out.
6. This drawing must be read with the relevant specification clauses and dated drawings.
7. Order of construction and setting out to be agreed on site.

BOUNDARIES	
	Red Line Boundary
	Section 278 Works

Refer to OTH-PLA-EE-ES-DWG-L 5000 series for hardwearing details

	SL.1	Natural Stone Slab Paving - to streets and perimeter of Albert Square. Material: Yorkstone NOTE: SL.1 depth = 75mm / SL.1" to match existing material finish and depth Refer to detailed drawing OTH-PLA-EE-ES-DWG-L-5000 Q25/112A
	SL.2	Natural Stone Set Paving - to vehicular access points at corners of Albert Square. Material: Yorkstone with percentage mix of Burlington (Cumbrian) Stone. Refer to detailed drawing OTH-PLA-EE-ES-DWG-L-5000 Q25/112B

B1.1 Proposed Asphalt Surfacing:
New surfacing to Mount Street and Central Street and tie in areas
Refer to Ramboll Pavement Hardstanding Details drawings
OTH-RAM-EE-ES-DWG-N-0100 and 0101

TO BE RETAINED - any damaged material to be replaced with reclaimed paving material from site or new paving to match existing. Replacement material to **Q25/115A**

 EX.1.1 Natural Stone Slab Paving; Yorkstone to Mount Street, Lloyd Street, Cooper Street and Princess Street.

TO BE LIFTED & RELAID - any damaged material to be replaced with reclaimed paving material from site or new paving to match existing.

 EX.1.2 Natural Stone Setts; Reclaimed Granite Setts from Albert Square to Mount Street & Southmill Street carriageway. **Q25/115B**

 EX.1.3 Natural Stone Slab Paving; Yorkstone to Lloyd Street. **Q25/115A**

 T2 New Tactile Blister Paving,
Material: Carlow Blue Limestone
Dimensions: 400mm x 400mm
Q25/144B

	Static Bollard - To IWA 14-1 and 2
	Active (Telescopic) Bollard - To IWA 14-1 and 2

For details of security bollards and other associated elements refer to Arup Public Realm Security Layout: OTH-ARU-EE-ES-DWG-G-17401 and Specification: OTH-ARU-EX-ES-SPE-Y-0001

Refer to OTH-PLA-EE-ES-DWG-C-4000 series for details.


	W1	In ground markers - cycling & parking bays Reclaimed setts on Mount Street to have new stone marker units. Existing yorkstone slabs retained on Lloyd Street to have detail shotblasted/laser etched in situ. Refer to drawing OTH-PLA-EE-ES-DWG-L-5000 for details
---	-----------	--

 Semi mature tree planting.
Refer to Softworks General Arrangement drawing OTH-PLA-EE-ES-DWG-L-2000

 Existing trees to be retained
Refer to Tree Retention and Removal drawing OTH-PLA-EE-ES-DWG-L-1006

1. Minor amendments to cycle stand positions / spacing.
2. Minor amendment to kerbline to reflect as built position.
3. Basement linework added to building edge on Central St.

Revision	Date	Description	Drawn	Apprvd.

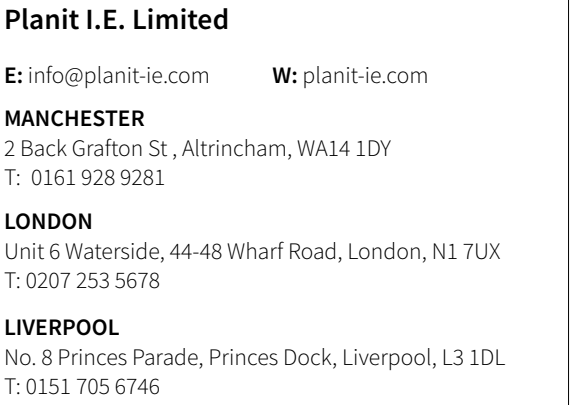

Project Our Town Hall

Created on	Created by	Approved by
26.09.18	SR	MS/KR

Drg No.	Suitability	Revision
OTH-PLA-EE-ES-DWG-L-1005	S4	C02