




AMENDEDMENTS TO 60 VICTORIA AVE EAST
PROPOSED FLOOR PLANS

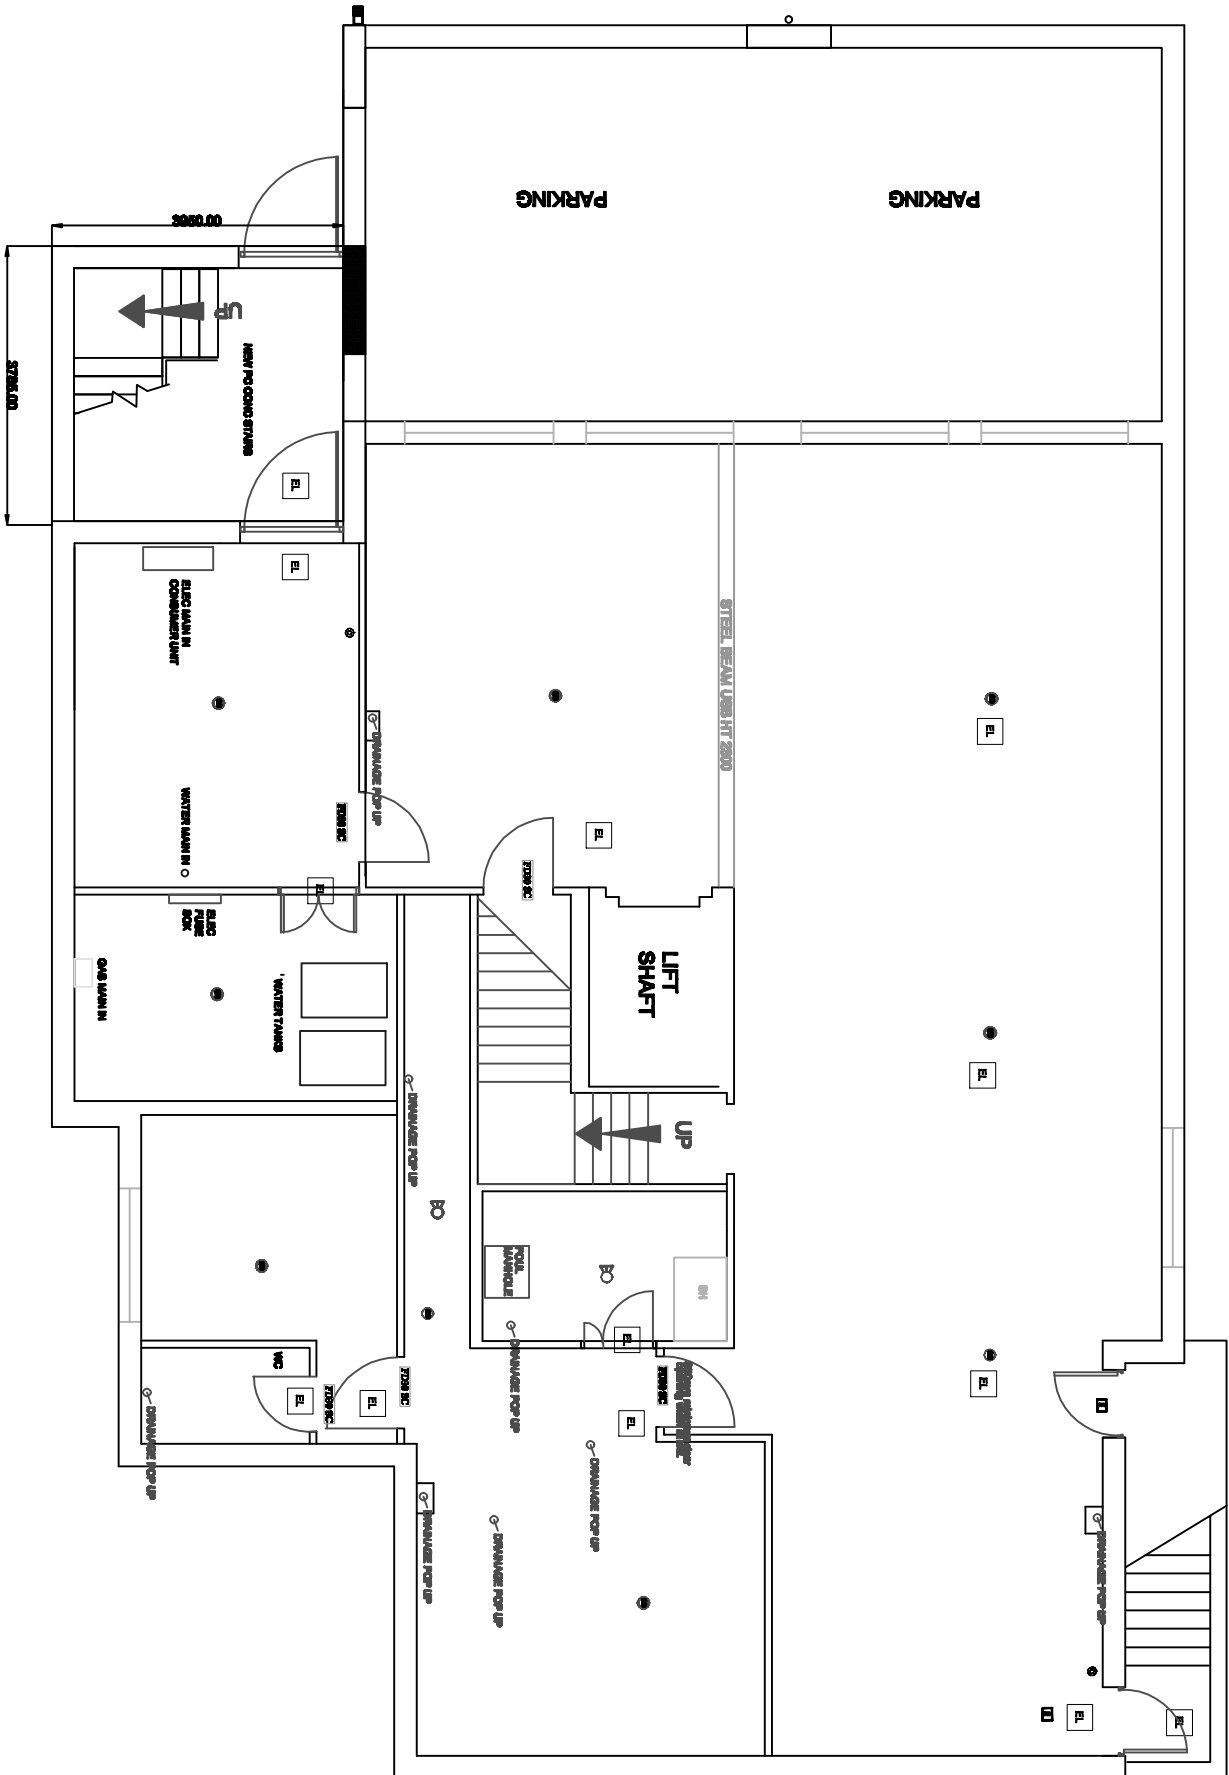

GROUND FLOOR

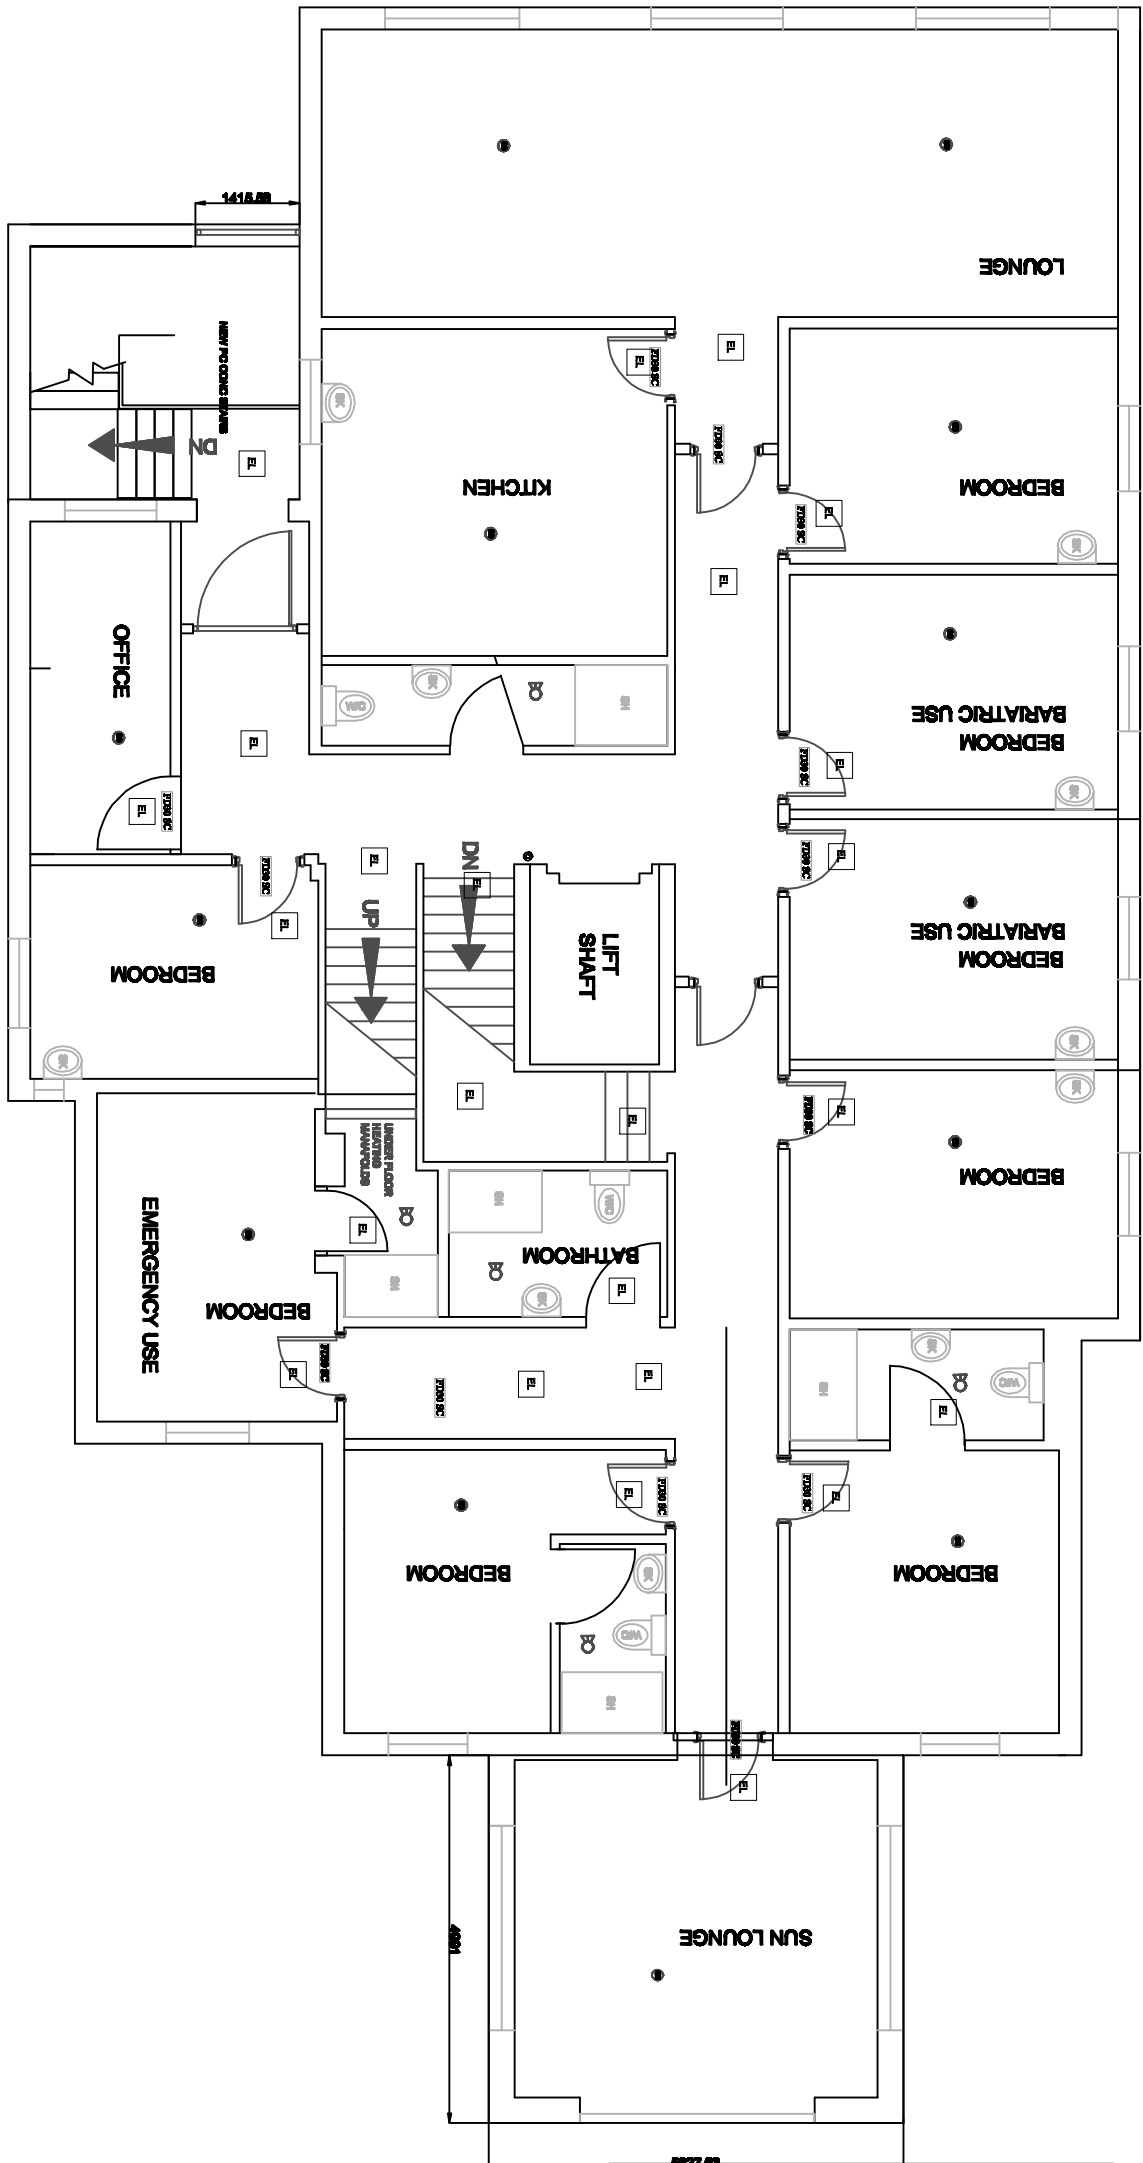


FIRST FLOOR PLAN

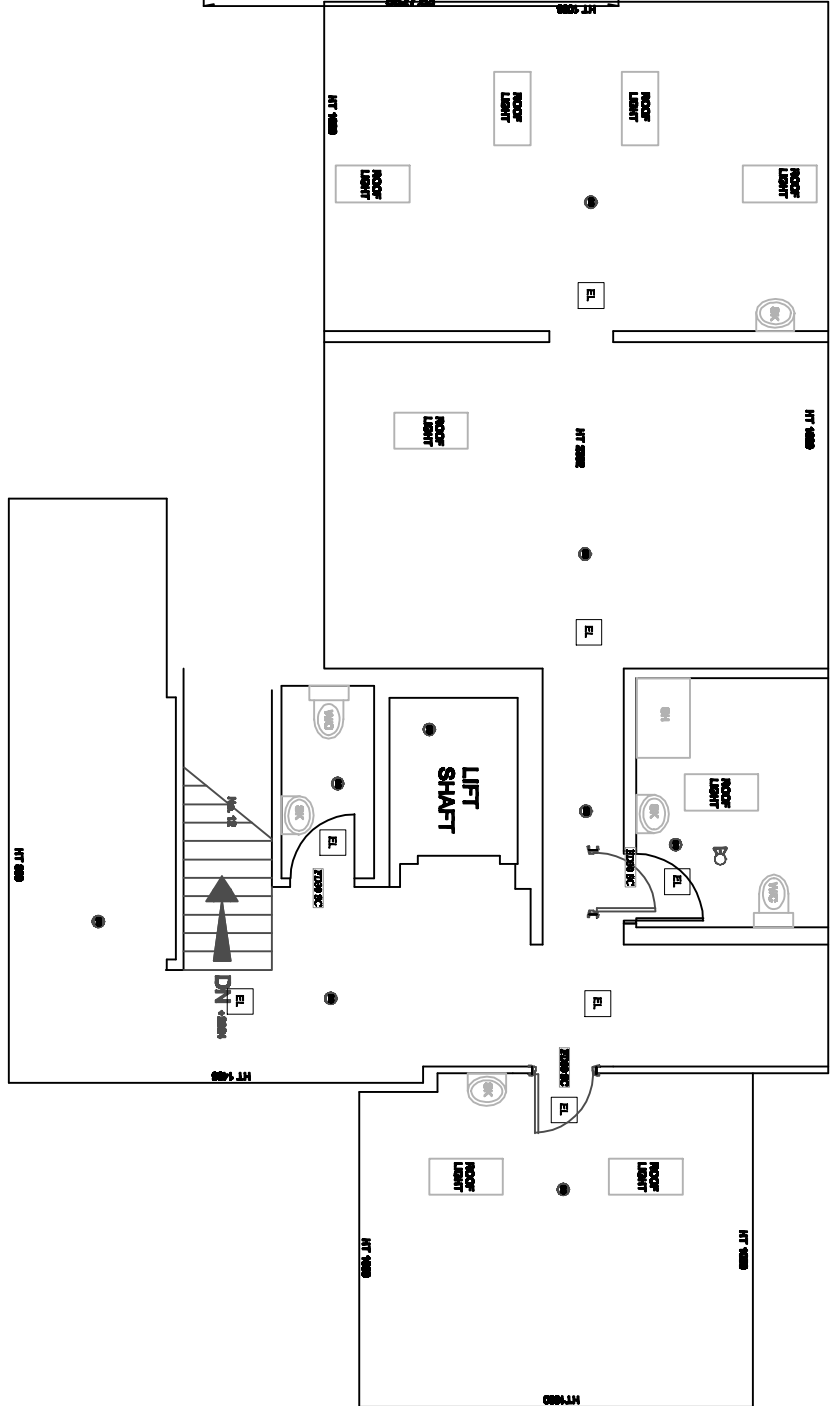


SECOND FLOOR


AMENDED SUNLOUNGER

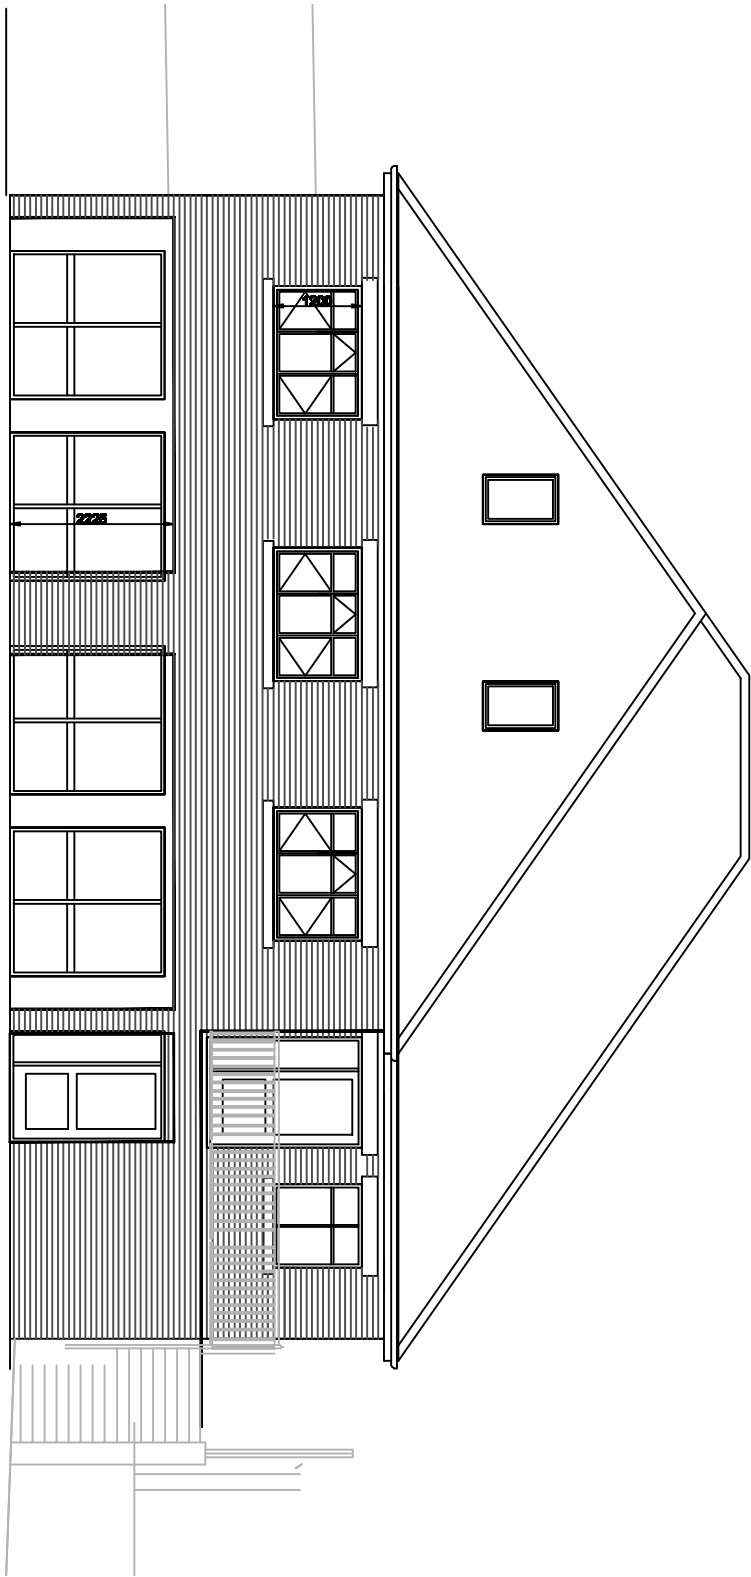


APPROVED ELEVATION
ELEVATION TO VICTORIA AVENUE EAST

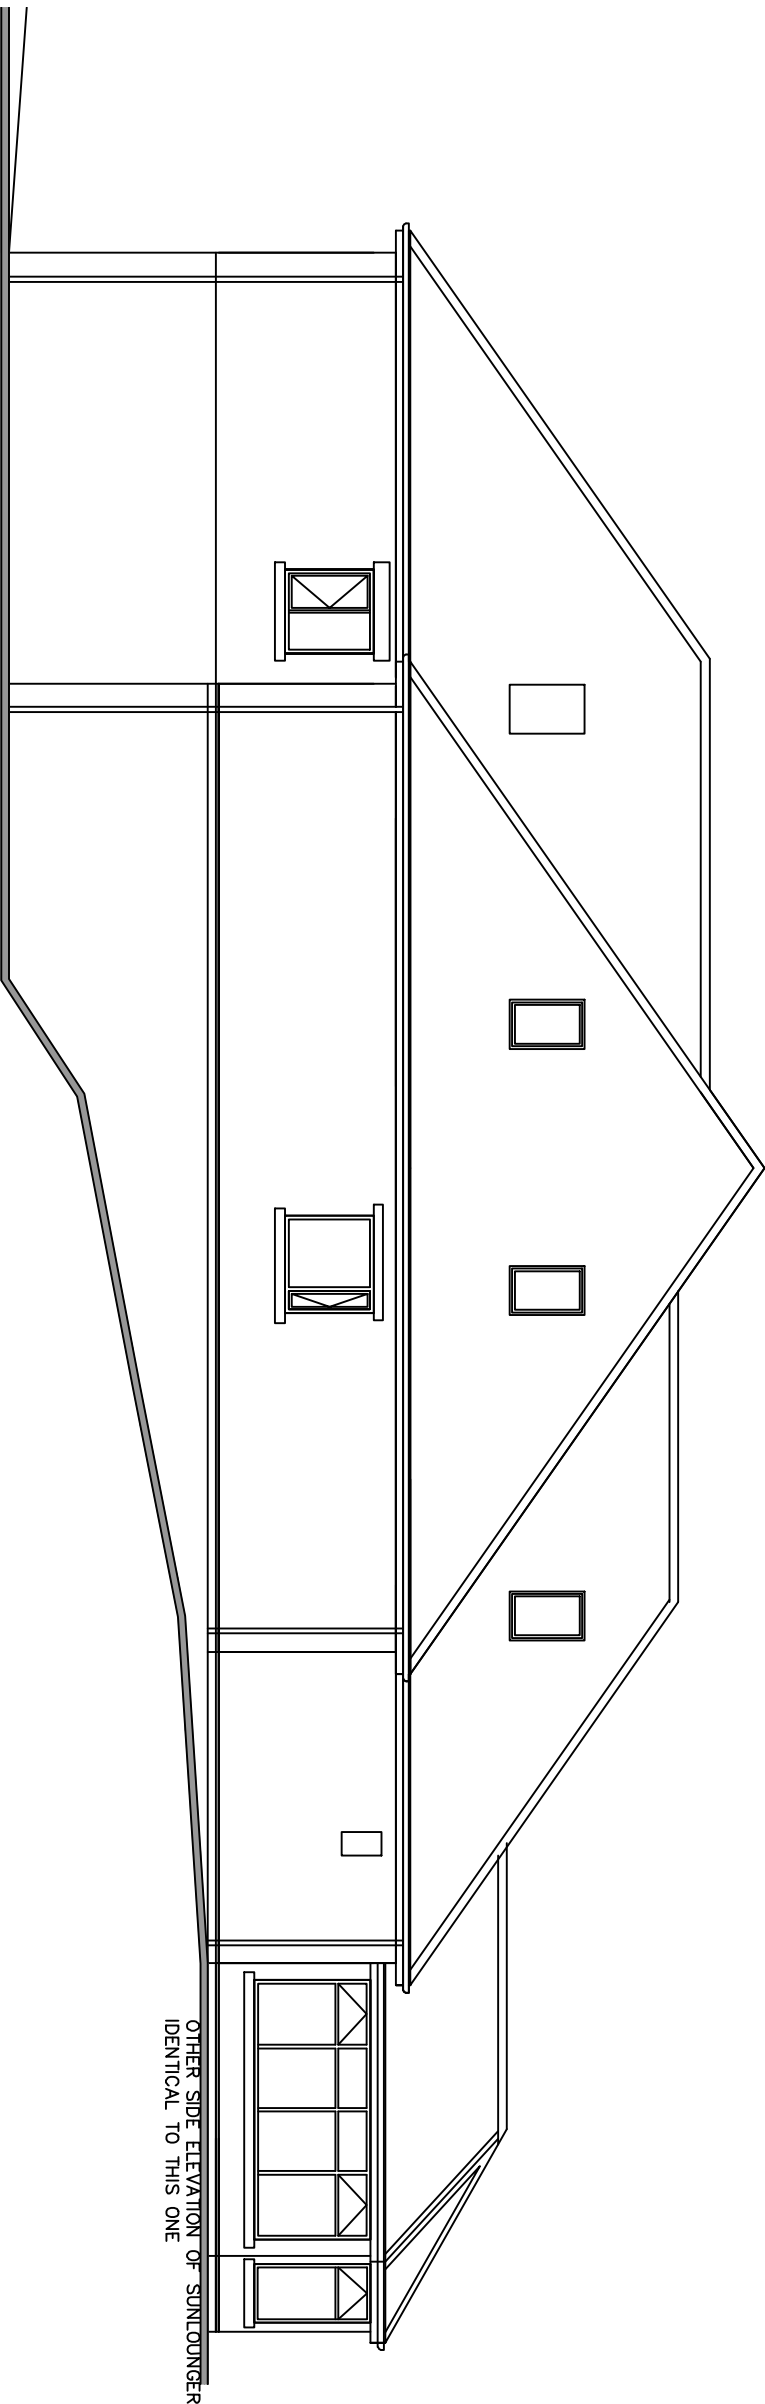


APPROVED SIDE ELEVATION

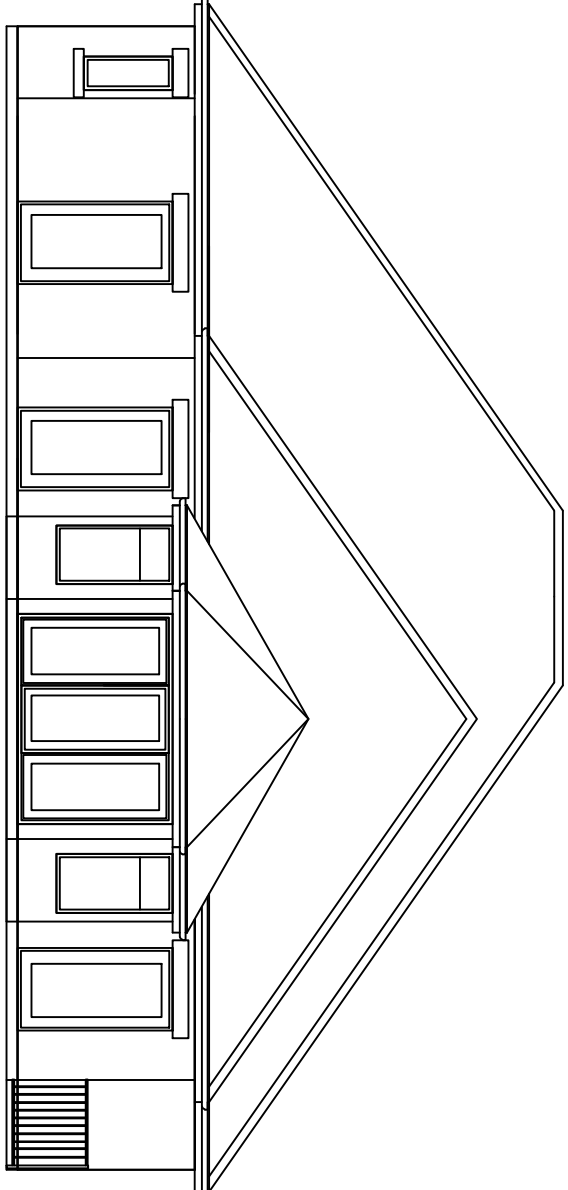


APPROVED REAR ELEVATION

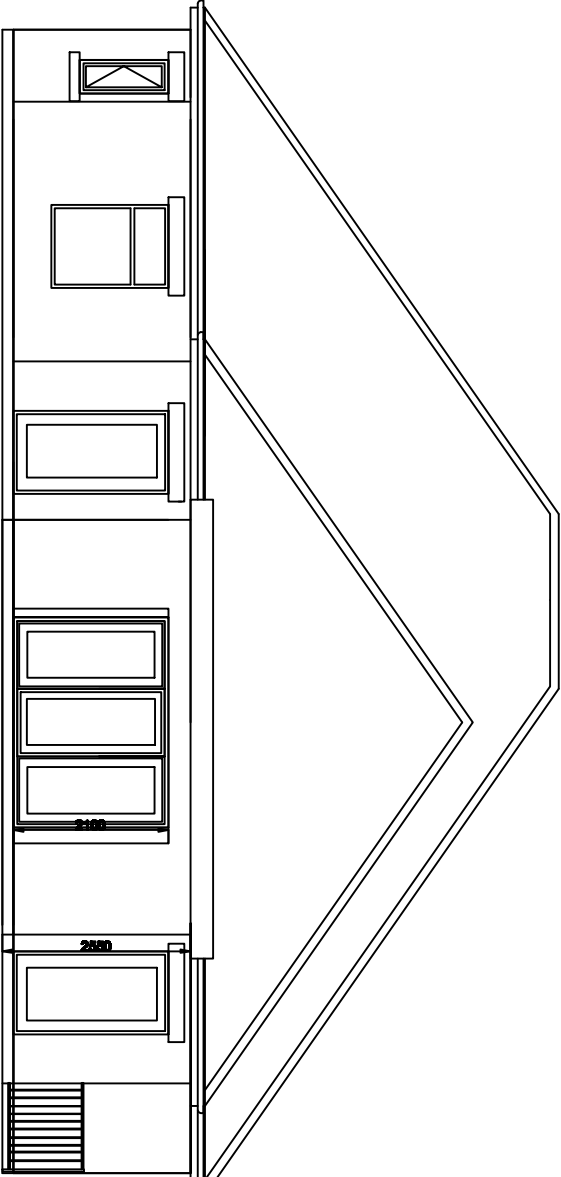


AMENDED REAR ELEVATION

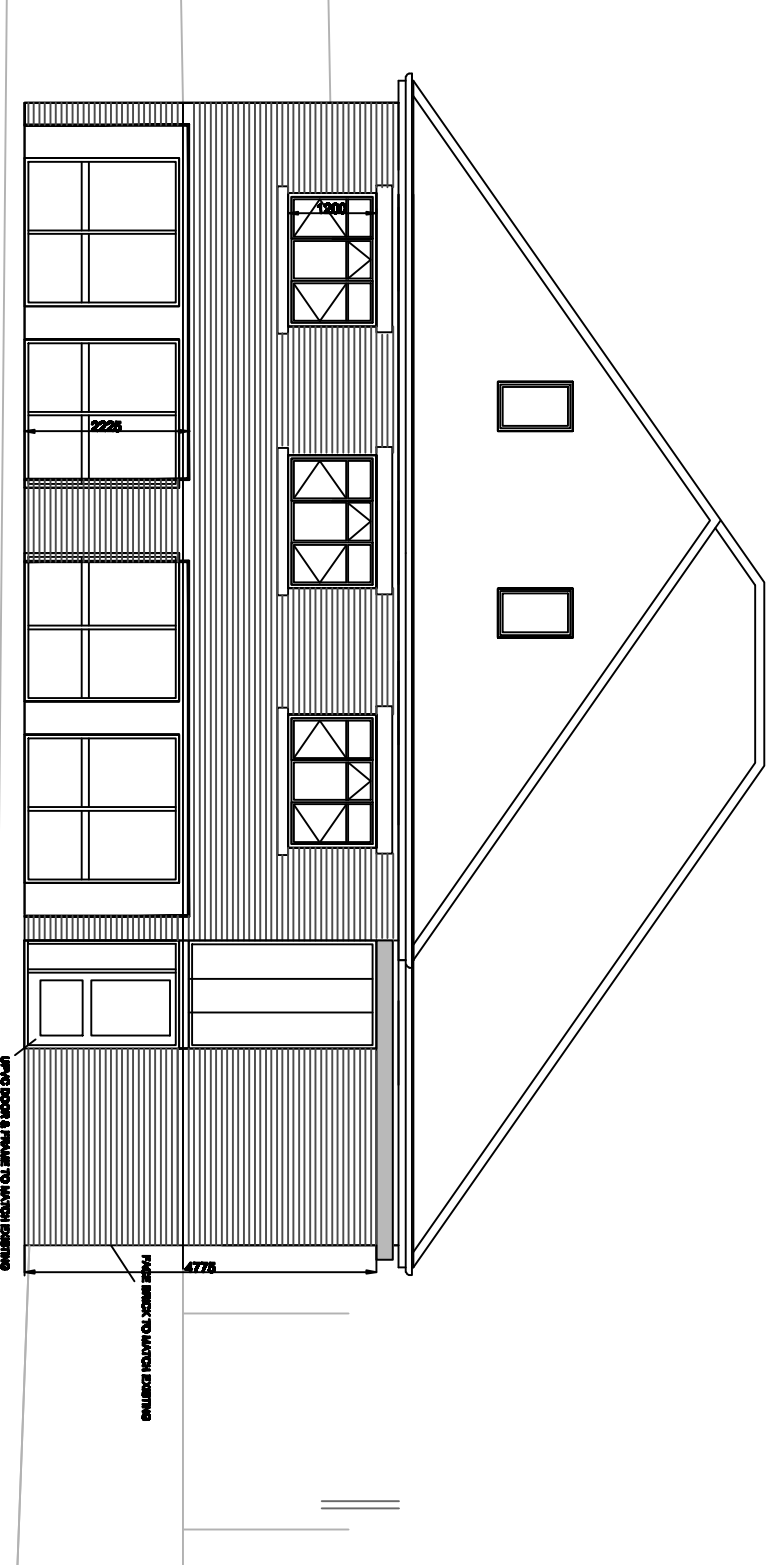

AMENDED ELEVATION
ELEVATION TO VICTORIA AVENUE EAST

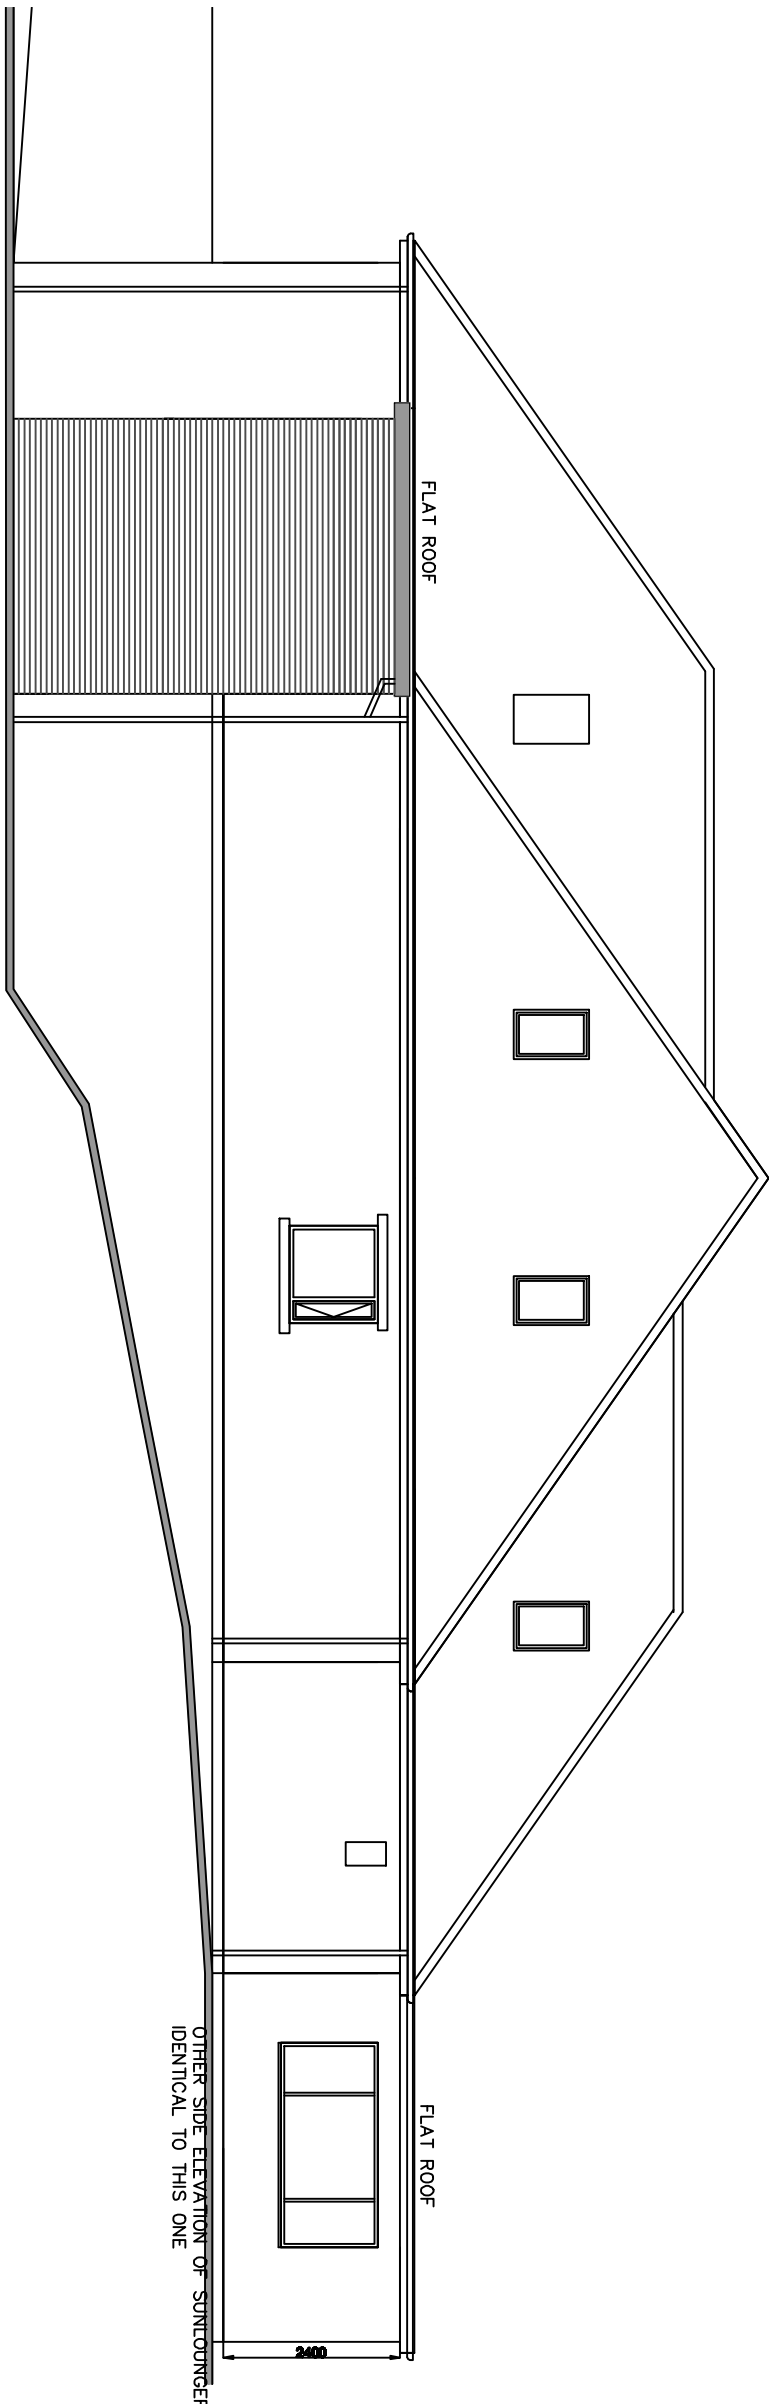

AMENDED SIDE ELEVATION

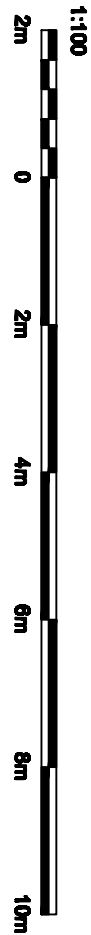

REVISIONS			
SCALE	DATE	DRAWN	CHECKED
1/100	April 2025		
1/200			
CLIENT			
VESTACARE UK Ltd			
TITLE			
PROPOSED RESITITE / DAYCARE FACILITY AS BUILT FLOORPLAN SURVEY 60 VICTORIA AVENUE EAST BLACKLEY, MANCHESTER M9 6HB			

Amended entrance stairs, amended rear sun lounge
to approval ref 094690/O/2010/N1